

APPLICATION

PERCOLATION TESTING

A 40277
P _____

HOWARD COUNTY HEALTH DEPARTMENT
BUREAU OF ENVIRONMENTAL HEALTH
P.O. BOX 476 ELLICOTT CITY, MARYLAND 21043
TELEPHONE: 461-9933

DISTRICT 3rd
DATE 8/21/87

TO: THE COUNTY HEALTH OFFICER
ELLICOTT CITY, MARYLAND

I, HEREBY, APPLY FOR THE NECESSARY TEST IN ORDER TO CONSTRUCT (OR RECONSTRUCT) A SEWAGE DISPOSAL SYSTEM.

PROPERTY OWNER Murat Seibert

ADDRESS 3250 Roscommon Drive PHONE 489-4863

PROSPECTIVE BUYER _____

ADDRESS _____ PHONE _____

PROPERTY LOCATION:

SUBDIVISION Byrd Manor LOT NO. 3

ROAD AND DESCRIPTION End of Roscommon Drive & Gared Road

TAX MAP 15 PARCEL # 19

SIZE OF LOT 3.72 Acres TYPE BLDG. SFD
(SINGLE FAMILY DWELLING OR COMMERCIAL)

THE SYSTEM INSTALLED UNDER THIS APPLICATION IS ACCEPTABLE ONLY UNTIL PUBLIC FACILITIES BECOME AVAILABLE. I FULLY UNDERSTAND THE

FEE CONNECTED WITH THE FILING OF THIS PERC TEST APPLICATION IS NON-REFUNDABLE UNDER ANY CIRCUMSTANCES. I ALSO AGREE TO COMPLY

WITH ALL M.O.S.H.A. REQUIREMENTS IN TESTING THIS LOT. _____
(SIGNATURE OF APPLICANT)

APPROVED BY [Signature] FOR [Signature] DATE 8-5-88

REJECTED BY _____ FOR _____ DATE _____

HOLD PENDING FURTHER TESTS _____ DATE _____

REASONS FOR REJECTION OR HOLDING 11/19/87 Per Satisfactory - Hold for Subdivision Plat, 5 Acre

THIS IS NOT A PERMIT


lot 3

① → ④
SOIL PROFILE

0"
6" AP 11x
Yell Br.
Silt Clay
Loam
Few small
QUARTZ FRAGS
10-15%
CK

4.5-6"
Yellow Br
MICACEOUS
Silt Loam
15-20%
FRAGS

13"

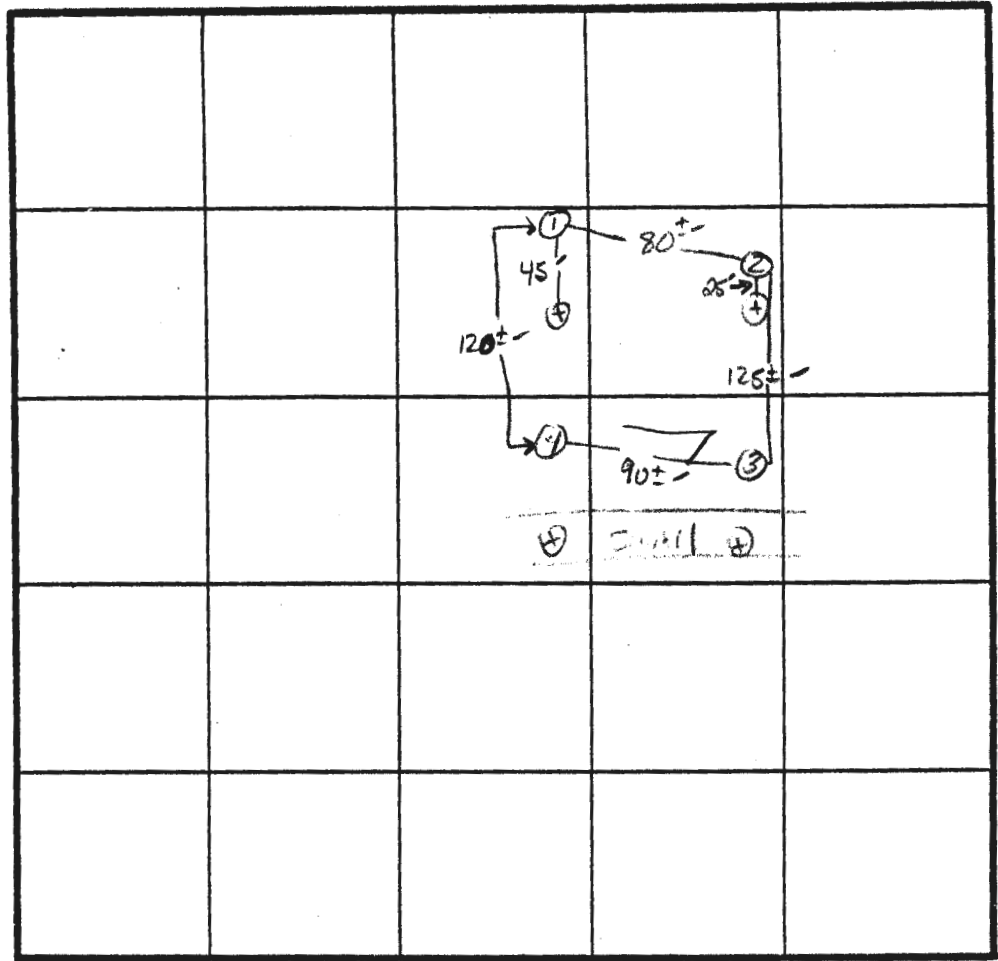

⊗ = SWAILS

̄ Perc 5 m

180 & 180

Inlet 5
Bottom 9

INDICATE NORTH - NAME ADJOINING ROADWAY AS BASE LINE.
BURNWOODS ROAD

DATE	TEST NO.	DEPTH	PRE-WET		TEST - 1" DROP		TIME
			START	STOP	START	STOP	
11/19/87	1 S	5.0'	10:10	10:17	10:17	10:30	13 MIN
		9.5'	10:10	10:11	10:11	10:13	2 MIN
	1 V	13'	UNIFORM Soil below 4.5'				
	2 S	4.0'	10:12	10:13	10:13	10:15	2 MIN
	2 V	13'	UNIFORM Soil below 9.0'			CK	
	3 S	6.0'	10:16	10:18	10:18	10:21	3 MIN
	3 V	13'	UNIFORM below 5.5' - 6.0'			CK	
	4 V	13'	UNIFORM below 4.5'			CK	

REMARKS Holes DIFF THAN RAT -> Swail

TYPE OF SOIL Chestex Lm.

TESTED BY S. Abel ALSO PRESENT SKIP, Rocky

EH-12-1079

Detailed Search

- Search By Longitude/Latitude
- Search By Street Intersection
- Search By Owner (Property)
- Search By Tax ID
- Search By Plat Number
- Search By Tax Map/Parcel/Lot

Map:	15
Parcel:	19
Lot:	2

Search By Map/Parcel/Lot

- Search Scanned Drawings By Number
- Search Scanned Drawings By Name

13509 GOLDEN CORN DR

Detailed Search

Search By Longitude/Latitude

Search By Street Intersection

Search By Owner (Property)

Search By Tax ID

Search By Plat Number

Search By Tax Map/Parcel/Lot

Map:

Parcel:

Lot:

Search By Map/Parcel/Lot

Search Scanned Drawings By Number

Search Scanned Drawings By Name

Real Property Data Search (w3)

Search Result for HOWARD COUNTY

View Map		View GroundRent Redemption			View GroundRent Registration					
Tax Exempt:		Special Tax Recapture:								
Exempt Class:		NONE								
Account Identifier:		District - 03 Account Number - 313646								
Owner Information										
Owner Name:	MANICKAM VIJAY THIAGU MANICKAM NESSHA VINOD			Use:	RESIDENTIAL					
				Principal Residence:	NO					
Mailing Address:	5006 FINSBURY RD ROSEDALE MD 21237-			Deed Reference:	/18415/ 00288					
Location & Structure Information										
Premises Address:	NE GARED DR GLENELG 21737-0000			Legal Description:	LOT 3 4.166 A GARED DR BRYD MANOR SUB					
Map:	Grid:	Parcel:	Sub District:	Subdivision:	Section:	Block:	Lot:	Assessment Year:	Plat No:	8079
0015	0019	0019		2001			3	2019	Plat Ref:	
Special Tax Areas:				Town:	NONE					
				Ad Valorem:	100					
				Tax Class:						
Primary Structure Built	Above Grade Living Area		Finished Basement Area		Property Land Area	4.1600 AC		County Use		
Stories	Basement	Type	Exterior	Full/Half Bath	Garage	Last Major Renovation				
Value Information										
			Base Value	Value	Phase-in Assessments					
				As of	As of		As of			
				01/01/2019	07/01/2018		07/01/2019			
Land:			207,200	213,700						
Improvements			0	0						
Total:			207,200	213,700	207,200		209,367			
Preferential Land:			0		0					
Transfer Information										
Seller: YODER ELDON L			Date: 10/17/2018			Price: \$428,000				
Type: ARMS LENGTH VACANT			Deed1: /18415/ 00288			Deed2:				
Seller: SEIBERT BYRD M AND WF			Date: 10/04/1989			Price: \$115,000				
Type: ARMS LENGTH IMPROVED			Deed1: /02064/ 00579			Deed2:				
Seller:			Date:			Price:				
Type:			Deed1:			Deed2:				
Exemption Information										
Partial Exempt Assessments:	Class	07/01/2018			07/01/2019					
County:	000	0.00								
State:	000	0.00								
Municipal:	000	0.00 0.00			0.00 0.00					
Tax Exempt:		Special Tax Recapture:								
Exempt Class:		NONE								
Homestead Application Information										
Homestead Application Status: No Application										

Homeowners' Tax Credit Application Information

Homeowners' Tax Credit Application Status: No Application **Date:**

1. This screen allows you to search the Real Property database and display property records.
2. Click [here](#) for a glossary of terms.
3. Deleted accounts can only be selected by Property Account Identifier.
4. The following pages are for information purpose only. The data is not to be used for legal reports or documents. While we have confidence in the accuracy of these records, the Department makes no warranties, expressed or implied, regarding the information.