

Preli.

# APPLICATION

A 28060

P \_\_\_\_\_

## SEWAGE DISPOSAL TESTING

STATE OF MARYLAND - DEPARTMENT OF HEALTH AND MENTAL HYGIENE

HOWARD COUNTY HEALTH DEPARTMENT  
ENVIRONMENTAL HEALTH SERVICES

P. O. BOX 476, ELLICOTT CITY, MARYLAND 21043  
TELEPHONE: 465-5000, EXT. 356

DISTRICT 6th

DATE 5/18/78

TO: THE COUNTY HEALTH OFFICER  
ELLICOTT CITY, MARYLAND

I, HEREBY, APPLY FOR THE NECESSARY TEST IN ORDER TO CONSTRUCT (OR RECONSTRUCT) A SEWAGE DISPOSAL SYSTEM.

PROPERTY OWNER Thomas L. and Cheryl E. Bianco

ADDRESS 8514 Locust Grove Drive PHONE (301) 490-7093  
Laurel, Maryland 20810

PROPERTY LOCATION:

SUBDIVISION N/A LOT NO. N/A

ROAD AND DESCRIPTION Gorman Rd NS Dist R6, Map 047, Grid 17,  
Parcel 0893, Liber 0693, Folio 238

SIZE OF LOT 1.377 acres TYPE BLDG. residence 3 BR  
NUMBER OF BEDROOMS

IF NOT SINGLE RESIDENCE DESCRIBE N/A

THE SYSTEM INSTALLED UNDER THIS APPLICATION IS ACCEPTABLE ONLY UNTIL PUBLIC FACILITIES BECOME AVAILABLE.

SIGNATURE OF APPLICANT Thomas L. Bianco


APPROVED BY \_\_\_\_\_ FOR \_\_\_\_\_ DATE \_\_\_\_\_

REJECTED BY All Money Co FOR any DATE 2-2-78  
(KIND OF SYSTEM) (KIND OF SYSTEM)

HOLD PENDING FURTHER TESTS \_\_\_\_\_ DATE \_\_\_\_\_

REASONS FOR REJECTION OR HOLDING Too much slope exceeds 25% - poor price

# THIS IS NOT A PERMIT

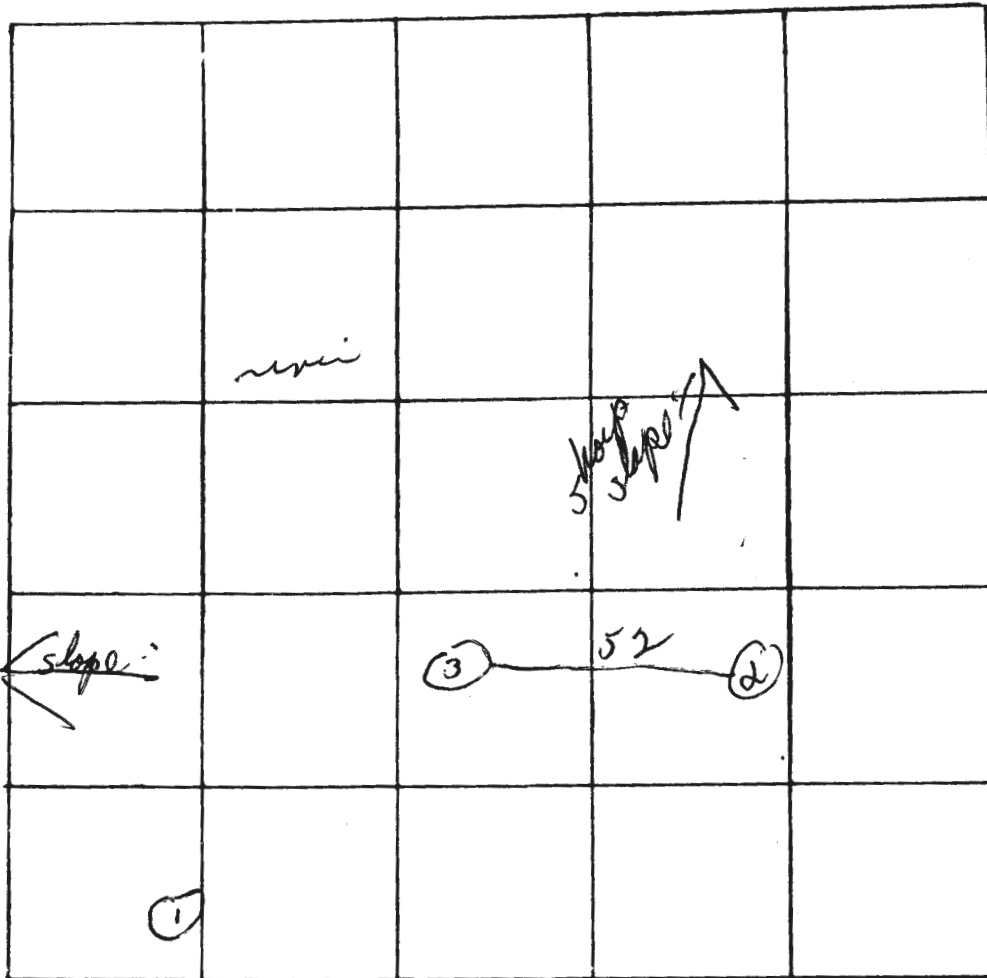

INDICATE NORTH - NAME ADJOINING ROADWAY AS BASE LINE

*Boomer Rd*

| DATE | TEST NO.         | DEPTH    | PRE-WET            |       | TEST - 1" DROP     |       | TIME   |  |
|------|------------------|----------|--------------------|-------|--------------------|-------|--------|--|
|      |                  |          | START              | STOP  | START              | STOP  |        |  |
| 2/   | 1                | 9ft.     | solid rock in bath |       |                    |       |        |  |
|      | 2A               | 1 1/2    | 10 05              | 10 07 | 10 07              | 10 17 | 10m    |  |
|      | 2B               | 4 1/2    | 10 08              | 10 23 | 10 23              | 10 30 | 13min  |  |
|      | 2A<br><i>new</i> |          | 10 17              | 10 25 | 10 25              | 10 45 | 20 min |  |
|      | 3A               | 4 1/2 ft | 10 26              | 10 34 | 10 34              | 10 47 | 13m    |  |
|      | 3B               | 1 1/2 ft | 10 27              | 10 47 | stop test no perc. |       |        |  |
|      |                  |          |                    |       |                    |       |        |  |
|      |                  |          |                    |       |                    |       |        |  |
|      |                  |          |                    |       |                    |       |        |  |
|      |                  |          |                    |       |                    |       |        |  |

7 slope exceeds 35%

REMARKS \_\_\_\_\_  
 TYPE OF SOIL rocky - clay + sand  
 TESTED BY DUM ALSO PRESENT: \_\_\_\_\_

