

Real Property Data Search (w3)

Search Result for HOWARD COUNTY

View Map		View GroundRent Redemption		View GroundRent Registration	
Tax Exempt:		Special Tax Recapture:			
Exempt Class:		NONE			
Account Identifier:		District - 05 Account Number - 415136			
Owner Information					
Owner Name:	RICHMOND DAVIS ENTERPRISES LLC		Use:	RESIDENTIAL	
Mailing Address:	5201 GREEN BRIDGE RD DAYTON MD 21036-1203		Principal Residence:	NO	
			Deed Reference:	/05099/ 00185	
Location & Structure Information					
Premises Address:	5211 GREEN BRIDGE RD DAYTON 21036-0000		Legal Description:	LOT 5 3.0033 A 5211 GREEN BRIDGE RD GREENBRIDGE,RSB LOT 4	
Map:	Grid:	Parcel:	Sub District:	Subdivision:	Section: Block: Lot:
0028	0013	0058		0000	5
					Assessment Year: 2017
					Plat No: 14208
					Plat Ref: 0541/0714
Special Tax Areas:		Town:		NONE	
		Ad Valorem:		100	
		Tax Class:			
Primary Structure Built	Above Grade Living Area	Finished Basement Area	Property Land Area	County Use	
			3.0000 AC		
Stories	Basement	Type	Exterior	Full/Half Bath	Garage
					Last Major Renovation
Value Information					
	Base Value	Value	Phase-in Assessments		
		As of 01/01/2017	As of 07/01/2018	As of 07/01/2019	
Land:	232,500	232,500			
Improvements	0	0			
Total:	232,500	232,500	232,500	232,500	
Preferential Land:	0			0	
Transfer Information					
Seller: MARINUCCI ROSARIO		Date: 05/23/2000		Price: \$160,250	
Type: ARMS LENGTH VACANT		Deed1: /05099/ 00185		Deed2:	
Seller:		Date:		Price:	
Type:		Deed1:		Deed2:	
Seller:		Date:		Price:	
Type:		Deed1:		Deed2:	
Exemption Information					
Partial Exempt Assessments:	Class	07/01/2018	07/01/2019		
County:	000	0.00			
State:	000	0.00			
Municipal:	000	0.00 0.00	0.00 0.00		
Tax Exempt:		Special Tax Recapture:			
Exempt Class:		NONE			
Homestead Application Information					
Homestead Application Status: No Application					
Homeowners' Tax Credit Application Information					


Homestead Application Information

Homestead Application Status: Approved 08/07/2008

Homeowners' Tax Credit Application Information

Homeowners' Tax Credit Application Status: No Application **Date:**

1. This screen allows you to search the Real Property database and display property records.
2. Click **here** for a glossary of terms.
3. Deleted accounts can only be selected by Property Account Identifier.
4. The following pages are for information purpose only. The data is not to be used for legal reports or documents. While we have confidence in the accuracy of these records, the Department makes no warranties, expressed or implied, regarding the information.

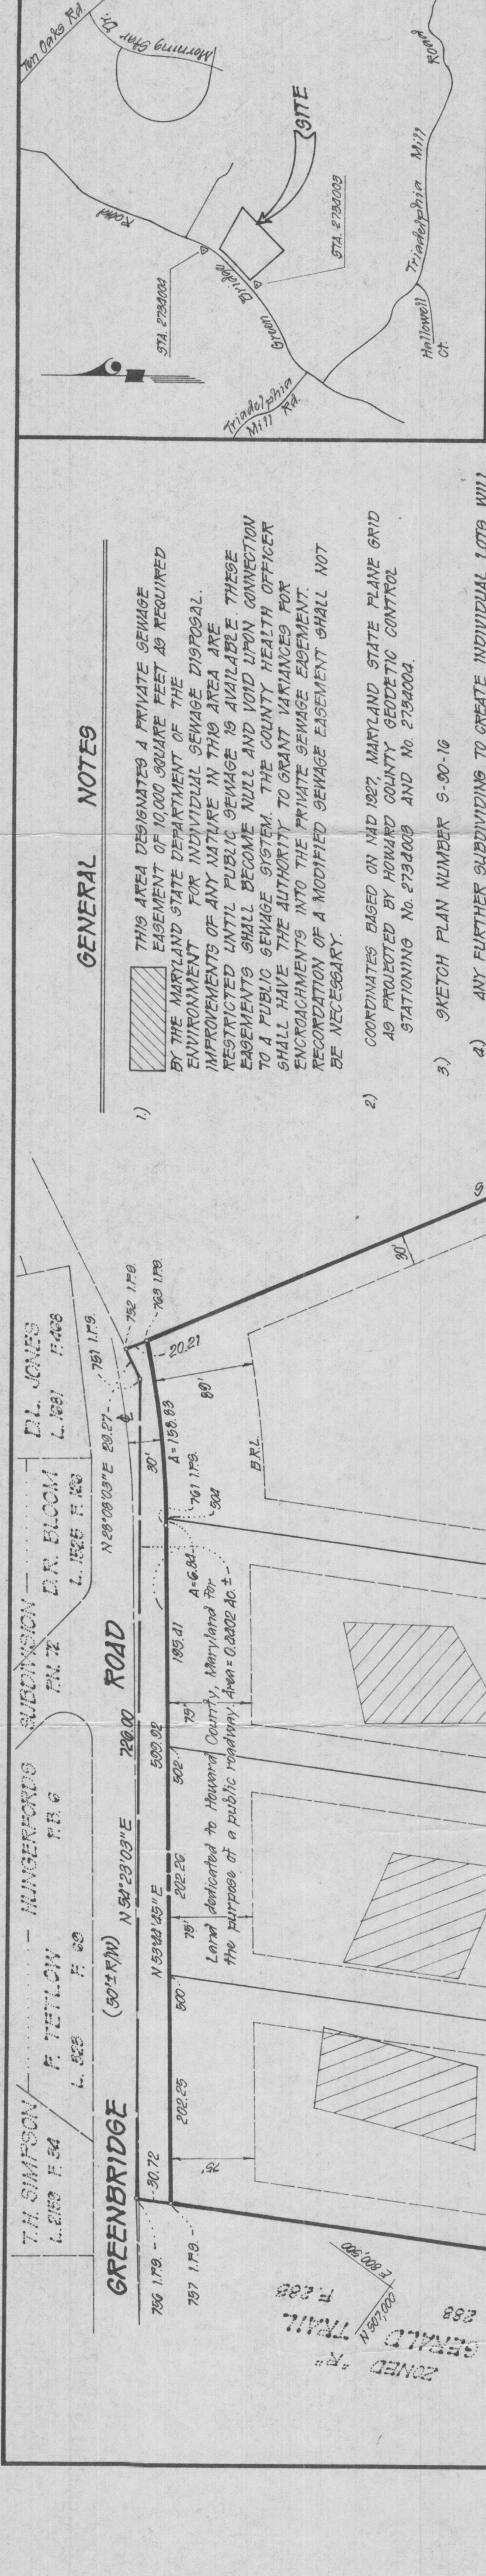

GENERAL NOTES

THIS AREA DESIGNATES A PRIVATE SEWAGE EASEMENT OF 10,000 SQUARE FEET AS REQUIRED BY THE MARYLAND STATE DEPARTMENT OF THE ENVIRONMENT FOR INDIVIDUAL SEWAGE DISPOSAL. IMPROVEMENTS OF ANY NATURE IN THIS AREA ARE RESTRICTED UNTIL PUBLIC SEWAGE IS AVAILABLE. THESE EASEMENTS SHALL BECOME NULL AND VOID UPON CONNECTION TO A PUBLIC SEWAGE SYSTEM. THE COUNTY HEALTH OFFICER SHALL HAVE THE AUTHORITY TO GRANT VARIANCES FOR ENCROACHMENTS INTO THE PRIVATE SEWAGE EASEMENT. RECONSTRUCTION OF A MODIFIED SEWAGE EASEMENT SHALL NOT BE NECESSARY.

2) COORDINATES BASED ON NAD 1927, MARYLAND STATE PLANE GRID AS PROJECTED BY HOWARD COUNTY GEODETIC CONTROL STATIONING No. 2734003 AND No. 2734004.

3) SKETCH PLAN NUMBER 5-90-16

4) ANY FURTHER SUBDIVIDING TO CREATE INDIVIDUAL LOTS WILL BE CONSIDERED A MAJOR SUBDIVISION AND WILL REQUIRE FULL COMPLIANCE TO THE HOWARD COUNTY SUBDIVISION AND LAND DIVISION REGULATIONS TO INCLUDE ROAD FRONTAGE IMPROVEMENTS ALONG THE ENTIRE FRONTAGE OF LOTS 1-4.

5) THE LOTS SHOWN HEREON COMPLY WITH THE MINIMUM OWNERSHIP WIDTH AND LOT AREA AS REQUIRED BY THE MD STATE DEPT OF THE ENVIRONMENT.

6) SUBJECT PROPERTY ZONED "R" PER 1985 COMPREHENSIVE ZONING PLAN.

7) NO CLEARING, GRADING OR CONSTRUCTION IS PERMITTED WITHIN THE REQUIRED WETLANDS OR STREAM BUFFERS.

8) THIS PLAN IS BASED ON A FIELD RUN BOUNDARY SURVEY PERFORMED ON JANUARY 30, 1990 BY WARD D. KELLEY FOR CORDERO, WARD & ASSOCIATES.

VICINITY MAP
Scale: 1" = 2000'

CURVE DATA

Rad	Δ	Arc	Tan	Chd	Bearing
702.55	11°56'48"	165.07	83.14	165.57	9.881011°W

LOT AREAS

LOT	GROSS AREA	FLOOD PLAIN	NET AREA
1	4.0109 Ac.	0.1148 Ac.	3.8961 Ac.
2	4.0670 Ac.	0.0000 Ac.	4.0670 Ac.
3	4.1240 Ac.	0.0517 Ac.	4.0723 Ac.
4	8.0522 Ac.	1.1477 Ac.	7.5045 Ac.

OWNER'S ADDRESS:
ROSARIO MARINUCCI
11009 EDMONSTON ROAD
BELTSVILLE, MARYLAND 20705

Owner's Signature: [Signature]
Dated: 12-24-91
see plat # 10174

GENERAL NOTES

THIS AREA DESIGNATES A PRIVATE SEWAGE EASEMENT OF 10,000 SQUARE FEET AS REQUIRED BY THE MARYLAND STATE DEPARTMENT OF THE ENVIRONMENT FOR INDIVIDUAL SEWAGE DISPOSAL. IMPROVEMENTS OF ANY NATURE IN THIS AREA ARE RESTRICTED UNTIL PUBLIC SEWAGE IS AVAILABLE. THESE EASEMENTS SHALL BECOME NULL AND VOID UPON CONNECTION TO A PUBLIC SEWAGE SYSTEM. THE COUNTY HEALTH OFFICER SHALL HAVE THE AUTHORITY TO GRANT VARIANCES FOR ENCROACHMENTS INTO THE PRIVATE SEWAGE EASEMENT. RECONSTRUCTION OF A MODIFIED SEWAGE EASEMENT SHALL NOT BE NECESSARY.

2) COORDINATES BASED ON NAD 1927, MARYLAND STATE PLANE GRID AS PROJECTED BY HOWARD COUNTY GEODETIC CONTROL STATIONING No. 2734003 AND No. 2734004.

3) SKETCH PLAN NUMBER 5-90-16

4) ANY FURTHER SUBDIVIDING TO CREATE INDIVIDUAL LOTS WILL BE CONSIDERED A MAJOR SUBDIVISION AND WILL REQUIRE FULL COMPLIANCE TO THE HOWARD COUNTY SUBDIVISION AND LAND DIVISION REGULATIONS TO INCLUDE ROAD FRONTAGE IMPROVEMENTS ALONG THE ENTIRE FRONTAGE OF LOTS 1-4.

5) THE LOTS SHOWN HEREON COMPLY WITH THE MINIMUM OWNERSHIP WIDTH AND LOT AREA AS REQUIRED BY THE MD STATE DEPT OF THE ENVIRONMENT.

6) SUBJECT PROPERTY ZONED "R" PER 1985 COMPREHENSIVE ZONING PLAN.

7) NO CLEARING, GRADING OR CONSTRUCTION IS PERMITTED WITHIN THE REQUIRED WETLANDS OR STREAM BUFFERS.

8) THIS PLAN IS BASED ON A FIELD RUN BOUNDARY SURVEY PERFORMED ON JANUARY 30, 1990 BY WARD D. KELLEY FOR CORDERO, WARD & ASSOCIATES.

VICINITY MAP
Scale: 1" = 2000'

CURVE DATA

Rad	Δ	Arc	Tan	Chd	Bearing
702.55	11°56'48"	165.07	83.14	165.57	9.881011°W

LOT AREAS

LOT	GROSS AREA	FLOOD PLAIN	NET AREA
1	4.0109 Ac.	0.1148 Ac.	3.8961 Ac.
2	4.0670 Ac.	0.0000 Ac.	4.0670 Ac.
3	4.1240 Ac.	0.0517 Ac.	4.0723 Ac.
4	8.0522 Ac.	1.1477 Ac.	7.5045 Ac.

OWNER'S ADDRESS:
ROSARIO MARINUCCI
11009 EDMONSTON ROAD
BELTSVILLE, MARYLAND 20705

Owner's Signature: [Signature]
Dated: 12-24-91
see plat # 10174

CERTIFICATE

I, ROSARIO MARINUCCI, OWNER OF THE PROPERTY SHOWN AND DESCRIBED HEREON, ADOPT THIS PLAN OF SUBDIVISION, AND IN CONSIDERATION OF THE APPROVAL OF THIS FINAL PLAN BY THE DEPARTMENT OF PLANNING AND ZONING, ESTABLISH THE MINIMUM BUILDING RESTRICTION LINES AND GRANT UNTO HOWARD COUNTY, MARYLAND, ITS SUCCESSORS AND ASSIGNS (1) THE RIGHT TO LAY, CONSTRUCT AND MAINTAIN SEWERS, DRAINAGE, WATER PIPES AND OTHER MUNICIPAL UTILITIES AND SERVICES, IN AND UNDER ALL ROADS AND STREET RIGHTS OF WAY AND THE SPECIFIC EASEMENT AREAS SHOWN HEREON; (2) THE RIGHT TO REQUIRE DEDICATION FOR PUBLIC USE THE BEDS OF THE STREET AND/OR ROADS AND FLOODPLAINS AND OPEN SPACE WHERE APPLICABLE AND FOR GOOD AND OTHER VALUABLE CONSIDERATION, HEREBY GRANT THE RIGHT AND OPTION TO HOWARD COUNTY TO ACQUIRE THE FEE SIMPLE TITLE TO THE BEDS OF THE STREETS AND/OR ROADS AND FLOODPLAINS STORM DRAINAGE FACILITIES AND OPEN SPACE WHERE APPLICABLE; (3) THE RIGHT TO REQUIRE DEDICATION OF WATERWAYS AND DRAINAGE EASEMENTS FOR THE SPECIFIC PURPOSE OF THEIR CONSTRUCTION, REPAIR AND MAINTENANCE; AND (4) THAT NO BUILDING OR SIMILAR STRUCTURE OF ANY KIND SHALL BE ERRECTED ON, OR OVER THE SAID EASEMENTS AND RIGHTS OF WAY.

WITNESS MY HAND THIS 25th DAY OF MARCH, 1991.

OWNER'S SIGNATURE: [Signature]
ROSARIO MARINUCCI

WITNESS SIGNATURE: [Signature]
Ward D. Kelley

DATE: 6-26-91

Reg. Property Line Surveyor # 900

APPROVED: FOR PRIVATE WATER AND PRIVATE SEWERAGE SYSTEMS, HOWARD COUNTY HEALTH DEPARTMENT.

APPROVED: FOR STORM DRAINAGE SYSTEMS AND PUBLIC ROADS, HOWARD COUNTY DEPARTMENT OF PUBLIC WORKS

DIRECTOR [Signature] **DATE** 12/20/91

DIRECTOR [Signature] **DATE** 12/13/91

APPLICATION

PERCOLATION TESTING

HOWARD COUNTY HEALTH DEPARTMENT
BUREAU OF ENVIRONMENTAL HEALTH
P.O. BOX 476 ELLICOTT CITY, MARYLAND 21043
TELEPHONE 461-9933

A 41160

P _____

DISTRICT 5TH

DATE 3-7-88

TO: THE COUNTY HEALTH OFFICER
ELLICOTT CITY, MARYLAND

I, HEREBY, APPLY FOR THE NECESSARY TEST IN ORDER TO CONSTRUCT (OR RECONSTRUCT) A SEWAGE DISPOSAL SYSTEM.

PROPERTY OWNER RUSS MARINUCCI

ADDRESS 11609 Edmonston Rd. Beltsville MD 20705 PHONE (301) 595-5800

PROSPECTIVE BUYER _____

ADDRESS _____ PHONE _____

PROPERTY LOCATION:

SUBDIVISION Greenbridge Subdivision LOT NO 2

ROAD AND DESCRIPTION Located south of Greenbridge Rd. and North of
Tridelphia Mill Rd.

TAX MAP 28 PARCEL # 58

SIZE OF LOT 4.30 Acres TYPE BLDG SINGLE FAMILY DWLG.
(SINGLE FAMILY DWELLING OR COMMERCIAL)

THE SYSTEM INSTALLED UNDER THIS APPLICATION IS ACCEPTABLE ONLY UNTIL PUBLIC FACILITIES BECOME AVAILABLE. I FULLY UNDERSTAND THE
FEE CONNECTED WITH THE FILING OF THIS PERC TEST APPLICATION IS NON-REFUNDABLE UNDER ANY CIRCUMSTANCES. I ALSO AGREE TO COMPLY
WITH ALL M.O.S.H.A. REQUIREMENTS IN TESTING THIS LOT

R. Marinucci
(SIGNATURE OF APPLICANT)

APPROVED BY _____ FOR _____ DATE _____

REJECTED BY _____ FOR _____ DATE _____

HOLD PENDING FURTHER TESTS _____ DATE _____

REASONS FOR REJECTION OR HOLDING 6-10-88 Pending perc hole locations and
plat approval JEN.

HD-216

THIS IS NOT A PERMIT

High

4
3
1
2

(A 41160)

Greenbridge Road

Low

①

SOIL PROFILE

0-5.5

Rd-br
scllm,
trc gul

5.5-12.5

Br mica
sa si
lm
little
saprolite
L 20%

12.5

Bottom

④

0-4.5


Rd-br
scllm

4.5-11.5

Br mica
sa si
lm,
L 20%
saprolite

11.5

Bottom

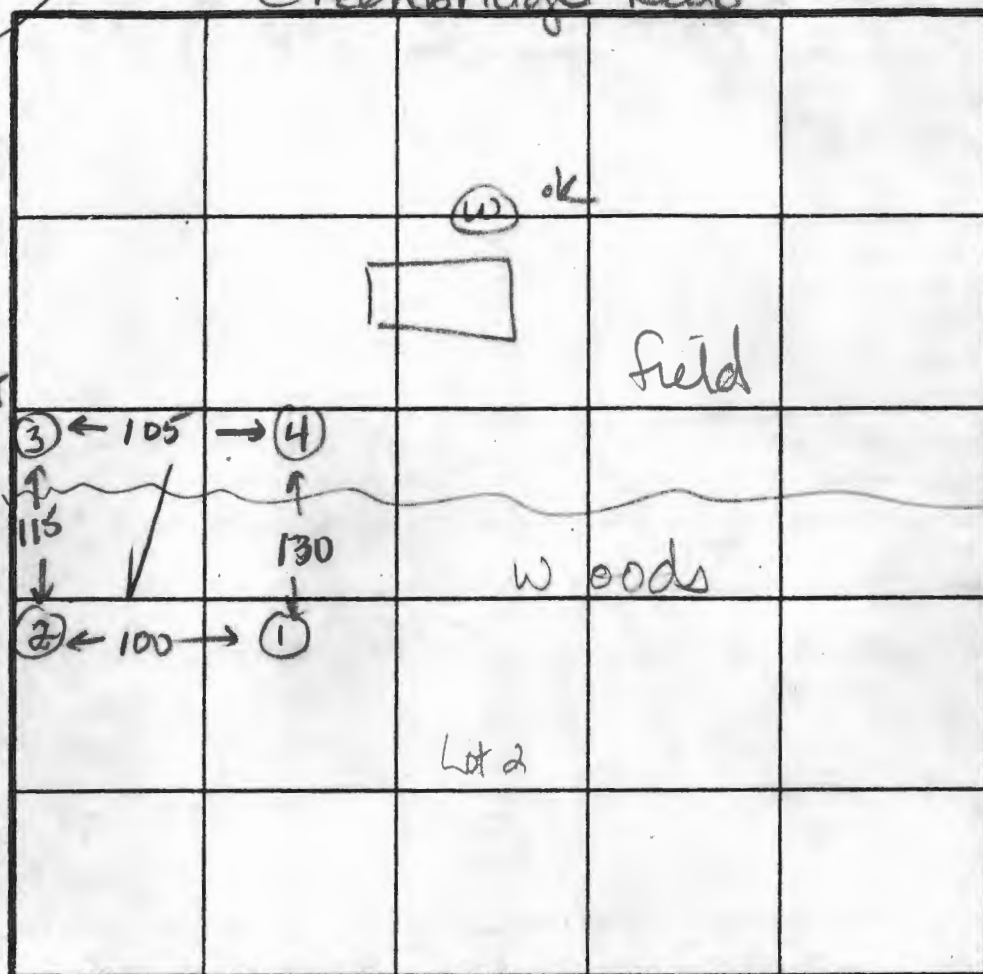

INDICATE NORTH - NAME ADJOINING ROADWAY AS BASE LINE.

DATE	TEST NO.	DEPTH	PRE-WET		TEST - 1" DROP		TIME
			START	STOP	START	STOP	
6-9-88	1	5.5 S	2:49	2:51	2:51	2:54	3min
		7.5 M	2:48	2:50	2:50	2:53	3min
		12.5 D	Bottom (see profile)				ok
	4	3.5 S	3:04	3:07	3:07	3:11	4min
		7.0 M	3:05	3:07	3:07	3:09	2min
		11.5 D	Bottom (see profile)				ok
	3	see Lot 1					ok
	2	see Lot 1					ok

REMARKS

All holes as shown on plat.

TYPE OF SOIL

0-5 Rd-br scllm 5-12 Br mica sa si lm,
L 20% saprolite

TESTED BY

J E Nadeau

ALSO PRESENT

Carl
Duncan

APPLICATION

PERCOLATION TESTING

A 41162

P _____

DISTRICT 5TH

DATE 3-7-88

HOWARD COUNTY HEALTH DEPARTMENT
BUREAU OF ENVIRONMENTAL HEALTH
P.O. BOX 476 ELLICOTT CITY, MARYLAND 21043
TELEPHONE 461-9933

TO: THE COUNTY HEALTH OFFICER
ELLICOTT CITY, MARYLAND

I, HEREBY, APPLY FOR THE NECESSARY TEST IN ORDER TO CONSTRUCT (OR RECONSTRUCT) A SEWAGE DISPOSAL SYSTEM.

PROPERTY OWNER RUSS MORINUCCI

ADDRESS 11609 Edmonston Rd. Beltsville MD 20705 PHONE (301) 595-5800

PROSPECTIVE BUYER _____

ADDRESS _____ PHONE _____

PROPERTY LOCATION:

SUBDIVISION Greenbridge Subdivision LOT NO A New Lot 5

ROAD AND DESCRIPTION Located south of Greenbridge Rd. and North of
Tridelphia Mill Rd.

TAX MAP 28 PARCEL # 58

SIZE OF LOT 4.53 Acres TYPE BLDG SINGLE FAMILY DWLG.
(SINGLE FAMILY DWELLING OR COMMERCIAL)

THE SYSTEM INSTALLED UNDER THIS APPLICATION IS ACCEPTABLE ONLY UNTIL PUBLIC FACILITIES BECOME AVAILABLE. I FULLY UNDERSTAND THE
FEE CONNECTED WITH THE FILING OF THIS PERC TEST APPLICATION IS NON-REFUNDABLE UNDER ANY CIRCUMSTANCES. I ALSO AGREE TO COMPLY
WITH ALL M.O.S.H.A. REQUIREMENTS IN TESTING THIS LOT

(SIGNATURE OF APPLICANT)

APPROVED BY _____ FOR _____ DATE _____

REJECTED BY _____ FOR _____ DATE _____

HOLD PENDING FURTHER TESTS _____ DATE _____


REASONS FOR REJECTION OR HOLDING 5-20-88 Pending perc hole locations and subdivision
plat approval, JEN

THIS IS NOT A PERMIT

A 41162

SOIL PROFILE

0-4.0	Red br si cl lm, some broken rock
4.0-11.0	Tan micaceous sa si lm, some saponite 2-4%, little broken rock pieces
11.0	~ 30% some folict structure to bedding Refusal

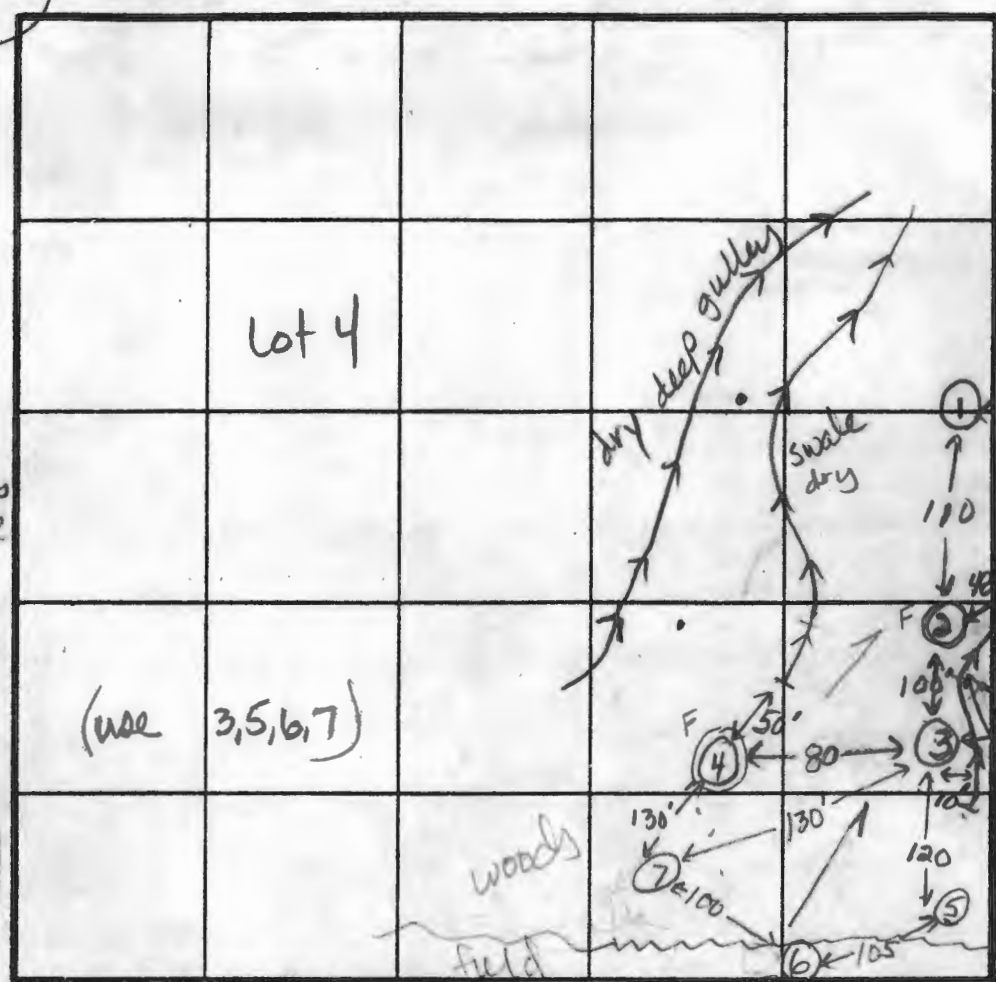

INDICATE NORTH - NAME ADJOINING ROADWAY AS BASE LINE

Greenbridge Road (W) 150'

PREF. WET

TES

②

0-5.5 Red-br
silt lm,
some
broken rock
L 10%,
5.5-11.0 Gray mica-
ceous sa
silt lm, some
broken rock
with relict
structure
apparent
at 6.0 ft.,
L 25% rock
11.0 Refusal

DATE	TEST NO.	DEPTH	PRE-WET		TEST - 1" DROP		TIME
			START	STOP	START	STOP	
5-20-88	1	5.0 S	10:49	10:51	10:51	10:57	6 min
		9.0 M	10:47	10:53	10:53	11:06	13 min
		11.0 D	Refusal at 11.0 ft.				OK
	2	11.0 V	Refusal at 11.0 ft				<u>Failed</u>
	3	5.0 S	12:18	12:20	12:20	12:25	5 min
		9.0 M	12:19	12:23	12:23	12:28	5 min
		13.0 D	Bottom				OK
	(4)	4.5 S	1:41	1:56	no movement		<u>Failed</u>
		7.5' M	1:49	2:04	moved hard bottom, 1/4 in		<u>Failed</u>
V		11.0 D	Refusal at 11.0 ft. structure at 8'				<u>Failed</u>

shallow
System
only
4-6'
JK

REMARKS All holes moved from plat location.

TYPE OF SOIL 0-5 Rd br ss cl lm, 5-11 Rd-br mica ss sl lm, <20% rock

TESTED BY Jane Nadeau ALSO PRESENT Carl (engineer)
Duncan

APPLICATION

PERCOLATION TESTING

HOWARD COUNTY HEALTH DEPARTMENT
BUREAU OF ENVIRONMENTAL HEALTH
P.O. BOX 476 ELLICOTT CITY, MARYLAND 21043
TELEPHONE: 461-9933

A 41162

P _____

DISTRICT 5TH

DATE 3-7-88

TO: THE COUNTY HEALTH OFFICER
ELLICOTT CITY, MARYLAND

I, HEREBY, APPLY FOR THE NECESSARY TEST IN ORDER TO CONSTRUCT (OR RECONSTRUCT) A SEWAGE DISPOSAL SYSTEM.

PROPERTY OWNER RUSS MABINUCCI

ADDRESS 11609 Edmonston Rd. Beltsville MD 20705 PHONE (301) 595-5800

PROSPECTIVE BUYER _____

ADDRESS _____ PHONE _____

PROPERTY LOCATION:

SUBDIVISION Greenbridge Subdivision LOT NO. 4 New Lot-5

ROAD AND DESCRIPTION Located south of Greenbridge Rd. and North of
Tridelphia Mill Rd.

TAX MAP 28 PARCEL # 58

SIZE OF LOT 4.53 Acres TYPE BLDG SINGLE FAMILY DWLG.
(SINGLE FAMILY DWELLING OR COMMERCIAL)

THE SYSTEM INSTALLED UNDER THIS APPLICATION IS ACCEPTABLE ONLY UNTIL PUBLIC FACILITIES BECOME AVAILABLE. I FULLY UNDERSTAND THE
FEE CONNECTED WITH THE FILING OF THIS PERC TEST APPLICATION IS NON-REFUNDABLE UNDER ANY CIRCUMSTANCES. I ALSO AGREE TO COMPLY
WITH ALL M.O.S.H.A. REQUIREMENTS IN TESTING THIS LOT.

[Signature]
(SIGNATURE OF APPLICANT)

APPROVED BY _____ FOR _____ DATE _____

REJECTED BY _____ FOR _____ DATE _____

HOLD PENDING FURTHER TESTS _____ DATE _____

REASONS FOR REJECTION OR HOLDING _____

HD-216

THIS IS NOT A PERMIT

A41162

(3)
SOIL PROFILE

0-4.5

Rd-br
scllm,
little
broken
rock
< 5%

4.5-13.0


Tan micaceous
sandy silty
loam,
little decomp
rock pieces,
< 15%,
slight
relict

structure
apparent
Bottom

13.0

(4)

0-5.0' Br scl
loam, < 10%
rock pieces
5.0' - 11.0' Br-gray
micaceous
sasi lm,
some
broken
rock
pieces, < 25%,
with
slight
relict
structure
apparent
at B.S. in
11.0' Refusal

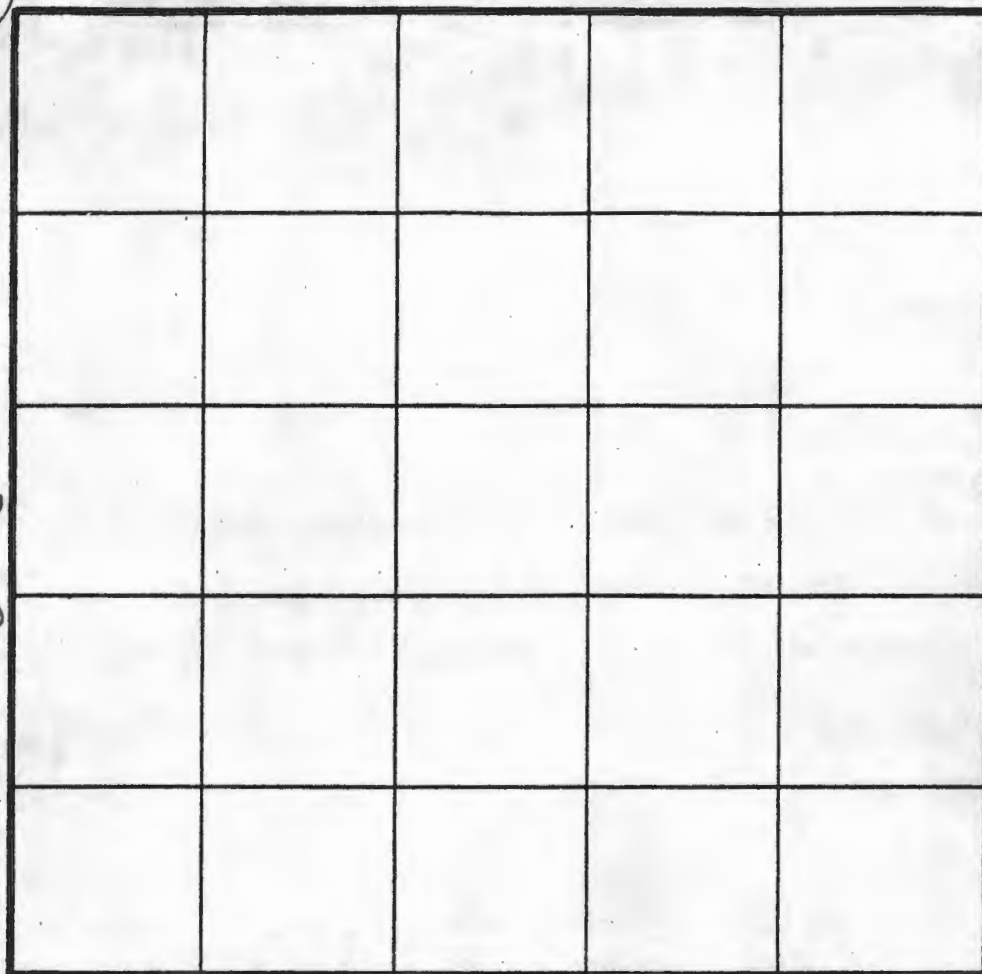

INDICATE NORTH - NAME ADJOINING ROADWAY AS BASE LINE.

(5)

0-4. Rd-br
mica sa
scllm

4-10 Rd-br
mica
sasi lm,
< 20%
saprolite

10-13 Br sandy
loam

13.0 Bottom

(6)

0-5.5 Br si
cllm

5.5-13.0 Br mica
sa scllm,
< 20%
saprolite
tr of
relict
structure

13.0 Bottom

(7)

0-6.0 Rd si
cllm,
tr
rock

6-13 Rd-br
mica
sasi
lm,
< 30%
saprolite
tr of
relict
structure

13.0 Bottom

DATE	TEST NO.	DEPTH	PRE-WET		TEST - 1" DROP		TIME
			START	STOP	START	STOP	
5-20-88	5	5.0 S	2:25	2:27	2:27	2:30	3min
		7.5 M	2:28	3:32	3:32	3:38	6min
		13.0 D	Bottom				ok
	6	4.5 S	2:50	2:52	2:52	2:54	2min
		13.0 D	Bottom				ok
	7	5.0 S	3:19	3:23	3:23	3:29	6min
		13.0 D	Bottom				ok

REMARKS

TYPE OF SOIL

TESTED BY

ALSO PRESENT

Preliminary
Aug 22 1988
1:30pm

APPLICATION

PERCOLATION TESTING

A 41163

P _____

HOWARD COUNTY HEALTH DEPARTMENT
BUREAU OF ENVIRONMENTAL HEALTH
P.O. BOX 476 ELLICOTT CITY, MARYLAND 21043
TELEPHONE 461-9933

DISTRICT _____

DATE _____

TO: THE COUNTY HEALTH OFFICER
ELLICOTT CITY, MARYLAND

I, HEREBY, APPLY FOR THE NECESSARY TEST IN ORDER TO CONSTRUCT (OR RECONSTRUCT) A SEWAGE DISPOSAL SYSTEM.

PROPERTY OWNER Russ Mariaucci

ADDRESS 11609 Edmonston Rd Beltsville MD 20705 PHONE 595-5806

ENGINEER ENGINEERING TECHNOLOGIES ASSOC. INC
~~PROSPECTIVE BUYER~~

ADDRESS 3958 Ellicott Center Drive Suite 101 Ellicott City MD 21093 PHONE 461-9920
Please contact Carl DUNCAN

PROPERTY LOCATION:

SUBDIVISION Greenbridge LOT NO NEW 3

ROAD AND DESCRIPTION Adjacent to Greenbridge Rd

TAX MAP 28 PARCEL # 58

SIZE OF LOT 3.76 Ac. TYPE BLDG Single Family Dwelling
(SINGLE FAMILY DWELLING OR COMMERCIAL)

THE SYSTEM INSTALLED UNDER THIS APPLICATION IS ACCEPTABLE ONLY UNTIL PUBLIC FACILITIES BECOME AVAILABLE. I FULLY UNDERSTAND THE

FEE CONNECTED WITH THE FILING OF THIS PERC TEST APPLICATION IS NON-REFUNDABLE UNDER ANY CIRCUMSTANCES. I ALSO AGREE TO COMPLY

WITH ALL M.O.S.H.A. REQUIREMENTS IN TESTING THIS LOT. [Signature]
(SIGNATURE OF APPLICANT)

APPROVED BY _____ FOR _____ DATE _____

REJECTED BY _____ FOR _____ DATE _____

HOLD PENDING FURTHER TESTS C-10-88 NOT PERCED, JEN DATE _____

REASONS FOR REJECTION OR HOLDING 8-22-88 Hold for minor sub plat approval and
perc hole locations. May not have 10,000 sq ft. OK to move uphill.
20 ft, SHALLOW SYSTEM ONLY. JEN

HD-216

THIS IS NOT A PERMIT


High 1
2
3
Low 4

A 41163

(A 41160)
Lot-2

②
SOIL PROFILE

0-3' Br sicl
loam,
3'-14.0' Br mica
sa silm,
~20%
saprolite,
trace of
near
horizontal
bedding
14.0' Bottom

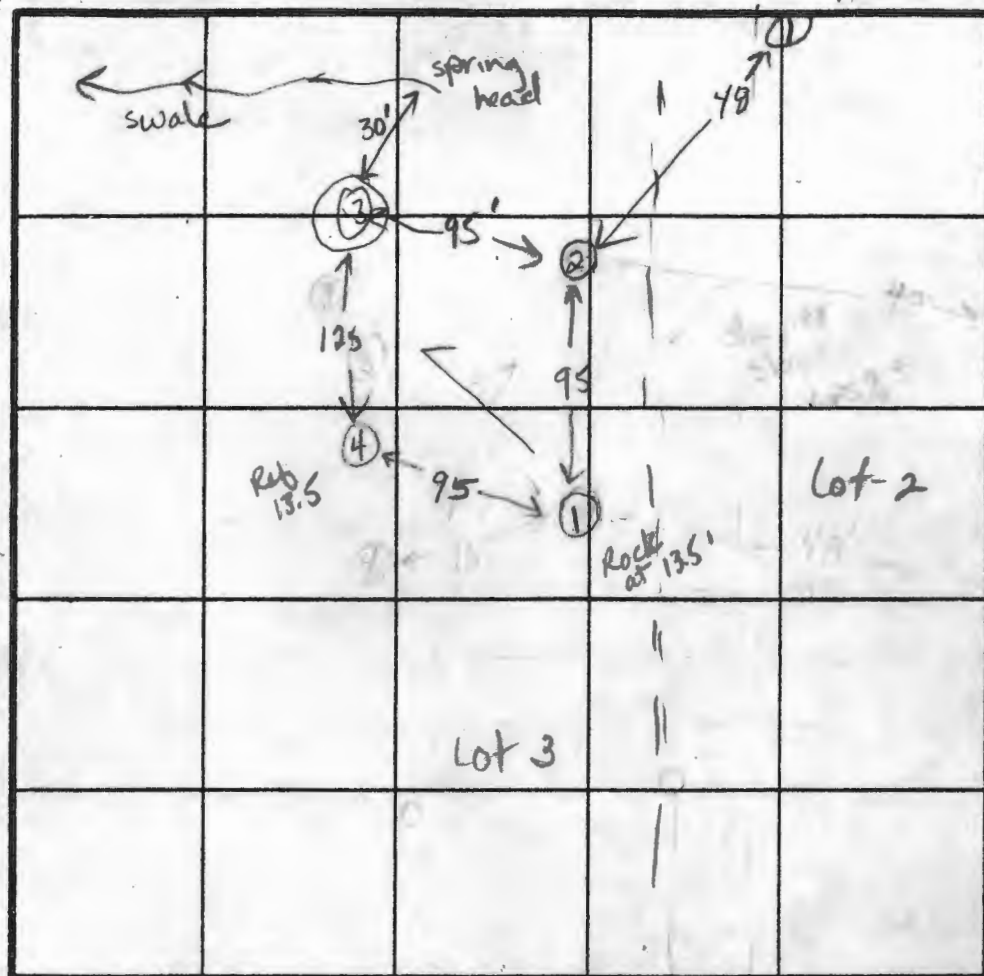

③
0-4.0' Br sicl
lm, some
broken
rock
~25%
4-13.5' Rd-br
mica sa
silim,
~40%
saprolite,
near
horizontal
bedding
at 5'
13.5' Refusal

$\bar{x} = 8$ min
Inlet = 4.5'
Bottom 6'

INDICATE NORTH - NAME ADJOINING ROADWAY AS BASE LINE.

Greenbridge Road

DATE	TEST NO.	DEPTH	PRE-WET		TEST - 1" DROP		TIME
			START	STOP	START	STOP	
8-22-89	2	4.0' S	2:12	2:13	2:13	2:15	2min
		8.0' M	2:19	2:20	2:20	2:24	4min
		14.0' D (see profile)					ok
	1	3.5' S	2:45	2:55	2:55	3:25	3 1/4 min
		6.5' S	3:30	3:31	3:31	3:33	2min
		8.0' M	2:41	2:48	2:48	2:58	10min
		13.0' D (see profile - Rocky bottom)					ok
	4	4.5' S	3:16:58	3:18:58	3:18:58	3:25	7min
		7.5' M	3:13	3:14	3:14	3:16	2min
		13.5' D (see profile - Refusal at 13.5)					ok
	③	4.0' S	3:43	4:11			slow failed
		8.0' M	3:49:35	3:49:38	3:49:38	3:49:48	4 sec fast-failed
		7.5' M	4:01	4:05	4:05	4:17	12min
		13.5' D (see profile - Refusal at 13.5)					ok

slow
loose soil
avg 10 min

REMARKS

All holes different from plat (slightly) ONLY SHALLOW SYSTEM

TYPE OF SOIL

0-4' Br sicl lm, 4-13' Rd-br mica sa silm, ~30% saprolite

TESTED BY

JE Nadeau

ALSO PRESENT

Mr Collins
Carl Duncan, engineer

①
0-5.0' Br sicl
lm, little
sa ~10%

5.0-10.0' Rd-br
mica sa
silim,
~25%
saprolite.
10-13.0' Saprolite
w/ 30%
broken
rock
13.0' Bottom

④
0-30' Br sicl
lm, some
broken
rock, ~20%

30-13.5' Brown mica
sa silm
~30%
saprolite,
trc of
bedding at
13.5' Refusal

COPY @ 140%
to obtain
1:100 scale

PAUL E. BLANCHARD
F. 434
L. 313

MARTIN THALER
L. 498
F. 543

o Holes to be tested

Greenbridge Sub.
Greenbridge Road
Lots 1-5

