

APPLICATION

SEWAGE DISPOSAL TESTING

STATE OF MARYLAND - DEPARTMENT OF HEALTH AND MENTAL HYGIENE

HOWARD COUNTY HEALTH DEPARTMENT
ENVIRONMENTAL HEALTH SERVICES

P. O. BOX 473 ELLICOTT CITY, MARYLAND 21043
TELEPHONE: 992-2330

A 39144

P _____

DISTRICT 54

DATE 3/10/87

TO: THE COUNTY HEALTH OFFICER
ELLICOTT CITY, MARYLAND

I, HEREBY, APPLY FOR THE NECESSARY TEST IN ORDER TO CONSTRUCT (OR RECONSTRUCT) A SEWAGE DISPOSAL SYSTEM.

PROPERTY OWNER DR. FRED LEWIS + C. Ellsworth Jeger

ADDRESS 1001 ROUTE 108 COLUMBIA, MARYLAND 21044 PHONE 730-6062

PROPERTY LOCATION:

SUBDIVISION CLARKSVILLE MANOR / LEWIS PROPERTY LOT NO. LOT 6

ROAD AND DESCRIPTION NORTH OF TEN OAKS ROAD AND SOUTH OF MD. ROUTE 32

SIZE OF LOT PLEASE ATTACHED LIST 3.25 ACRES TYPE BLDG. RESIDENTIAL PROPOSED
(NUMBER OF BEDROOMS)

THE SYSTEM INSTALLED UNDER THIS APPLICATION IS ACCEPTABLE ONLY UNTIL PUBLIC FACILITIES BECOME AVAILABLE. I FULLY UNDERSTAND THE FEE CONNECTED WITH THE FILING OF THIS PERC TEST APPLICATION IS NON-REFUNDABLE UNDER ANY CIRCUMSTANCES. I ALSO AGREE TO COMPLY WITH ALL M.O.S.H.A. REQUIREMENTS IN TESTING THIS LOT.

C. Ellsworth Jeger
(SIGNATURE OF APPLICANT)

APPROVED BY _____ FOR _____ DATE _____

REJECTED BY _____ FOR _____ DATE _____

HOLD PENDING FURTHER TESTS _____ DATE _____

REASONS FOR REJECTION OR HOLDING 6-10-87 PERC SATISFACTORY - HOLD FOR SUBDIVISION PLAT - S.A.W.

THIS IS NOT A PERMIT


SOIL PROFILE

AP

10' Yellow BA Silty CLAY LOAM MANY SURFACE STONE 10-20%

4' Yellow BA Silty LOAM 10-15% FRAGS

12'

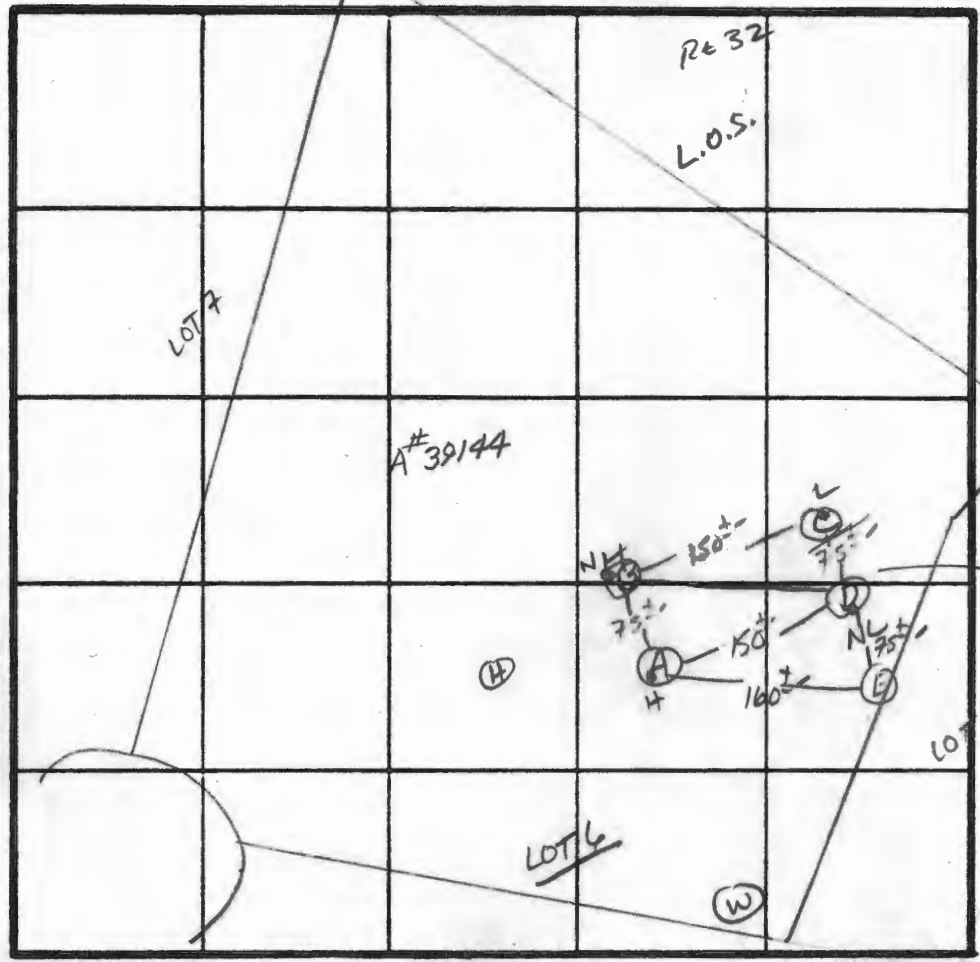

2 Pore MIN

ϕ 1/8"

Inlet - 3

Bottom - 5

WATER AT 11.5/12'

INDICATE NORTH - NAME ADJOINING ROADWAY AS BASE LINE.

↓ TEN OAKS TR

AP

8' BROWN Silty CLAY LOAM 10-15% FRAGS

3' Yellow Brown TO BA. Silty LOAM w/ WHITE veins SAND LOAM 10-15% FRAGS

12'

DATE	TEST NO.	DEPTH	PRE-WET		TEST - 1" DROP		TIME
			START	STOP	START	STOP	
6/10/67	A ^S _M	4"	2:48	2:50	2:50	2:54	4 MIN
		8"	2:46	2:49	2:49	2:53	4 MIN
	A ^V	12"	UNIFORM soil below 4"				
	B ^V	12"	UNIFORM soil below 3"				
	C ^V						
	D ^S	3"	3:07	3:11	3:11	3:18	7 MIN
	D ^V	12"	UNIFORM soil below 2.5" soil		Wet at 12" same as (B)		
	E ^S	3.5"	3:26	3:27	3:27	3:30	3 MIN
	E ^V	12"	UNIFORM soil below 3.0" similar to D Above				

WATER AT 11.5/12'

REMARKS Holes per Plat - Shallow Syst. Only

TYPE OF SOIL MANOK - Glemelg


TESTED BY S. Abel ALSO PRESENT CRBS, Roky, JANE

EM 12 10/9

NEED REFERENCE
PLAT NO. 29379
26192

NO. 32⁴⁴⁰

P-88-65

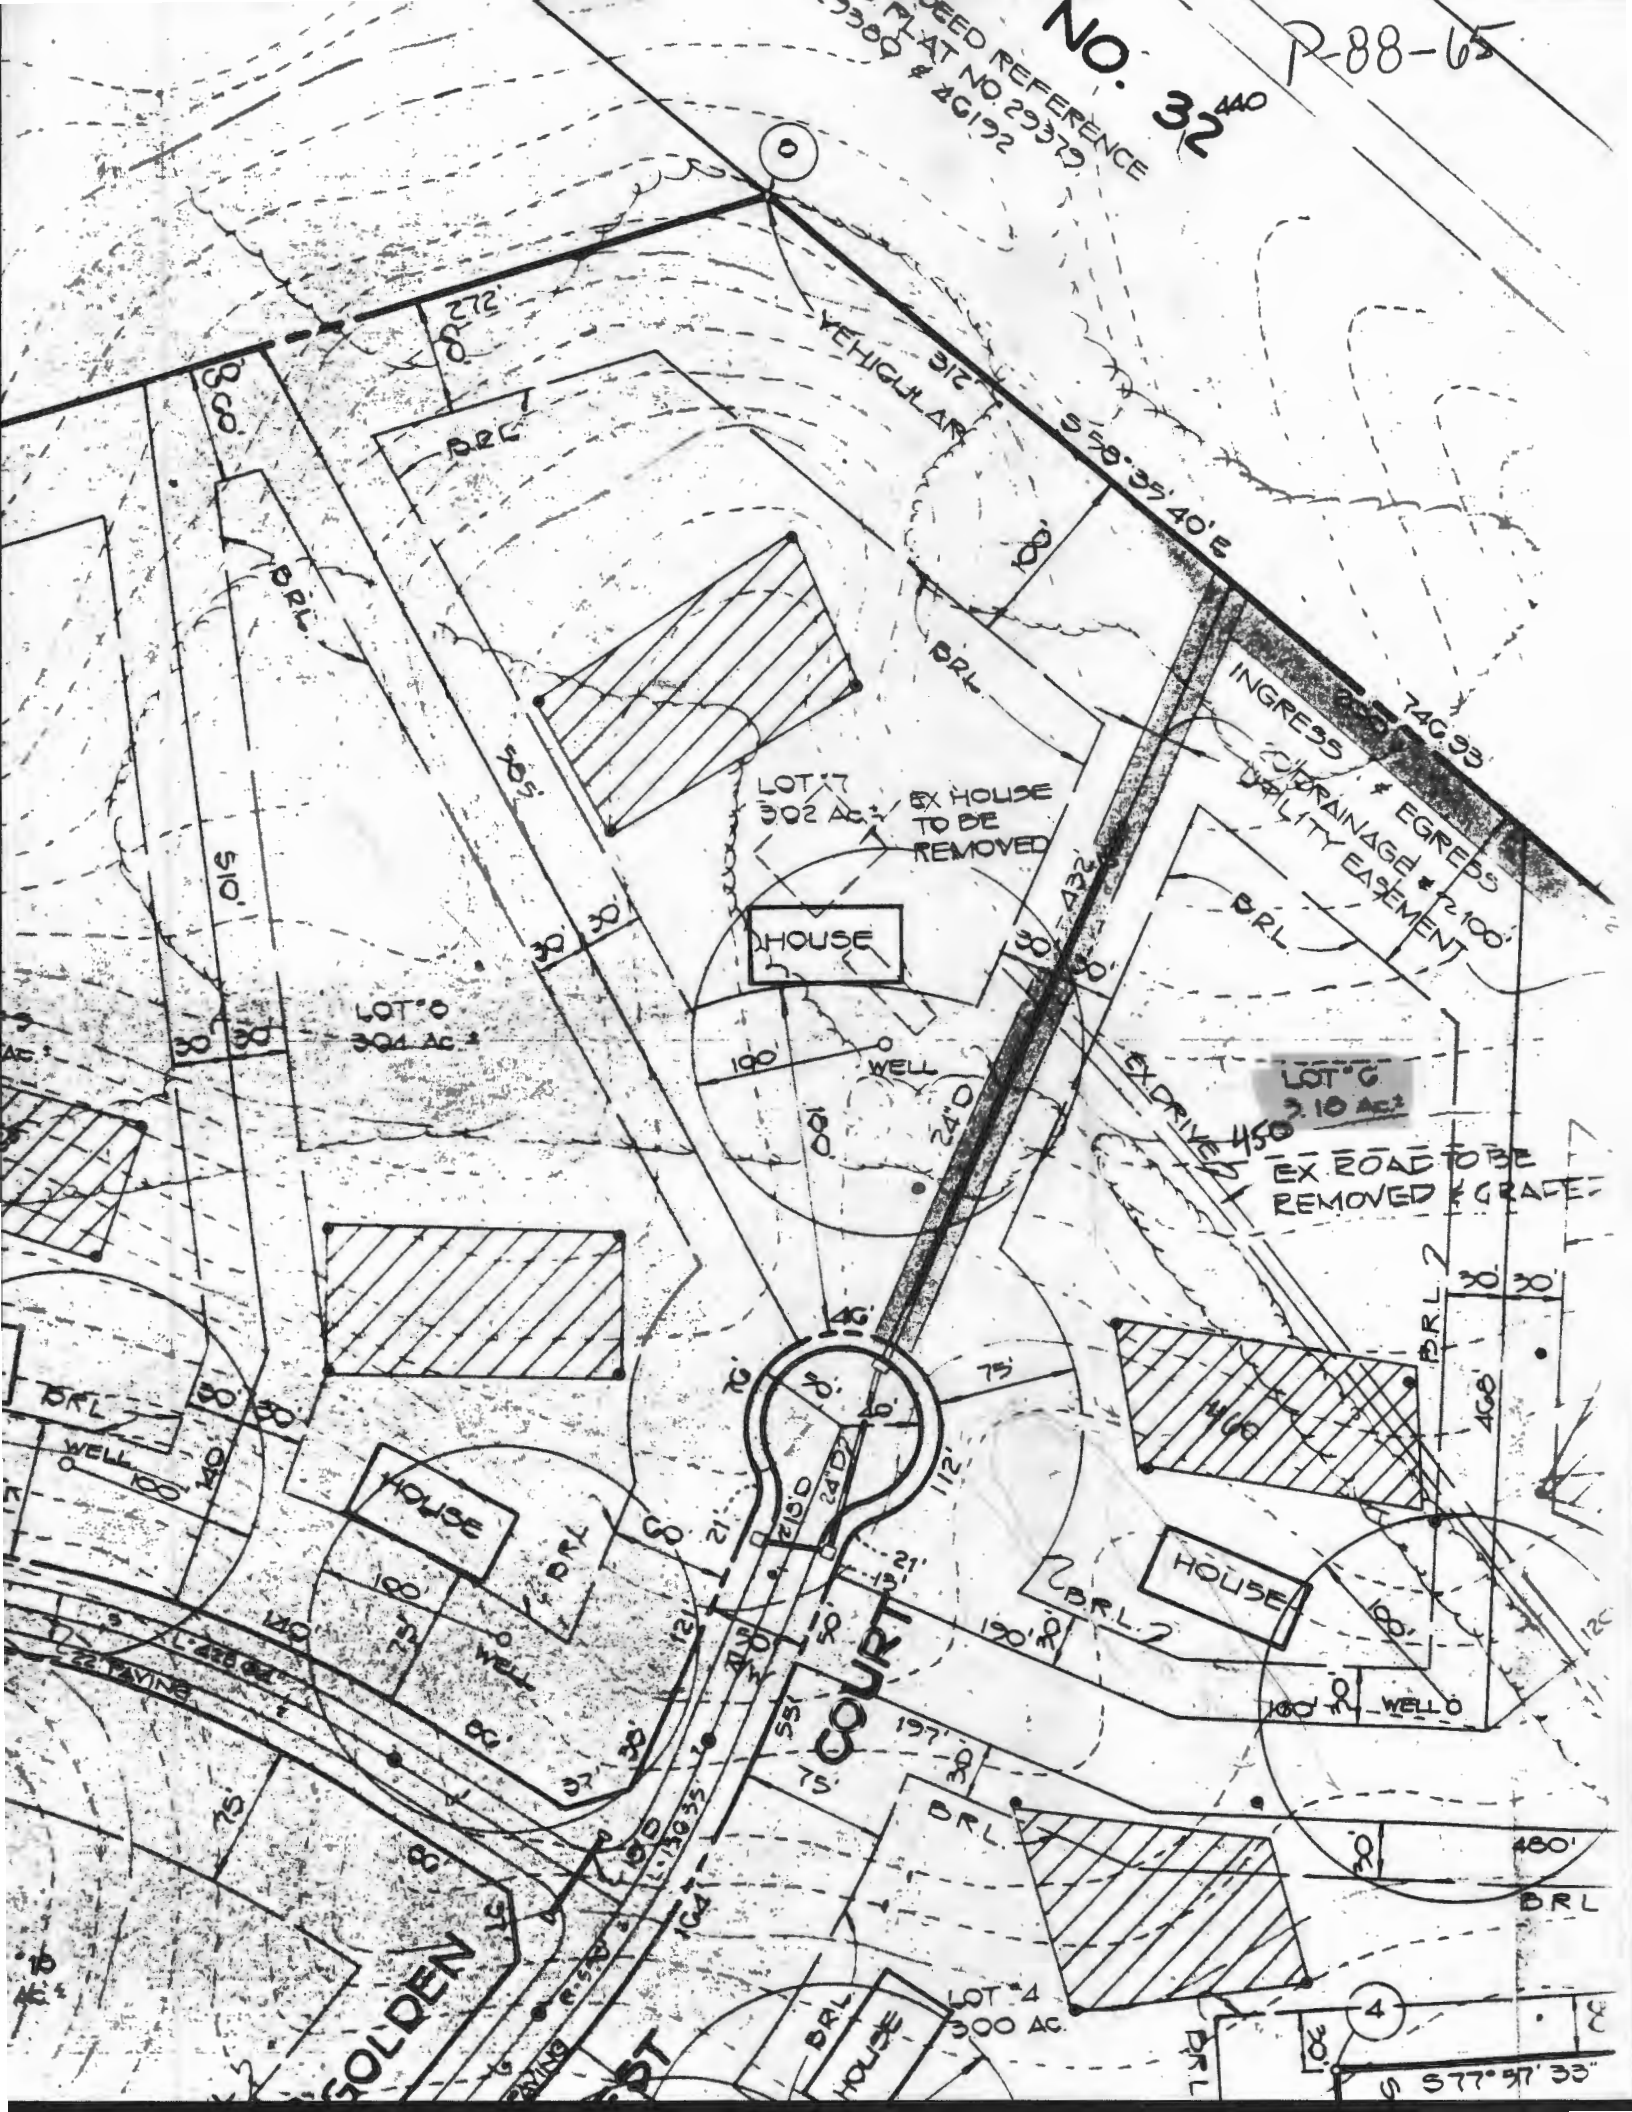


MD. ROUTE

NO. 32

VICINITY MAP

SCALE: 1" = 200'

S.R.G. PLAT NO'S 2937, 2938 & 46192

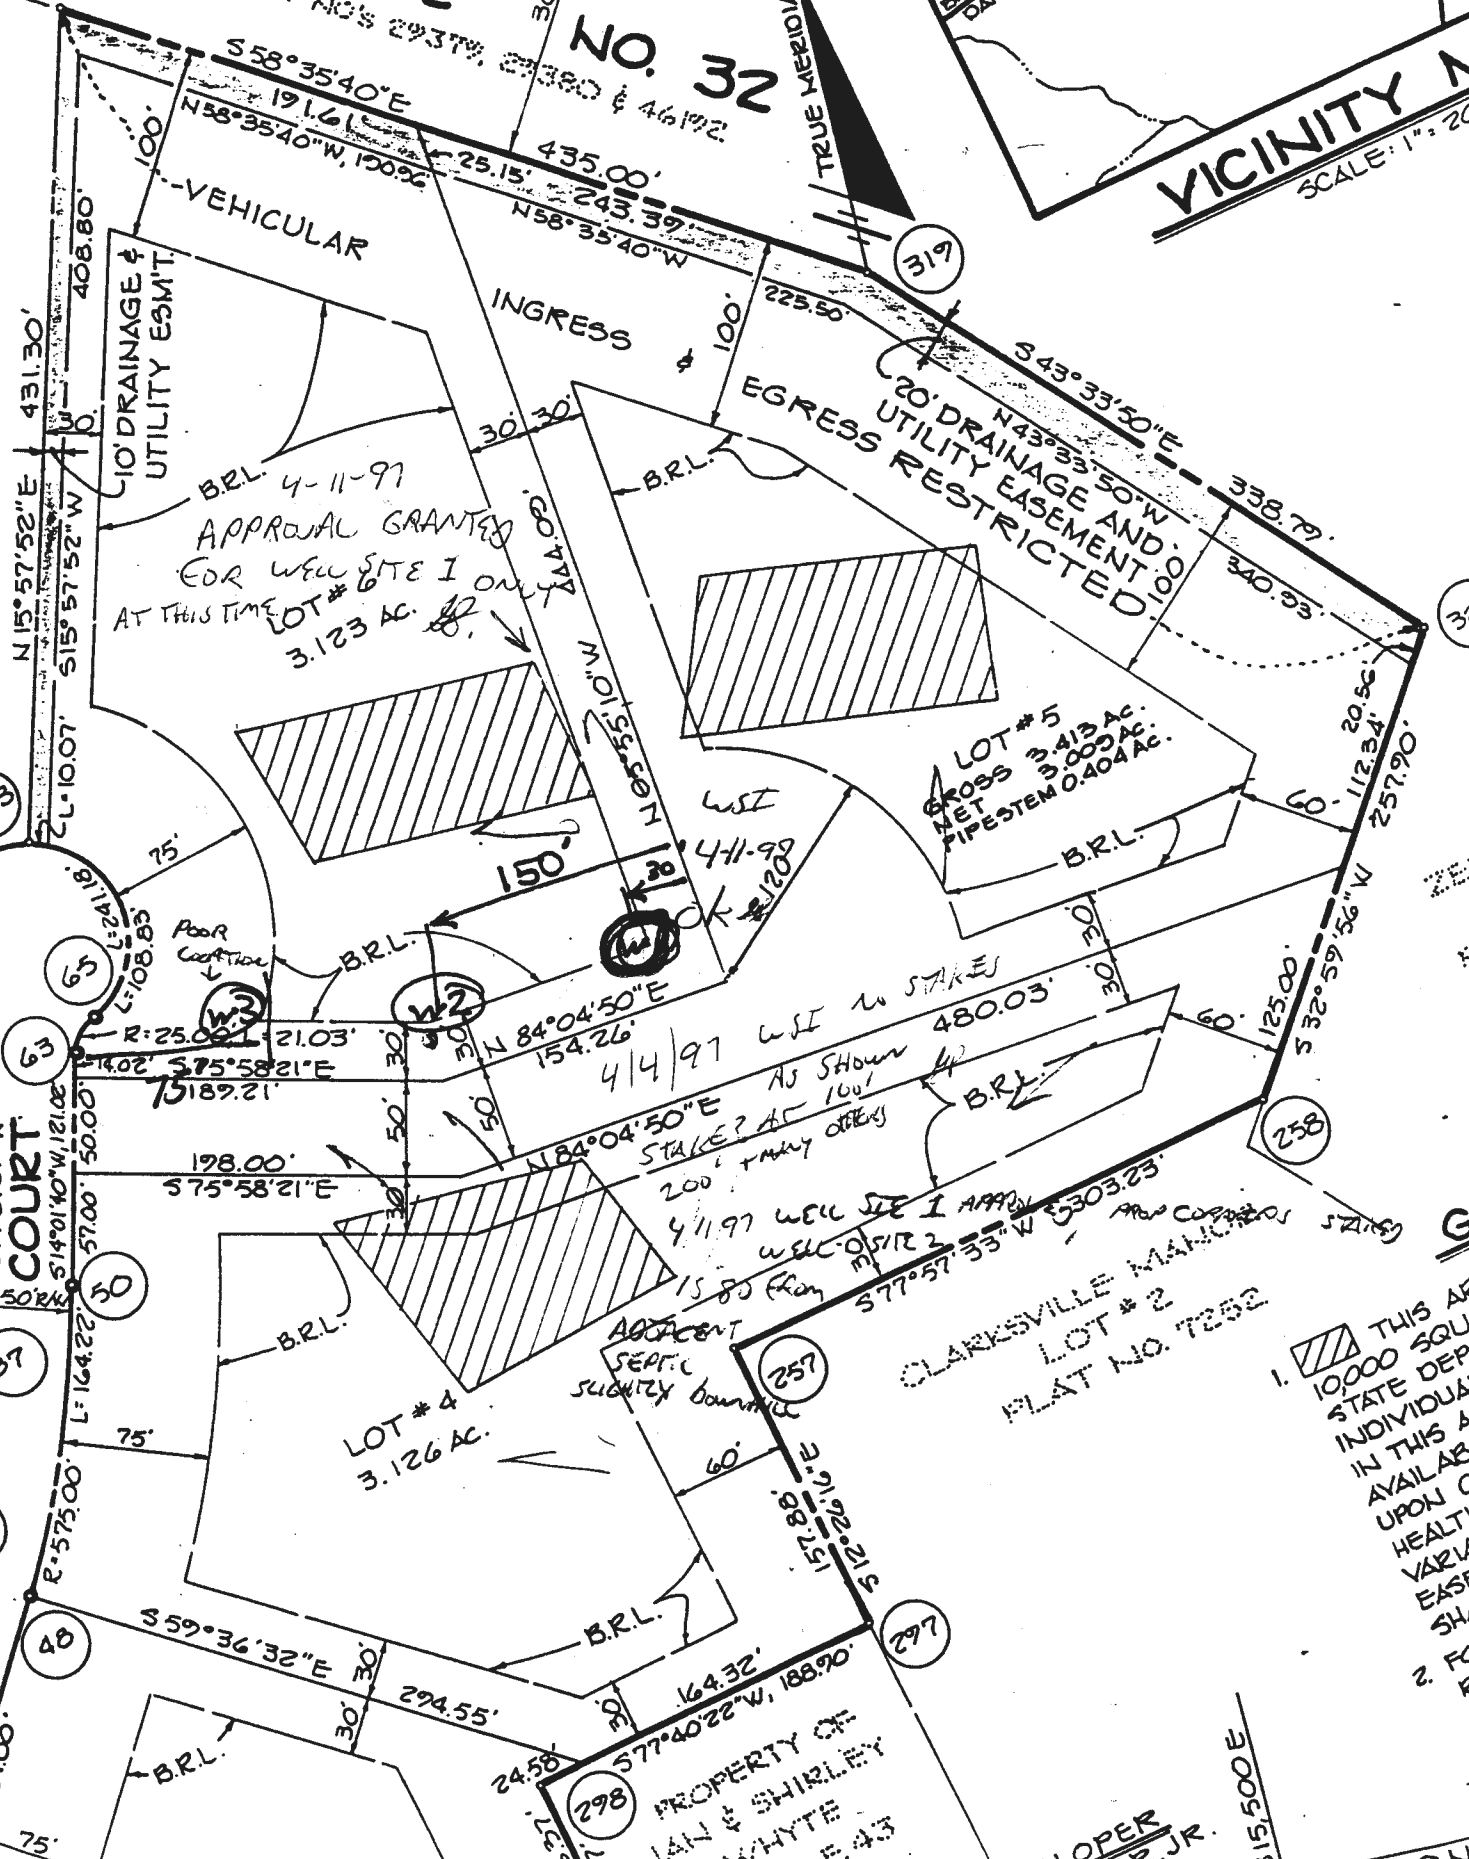

B.R.L. 4-11-97
 APPROVAL GRANTED
 FOR WELL SITE 1 ONLY
 AT THIS TIME
 LOT # 6
 3.123 AC.

LOT # 5
 GROSS 3.413 AC.
 NET 3.000 AC.
 PIPESTEM 0.404 AC.

LOT # 4
 3.126 AC.

4/14/97 WSI IN STAKES
 AS SHOWN
 100' STAKE? AT 100' RANKY OFFERS
 4/11/97 WELL SITE 1 APPROVED
 WELL OFFER 2

CLARKSVILLE MANHOLE
 LOT # 2
 PLAT NO. 7252

PROPERTY OF
 IAN & SHIRLEY
 WHITE
 F.43

- THIS AREA 10,000 SQUARE FEET STATE DEPARTMENT INDIVIDUALS IN THIS AREA AVAILABLE UPON COMPLIANCE WITH HEALTH DEPARTMENT VARIANCE EASEMENT SHALL
- FOR REVIEW
-

DEPT
 PL

GE

3.


1000 N

6.60	N 30°02'08"E
38.16	N 16°06'37"E
20.41	N 10°03'59"W
94.01	N 35°54'03"E
72.80	S 05°54'34"E
66.67	S 15°58'20"E
20.41	S 38°07'20"W
63.67	S 22°12'33"W
62.35	S 09°14'33"W

F-89-33

FOR CONTINUATION SEE SHEET 2 OF 3

STATE ROUTE NO. 32
 S.R.G. FLAT NO'S 29379, 29380 & 46192
 300' R/W

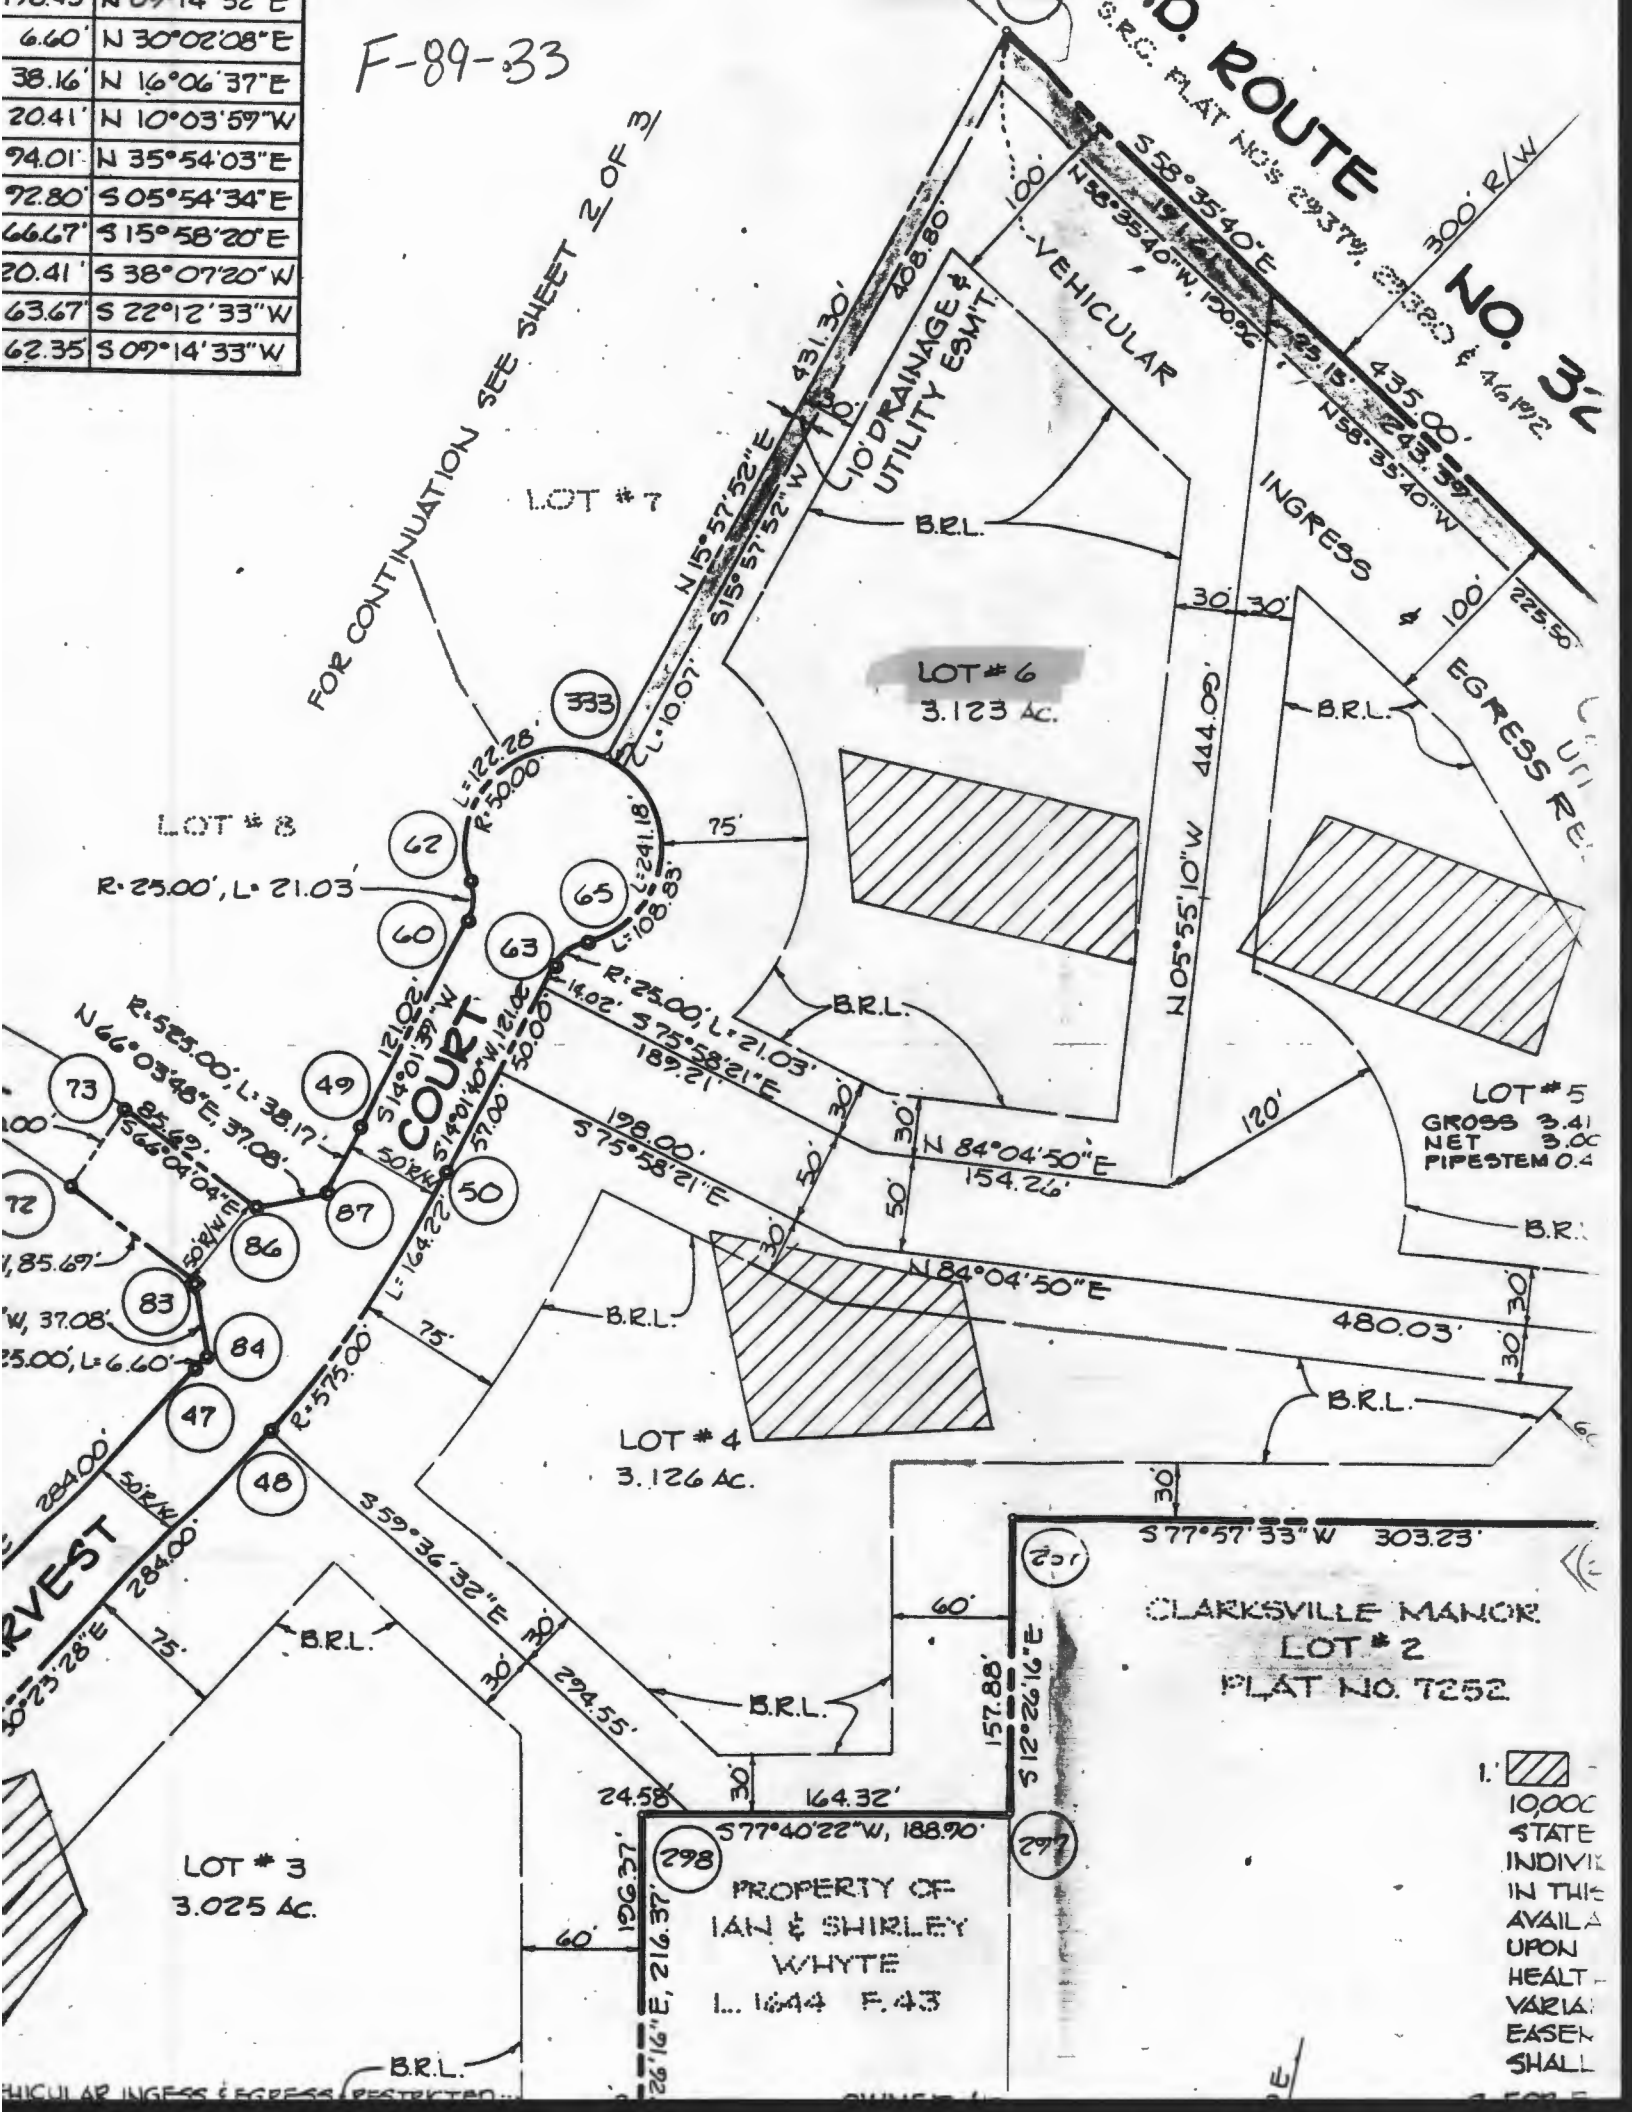

LOT # 7

LOT # 6
3.123 AC.

LOT # 8

R. 23.00', L. 21.03'

COURT

LOT # 5
GROSS 3.41
NET 3.00
PIPESTEM 0.4

LOT # 4
3.126 AC.

LOT # 3
3.025 AC.

CLARKSVILLE MANOR
LOT # 2
PLAT NO. 7252


PROPERTY OF
IAN & SHIRLEY
WHYTE
L. 1644 F. 43

1. [Hatched Box] 10,000 STATE INDIVIDUAL IN THIS AVAILABILITY UPON HEALTH VARIATIONS SHALL

DEED REFERENCE
PLAT NO. 29379
46192

NO. 32⁴⁴⁰

P-88-65

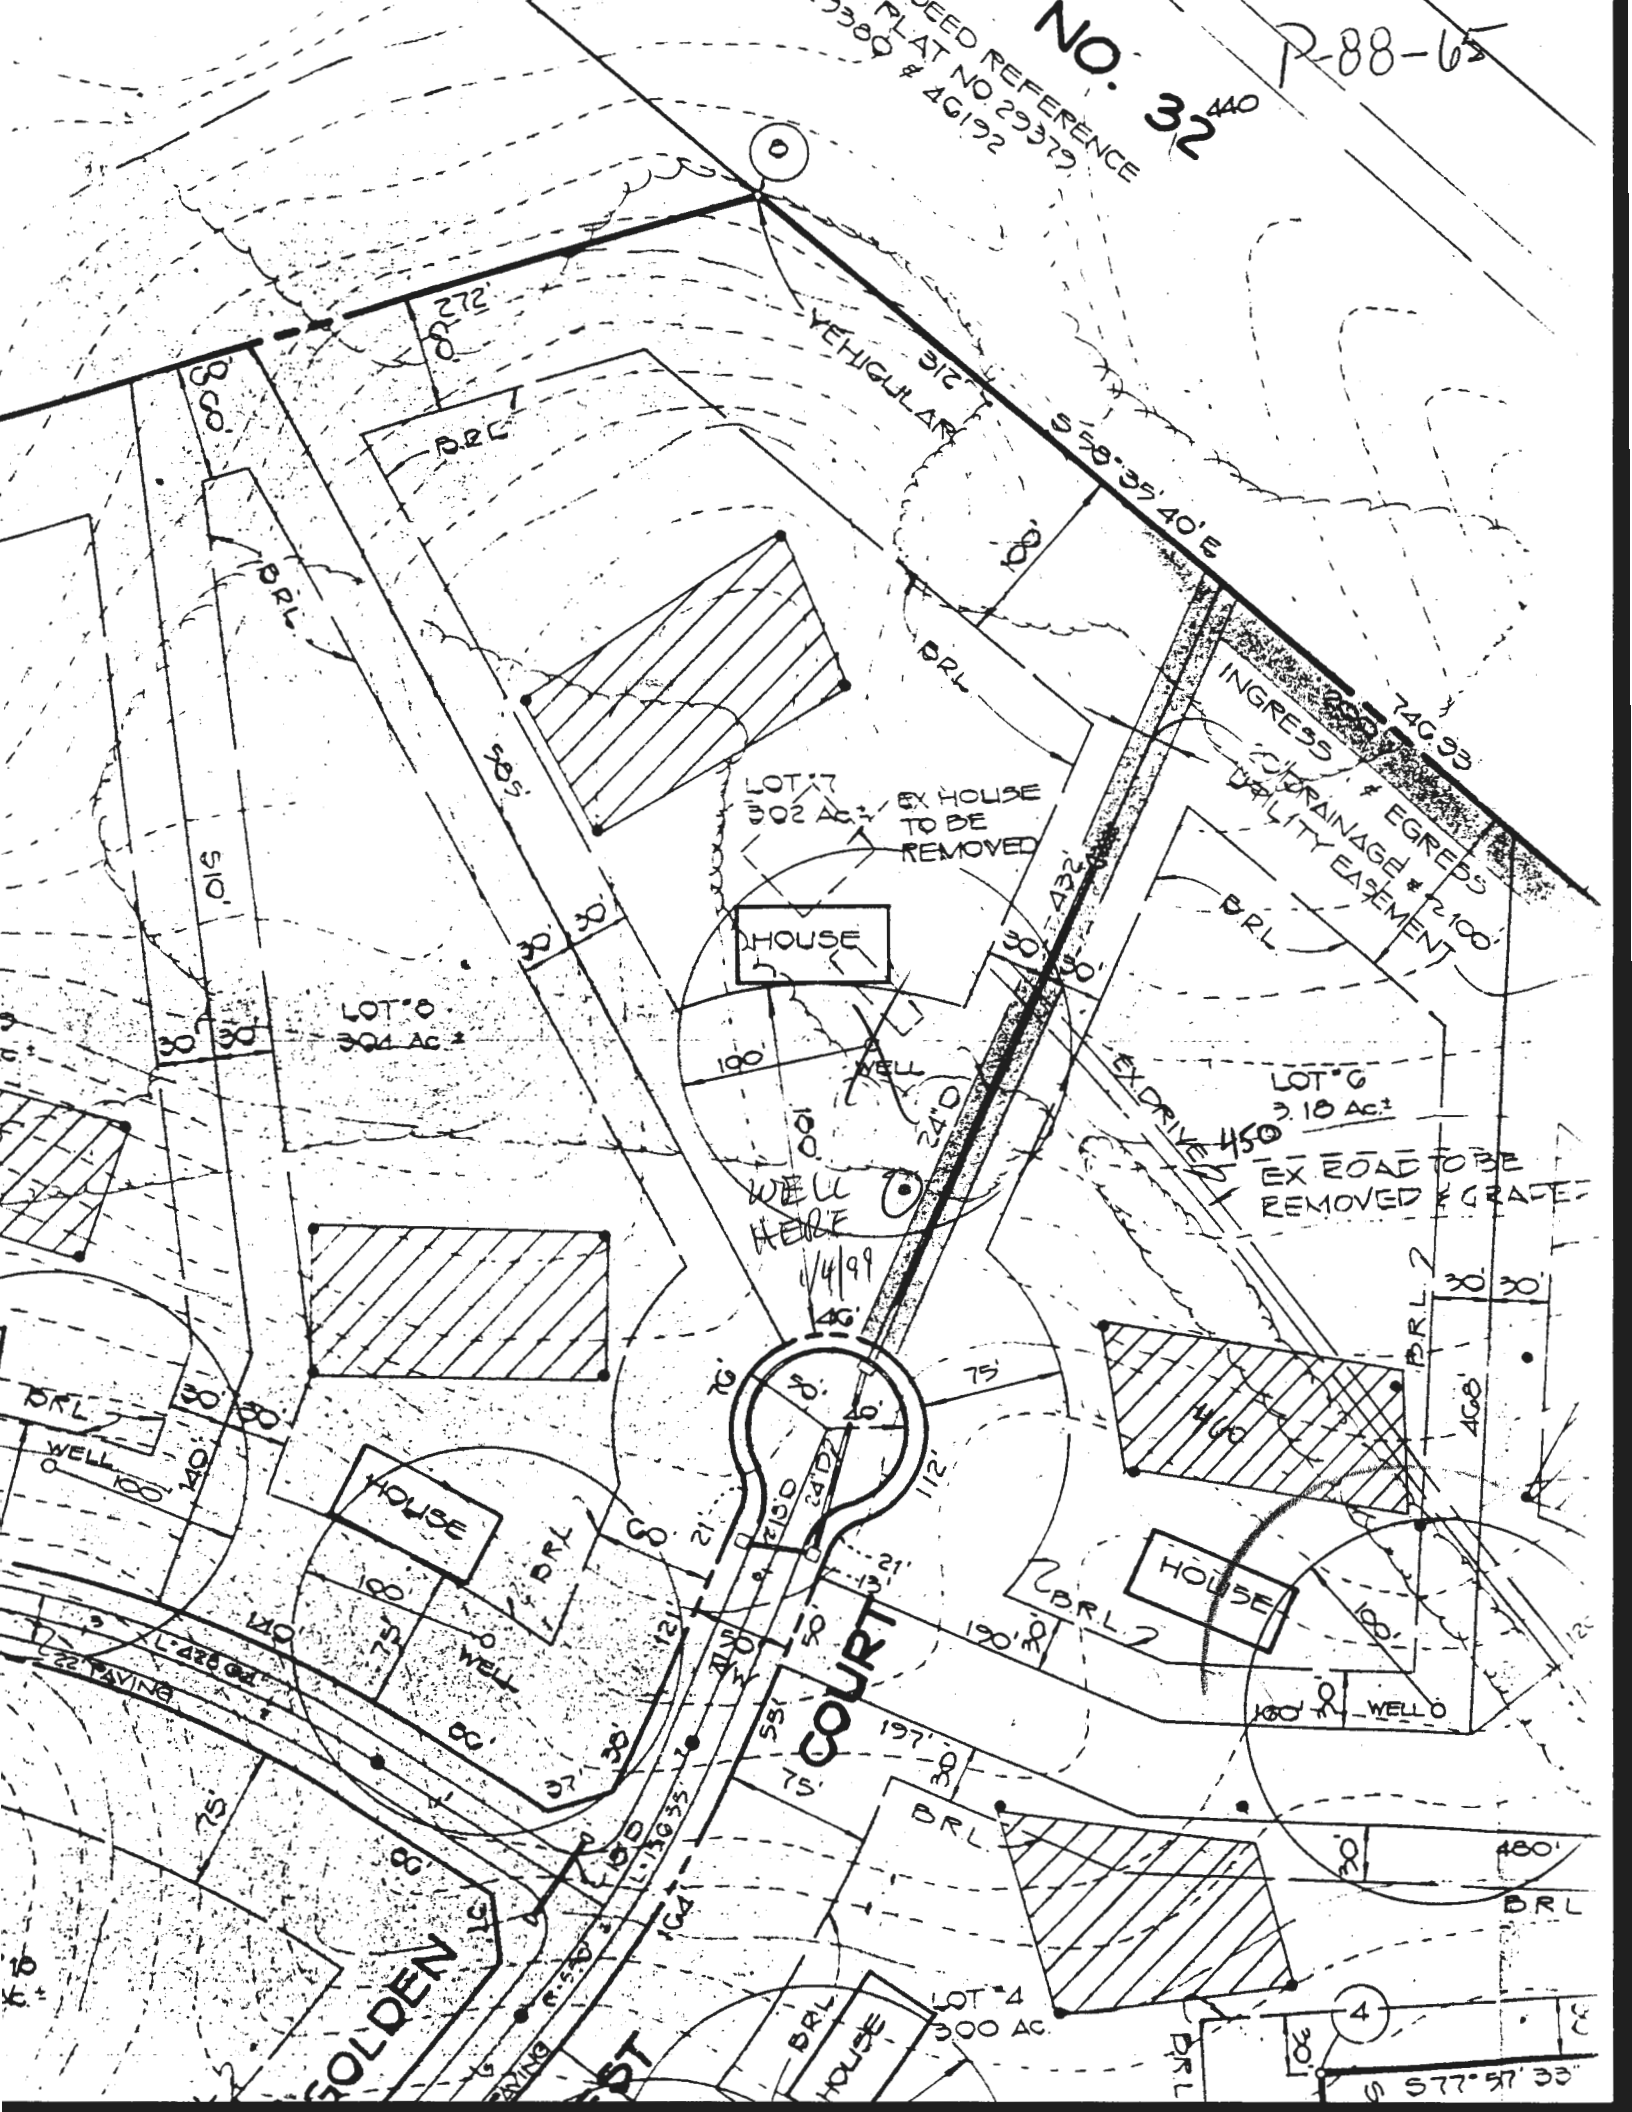

LOT 7
302 AC.
EX HOUSE
TO BE
REMOVED

HOUSE

LOT 6
304 AC.

WELL
HERE
4/4/99

LOT 6
310 AC.

EX ROAD TO BE
REMOVED & GRADED

COURT

GOLDEN ST

HOUSE

LOT 4
300 AC.


4

S 77° 57' 33"

DEED REFERENCE
PLAT NO 29379
26192 # 46192

NO. 32⁴⁴⁰

P-88-65

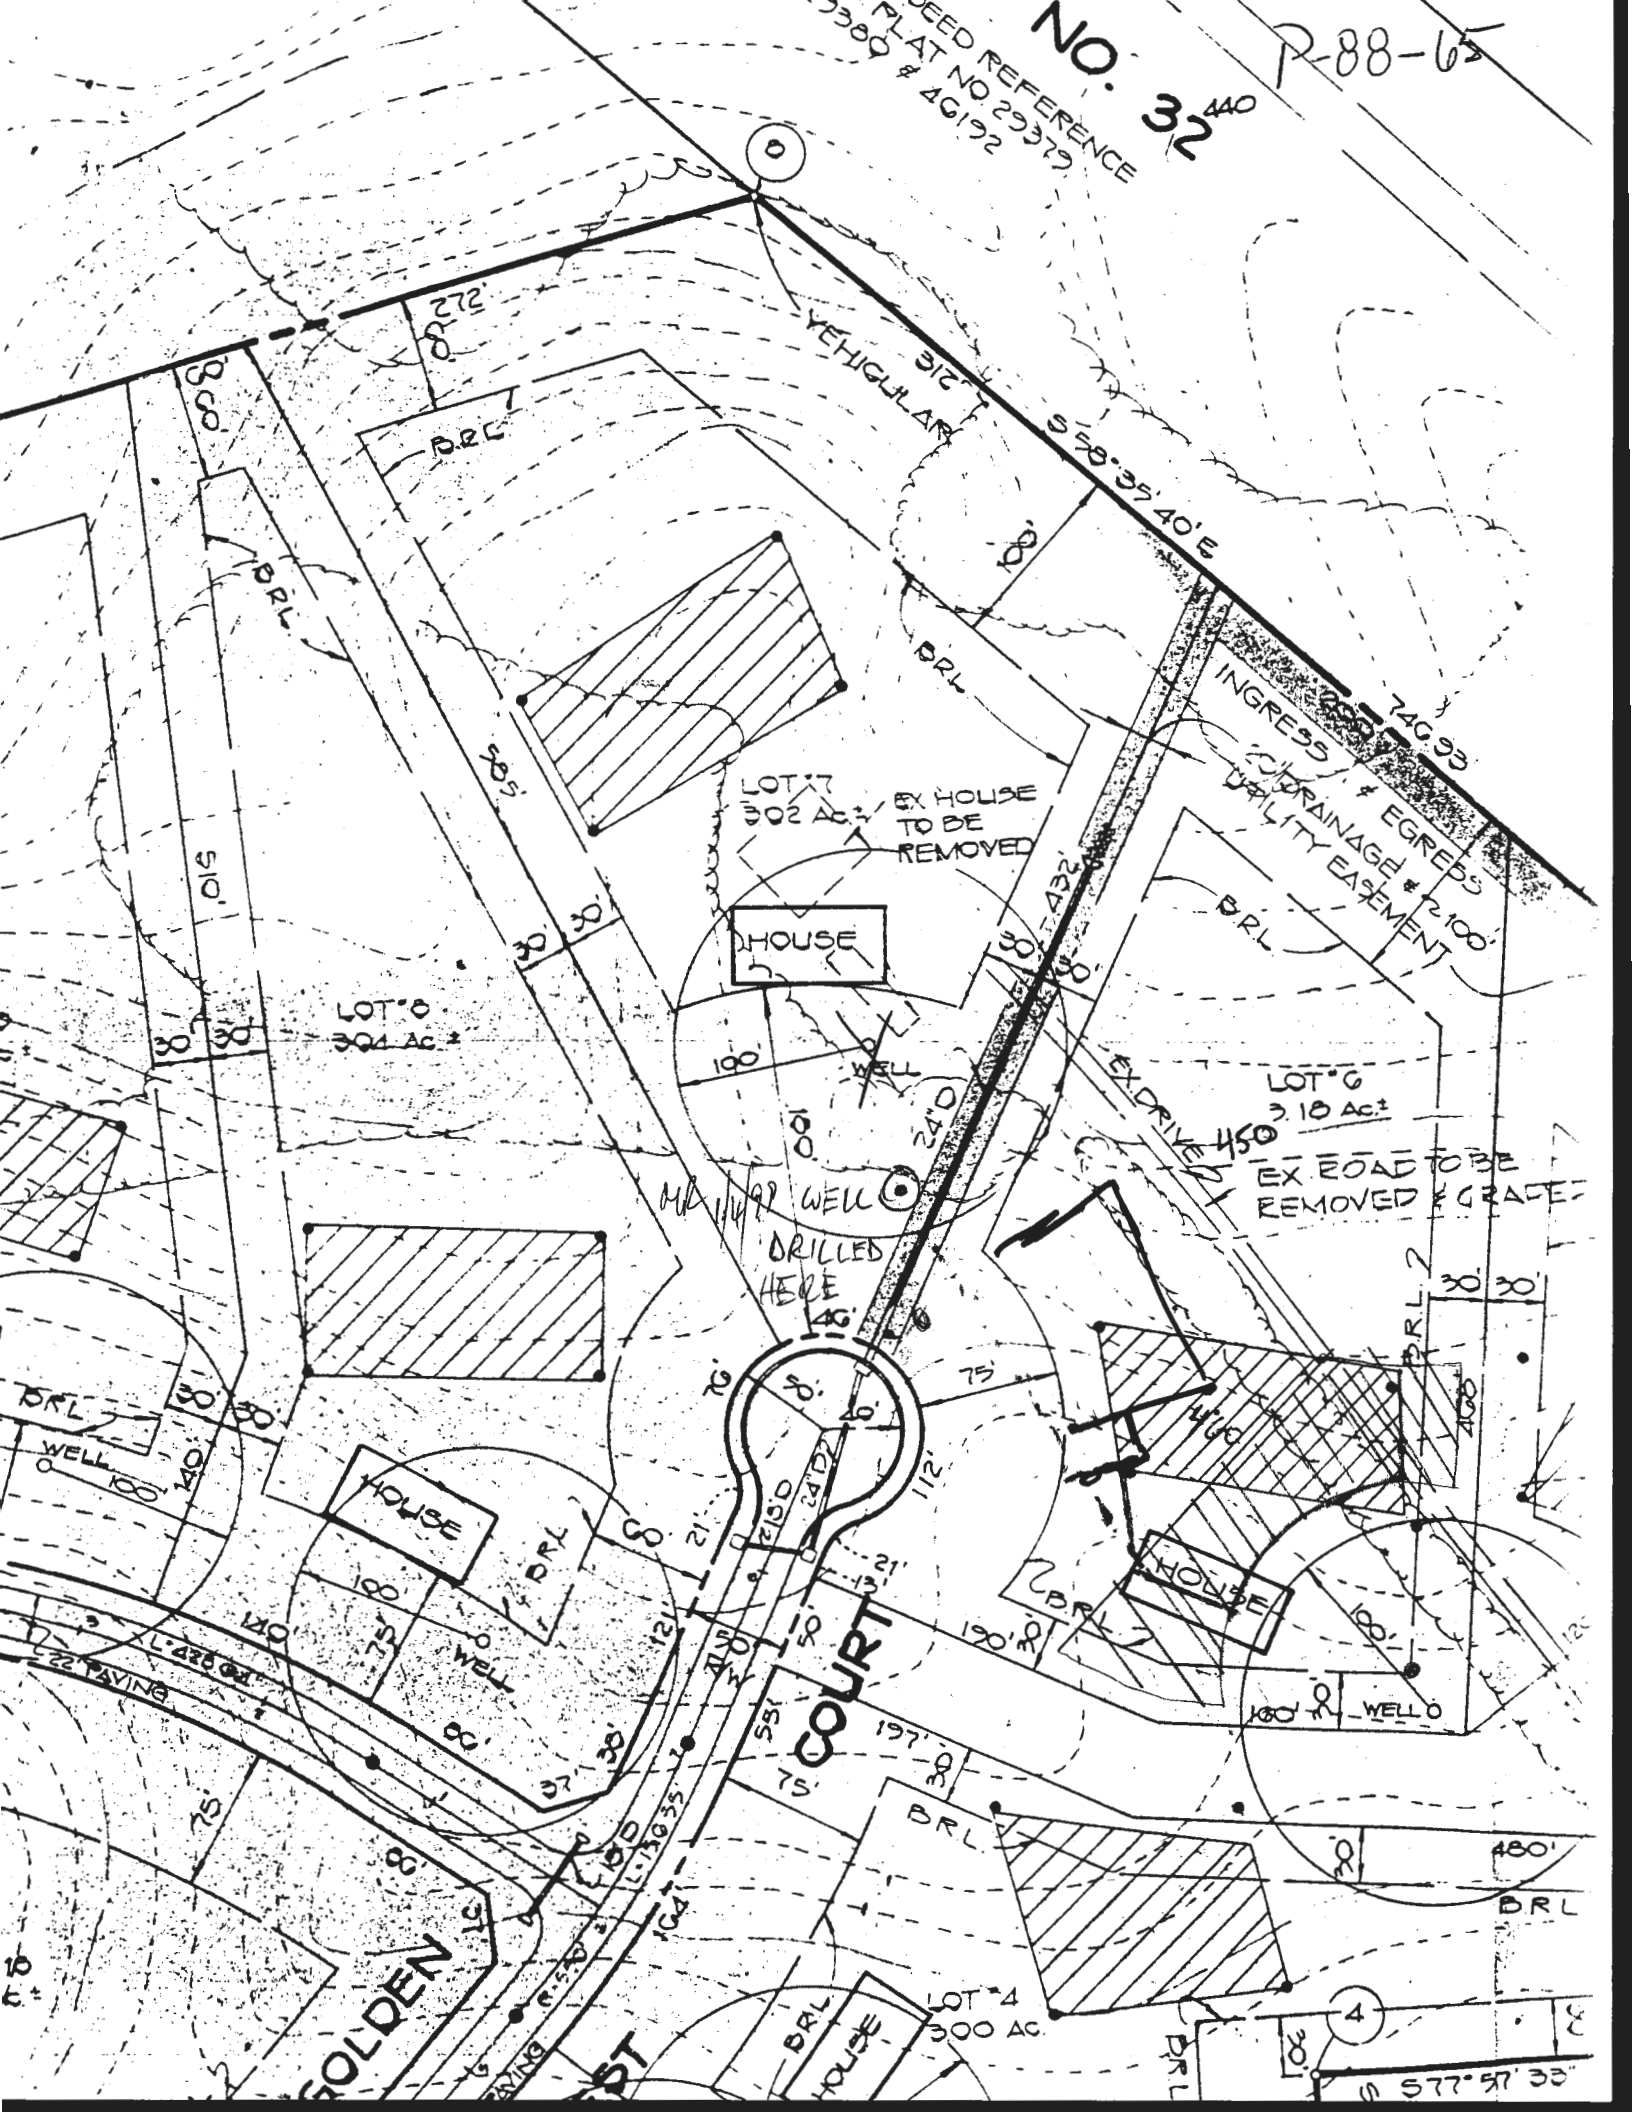

Clarksville Manor
AS of 1/27/00⁰¹⁶

NO activity
regarding perc
app.

MR/DS

SUBDIVISION: Clarksville Manor LOT NUMBER 6 A _____

STREET NAME: Golden Harvest Court

AVERAGE PERCOLATION RATE: 4-5 min SQUARE FEET PER BEDROOM: 180

NUMBER OF BEDROOMS: _____ LINEAR FEET OF TRENCH PER BEDROOM: _____

TOTAL LINEAR FEET OF TRENCH: _____

SEPTIC TANK CAPACITY: _____ GALLONS

TRENCH DIMENSIONS

Trench to be 3 feet wide. Inlet 3 feet below original grade. Bottom maximum depth 5 feet below original grade. Effective area begins at 3 feet below original grade. 2 feet of stone below distribution pipe.

PUMPED SYSTEM PROPOSED: YES NO

PUMPED SEPTIC SYSTEM DETAIL

_____ Gallon pump chamber: top seamed center seamed

Note 1: Septic pump detail to be provided by installer prior to issuance of septic permit.

Note 2: Pump performance test is necessary prior to Health Department approval of pumped septic system

LOCATION: _____

ADDITIONAL NOTES: _____

Reviewer: _____ Date: _____

13509 GOLDEN CORN DR

Detailed Search

Map:

Parcel:

Lot:

Real Property Data Search (w3)

Search Result for HOWARD COUNTY

View Map		View GroundRent Redemption			View GroundRent Registration					
Tax Exempt:		Special Tax Recapture:								
Exempt Class:		NONE								
Account Identifier:		District - 05 Account Number - 410347								
Owner Information										
Owner Name:		ABOAROB PASIL			Use:		RESIDENTIAL			
Mailing Address:		1704 ALLERFORD DR HANOVER MD 21076-			Principal Residence:		NO			
					Deed Reference:		/17401/ 00067			
Location & Structure Information										
Premises Address:		6318 GOLDEN HARVEST CT CLARKSVILLE 21029-0000			Legal Description:		LOT 6 3.123 A 6318 GOLDEN HARVEST CT CLARKSVILLE MANOR			
Map:	Grid:	Parcel:	Sub District:	Subdivision:	Section:	Block:	Lot:	Assessment Year:	Plat No:	8501
0034	0011	0398		0000			6	2017	Plat Ref:	
Special Tax Areas:					Town:		NONE			
					Ad Valorem:		100			
					Tax Class:					
Primary Structure Built		Above Grade Living Area		Finished Basement Area		Property Land Area		County Use		
2018		8,446 SF				3.1200 AC				
Stories	Basement	Type	Exterior	Full/Half Bath	Garage	Last Major Renovation				
2	YES	STANDARD UNIT	STUCCO	5 full	1 Attached					
Value Information										
			Base Value	Value	Phase-in Assessments					
				As of	As of		As of			
				01/01/2017	07/01/2018		07/01/2019			
Land:		295,900		295,900						
Improvements		828,500		910,400						
Total:		1,124,400		1,206,300		1,179,000		1,206,300		
Preferential Land:		0						0		
Transfer Information										
Seller: SINGH HARMANDAR			Date: 01/23/2017			Price: \$515,000				
Type: ARMS LENGTH VACANT			Deed1: /17401/ 00067			Deed2:				
Seller: SINGH HARMANDAR			Date: 01/23/2017			Price: \$0				
Type: NON-ARMS LENGTH OTHER			Deed1: /17401/ 00060			Deed2:				
Seller: SINGH BALBIR			Date: 06/23/2005			Price: \$0				
Type: NON-ARMS LENGTH OTHER			Deed1: /09259/ 00471			Deed2:				
Exemption Information										
Partial Exempt Assessments:		Class		07/01/2018		07/01/2019				
County:		000		0.00						
State:		000		0.00						
Municipal:		000		0.00 0.00		0.00 0.00				
Tax Exempt:		Special Tax Recapture:								
Exempt Class:		NONE								
Homestead Application Information										

Homestead Application Status: Denied

Homeowners' Tax Credit Application Information

Homeowners' Tax Credit Application Status: No Application **Date:**

1. This screen allows you to search the Real Property database and display property records.
2. Click **here** for a glossary of terms.
3. Deleted accounts can only be selected by Property Account Identifier.
4. The following pages are for information purpose only. The data is not to be used for legal reports or documents. While we have confidence in the accuracy of these records, the Department makes no warranties, expressed or implied, regarding the information.