

# APPLICATION

PERCOLATION TESTING

A 47426  
P \_\_\_\_\_

HOWARD COUNTY HEALTH DEPARTMENT  
BUREAU OF ENVIRONMENTAL HEALTH  
P.O. BOX 476 ELLICOTT CITY, MARYLAND 21043  
TELEPHONE: 461-9933

DISTRICT \_\_\_\_\_

DATE \_\_\_\_\_

TO: THE COUNTY HEALTH OFFICER  
ELLICOTT CITY, MARYLAND

I, HEREBY, APPLY FOR THE NECESSARY TEST IN ORDER TO CONSTRUCT (OR RECONSTRUCT) A SEWAGE DISPOSAL SYSTEM.

PROPERTY OWNER FRANK Reese 596-7556

ADDRESS 6845 Sewells orchard Dr PHONE \_\_\_\_\_  
Columbia 21045

PROSPECTIVE BUYER SAME

ADDRESS \_\_\_\_\_ PHONE \_\_\_\_\_

PROPERTY LOCATION:

SUBDIVISION King's Grant LOT NO. 15 Ratest

ROAD AND DESCRIPTION 3209 Regents Row

TAX MAP 22 PARCEL # 7

SIZE OF LOT 3.0 acre TYPE BLDG. SFD  
(SINGLE FAMILY DWELLING OR COMMERCIAL)

THE SYSTEM INSTALLED UNDER THIS APPLICATION IS ACCEPTABLE ONLY UNTIL PUBLIC FACILITIES BECOME AVAILABLE. I FULLY UNDERSTAND THE FEE CONNECTED WITH THE FILING OF THIS PERC TEST APPLICATION IS NON-REFUNDABLE UNDER ANY CIRCUMSTANCES. I ALSO AGREE TO COMPLY WITH ALL M.O.S.H.A. REQUIREMENTS IN TESTING THIS LOT.

[Signature]  
(SIGNATURE OF APPLICANT)

APPROVED BY \_\_\_\_\_ FOR \_\_\_\_\_ DATE \_\_\_\_\_

REJECTED BY \_\_\_\_\_ FOR \_\_\_\_\_ DATE \_\_\_\_\_

HOLD PENDING FURTHER TESTS \_\_\_\_\_ DATE \_\_\_\_\_

REASONS FOR REJECTION OR HOLDING 8-22-91 pending perch hole locations and plan approval. JEN

BLDG. PERMIT SIGNED  
AND RETURNED 4/27/92  
Health # 40987-SFD

# THIS IS NOT A PERMIT

8-22-91  
2 pm

HD-216

A47426

(5)

SOIL PROFILE

0-6.0 Brown sil cl, trace of quartz at 6.0 ft

6.0-14.5 Brown mica sil, trace of mottles at 12.0 ft Bottom

14.5 Bottom

(X) old perc holes 2-28-86

Inlet - 3  
Bottom - 7  
X = 5 min  
180 sq ft / bottom

field

steeper slope to floodplain

Highest 20'

Lowest 180'

High 20'

High 60'

High 60'

(7)  
0-2.0 Red sil cl  
< 10% decomp rock  
2-8.0 Red mica sil,  
< 15% decomp rock  
slight structure at 8.0 ft  
8.0 Refusal

stream bed

(8)  
0-6 Red sil cl, large rock 4-13'  
6-14.5 Yellow mica sil, some broken rocks < 15%  
14.5 Bottom

(6)

0-6.5 Red br sil cl  
6.5-9.5 Red mica sil  
< 40% broken rock  
Structured at 5.5 ft  
9.5 Refusal

(9)

0-3.0 Red sil cl  
3.0-11.0 Br mica sil,  
little decomp rock  
< 15%  
11.0 Refusal

INDICATE NORTH - NAME ADJOINING ROADWAY AS BASE LINE  
Reagents Row

DATE	TEST NO.	DEPTH	PRE-WET		TEST - 1" DROP		TIME	
			START	STOP	START	STOP		
8/22/91	5	6.5 S	3:25	3:40	1/2 inch		slow	
		9.0 M	3:25	3:28	3:28	3:33	5 min	
		7.5 S	3:53	3:54	3:54	3:58	2 min	
	Retest	14.5 D	Trace of mottles at 12.0 ft					ok
	6	9.5 V	Refusal				Failed	
	9	3.5 S	3:36	3:37	3:37	3:40	3 min	
		11.0 D	Refusal at		11.0 ft		ok	
	7	8.0 V	Refusal at 8.0 ft, uniform below 2.0 ft					ok
	8	7.5 S	4:02	4:04	4:04	4:07	3 min	
		14.5 D	Bottom					ok

REMARKS use holes 5, 7, 8, 9 in combination with previous

TYPE OF SOIL holes

TESTED BY JE Nadeau

ALSO PRESENT Dwayne Eckert, Ken Mr. Reese

# APPLICATION

PERCOLATION TESTING

A 36592

P \_\_\_\_\_

HOWARD COUNTY HEALTH DEPARTMENT  
BUREAU OF ENVIRONMENTAL HEALTH  
P.O. BOX 476 ELLICOTT CITY, MARYLAND 21043  
TELEPHONE: 461-9933

DISTRICT 3rd

DATE 2-17-84

TO: THE COUNTY HEALTH OFFICER  
ELLICOTT CITY, MARYLAND

I, HEREBY, APPLY FOR THE NECESSARY TEST IN ORDER TO CONSTRUCT (OR RECONSTRUCT) A SEWAGE DISPOSAL SYSTEM.

PROPERTY OWNER J.C. Mappenley Williamsburg Builders

ADDRESS Summer Hill Road At 32 West Friendship PHONE 489-4642

PROSPECTIVE BUYER Howard County Jail Service Inc

ADDRESS 10176 Baltimore Rd. Pike PHONE 465-5855

PROPERTY LOCATION: ~~6600 Road~~ KING'S GRANT

SUBDIVISION ~~Mappenley Property~~ LOT NO 3209 78 15

ROAD AND DESCRIPTION At 32 - Old Spring Road Regent's Row

TAX MAP 22 PARCEL # 7

SIZE OF LOT 3.0 ac TYPE BLDG. Single Family  
(SINGLE FAMILY DWELLING OR COMMERCIAL)

THE SYSTEM INSTALLED UNDER THIS APPLICATION IS ACCEPTABLE ONLY UNTIL PUBLIC FACILITIES BECOME AVAILABLE. I FULLY UNDERSTAND THE FEE CONNECTED WITH THE FILING OF THIS PERC TEST APPLICATION IS NON-REFUNDABLE UNDER ANY CIRCUMSTANCES. I ALSO AGREE TO COMPLY WITH ALL M.O.S.H.A. REQUIREMENTS IN TESTING THIS LOT.

J.C. Mappenley  
(SIGNATURE OF APPLICANT)

APPROVED BY Sid Abel FOR Deep trenches DATE 5-26-89

REJECTED BY \_\_\_\_\_ FOR \_\_\_\_\_ DATE \_\_\_\_\_

HOLD PENDING FURTHER TESTS \_\_\_\_\_ DATE \_\_\_\_\_

REASONS FOR REJECTION OR HOLDING \_\_\_\_\_

BLOG. PERMIT SIGNED  
AND RETURNED 5-26-89  
BP 2684 SA

# THIS IS NOT A PERMIT

# APPLICATION

PERCOLATION TESTING

A 36592

P \_\_\_\_\_

HOWARD COUNTY HEALTH DEPARTMENT  
BUREAU OF ENVIRONMENTAL HEALTH  
P.O. BOX 476 ELLICOTT CITY, MARYLAND 21043  
TELEPHONE: 461-9933

DISTRICT \_\_\_\_\_

DATE \_\_\_\_\_

TO: THE COUNTY HEALTH OFFICER  
ELLICOTT CITY, MARYLAND

I, HEREBY, APPLY FOR THE NECESSARY TEST IN ORDER TO CONSTRUCT (OR RECONSTRUCT) A SEWAGE DISPOSAL SYSTEM.

PROPERTY OWNER \_\_\_\_\_

ADDRESS \_\_\_\_\_ PHONE \_\_\_\_\_

PROSPECTIVE BUYER \_\_\_\_\_

ADDRESS \_\_\_\_\_ PHONE \_\_\_\_\_

PROPERTY LOCATION:

SUBDIVISION MOBERLY PROPERTY LOT NO. 28

ROAD AND DESCRIPTION ROUTE 32 OPPOSITE WEST IVORY RD

TAX MAP \_\_\_\_\_ PARCEL # \_\_\_\_\_

SIZE OF LOT \_\_\_\_\_ TYPE BLDG. \_\_\_\_\_  
(SINGLE FAMILY DWELLING OR COMMERCIAL)

THE SYSTEM INSTALLED UNDER THIS APPLICATION IS ACCEPTABLE ONLY UNTIL PUBLIC FACILITIES BECOME AVAILABLE. I FULLY UNDERSTAND THE FEE CONNECTED WITH THE FILING OF THIS PERC TEST APPLICATION IS NON-REFUNDABLE UNDER ANY CIRCUMSTANCES. I ALSO AGREE TO COMPLY WITH ALL M.O.S.H.A. REQUIREMENTS IN TESTING THIS LOT.

(SIGNATURE OF APPLICANT)

APPROVED BY \_\_\_\_\_ FOR \_\_\_\_\_ DATE \_\_\_\_\_

REJECTED BY \_\_\_\_\_ FOR \_\_\_\_\_ DATE \_\_\_\_\_



HOLD PENDING FURTHER TESTS \_\_\_\_\_ DATE \_\_\_\_\_

REASONS FOR REJECTION OR HOLDING \_\_\_\_\_

# THIS IS NOT A PERMIT

Lot 28  
MOBERLY  
PROPER 11

SOIL PROFILE


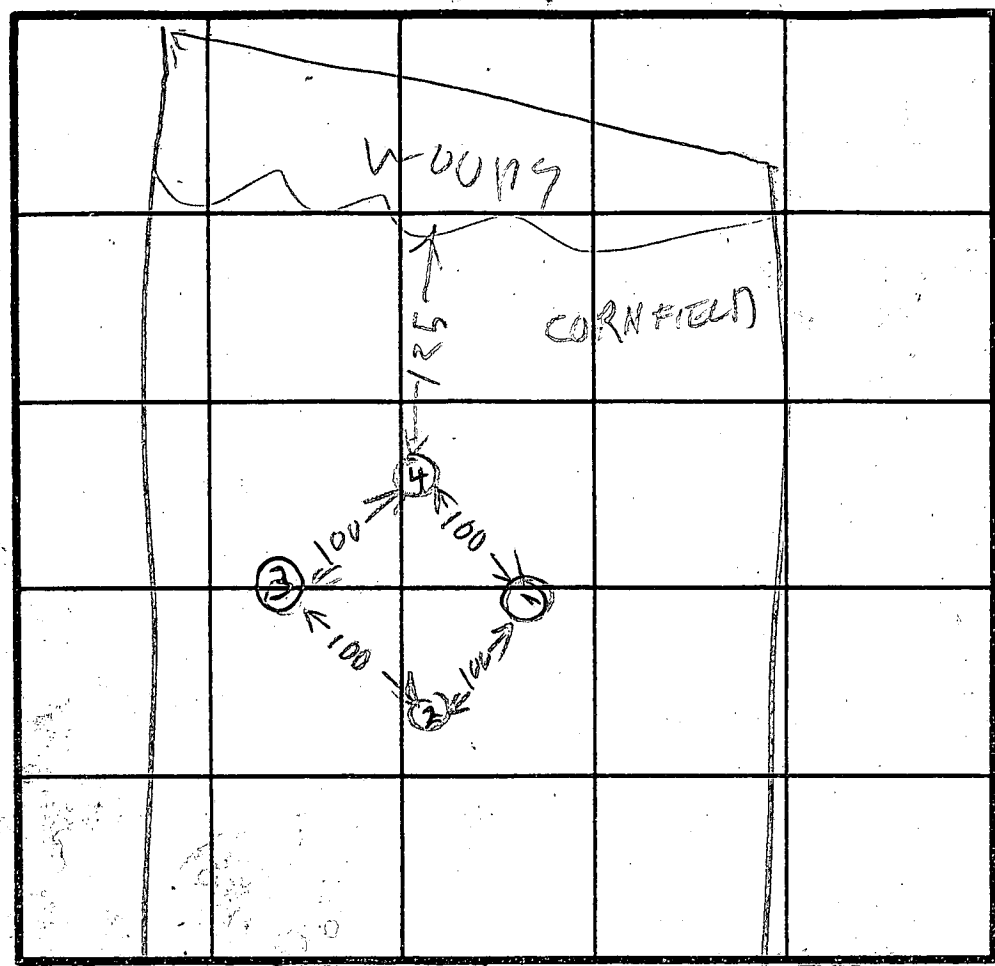
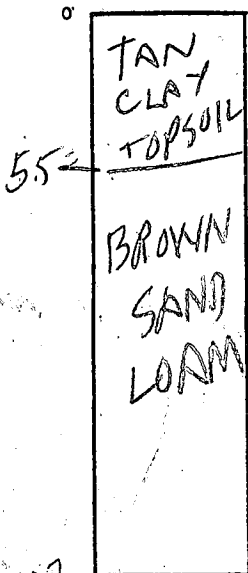


HOLE ELEVATION  
①② = HIGH  
③ = MEDIUM  
④ = LOW

INDICATE NORTH - NAME ADJOINING ROADWAY AS BASE LINE

STREET

TO R 32

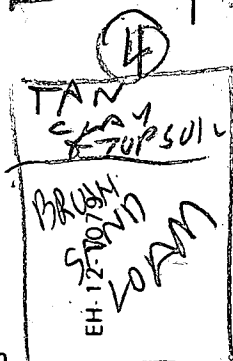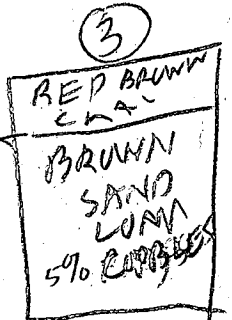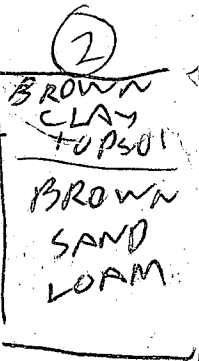

DATE	TEST NO.	DEPTH	PRE-WET		TEST - 1" DROP		TIME
			START	STOP	START	STOP	
2/28/86	1 S	6.5	254	259	259	303	4
	1 V	13	LOOKS OK				
	2 S	4	258	302	302	305	3
	2 D	8	257	305	305	316	11
	2 V	12	LOOKS OK				
	3 S	3.5	306	315	315	325	10
	3 V	11	LOOKS OK				
	4 S	17	307	309	309	313	4
	4 V	13	LOOKS OK				

REMARKS HOLES DUG PER SURVEYORS PLAT

TYPE OF SOIL

TESTED BY R.H

ALSO PRESENT KETTERMANS