

HEALTH

Name: ~~Boss~~ Bopsalis
Street Address: 12090 Hall Shop Rd
City, State, Zip: Clarksville, md 21029
Date: 5/10/19

Amendment, Permit # B15003264

Ms. Debbie Whalen
Division of Plan Review
Department of Inspections, Licenses and Permits
Howard County Government
3430 Court House Dr
Ellicott City, MD 21043

Approved Septic System Plan
Howard County Health Department
Floor Plan ^{revisions}
approved as described
and illustrated.
Signature: [Signature]
Date: 5/29/2019
(see 2 handwritten pages, attached)

Dear Ms. Whalen:

I am requesting to amend Permit # B15003264 at
12090 Hall Shop Rd, Clarksville, md 21029 to

See attached

Enclosed:

Fee: _____
4 Plot Plans
1 Sets of Construction Drawings - other 2 submitted previously
Other: _____

If there is anything we can do to assist you, please let me know.

Sincerely, [Signature]

Name: Kimberly Tatham
Title: Assistant
Phone: 301-854-1006
Email: mtainypaving1@yahoo.com

DILP 2019 MAY 10 AM 11:13

AMENDMENTS

1 A-2 GENERAL - Exterior to be brick
All Elevation's TO
HAVE BRICK ON EXISTING
Brick Ledges

2 A-2 Left Elevation - Add 36×84 Window

3 A-2 Front Elevation - Add sidelights
TO Front Door

1 A-3 Second floor plan: Revise Bedroom #2

Revise STAIR CASE
to site Built

Revise Master Bath

Revise Master Bedroom

Removing Balcony

Removing Doors

to Balcony

Front walls

Reflecting Front
Elevation

Already Amended —

2 A-3 First Floor Plan: Location Change of

Powder room, Kitchen

Mechanical Room

Show Revised staircase

Already Amended

Show Revised Front Wall

3 A-3 Attic Plan: Revised Plan for
CLOSET AREAS
AND MECHANICAL ROOM

1 S-1 Second Floor Framing Plan:

Revised Stair Case
Revised Joist Plan @
MASTER BATH

1 A-4 Transverse Section: Shows Elevation
of Stair Case


1 A-5 Longitudinal Section:

Shows Elevation
of Stair Case

Shows Section
of Joist Change
For Master Bath

PROPOSED ADDITION/RENOVATION @: THE BOOSALI RESIDENCE

12090 HALL SHOP ROAD
CLARKSVILLE, MD

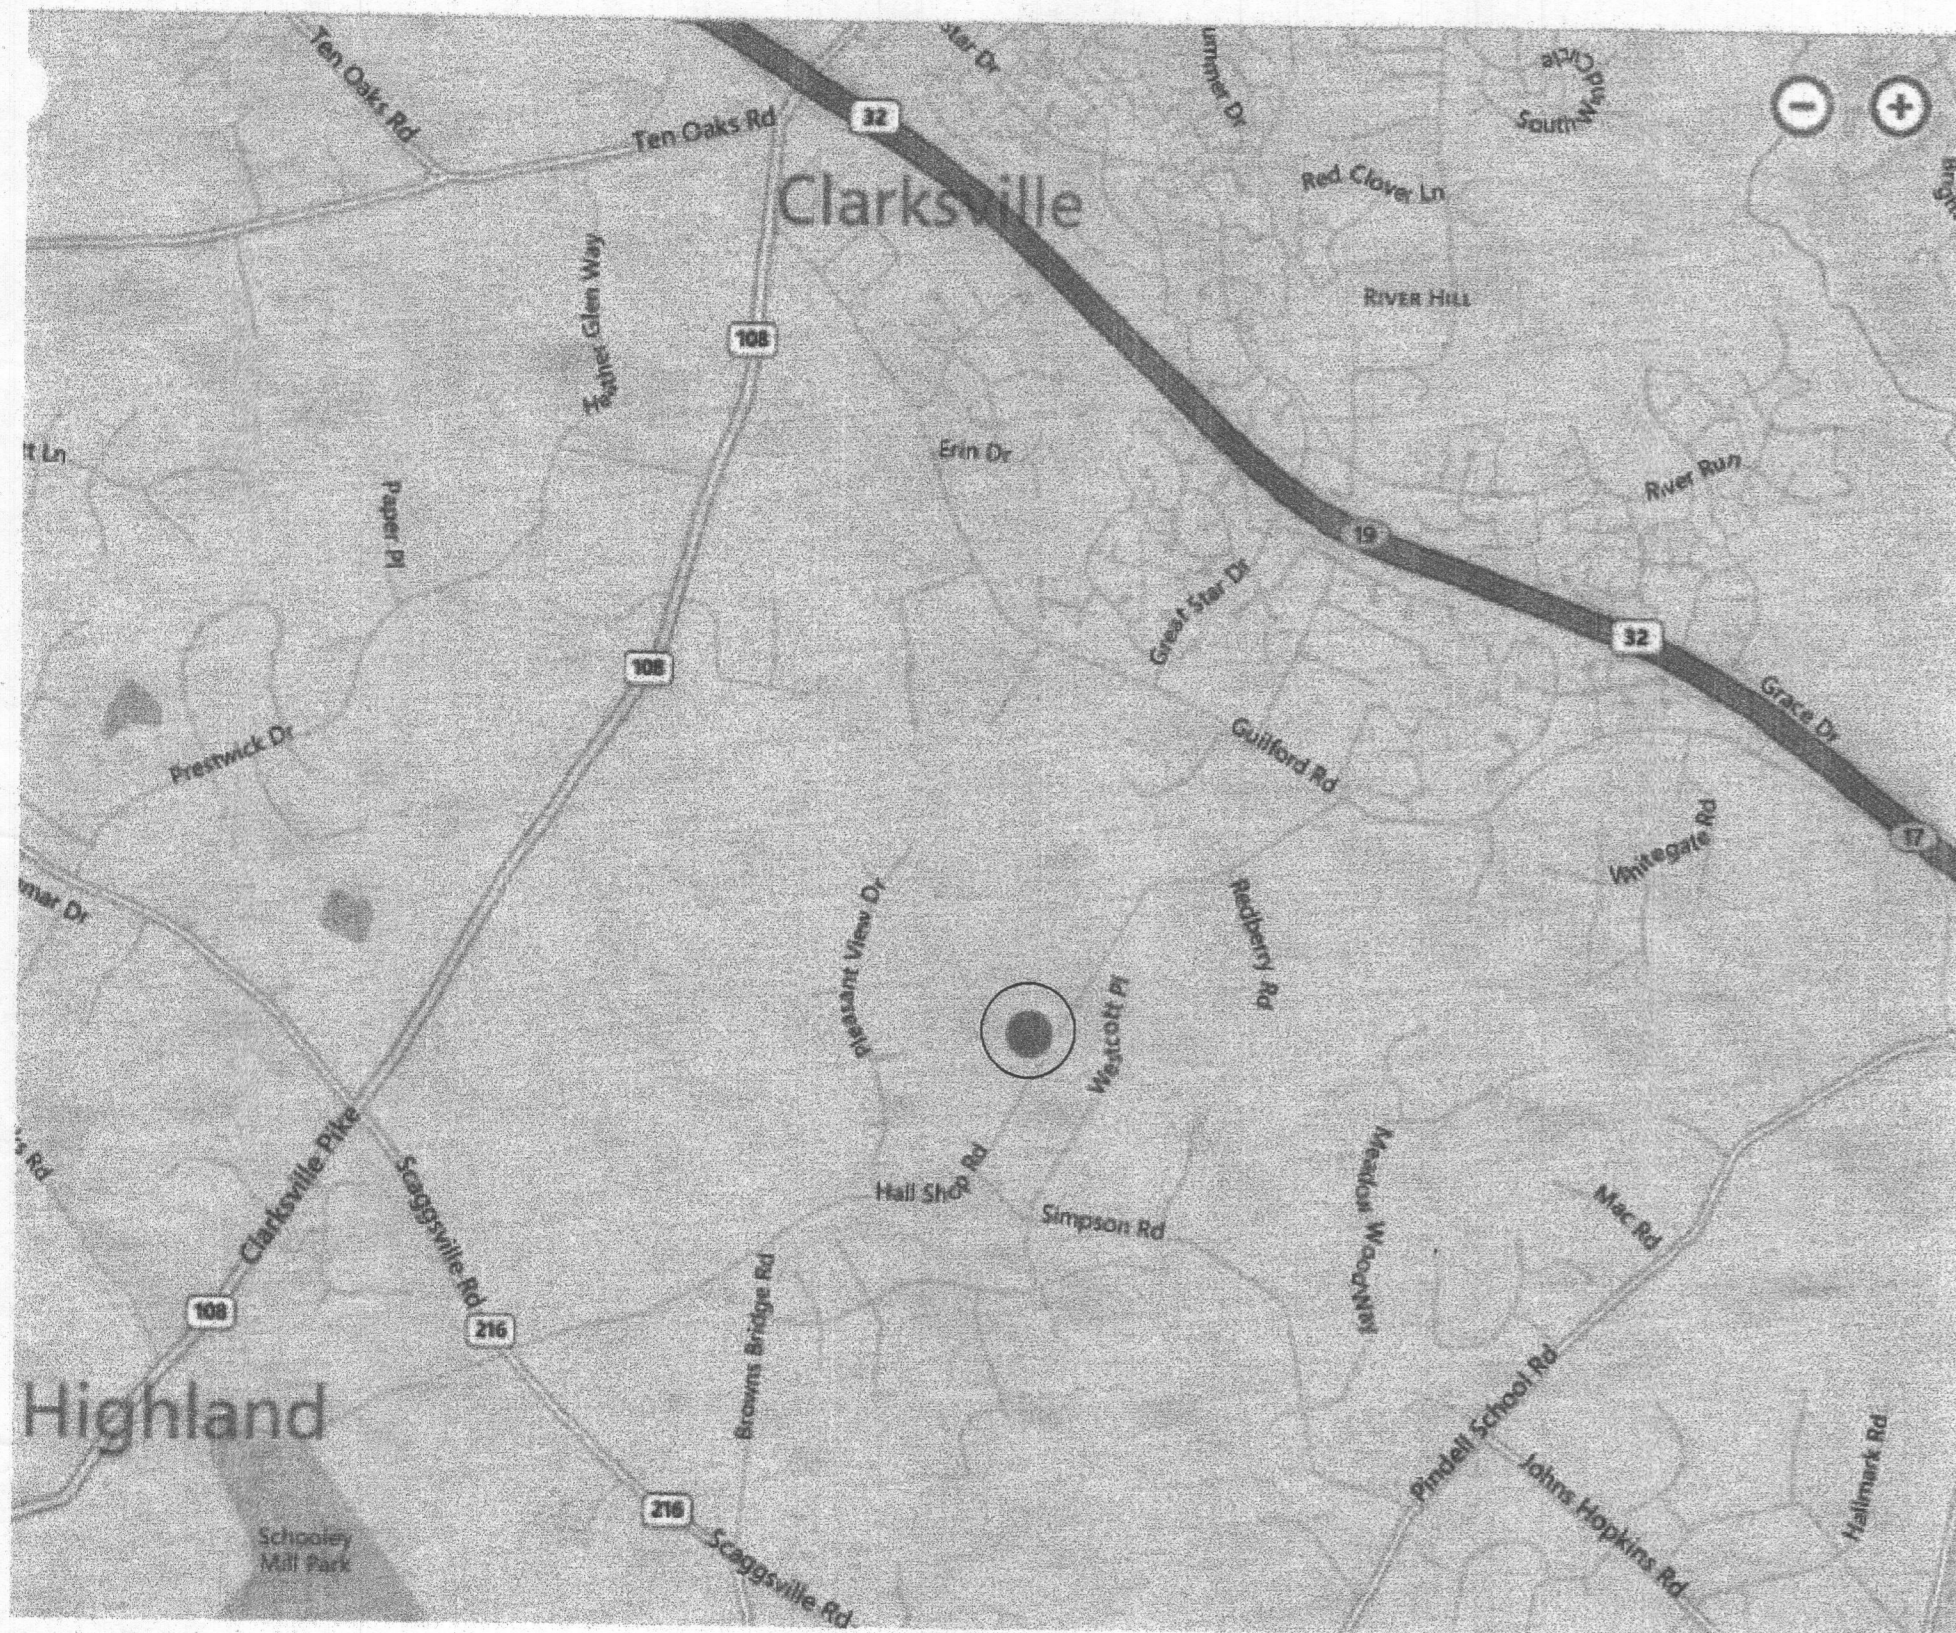

LOCATION MAP

DRAWING INDEX

- CV COVER PAGE GEN. NOTES
- A1 EXISTING HOME ELEVATIONS
- A2 PROPOSED HOME ELEVATIONS
- A3 FLOOR PLANS
- A4 BUILDING SECTION
- A5 BUILDING SECTION
- S1 FRAMING PLANS



GENERAL NOTES

BUILDING CODES:

- A. ALL CONSTRUCTION SHALL CONFORM WITH THE 2015 INTERNATIONAL RESIDENTIAL CODE (IRC).
- B. ALL CONSTRUCTION SHALL CONFORM WITH ALL APPLICABLE LOCAL CODES/AMENDMENTS.

DESIGN LOADS: (PER SECTION R301 OF IRC 2015)

- A. THE DESIGN DEAD LOADS FOR ALL FRAMING IS BASED ON THE CONSTRUCTION MATERIALS SHOWN ON THE DRAWINGS AND INDICATED IN THE GENERAL NOTES.
- B. THE MINIMUM DESIGN UNIFORMLY DISTRIBUTED LIVE LOADS FOR ALL NEW FRAMING SHALL BE AS FOLLOWS:

FLOOR LOAD (U.O.N.)	LL=40 PSF / DL=10 PSF
SLEEPING RMS / ATTIC WITH FIXED STAIR	LL=30 PSF / DL=10 PSF
GARAGE FLOOR	LL=50 PSF / 2000# POINT
ROOF LIVE LOAD	MIN. 30 PSF
ATTIC AND TRUSS BOTTOM CHORD	LL=20 PSF (LIMITED STORAGE) LL=10 PSF (NO STORAGE)
- C. ROOF SNOW LOAD DESIGN CRITERIA:

GROUND SNOW LOAD (Pg)	30 PSF
-----------------------	--------
- D. WIND LOAD DESIGN CRITERIA:

ULTIMATE WIND SPEED	115 MPH
---------------------	---------
- F. SUBJECT TO DAMAGE FROM:

WEATHERING	SEVERE
FROST LINE DEPTH	24"
TERMITE	MODERATE TO HEAVY
DECAY	SLIGHT TO MODERATE
- H. THE STABILITY OF THE STRUCTURE IS DEPENDENT UPON THE DIAPHRAGM ACTION OF THE FLOORS AND ROOF. THE CONTRACTOR IS RESPONSIBLE FOR THE METHOD OF CONSTRUCTION AND SHALL PROVIDE ALL TEMPORARY BRACING AND SHORING REQUIRED TO MAINTAIN THE STABILITY OF THE STRUCTURE AND TO SUPPORT CONSTRUCTION LOADS DURING CONSTRUCTION, INCLUDING SOILS ON WALLS FROM BACK FILLING PRIOR TO PLACING SLABS ON GRADE. DESIGN OF ALL BRACING IS THE CONTRACTOR'S RESPONSIBILITY.

SPREAD FOOTING FOUNDATIONS:

- A. THE BOTTOM OF ALL EXTERIOR FOOTINGS SHALL BE A MINIMUM OF 24" BELOW FINISH GRADE FOR FROST PROTECTION.
- B. ALL FOOTINGS HAVE BEEN DESIGNED FOR AN ASSUMED NET ALLOWABLE SOIL BEARING PRESSURE OF 2000 PSF.
- C. THE CONTRACTOR SHALL NOTIFY THE ENGINEER OF ALL FOUNDATION AND SOIL CONDITIONS WHICH DIFFER FROM THOSE ANTICIPATED OR INDICATED IN THE CONTRACT DOCUMENTS.

CONCRETE SLAB-ON-GRADE:

- A. ALL SLABS ON GRADE, UNLESS OTHERWISE NOTED, SHALL CONSIST OF A 4 INCH THICK CONCRETE SLAB REINFORCED WITH ONE LAYER OF 6"x6" - W/4W14 WELDED WIRE FABRIC AND PLACED OVER A 6 MIL POLYETHYLENE VAPOR RETARDER AND 4 INCHES OF COMPACTED GRANULAR BASE. ALL EDGES OF VAPOR RETARDER SHALL BE LAPPED A MINIMUM OF 6 INCHES AND TAPED. MAXIMUM AGGREGATE SIZE OF GRANULAR BASE SHALL BE 1/2 INCH.
- B. FILL DEPTHS UNDER SLAB SHALL NOT EXCEED 24 INCHES FOR CLEAN SAND OR GRAVEL AND 8 INCHES FOR COMPACTED SOIL. SLABS ON GREATER FILL SHALL BE ENGINEERED SUPPORTED SLABS. COORDINATE WITH ENGINEER WHERE REQUIRED.
- C. PLACE CONCRETE PER ACI 302. CONTRACTOR SHALL READ, UNDERSTAND & FOLLOW GUIDELINES SET FORTH FOR PREPARING SUBGRADE, PLACING, CONSOLIDATING, FINISHING AND CURING CONCRETE SLABS.

CAST IN PLACE CONCRETE:

- A. ALL CONCRETE CONSTRUCTION SHALL CONFORM TO THE "SPECIFICATIONS FOR STRUCTURAL CONCRETE FOR BUILDINGS (ACI 301)" AND TO THE "BUILDING CODE REQUIREMENTS FOR REINFORCED CONCRETE (ACI 318)".
- B. IN ADDITION TO THE ABOVE, ALL CONCRETE WORK SHALL CONFORM TO THE FOLLOWING:
 1. RECOMMENDED PRACTICE FOR HOT WEATHER CONCRETING (ACI 305).
 2. RECOMMENDED PRACTICE FOR COLD WEATHER CONCRETING (ACI 306).
 3. RECOMMENDED PRACTICE FOR CONCRETE FORM WORK (ACI 347).
- C. ALL CONCRETE, UNLESS OTHERWISE NOTED, SHALL BE STONE AGGREGATE CONCRETE HAVING A MINIMUM 28 DAY COMPRESSIVE STRENGTH OF 3500 PSI. ALL CONCRETE EXPOSED TO WEATHER SHALL HAVE AN AIR ENTRAINMENT OF 5%-7%. NO AGGREGATE SIZE SHALL BE 1" AND MAXIMUM SLUMP SHALL BE 4" (3" FOR SLABS ON GRADE). ALL CONCRETE, EXCEPT FOOTINGS, SHALL CONTAIN A WATER REDUCING ADMIXTURE. PORTLAND CEMENT SHALL CONFORM TO ASTM C150 AND NORMAL WEIGHT AGGREGATES SHALL CONFORM TO ASTM C33.
- D. ALL REINFORCING BARS SHALL BE NEW BILLET STEEL CONFORMING TO ASTM A615 GRADE 60. ALL WELDED WIRE FABRIC (W.W.F.) SHALL CONFORM TO ASTM A65. LAP ALL REINFORCING BARS A MINIMUM OF 48x BAR DIA. (EX. - LAP 1/2" BAR 24") AND ALL W.W.F. A MINIMUM OF TWO FULL GRIDS, UNLESS OTHERWISE INDICATED.

STRUCTURAL AND MISCELLANEOUS STEEL:

- A. ALL STEEL CONSTRUCTION SHALL CONFORM TO THE THIRTEENTH EDITION OF THE AISC "SPECIFICATION FOR STRUCTURAL STEEL BUILDINGS - ALLOWABLE STRESS DESIGN AND PLASTIC DESIGN" AND THE AISC "CODE OF STANDARD PRACTICE FOR STEEL BUILDINGS AND BRIDGES".
- B. ALL STRUCTURAL STEEL SHALL CONFORM TO ASTM A992 GRADE 50 OR ASTM A36 AT THE CONTRACTOR'S OPTION.
- C. ALL MISCELLANEOUS STEEL (ANGLES, PLATES, ETC.) SHALL CONFORM TO ASTM A36 HAVING A MINIMUM YIELD STRENGTH OF Fy=36,000 PSI.
- D. ALL STRUCTURAL STEEL PIPE SHALL CONFORM TO ASTM A501 HAVING A MINIMUM YIELD STRENGTH OF Fy=36,000 PSI OR TO ASTM A53, TYPE "E" OR "S" GRADE "B", HAVING A MINIMUM YIELD STRENGTH OF Fy=35,000 PSI.
- E. ALL STRUCTURAL STEEL TUBES SHALL CONFORM TO ASTM A500, GRADE "B", HAVING A MINIMUM YIELD STRENGTH OF Fy=48,000 PSI.
- F. ALL CONNECTIONS, UNLESS OTHERWISE NOTED, SHALL BE DOUBLE ANGLE OR SINGLE PLATE SHEAR CONNECTIONS DESIGNED AND DETAILED IN ACCORDANCE WITH THE AISC "STEEL CONSTRUCTION MANUAL" WITH A MINIMUM EDGE DISTANCE OF 1-1/2 INCHES AND BOLT SPACING OF 3 INCHES.
- G. THE CONTRACTOR SHALL NOT SPLICE OR CUT OPENINGS IN STEEL MEMBERS NOT SHOWN ON CONTRACT DRAWINGS WITHOUT THE PERMISSION OF THE STRUCTURAL ENGINEER.

WOOD FRAMING:

- A. ALL WOOD FRAMING SHALL BE FABRICATED AND ERECTED IN ACCORDANCE WITH THE "NATIONAL DESIGN SPECIFICATION FOR WOOD CONSTRUCTION" PUBLISHED BY THE NATIONAL FOREST PRODUCTS ASSOCIATION.
- B. ALL NEW LUMBER SHALL BE SPRUCE-PINE-FIR NO. 2 OR BETTER. ALL NEW PRESSURE TREATED LUMBER SHALL BE SOUTHERN PINE NO. 2 OR BETTER.
- C. NAILING OF ALL WOOD FRAMING SHALL MEET THE MINIMUM RECOMMENDED REQUIREMENTS PROVIDED IN THE NAILING SCHEDULE OF THE IRC BUILDING CODE.
- D. PROVIDE DOUBLE JOISTS OR HEADERS ALONG EACH SIDE OF FLOOR OR ROOF OPENINGS, UNDER THE CENTERLINE OF PARTITION WALLS PARALLEL TO JOIST SPANS, AND ABOVE ALL WALL OPENINGS UNLESS OTHERWISE INDICATED.
- E. THE CONTRACTOR SHALL CUT OR NOTCH THE WOOD FRAMING ONLY AS REQUIRED AND IN ACCORDANCE WITH THE IRC BUILDING CODE, THE "NATIONAL DESIGN SPECIFICATION FOR WOOD CONSTRUCTION", OR AS SHOWN ON THE CONTRACT DRAWINGS.
- F. PROVIDE DOUBLE OR TRIPLE STUDS AT ALL CORNERS, SIDES OF OPENINGS, AND BENEATH ALL WOOD BEAMS AND LINTELS, UNLESS OTHERWISE INDICATED.
- G. WOOD TRUSSES SHALL BE DESIGNED, FABRICATED AND ERECTED IN ACCORDANCE WITH THE TRUSS PLATE INSTITUTE'S "NATIONAL DESIGN SPECIFICATION FOR METAL PLATE CONNECTED WOOD TRUSS CONSTRUCTION" FOR THE DESIGN LOADS INDICATED ON THE CONTRACT DOCUMENTS.
- H. THE CONTRACTOR SHALL SUBMIT SHOP DRAWINGS AND DESIGN CALCULATIONS FOR ALL WOOD TRUSSES INCLUDING MEMBER LAYOUT, WOOD SPECIES AND GRADE, MEMBER SIZES, TRUSS BEARING CONNECTION DETAILS, CAPACITY OF CONNECTOR PLATES AND THE SIZE AND LOCATION OF ALL REQUIRED BRIDGING. THE CALCULATIONS AND SHOP DRAWINGS SHALL BE SIGNED AND SEALED BY A PROFESSIONAL ENGINEER REGISTERED IN THE STATE OF MARYLAND.
- I. THE CONTRACTOR SHALL PROVIDE TRUSS TIES EQUIVALENT TO OR BETTER THAN THE UPLIFT LOADS INDICATED ON THE TRUSS SHOP DRAWINGS.

INSULATION & MOISTURE PROTECTION:

- A. PROVIDE 3/8" BUILDING FELT OR PAPER AT BRICK VENEER WITH FLASHING AT OPENING TO PREVENT MOISTURE PENETRATION BEHIND THE VENEER.
- B. PROVIDE MINIMUM ONE LAYER OF 15 LB. ROOFING FELT AT THE ROOF TO PROVIDE A WATER-RESISTANT BASE FOR FIBERGLASS COMPOSITION ROOF SHINGLES.
- C. AN ICE BARRIER, IF REQUIRED, THAT CONSISTS OF TWO LAYERS OF UNDERLAYMENT CEMENTED TOGETHER OR OF A SELF-ADHERING POLYMER MODIFIED BITUMEN SHEET, SHALL BE USED IN LIEU OF NORMAL UNDERLAYMENT AND EXTEND FROM THE LOWEST EDGES OF ALL ROOF SURFACES TO A POINT AT LEAST 24 INCHES INSIDE THE EXTERIOR WALL LINE OF THE BUILDING.
- D. PROVIDE INSULATION TO ACHIEVE MINIMUM R-VALUES AS FOLLOWS:

Ceilings: R-49 (if UNCOMPRESSED EXTENDS OVER WALL TOP PLATE)	R-13 CONTINUOUS
EXTERIOR FRAME WALLS:	R-20
BASEMENT (CONCRETE) WALLS:	R-10 CONTINUOUS
FLOORS OVER UNCONDITIONED SPACE:	R-25
WINDOWS / GLASS DOORS:	U-FACTOR ≤ 0.35
SKYLIGHTS:	U-FACTOR ≤ 0.55
- E. THE CONTRACTOR SHALL PROVIDE CORROSION-RESISTANT METAL FLASHING ABOVE ALL WINDOW AND DOOR OPENINGS TO PREVENT MOISTURE PENETRATION. SIMILAR FLASHING SHALL BE PROVIDED AT ROOF VALLEYS AND ROOF OPENINGS, WOOD OR METAL COPINGS AND SILLS.
- F. THE CONTRACTOR SHALL PROVIDE PERFORATED SOFFITS AT THE ROOF EAVES AND A CONTINUOUS RIDGE VENT AT THE ROOF TO PROVIDE REQUIRED ATTIC VENTILATION.

STAIRS, HANDRAILS and GUARDS:

- A. STAIRS SHALL COMPLY WITH SECTION R311 OF THE IRC. STAIRWAYS SHALL NOT BE LESS THAN 36 INCHES IN CLEAR WIDTH AT ALL POINTS ABOVE THE PERMITTED HANDRAIL HEIGHT AND BELOW THE REQ'D HEADROOM HEIGHT; 31.5 INCHES WHERE A HANDRAIL IS INSTALLED ON ONE SIDE; 27 INCHES WHERE HANDRAILS ARE INSTALLED ON BOTH SIDES.
- B. MINIMUM HEADROOM IN ALL PARTS OF THE STAIRWAY SHALL NOT BE LESS THAN 6 FEET 8 INCHES.
- C. MAXIMUM STAIR RISER HEIGHT SHALL BE 7-3/4 INCHES AND MINIMUM TREAD DEPTH SHALL BE 10 INCHES. (UNLESS NOTED OTHERWISE IN CONTRACT DRAWINGS.)
- D. HANDRAILS SHALL BE PROVIDED ON AT LEAST ONE SIDE OF EACH STAIRWAY WITH FOUR OR MORE RISERS. HANDRAILS SHALL BE A MINIMUM OF 34 INCHES AND A MAXIMUM OF 38 INCHES ABOVE TREAD NOSING.
- E. PORCHES, BALCONIES, RAMPS OR RAISED FLOOR SURFACES LOCATED MORE THAN 30 INCHES ABOVE THE FLOOR OR GRADE BELOW SHALL HAVE GUARDS NOT LESS THAN 36 INCHES IN HEIGHT.
- F. REQUIRED GUARDS SHALL HAVE INTERMEDIATE RAILS OR ORNAMENTAL CLOSURES WHICH DO NOT ALLOW PASSAGE OF A SPHERE 4 INCHES OR MORE IN DIAMETER.

SPECIALTIES:

- A. SMOKE ALARMS SHALL COMPLY WITH SECTION R314 OF THE IRC. SMOKE ALARMS SHALL BE INSTALLED IN EACH SLEEPING ROOM AND OUTSIDE EACH SEPARATE SLEEPING AREA IN THE IMMEDIATE VICINITY OF THE BEDROOMS AND ON EACH ADDITIONAL STORY OF THE HOUSE INCLUDING THE BASEMENT.
- B. SMOKE ALARMS SHALL RECEIVE THEIR PRIMARY POWER FROM THE HOUSE WIRING. WHEN PRIMARY POWER IS INTERRUPTED, SMOKE ALARMS SHALL RECEIVE POWER FROM A BATTERY.
- C. CARBON MONOXIDE ALARMS SHALL COMPLY WITH SECTION R315 OF THE IRC. CARBON MONOXIDE ALARMS SHALL BE INSTALLED OUTSIDE EACH SEPARATE SLEEPING AREA IN THE IMMEDIATE VICINITY OF THE BEDROOMS.
- D. CARBON MONOXIDE ALARMS ARE REQUIRED IN DWELLING UNITS WHICH HAVE FUEL-FIRED APPLIANCES OR ATTACHED GARAGES.

MECHANICAL, ELECTRICAL & PLUMBING:

- A. H.V.A.C. DESIGN AND INSTALLATION TO BE PERFORMED BY LICENSED MECHANICAL CONTRACTOR IN COMPLIANCE WITH ALL APPLICABLE CODES.
- B. ELECTRICAL DESIGN AND INSTALLATION TO BE PERFORMED BY LICENSED ELECTRICAL CONTRACTOR IN COMPLIANCE WITH ALL APPLICABLE CODES.
- C. PLUMBING DESIGN AND INSTALLATION TO BE PERFORMED BY LICENSED PLUMBING CONTRACTOR IN COMPLIANCE WITH ALL APPLICABLE CODES.
- D. IF REQUIRED, FIRE SPRINKLER SYSTEM TO BE DESIGNED AND INSTALLED BY LICENSED SPRINKLER CONTRACTOR IN COMPLIANCE WITH ALL APPLICABLE CODES.

PROJECT GENERAL NOTES:


- A. WALL DIMENSIONS ARE FROM OUTSIDE FACE OF FRAMING AND ARE AS FOLLOWS (U.O.N.):

INTERIOR PARTITIONS =	3-1/2" (2x4 WOOD STUDS @ 16" O.C.) or 5-1/2" (2x6 WOOD STUDS @ 16" O.C.) WHERE INDICATED
EXTERIOR WALLS =	6" (2x6 STUDS @ 16" O.C. PLUS 1/2" SHEATHING)
- B. THE CONTRACTOR AND HIS ASSOCIATED SUBCONTRACTORS ARE RESPONSIBLE TO THOROUGHLY REVIEW ALL DRAWINGS. ANY INCONSISTENCIES OR ERRORS ARE TO BE REPORTED TO THE DESIGNER FOR CLARIFICATION OR CORRECTION PRIOR TO THE START OF CONSTRUCTION OR MANUFACTURING OF PRE-FABRICATED COMPONENTS.
- C. IF THE CONTRACTOR MODIFIES OR DEVIATES FROM THESE PLANS FOR ANY REASON WITHOUT NOTIFYING CADWORKS, INC., THE PLAN'S CODE COMPLIANCE BECOMES THE CONTRACTOR'S RESPONSIBILITY.
- D. SIZING/SPACING OF ALL PRE-ENGINEERED WOOD FRAMING PRODUCTS (MICROLAMS, PARALLAMS, & FLOOR/ROOF TRUSSES) TO BE ENGINEERED/VERIFIED BY MANUFACTURER.
- E. FLOOR FRAMING TO BE ACCOMPLISHED WITH PRE-ENGINEERED WOOD "I" JOISTS; MANUFACTURER'S AGENT TO DESIGN JOIST LAYOUT AND PROVIDE ENGINEERED SHOP DRAWINGS; FLOOR SYSTEM TO BE DESIGNED WITH L/480 LIVE LOAD DEFLECTION MIN. (L/600 IN AREAS TO BE FINISHED WITH TILE).
- F. ROOF FRAMING TO BE ACCOMPLISHED WITH PRE-ENGINEERED WOOD TRUSSES; MANUFACTURER'S AGENT TO DESIGN TRUSS LAYOUT AND PROVIDE ENGINEERED SHOP DRAWINGS.
- G. THE STAIR MANUFACTURER SHALL VERIFY EXISTING FIELD CONDITIONS PRIOR TO FABRICATION OF STAIR; STAIR TO BE BUILT IN COMPLIANCE WITH ALL APPLICABLE CODES.
- H. THESE DOCUMENTS ARE NOT TO BE SCALED. DIMENSIONS SHALL GOVERN ON ALL DRAWINGS. ANY OMISSIONS OR AREAS OF DISCREPANCY SHALL BE REFERRED TO CADWORKS, INC. PRIOR TO CONSTRUCTION.

WINDOWS AND DOORS:

- A. ALL WINDOW NUMBERS INDICATE MODEL NUMBERS FOR "ANDERSEN" WINDOW UNITS.
- B. WINDOWS INDICATED ON DRAWINGS AS "EGRESS" SHOULD MEET BUILDING CODE REQUIREMENTS PER SECTION R310 OF THE IRC.
- C. WINDOWS IN DOORS, SIDE LIGHTS AND WINDOWS WITHIN 24" OF DOORS SHALL BE PROVIDED WITH SAFETY GLASS TO COMPLY WITH SECTION R308 OF THE IRC.
- D. GLASS AT TUBS AND SHOWER ENCLOSURES SHALL BE PROVIDED WITH SAFETY GLASS TO COMPLY WITH SECTION R308 OF THE IRC.

Professional Certification. I hereby certify that these documents were prepared or approved by me, and that I am a duly licensed professional engineer under the laws of the State of Maryland, License No. 24342, Expiration Date: 11-17-2019.

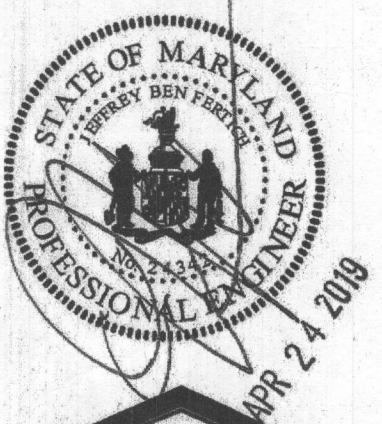


STRUCTURAL ENGINEERING RESOURCES, LLC
26 NORTH FOURTH STREET
GETTYSBURG, PA 17325
(717) 337-1335
www.SERLLC.us

BOOSALIS RESIDENCE
12090 HALL SHOP ROAD
CLARKSVILLE, MARYLAND
301-401-3399


4/23/2019

CV

of 7

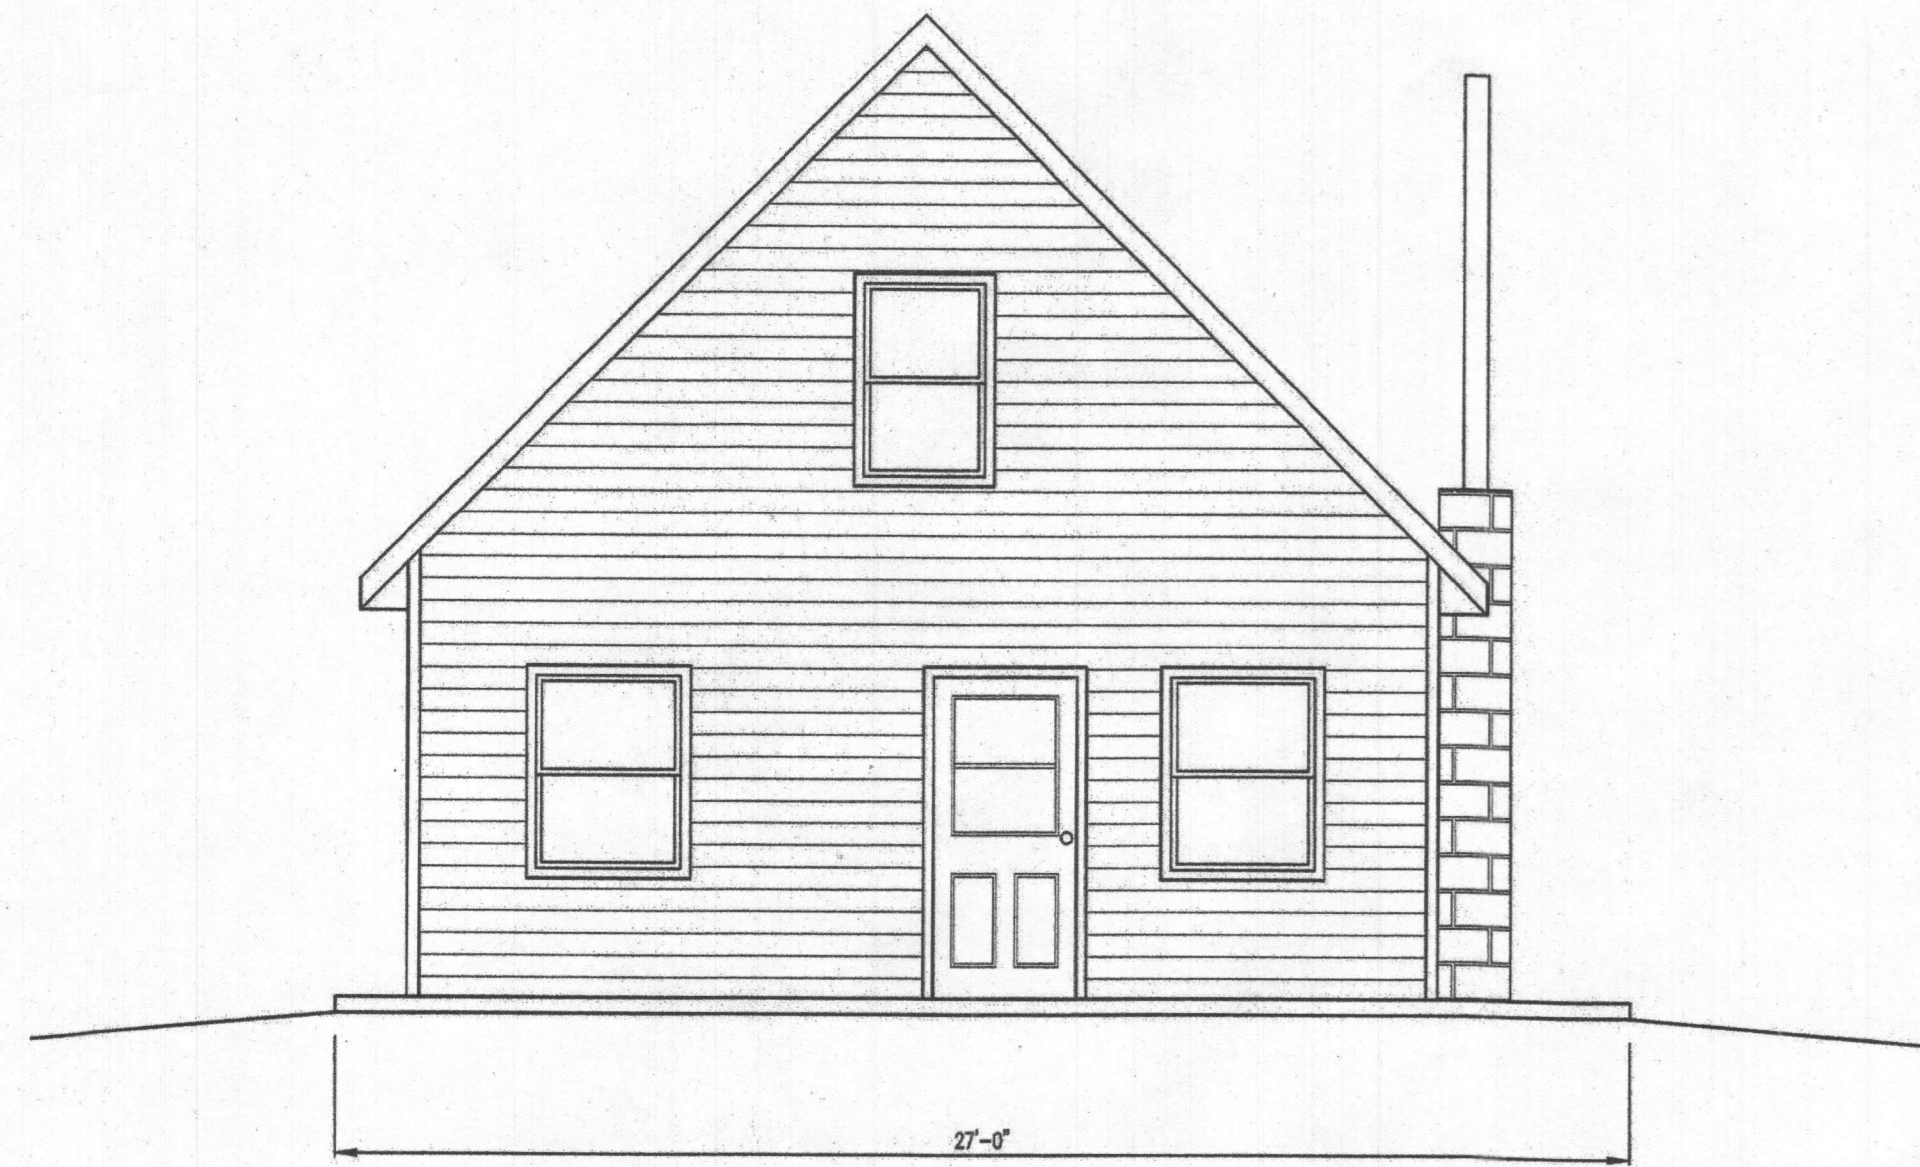


EXISTING FRONT ELEVATION
1/4" PER FOOT

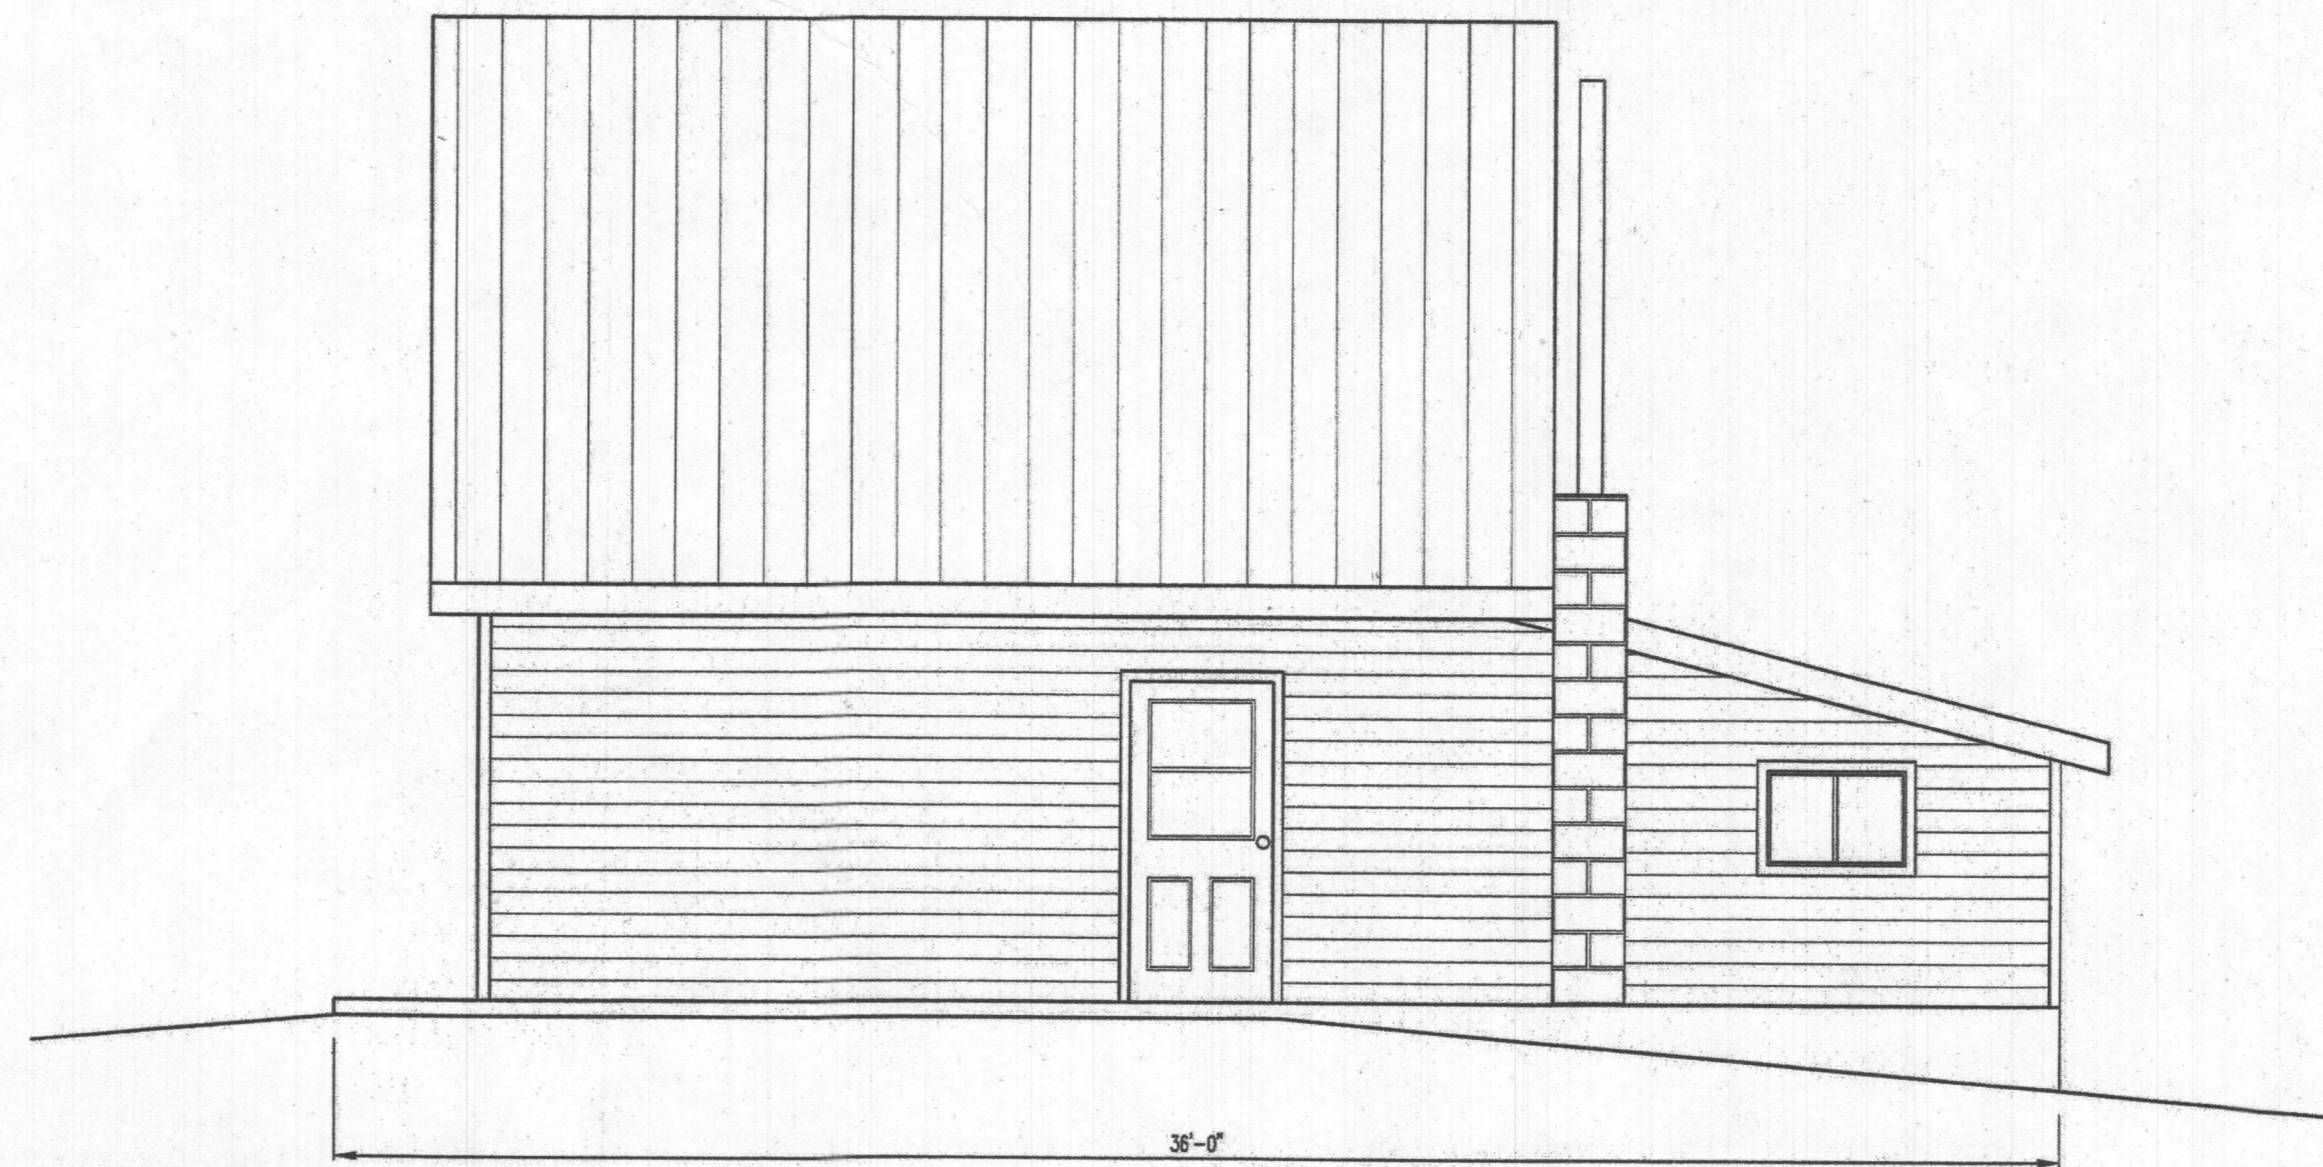

EXISTING RIGHT SIDE ELEVATION
1/4" PER FOOT




EXISTING REAR ELEVATION
1/4" PER FOOT

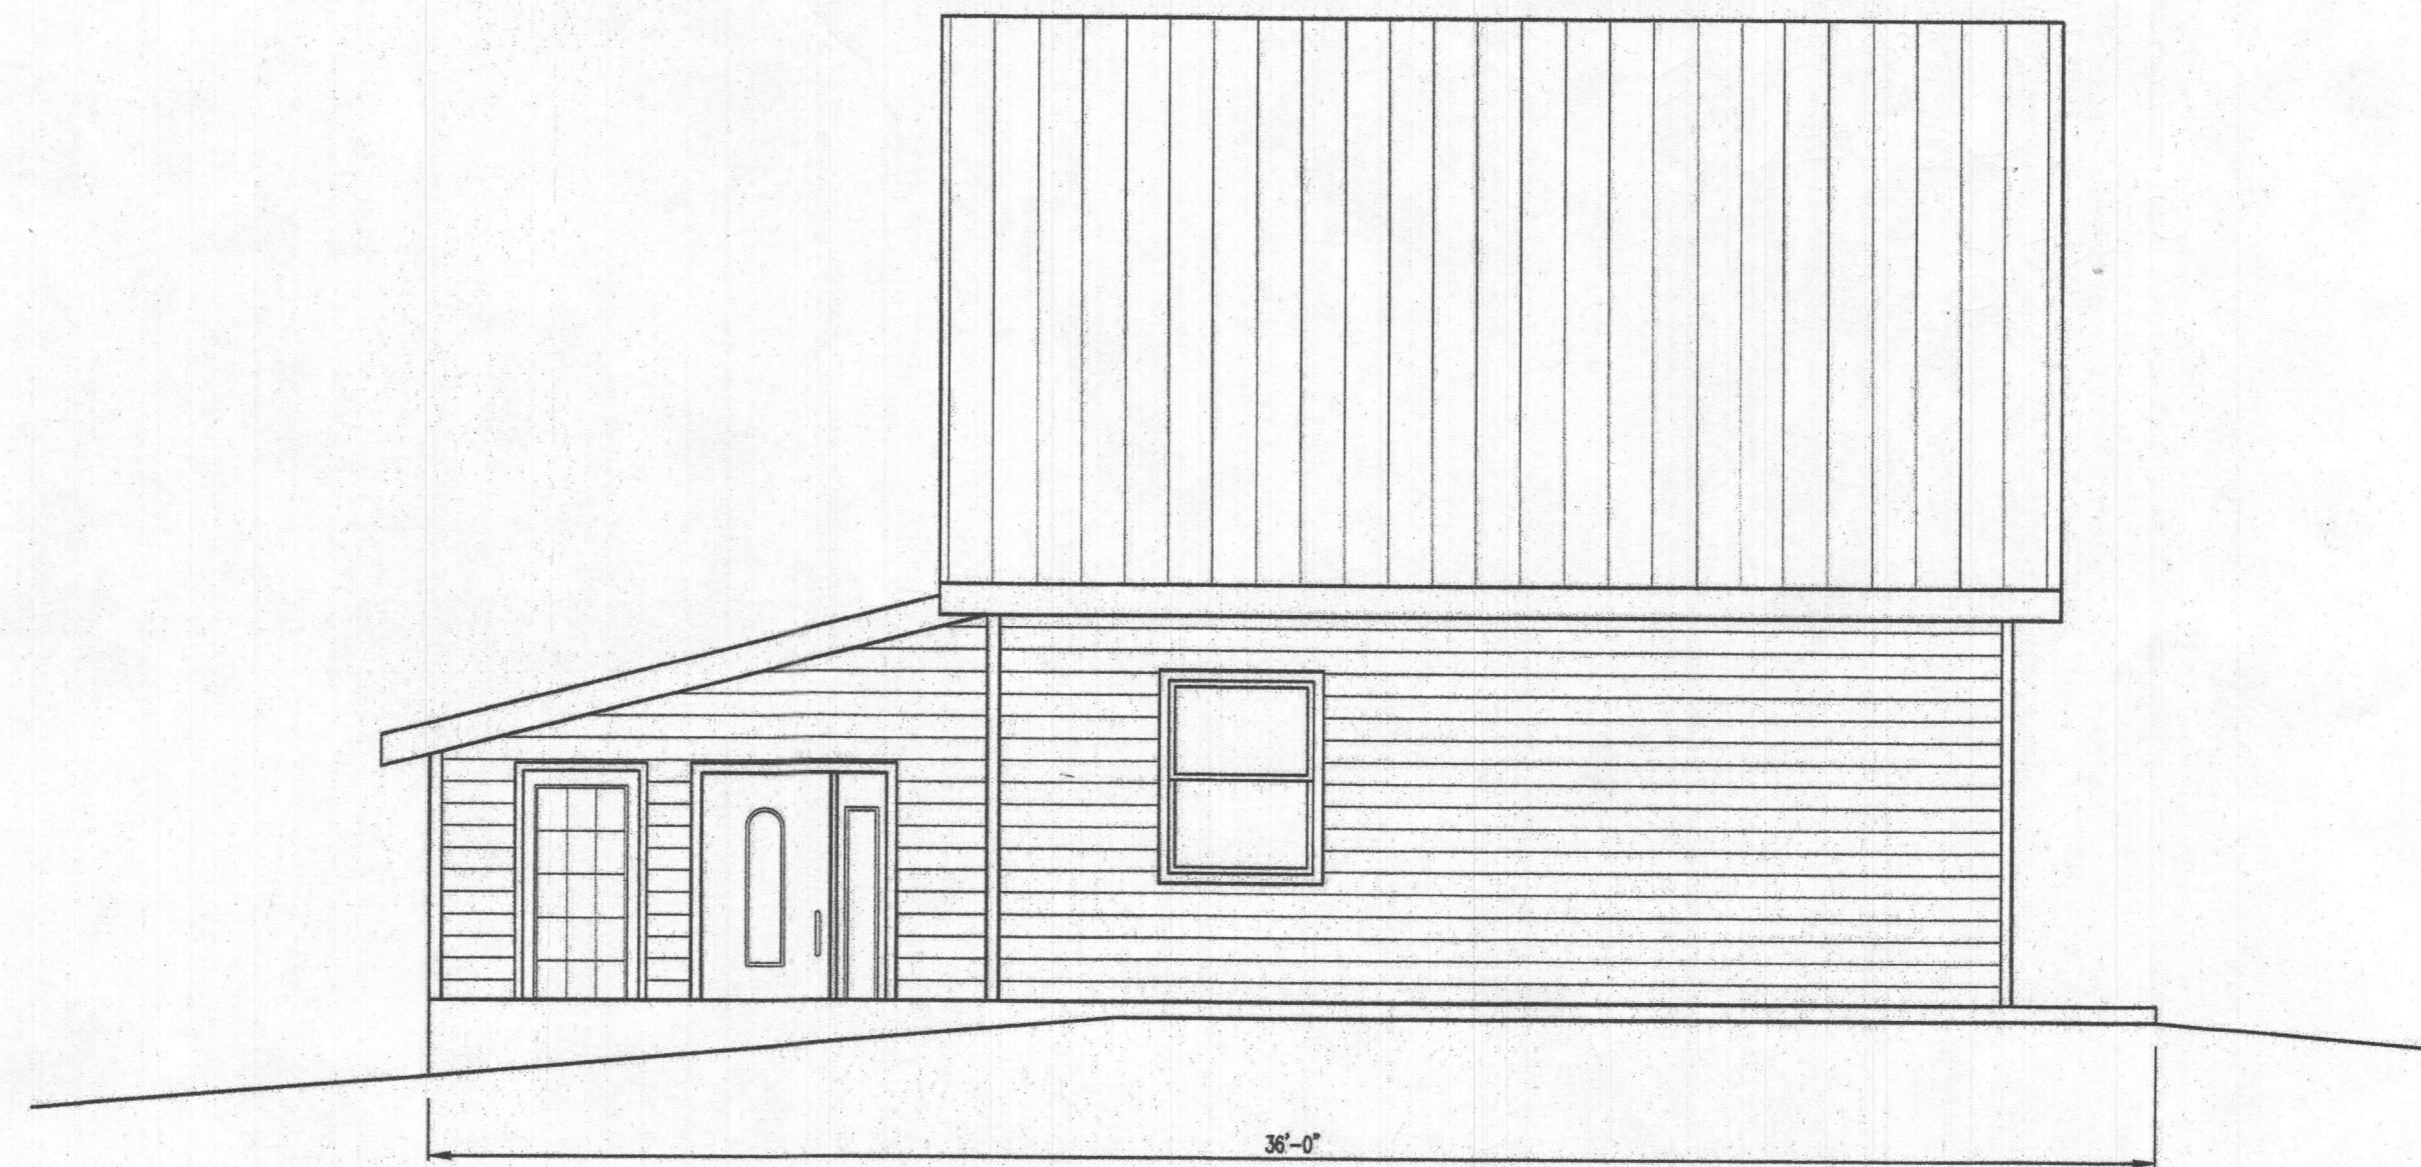


EXISTING LEFT SIDE ELEVATION
1/4" PER FOOT

'OK' reb. 5/29/2018
B1500 3264

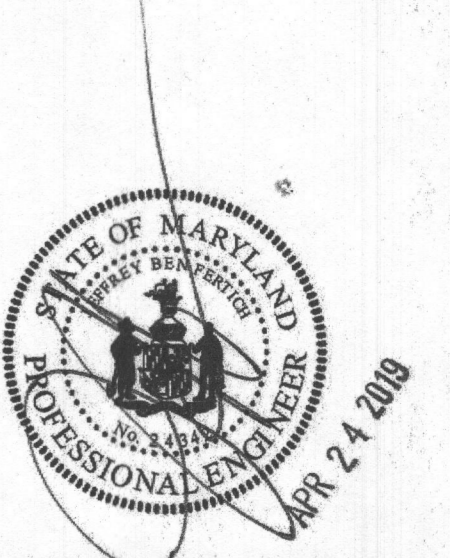

Professional Certification. I hereby certify that these documents were prepared or approved by me, and that I am a duly licensed professional engineer under the laws of the State of Maryland, License No. 24342, Expiration Date: 11-17-2019.

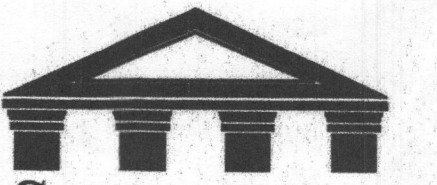

**STRUCTURAL
ENGINEERING
RESOURCES, LLC**


26 NORTH FOURTH STREET
GETTYSBURG, PA 17325
(717) 337-1335
www.SERLLC.us

BOOSALIS RESIDENCE
12090 HALL SHOP ROAD
CLARKSVILLE, MARYLAND
301-401-3399


EXISTING ELEVATIONS

4/23/2019


A1 of 7

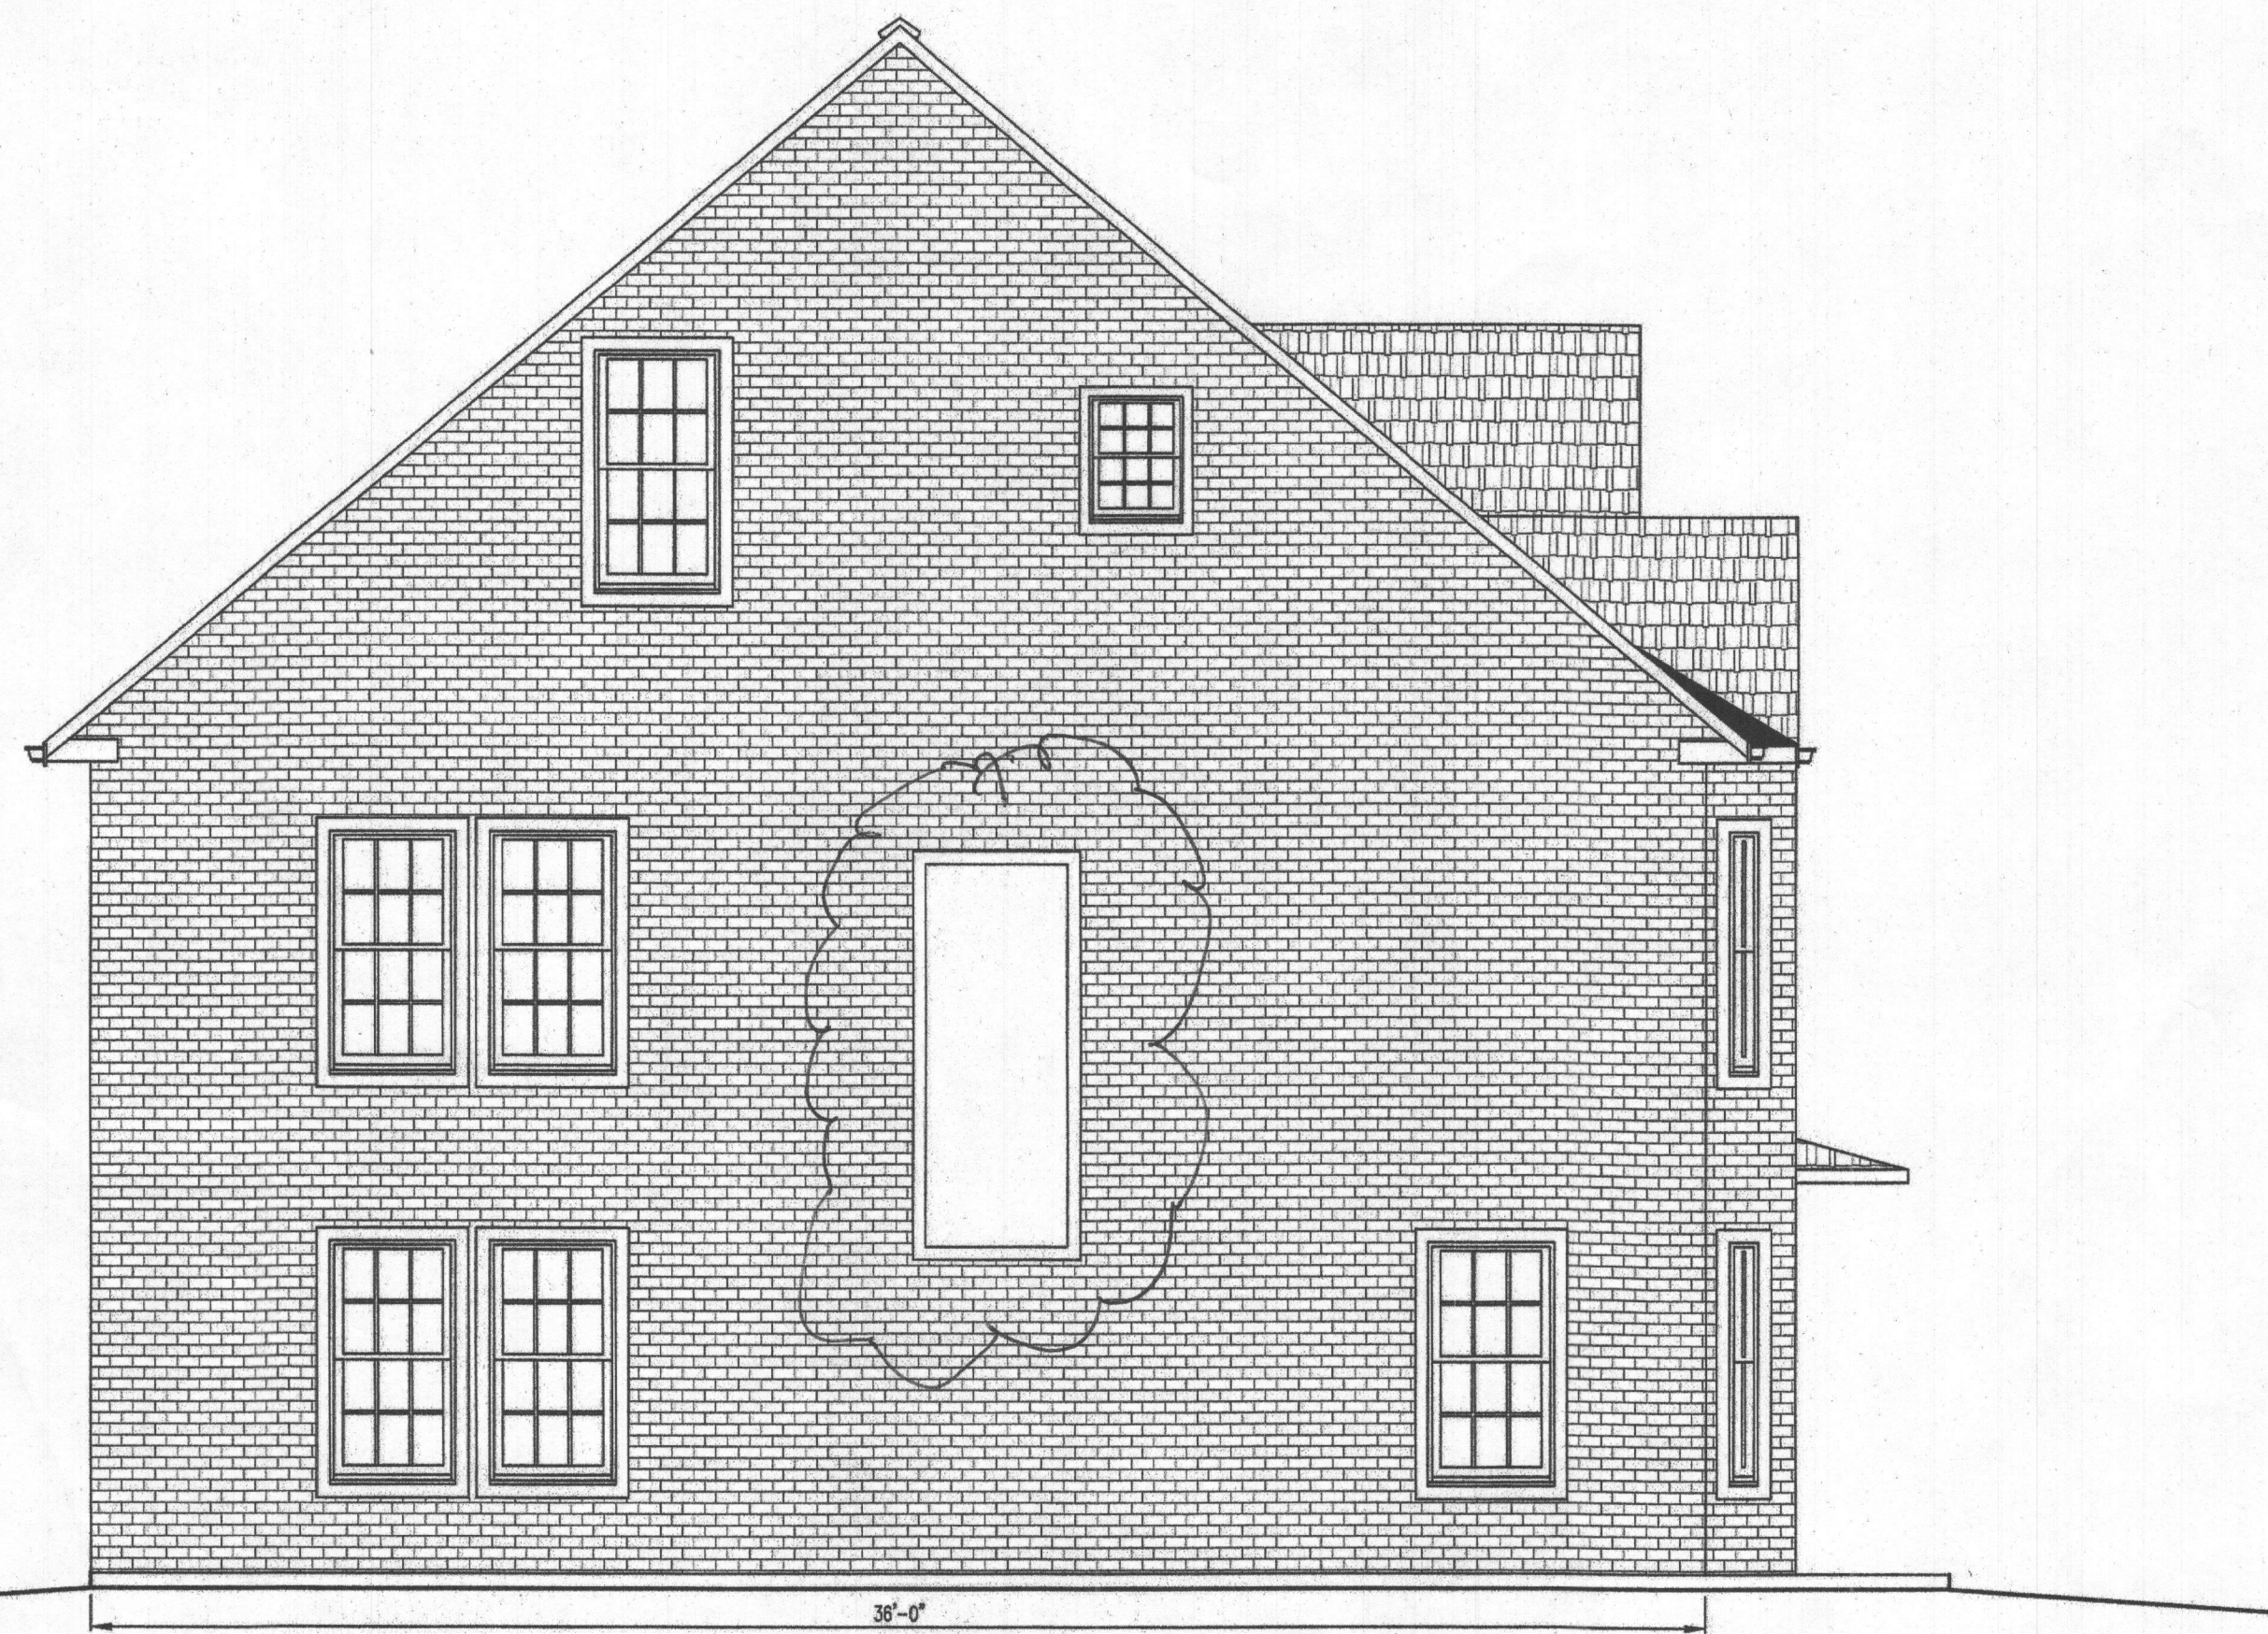


LEFT ELEVATION
1/4"=1'-0"

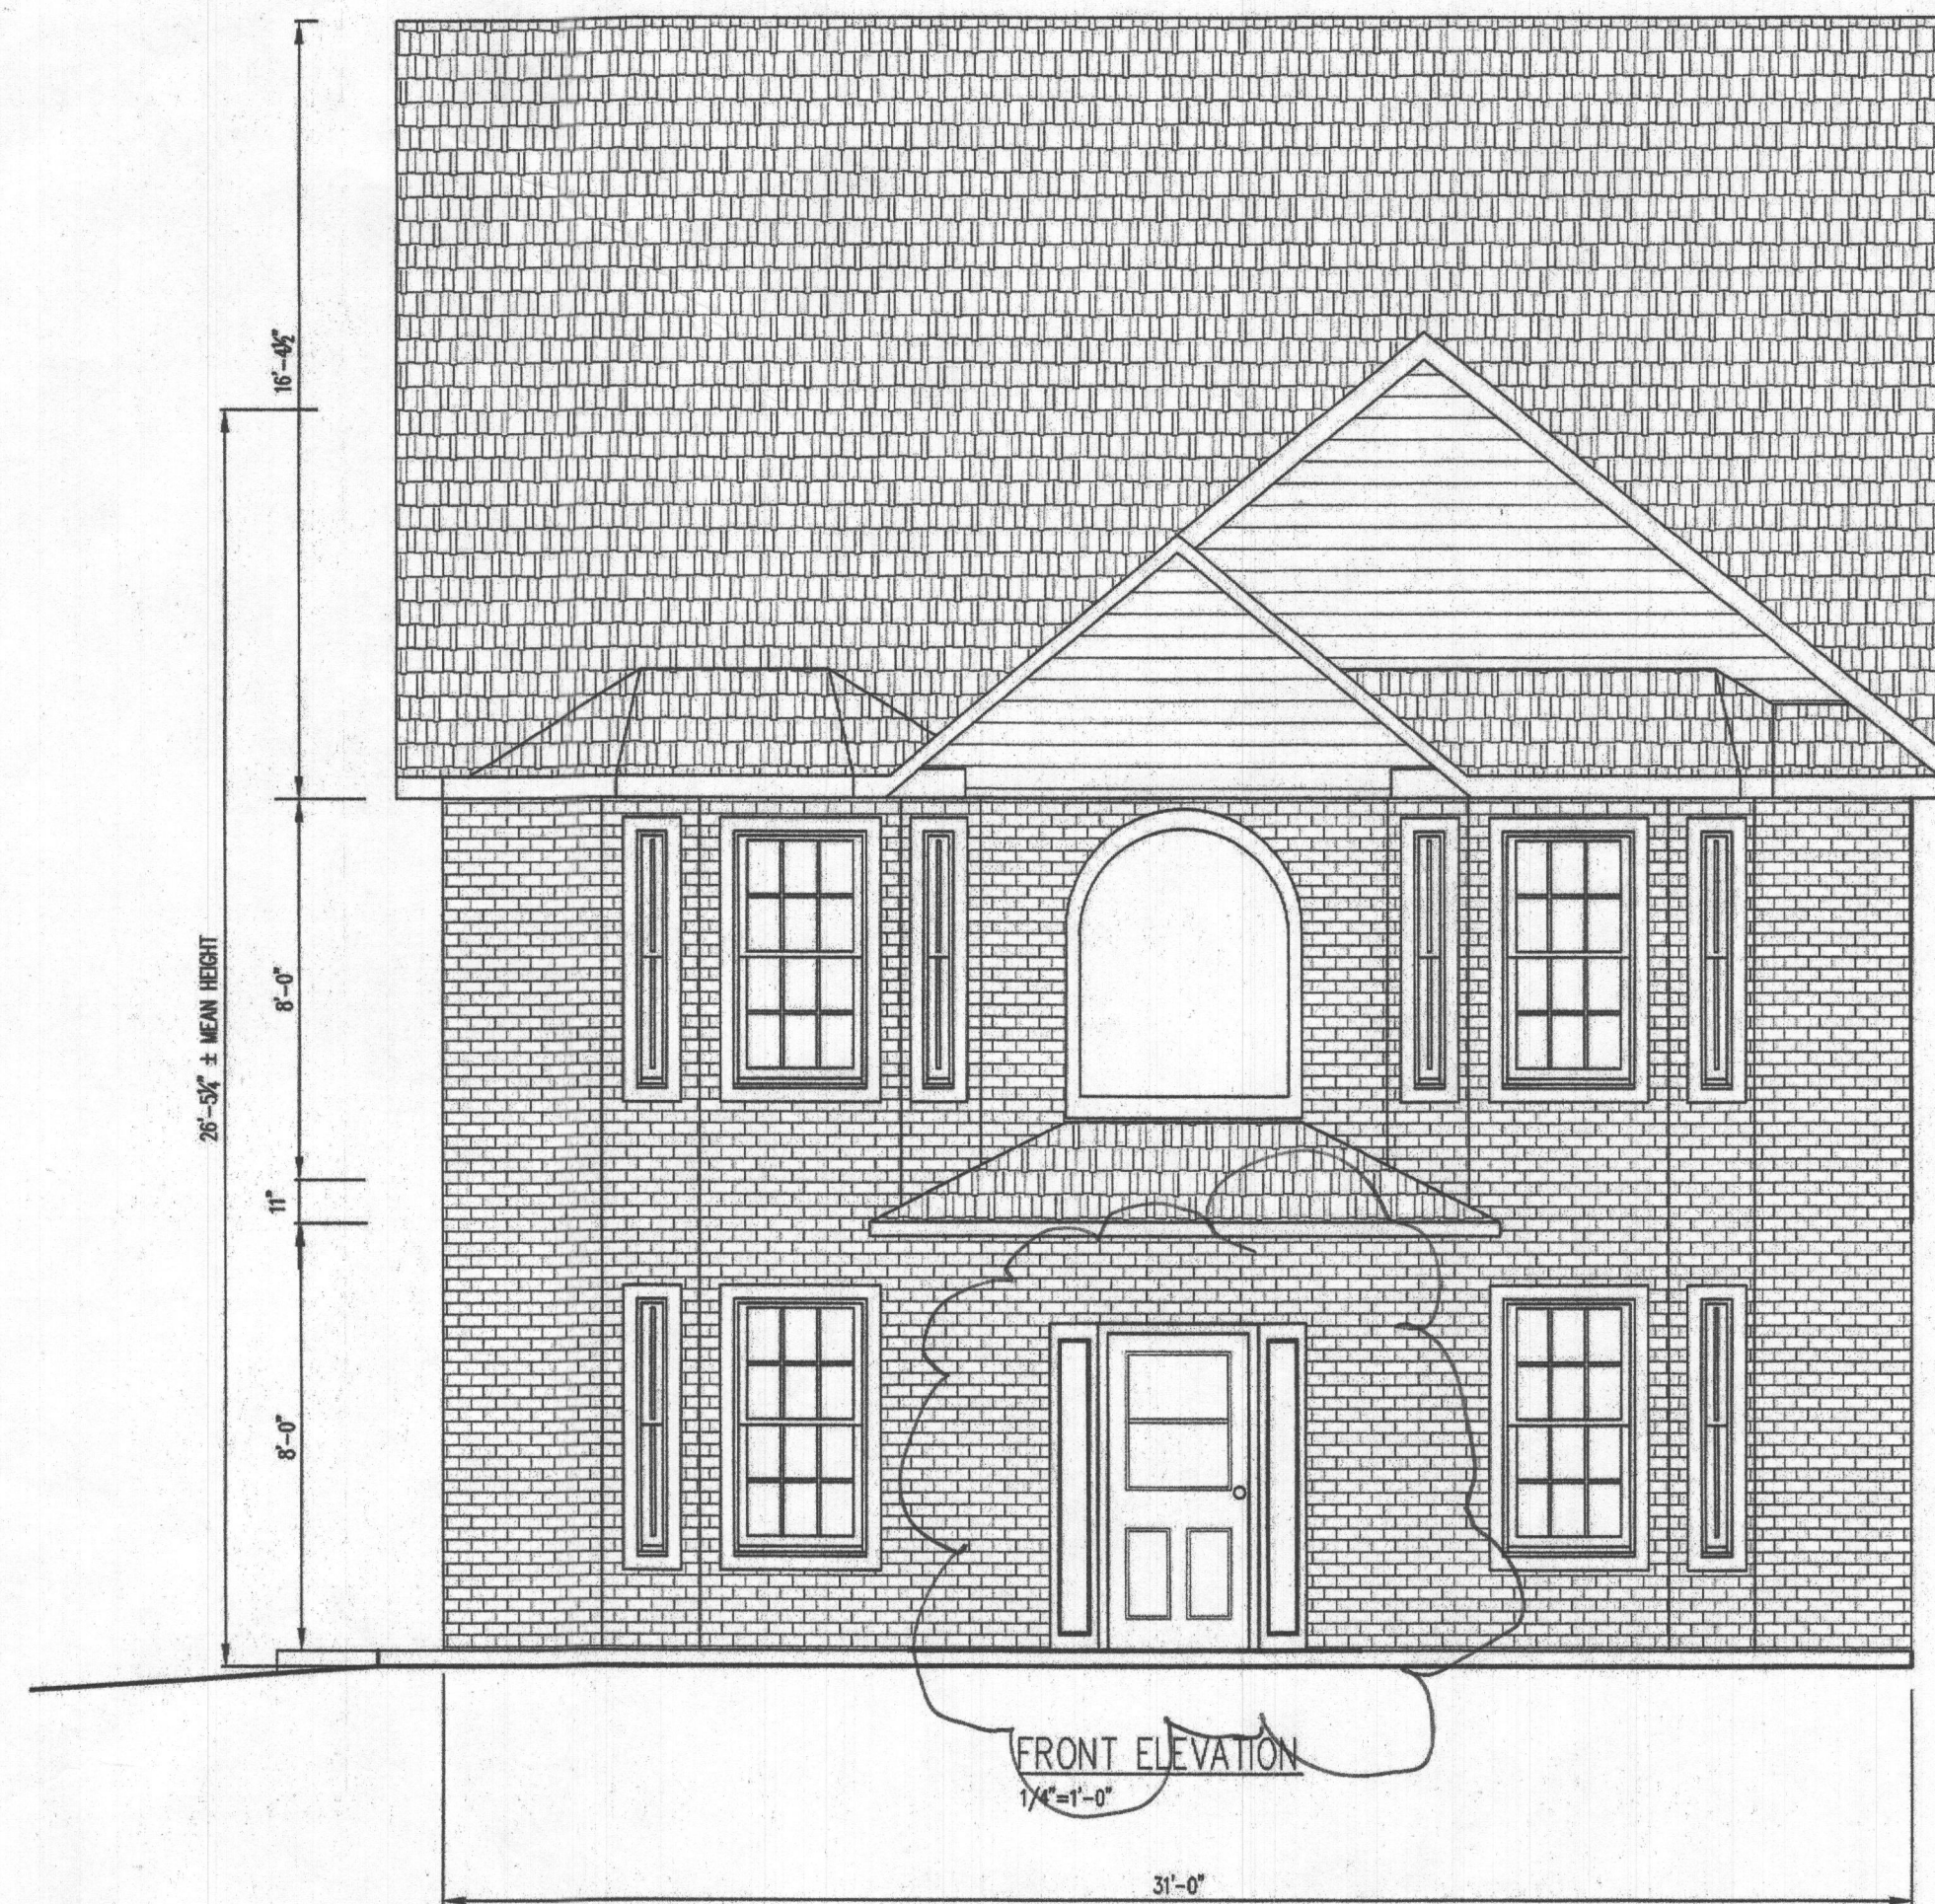

FRONT ELEVATION
1/4"=1'-0"

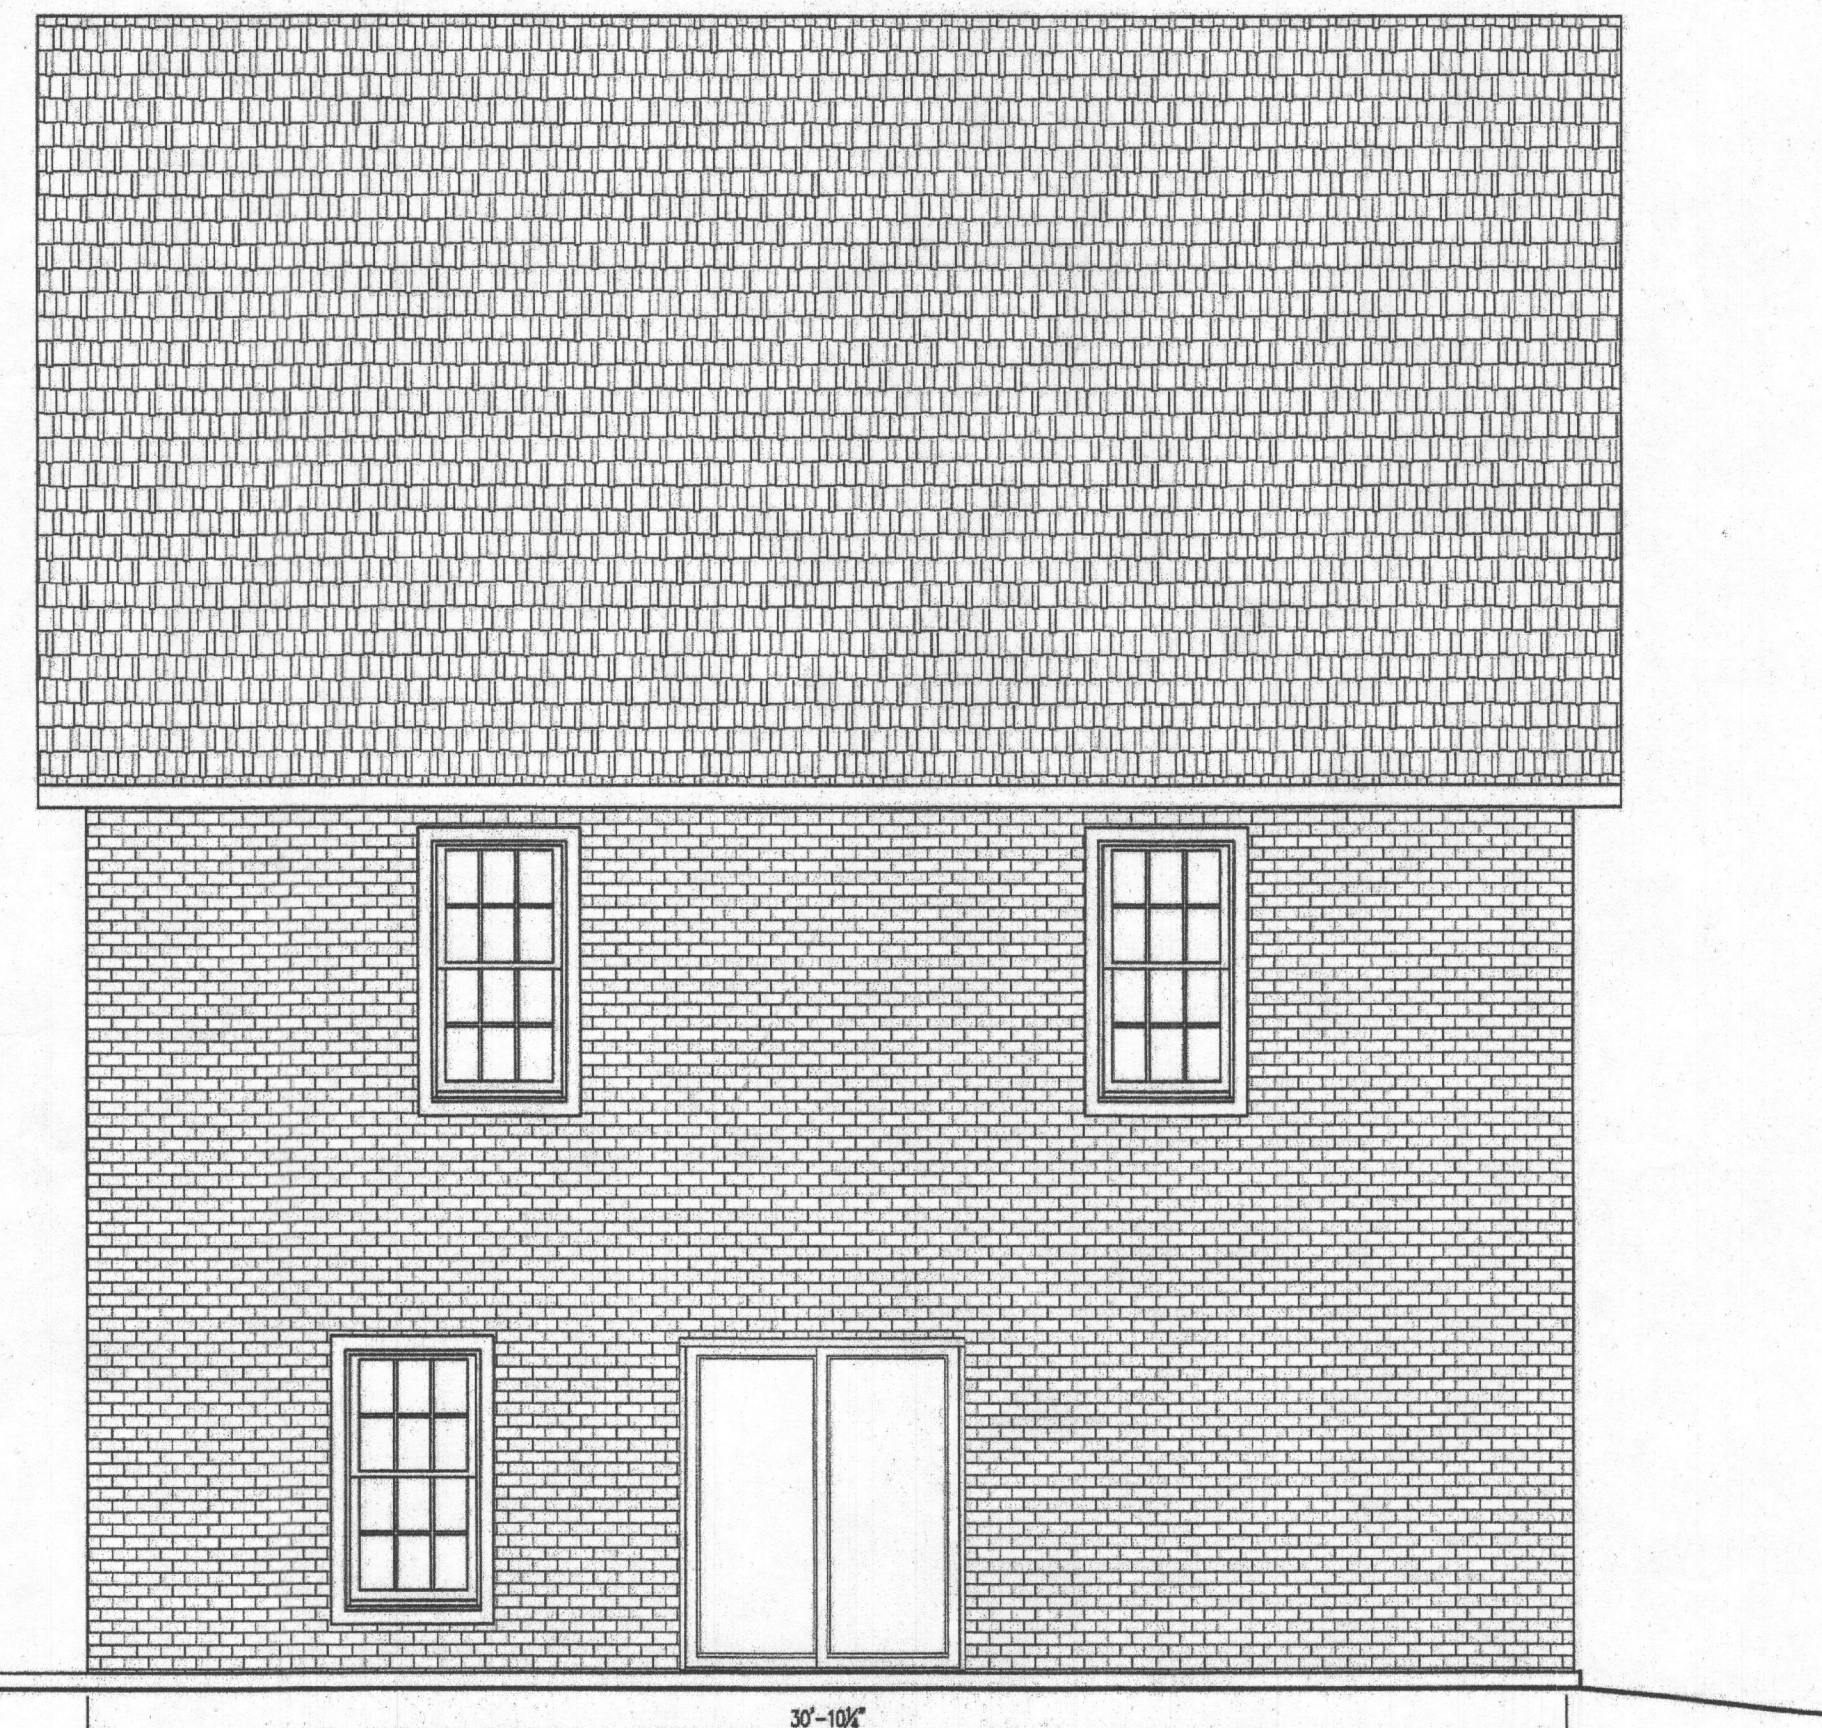

BACK ELEVATION
1/4"=1'-0"

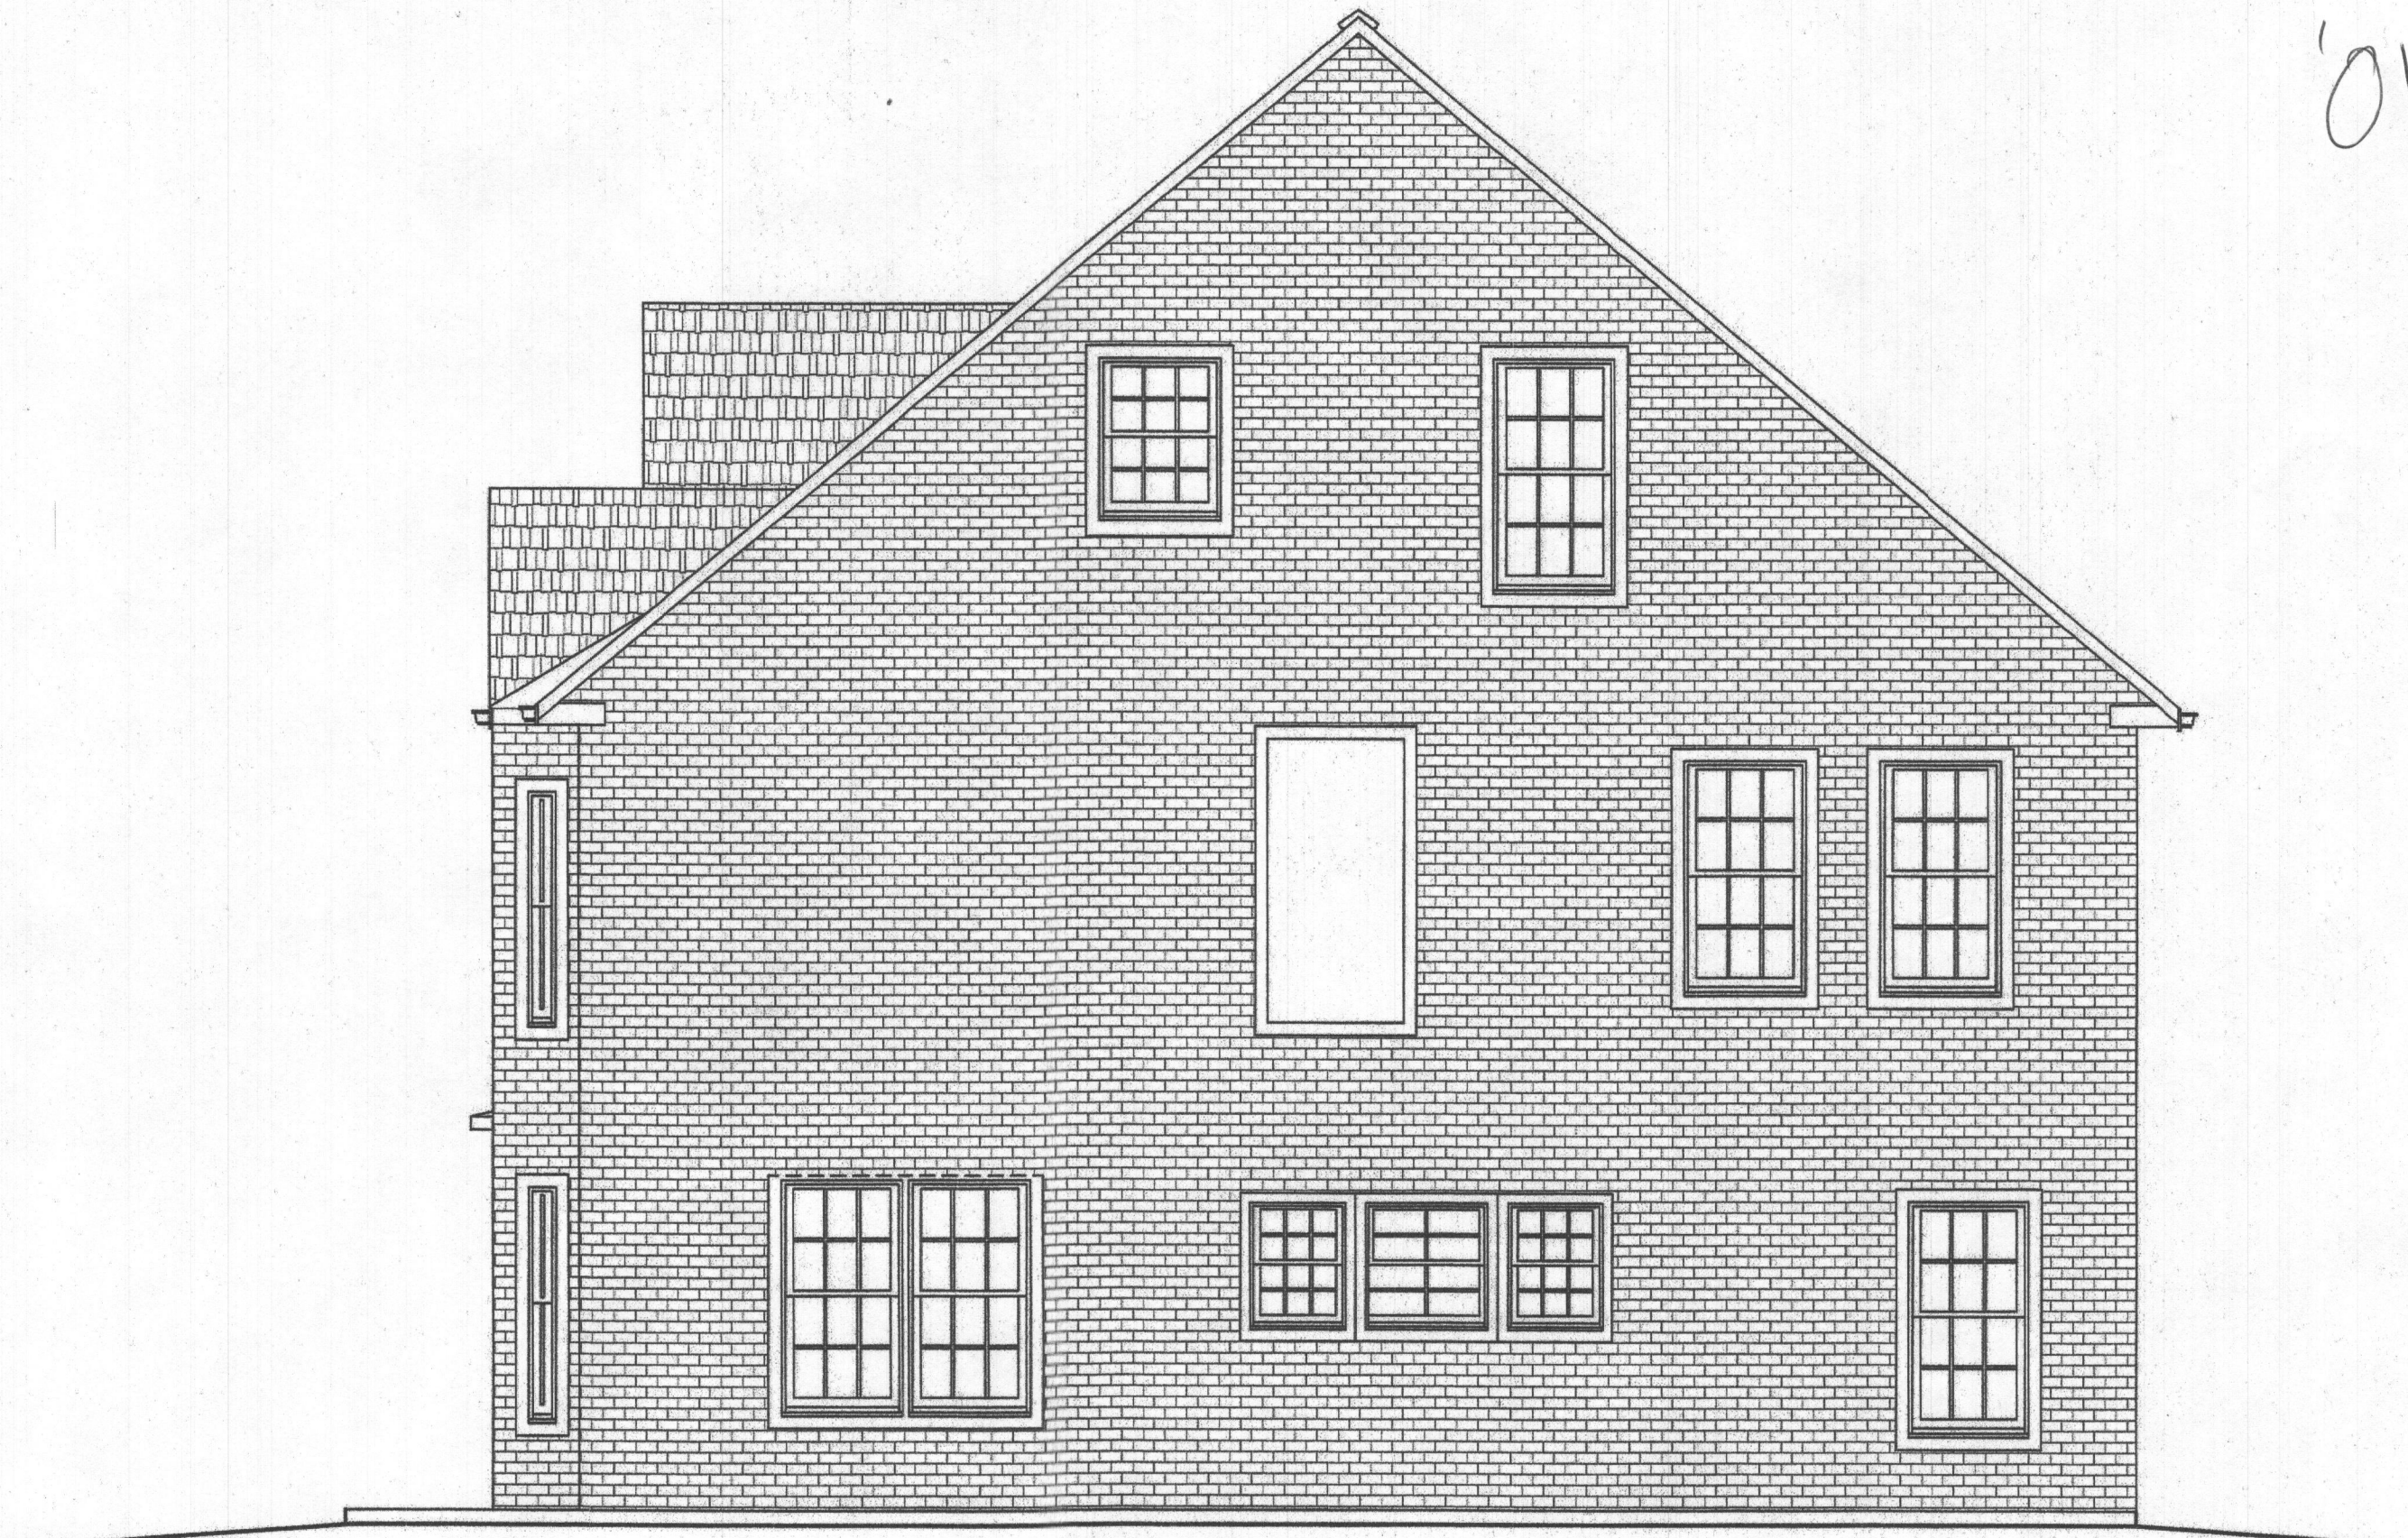

RIGHT ELEVATION
1/4"=1'-0"

OK' rrb 5/29/2019
B15003264

DIVISION 1 - GENERAL REQUIREMENTS
 ALL WORK TO CONFORM WITH THE REQUIREMENTS OF BUILDING CODE: INTERNATIONAL RESIDENTIAL CODE, 2015

DESIGN LIVE LOADS
 ROOF STRUCTURAL ELEMENTS SHALL BE DESIGNED FOR THE MORE CRITICAL OF THE FOLLOWING:
 FLOOR SNOW LOAD 30 PSF
 FLOOR LIVE LOAD 40 PSF

DESIGN WIND LOADS ARE BASED ON A BASIC WIND SPEED OF 115 MPH.

SUBMITTALS
 UNLESS OTHERWISE NOTED ELSEWHERE IN THE CONSTRUCTION DOCUMENTS, SHOP DRAWINGS SHALL BE REQUIRED ON THE FOLLOWING ITEMS:

1. WOOD ROOF TRUSSES, SEALED BY A PROFESSIONAL ENGINEER

DIVISION 2 - FOUNDATION
ASSUMED SOIL BEARING VALUE
 2000 POUNDS PER SQUARE FOOT FOR COLUMN AND WALL FOOTINGS. THE G.C. SHALL IMMEDIATELY NOTIFY THE ARCHITECT OF ANY INDICATION IN THE SOILS OF INSUFFICIENT BEARING CAPACITY.

FOUNDATION
 ALL SPREAD FOOTINGS SHALL EXTEND MINIMUM 1'-0" INTO UNDISTURBED SOIL OR SHALL BEAR ON UNDISTURBED SOIL. THE BOTTOM OF ALL EXTERIOR FOOTINGS SHALL BE A MINIMUM OF 2'-0" BELOW THE FINISHED EXTERIOR GRADE UNLESS NOTED OTHERWISE.

DIVISION 3 - CONCRETE
STRUCTURAL CONCRETE
 REINFORCING STEEL SHALL CONFORM TO ASTM A615, GRADE 60. ALL WELDED WIRE FABRIC SHALL CONFORM TO ASTM A185. DETAILING SHALL BE IN ACCORDANCE WITH ACI MANUAL 315 AND STANDARD 318-95. CONCRETE SHALL BE NORMAL WEIGHT. DESIGN COMPRESSIVE STRENGTH AT 28 DAYS SHALL BE 3000 PSI. EXPOSED EXTERIOR CONCRETE SHALL BE 3500 PSI.


PROVIDE CONCRETE PROTECTION FOR REINFORCING AS FOLLOWS:
 FOOTING: 3" WALLS: OUTSIDE FACE = 2"
 INTERIOR SLABS: 3/4" INSIDE FACE = 1"
 EXTERIOR SLABS: 1 1/2"

DIVISION 6 - TIMBER
WOOD FRAMING
 ALL LUMBER SHALL COMPLY WITH THE REQUIREMENTS OF AMERICAN INSTITUTE OF TIMBER CONSTRUCTION AND THE AMERICAN FOREST & PAPER ASSOCIATIONS (AFPA) NATIONAL DESIGN SPECIFICATIONS FOR WOOD CONSTRUCTION - WOOD FRAME CONSTRUCTION MANUAL.

ALL STRUCTURAL WOOD MEMBERS SHALL BE SPF#2 OR BETTER.


ALL EXPOSED LUMBER SHALL BE PRESSURE TREATED WOOD MEMBERS #2 SOUTHERN PINE OR BETTER.

Professional Certification. I hereby certify that these documents were prepared or approved by me, and that I am a duly licensed professional engineer under the laws of the State of Maryland, License No. 24542, Expiration Date: 11-17-2019.

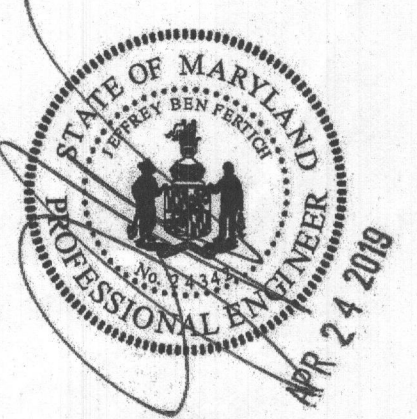

STRUCTURAL ENGINEERING RESOURCES, LLC
 26 NORTH FOURTH STREET
 GETTYSBURG, PA 17325
 (717) 337-1335
 www.SERLLC.us

BOOSALIS RESIDENCE
 12090 HALL SHOP ROAD
 CLARKSVILLE, MARYLAND
 301-401-3399

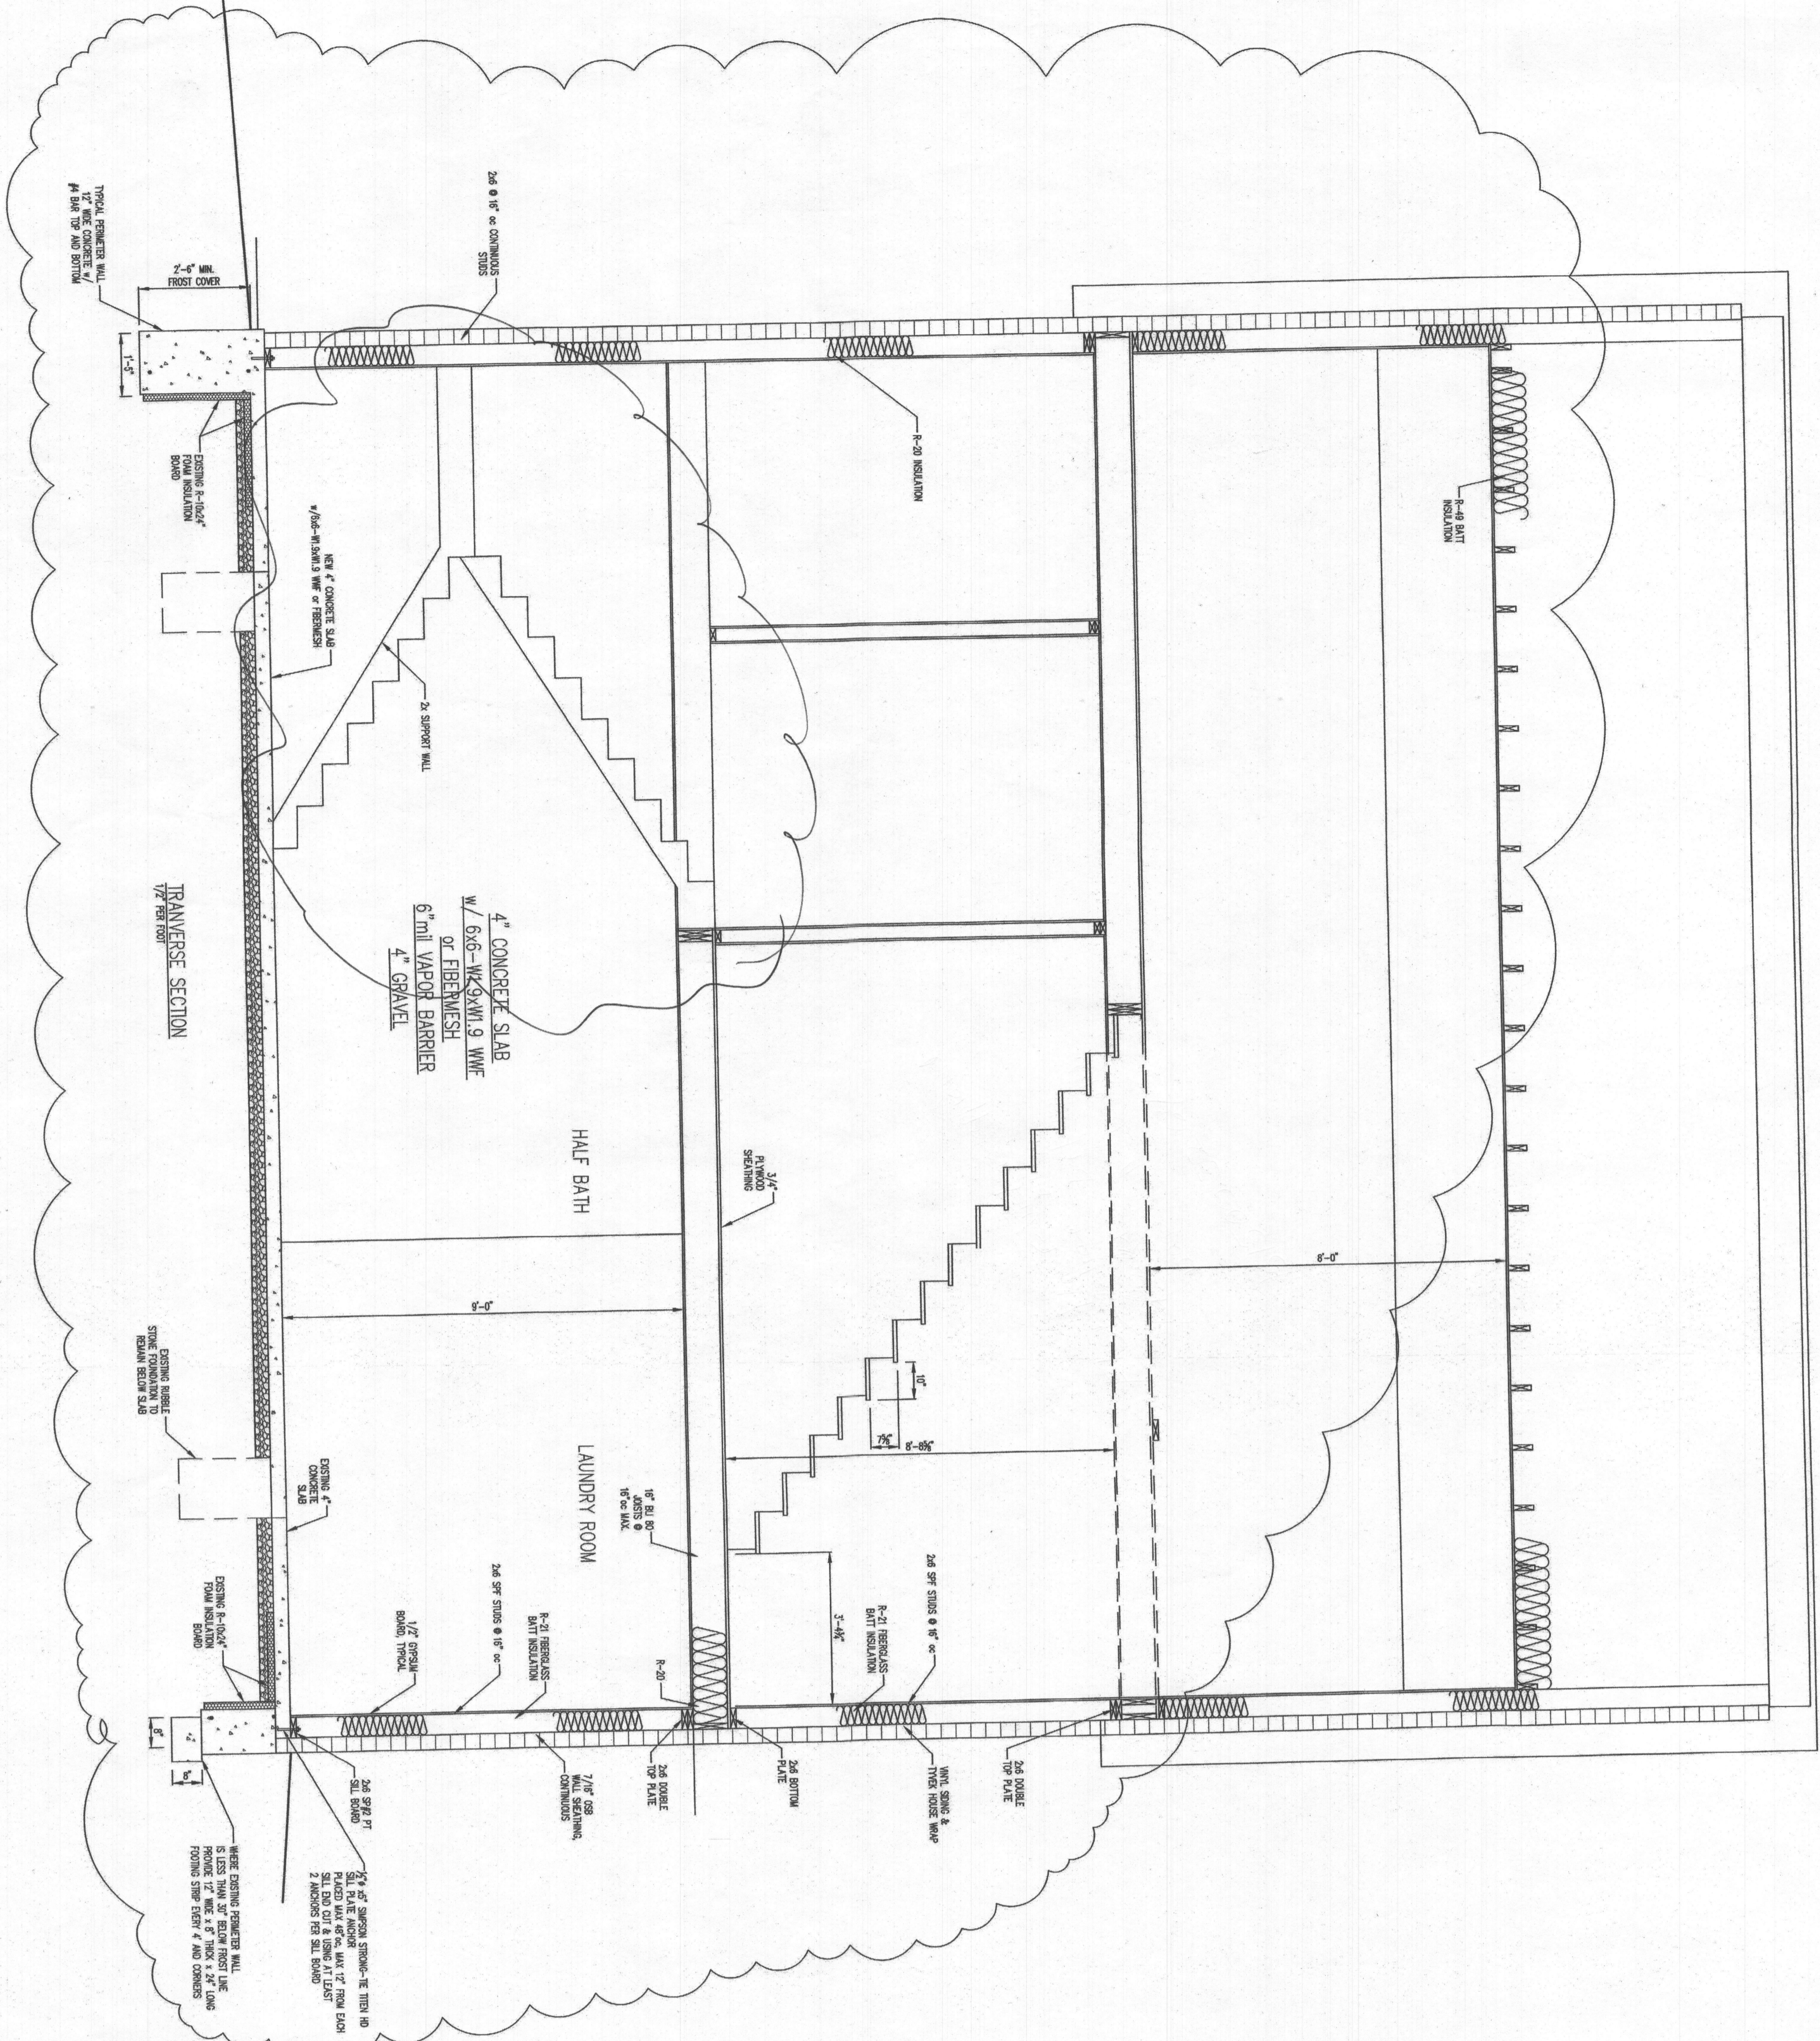


TRANVERSE SECTION
1/4" = 1'-0"

EXISTING HURDLE
STONE FOUNDATION TO
REMAIN EXISTING SLAB

EXISTING R-10 1/2"
FOAM INSULATION
BOARD

WHERE EXISTING PERIMETER WALL
IS LESS THAN 30" FROM FROST LINE
PROVIDE STEEP SLOPE 4" AND CONCRESE
2" MINIMUM TO EXISTING WALL

1/4" OF GYPSUM ABOVE- THE MIN 18"
SILL PLATE AND/OR
PLACED MAX 16" MAX 12" FROM EACH
2" MINIMUM TO EXISTING WALL

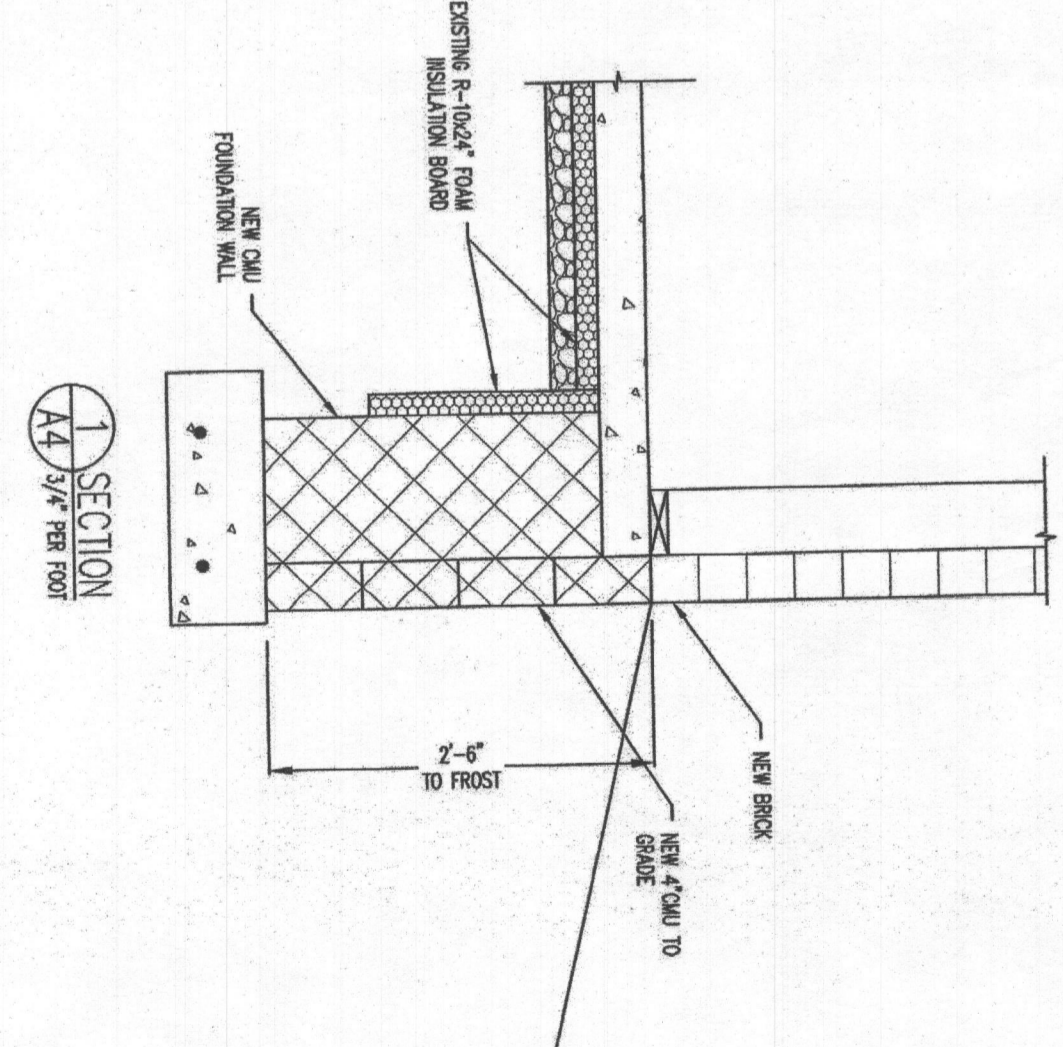

REVISED INSULATION & FOOTING DEPTH
4-23-2019

OK' RB 5/24/2019
B15003264


BOOSALIS RESIDENCE
12090 HALL SHOP ROAD
CLARKSVILLE, MARYLAND
301-401-3399

SECTION
4/23/2019
A4
of 7

STRUCTURAL ENGINEERING RESOURCES, LLC
26 NORTH EIGHTH STREET
GAITHERSBURG, MD 20878
TEL: (301) 357-1335
WWW.SERULL.COM

Professional Certification, I hereby certify that
these documents were prepared or supervised and
approved by me or under my direct supervision
and I am a duly Licensed Professional Engineer
under the laws of the State of Maryland, License No. 2442.
Expiration Date: 11-17-2018.

APR 24 2019

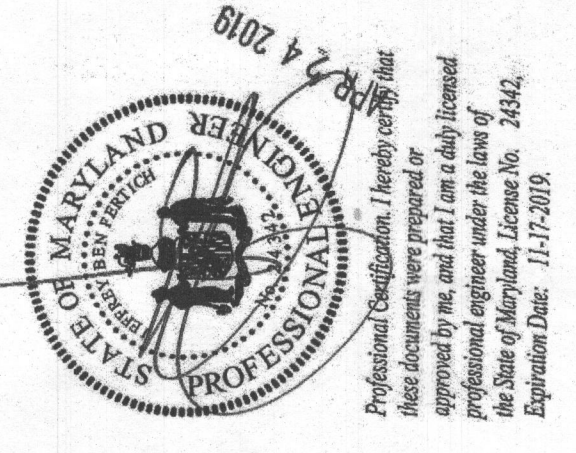


STRUCTURAL ENGINEERING RESOURCES, LLC
 26 NORTH FOURTH STREET
 GETTYSBURG, PA 17325
 (717) 337-1335
 www.SERLLC.us

BOOSALIS RESIDENCE
 12090 HALL SHOP ROAD
 CLARKSVILLE, MARYLAND
 301-401-3399

SECTION
 4/23/2019
A5 of 7

OK RB, Stokola
 B15003264

REVISED INSULATION & FOOTING DEPTH
 4-23-2019

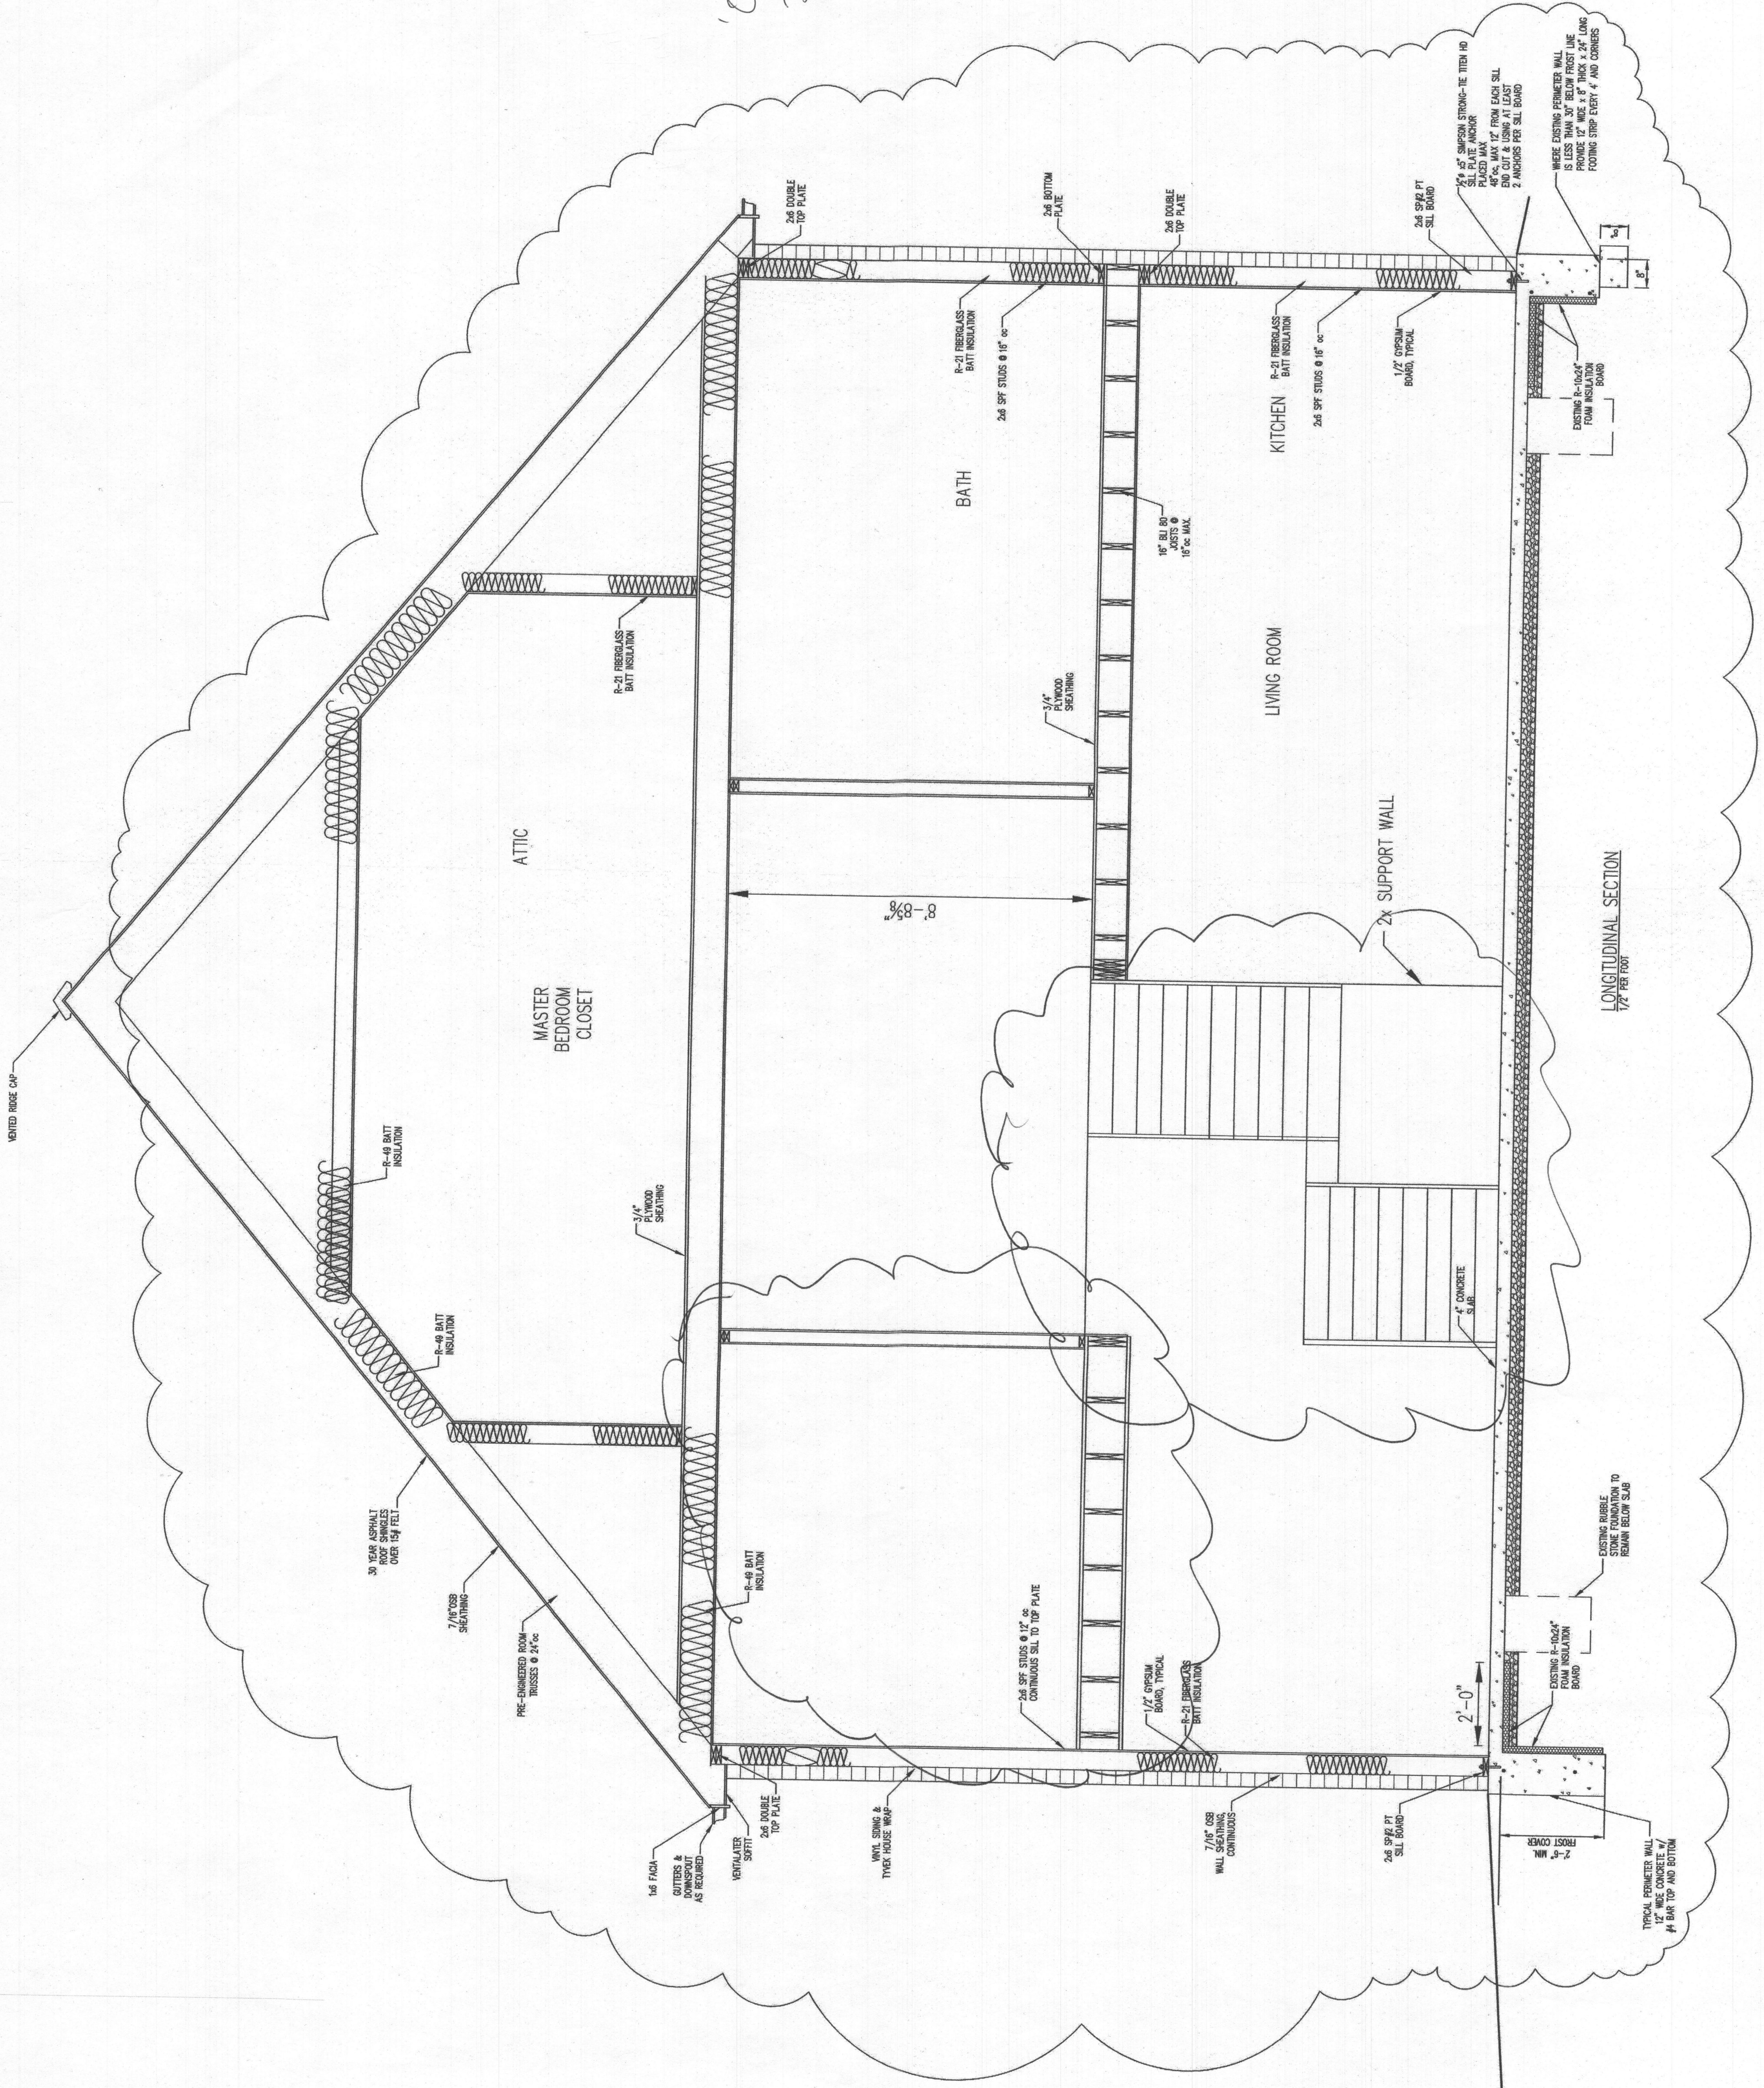

LONGITUDINAL SECTION
 1/2" PER FOOT

