
WATER WELL ABANDONMENT-SEALING REPORT FORM

SUBMIT COPIES OF COMPLETED FORM TO:

- * COUNTY ENVIRONMENTAL AGENCY (contact MDE, WMA if address needed)
- * WELL OWNER
- * MDE, WATER MANAGEMENT ADMINISTRATION, WELL PROGRAM

APPROVED
5/21/2019
Ⓟ

DATE WELL ABANDONED: 4/22/19 (month/day/year)

Hand Dug Ⓟ

* PERMIT NUMBER OF ABANDONED WELL (if any)

* PERMIT NUMBER OF REPLACEMENT WELL:

* PERSON ABANDONING WELL: Jason S. Kuciatkowski WELL DRILLER'S LICENSE NUMBER: 174


CIRCLE: MWD / MSD / MGD

* OWNER'S NAME: Capital Home Group LLC

* WELL LOCATION:

SITE LOCATION MAP

COUNTY: Howard
NEAREST TOWN: Elkridge
TAX MAP 38 BLOCK 0013 PARCEL 0873
SUBDIVISION: Harwood Park
SECTION: _____ LOT: 662 (661)
STREET ADDRESS: 6391 Forest Ave

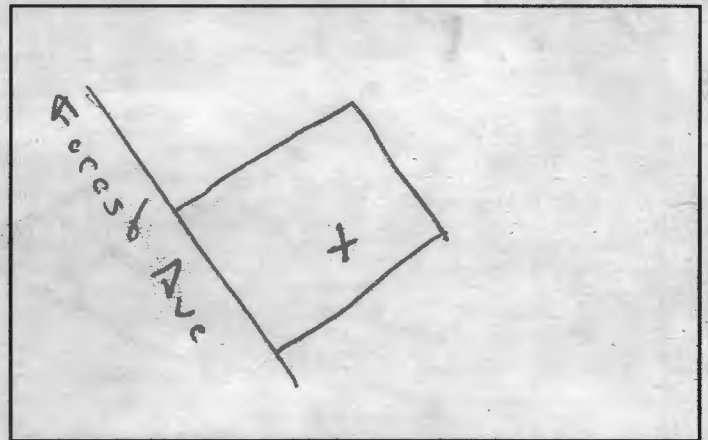

LATITUDE 39.193864
LONGITUDE 76.739006 Ⓟ

* TYPE OF WELL BEING ABANDONED:

- DRILLED
- BORED
- OTHER (specify) _____
- JETTED
- HAND DUG

LOG OF SEALING MATERIAL

* USE CODE:

- DOMESTIC
- IRRIGATION
- TEST/OBSERVATION
- MUNICIPAL/PUBLIC
- INDUSTRIAL
- GEOTHERMAL

MATERIAL	FEET	
	FROM	TO
Concrete	0	3
Well was filled prior by others with sandy clay and stone	3	?

* TYPE OF CASING:

- STEEL
- CONCRETE
- PLASTIC
- OTHER (specify) Stone

SIZE OF CASING: 36 INCHES IN DIAMETER

DEPTH OF WELL: N/A FEET DEEP

WAS ANY CASING REMOVED? YES NO
If yes, length removed, in feet: 3

WAS CASING RIPPED OR PERFORATED? YES NO

VOLUME OF MATERIAL USED

1 yard

SIGNATURE-MASTER WELL DRILLER OR SUPERVISING SANITARIAN LICENSE#

174 MWD MSD / MGS 4/22/19 Ⓟ
CIRCLE ONE DATE

COUNTY

B18003213

Search Result for HOWARD COUNTY

View Map		View GroundRent Redemption			View GroundRent Registration				
Tax Exempt:		Special Tax Recapture:							
Exempt Class:		NONE							
Account Identifier:		District - 01 Account Number - 165720							
Owner Information									
Owner Name:		PROCOPIO FAMILY HOMES INC			Use:		RESIDENTIAL		
Mailing Address:		1046 ANNAPOLIS RD GAMBRILLS MD 21054-			Principal Residence:		NO		
					Deed Reference:		/18404/ 00127		
Location & Structure Information									
Premises Address:		6391 FOREST AVE ELKRIDGE 21075-0000			Legal Description:		LOTS 661-664 12000 S 6391 FOREST AVE HARWOOD PARK		
Map:	Grid:	Parcel:	Sub District:	Subdivision:	Section:	Block:	Lot:	Assessment Year:	Plat No:
0038	0013	0873		0000			661	2018	Plat Ref:
Special Tax Areas:					Town:		NONE		
					Ad Valorem:		104		
					Tax Class:				
Primary Structure Built		Above Grade Living Area		Finished Basement Area		Property Land Area		County Use	
1938		1,304 SF				12,000 SF			
Stories	Basement	Type		Exterior	Full/Half Bath	Garage	Last Major Renovation		
1 1/2	YES	STANDARD UNIT		FRAME	1 full				
Value Information									
		Base Value		Value		Phase-in Assessments			
				As of		As of		As of	
				01/01/2018		07/01/2018		07/01/2019	
Land:		132,000		132,000					
Improvements		77,400		69,900					
Total:		209,400		201,900		201,900		201,900	
Preferential Land:		0						0	
Transfer Information									
Seller: CAPITAL HOME GROUP, LLC				Date: 10/10/2018		Price: \$280,000			
Type: ARMS LENGTH IMPROVED				Deed1: /18404/ 00127		Deed2:			
Seller: FONDELHEIT THERESA LUCY				Date: 09/30/2016		Price: \$200,000			
Type: ARMS LENGTH IMPROVED				Deed1: /17154/ 00280		Deed2:			
Seller: FONDELHEIT THERESA LUCY L/E				Date: 01/12/1983		Price: \$0			
Type: NON-ARMS LENGTH OTHER				Deed1: /01138/ 00094		Deed2:			
Exemption Information									
Partial Exempt Assessments:		Class		07/01/2018		07/01/2019			
County:		000		0.00					
State:		000		0.00					
Municipal:		000		0.00 0.00		0.00 0.00			
Tax Exempt:		Special Tax Recapture:							
Exempt Class:		NONE							
Homestead Application Information									
Homestead Application Status: No Application									
Homeowners' Tax Credit Application Information									

1. This screen allows you to search the Real Property database and display property records.
2. Click **here** for a glossary of terms.
3. Deleted accounts can only be selected by Property Account Identifier.
4. The following pages are for information purpose only. The data is not to be used for legal reports or documents. While we have confidence in the accuracy of these records, the Department makes no warranties, expressed or implied, regarding the information.