

APPLICATION

PERCOLATION TESTING

A 4905
P _____

HOWARD COUNTY HEALTH DEPARTMENT
BUREAU OF ENVIRONMENTAL HEALTH
3525-H ELLICOTT MILLS DRIVE/ELLICOTT CITY, MARYLAND 21043
TELEPHONE: 313-2640

DISTRICT _____
DATE 3/16/93

TO: THE COUNTY HEALTH OFFICER
ELLICOTT CITY, MARYLAND

I HEREBY APPLY FOR THE NECESSARY TEST PRIOR TO APPLICATION FOR PERMIT TO CONSTRUCT (OR RECONSTRUCT) A SEWAGE DISPOSAL SYSTEM.

PROPERTY OWNER CHARLES & CAROL SCHROYER

ADDRESS 1245 MORGAN STATION RD PHONE 301 854 6217

AGENT OR PROSPECTIVE BUYER _____

ADDRESS _____ PHONE _____

PROPERTY LOCATION:

SUBDIVISION N/A LOT NO. 8 & 11

THIS SDA NOT USED ~~NEEDED~~ PART OF NEW LOT 7 ON SIGNED PLAT

ROAD AND DESCRIPTION EAST OF MORGAN STATION RD. SOUTH OF RTE. 70

TAX MAP 8 PARCEL # 313

SIZE OF LOT ± 40,500 TYPE BLDG. Single Family
(SINGLE FAMILY DWELLING OR COMMERCIAL)

THE SYSTEM INSTALLED UNDER THIS APPLICATION IS ACCEPTABLE ONLY UNTIL PUBLIC FACILITIES BECOME AVAILABLE. I FULLY UNDERSTAND THE FEE CONNECTED WITH THE FILING OF THIS PERC TEST APPLICATION IS NON-REFUNDABLE UNDER ANY CIRCUMSTANCES. I ALSO AGREE TO COMPLY WITH ALL M.O.S.H.A. REQUIREMENTS IN TESTING THIS LOT.

[Signature]
(SIGNATURE OF APPLICANT)

APPROVED BY _____ FOR _____ DATE _____

DISAPPROVED BY _____ FOR _____ DATE _____

HOLD PENDING FURTHER TESTS _____

REASONS FOR REJECTION OR HOLDING HOLD FOR PLAT - PERC OK MR 6/3/93

PERCOLATION TEST PLAT/PRELIMINARY PLAT - TITLE OR I.D. # _____ DATE _____

SITE DEVELOPMENT PLAN/FINAL PLAT - TITLE OR I.D. # _____ DATE _____

THIS IS NOT A PERMIT


A49050

COUNTY #

Lot 7

SOIL PROFILE

0' (1)
red org
yel si
cl 1m
10% frags
3 1/2
brn
sa 1m
40-50%
structured
shale
frags
1 1/2

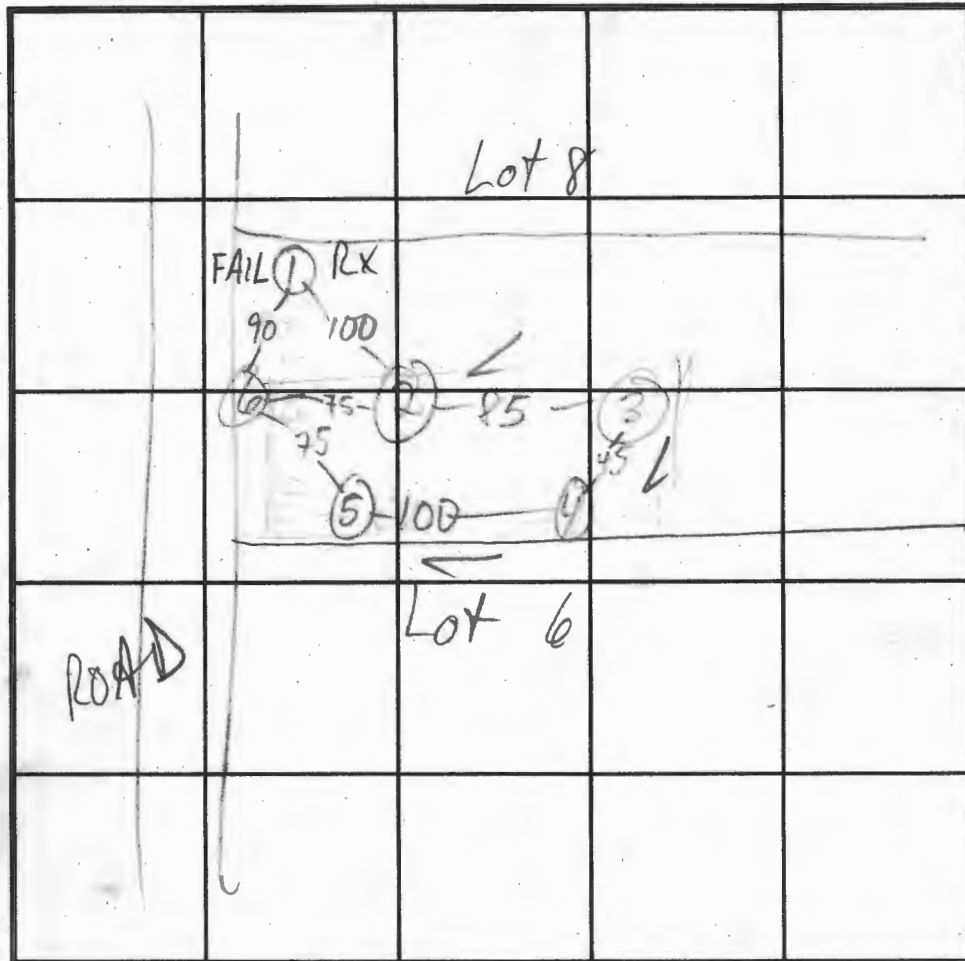

SOIL PROFILE

0'

INDICATE NORTH - NAME ADJOINING ROADWAY AS BASE LINE.

(2) (5) (6)
red org
si cl 1m
10% frags
3 1/2 - 4
brn si
red
sa 1m
35-40%
shale
frags
15% frags
in (5)
13

DATE	TEST NO.	DEPTH	PRE-WET		TEST - 1" DROP		TIME
			START	STOP	START	STOP	
5/4/93	1 S	4 1/2	12:04	12:06	12:06	12:10	4
	1 M	7	12:04	12:05	12:05	12:06	1
	1 M	7	12:06	12:07	12:07	12:08	1
	1 V	1 1/2	12:08	12:09	12:09	12:10	1
			see profile - ROCKY		FAIL		
	2 S	4 1/2"	12:17	12:19	12:19	12:24	5
	2 M	6 1/2	12:17	12:23	12:23	12:35	12
	2 V	13	see profile				
	3 S	4 1/2	12:26	12:33	12:33	12:49	16
	3 M	6 1/2	12:26	12:28	12:28	12:33	5
	3 V	13	see profile				
	4 S	4 1/2	12:38	12:42	12:42	12:47	5
	4 V	13	see profile				
	5 S	4	12:44	12:45	12:45	12:50	5
	5 M	7	12:52	12:54	12:54	12:57	3
	5 V	12 1/2	sim to (2) 15% frags				

REMARKS 6 M 7 1:05 1:10 1:10 1:23 13
 TYPE OF SOIL 6 V 12 sim to (2) 25-35% frags
 TESTED BY M. Rifkin HOLES (1)-(5) PER PLAN ALSO PRESENT Fyock crew
 TRENCH DESIGN DATA: AVERAGE PERCOLATION TIME 8 TRENCH WIDTH 3
 INLET DEPTH 4 1/2 MAXIMUM BOTTOM DEPTH 6 1/2 SQ. FT./BEDROOM 210

(3) (4)
red org
si cl 1m
5% frags
3-4
tan sa
1m
15%
shale
saprolite
frags
13

APPLICATION

PERCOLATION TESTING

A 490
P _____

HOWARD COUNTY HEALTH DEPARTMENT
BUREAU OF ENVIRONMENTAL HEALTH
3525-H ELLICOTT MILLS DRIVE/ELLICOTT CITY, MARYLAND 21043
TELEPHONE: 313-2940

DISTRICT _____
DATE 5/16/93

TO: THE COUNTY HEALTH OFFICER
ELLICOTT CITY, MARYLAND

I HEREBY APPLY FOR THE NECESSARY TEST PRIOR TO APPLICATION FOR PERMIT TO CONSTRUCT (OR RECONSTRUCT) A SEWAGE DISPOSAL SYSTEM.

PROPERTY OWNER CHARLES + CAROL SCHROYER

ADDRESS 1245 MORGAN STATION RD PHONE 301 854 6217

AGENT OR PROSPECTIVE BUYER D/A

ADDRESS _____ PHONE _____

PROPERTY LOCATION:
SUBDIVISION NONE LOT NO. 6 Mon signed plat

ROAD AND DESCRIPTION EAST OF MORGAN STATION RD SOUTH OF RT 76

TAX MAP 8 PARCEL # 313

SIZE OF LOT ± 41,000 TYPE BLDG. SINGLE FRAME
(SINGLE FAMILY DWELLING OR COMMERCIAL)

THE SYSTEM INSTALLED UNDER THIS APPLICATION IS ACCEPTABLE ONLY UNTIL PUBLIC FACILITIES BECOME AVAILABLE. I FULLY UNDERSTAND THE FEE CONNECTED WITH THE FILING OF THIS PERC TEST APPLICATION IS NON-REFUNDABLE UNDER ANY CIRCUMSTANCES. I ALSO AGREE TO COMPLY WITH ALL M.O.S.H.A. REQUIREMENTS IN TESTING THIS LOT
[Signature] (Brender Assoc)
(SIGNATURE OF APPLICANT)

APPROVED BY _____ FOR _____ DATE _____

DISAPPROVED BY _____ FOR _____ DATE _____

HOLD PENDING FURTHER TESTS _____

REASONS FOR REJECTION OR HOLDING HOLD FOR PLAT - PERC OK MR 6/3/93

PERCOLATION TEST PLAT/PRELIMINARY PLAT - TITLE OR I.D. # _____ DATE _____

SITE DEVELOPMENT PLAN/FINAL PLAT - TITLE OR I.D. # _____ DATE _____

THIS IS NOT A PERMIT


A 49049

COUNTY #

Lot 6 SOIL PROFILE

0'
 ①
 brn
 silty
 30-40%
 frags
 4 1/2
 brn
 red
 silty
 90%
 saprolite
 frags
 12 1/2

②③
 brn pink
 silty
 1-4
 brn
 30-35%
 black
 structural
 frags
 w/ saprolite
 12 1/2

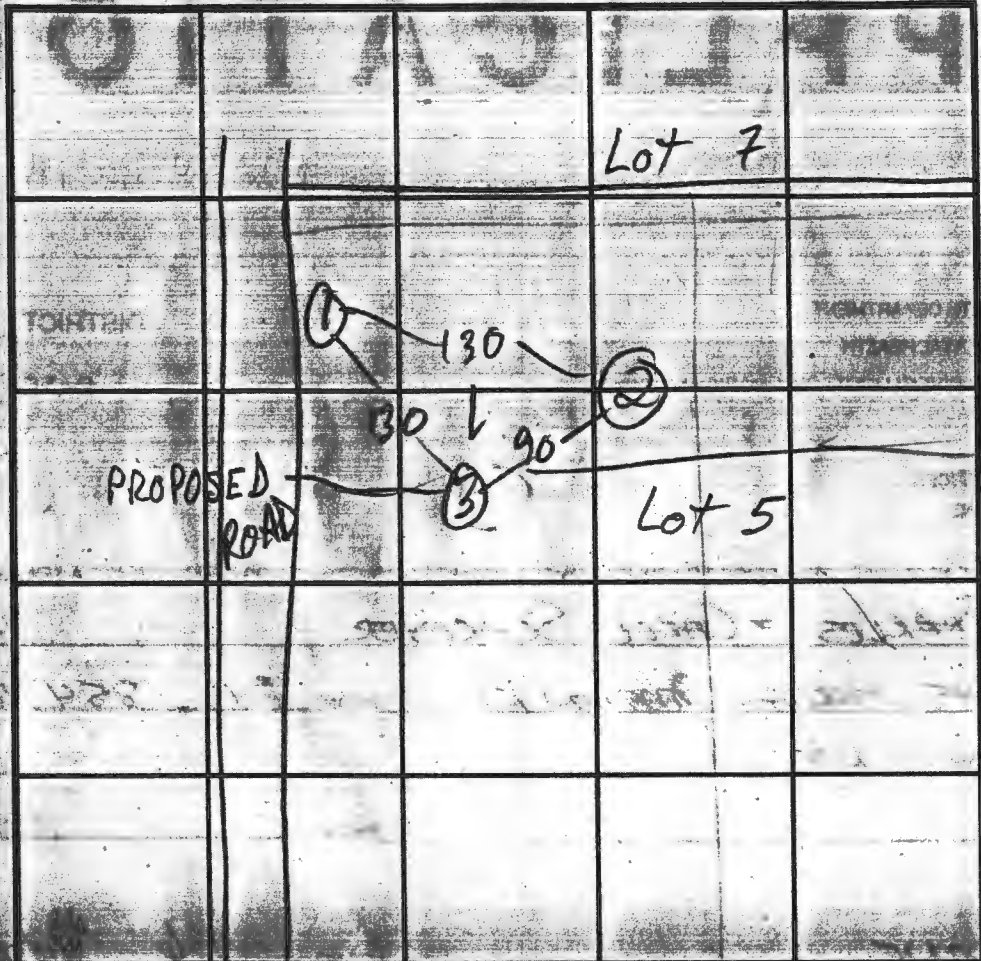

SOIL PROFILE

0'

INDICATE NORTH - NAME ADJOINING ROADWAY AS BASE LINE

DATE	TEST NO.	DEPTH	PRE-WET		TEST - 1" DROP		TIME	
			START	STOP	START	STOP		
5/4/93	1 H	5 1/2 7 1/2	2:14 2:15	2:15 2:17	2:15 2:17	2:19 2:21	4	
	2 V	12 1/2	see profile					
	2 H	5 7 1/2	2:24 2:24	2:27 2:26	2:27 2:26	2:32 2:29	3	
	2 V	12 1/2	see profile					
	3 H	4 1/2 7	2:32 2:33	2:38 2:34	2:38 2:34	2:45 2:38	4	
	3 V	12 1/2	see profile					

REMARKS: ALL HOLES PER PLAN

TYPE OF SOIL _____
 TESTED BY M. Rifkin ALSO PRESENT Fuork crew
 TRENCH DESIGN DATA: AVERAGE PERCOLATION TIME 4 1/2 TRENCH WIDTH 3
 INLET DEPTH 4 MAXIMUM BOTTOM DEPTH 6 SQ. FT./BEDROOM 180

17
1979
copy of Signed
Perc Cert

MORGAN

STATION

ROAD

