

Real Property Data Search (w4)

Search Result for HOWARD COUNTY

View Map		View GroundRent Redemption				View GroundRent Registration			
Tax Exempt:		Special Tax Recapture:							
Exempt Class:		AGRICULTURAL TRANSFER TAX							
Account Identifier:		District - 05 Account Number - 357632							
Owner Information									
Owner Name:		LEWIS FARM LIMITED LIABILITY CO				Use:		AGRICULTURAL	
Mailing Address:		3500 FOLLY QUARTER RD ELLICOTT CITY MD 21042-1406				Principal Residence:		NO	
						Deed Reference:		/03596/ 00108	
Location & Structure Information									
Premises Address:		4500 SHEPPARD LN ELLICOTT CITY 21042-0000				Legal Description:		104.778 ACRES 4500 SHEPPARD LN	
Map:	Grid:	Parcel:	Sub District:	Subdivision:	Section:	Block:	Lot:	Assessment Year:	Plat No:
0028	0006	0006		0000				2017	Plat Ref:
Special Tax Areas:				Town:		NONE			
				Ad Valorem:		100			
				Tax Class:					
Primary Structure Built		Above Grade Living Area		Finished Basement Area		Property Land Area		County Use	
						104.7700 AC			
Stories	Basement	Type	Exterior	Full/Half Bath	Garage	Last Major Renovation			
Value Information									
			Base Value	Value	Phase-in Assessments				
				As of	As of		As of		
				01/01/2017	07/01/2018		07/01/2019		
Land:			39,900	39,900					
Improvements			0	0					
Total:			39,900	39,900	✓	39,900	39,900		
Preferential Land:			39,900		39,900				
Transfer Information									
Seller: BECK WILLIAM K ET AL				Date: 10/13/1995		Price: \$0			
Type: NON-ARMS LENGTH OTHER				Deed1: /03596/ 00108		Deed2:			
Seller:				Date:		Price:			
Type:				Deed1:		Deed2:			
Seller:				Date:		Price:			
Type:				Deed1:		Deed2:			
Exemption Information									
Partial Exempt Assessments:		Class		07/01/2018		07/01/2019			
County:		000		0.00					
State:		000		0.00					
Municipal:		000		0.00 0.00		0.00 0.00			
Tax Exempt:		Special Tax Recapture:							
Exempt Class:		AGRICULTURAL TRANSFER TAX							
Homestead Application Information									
Homestead Application Status: No Application									

PRELIMINARY

APPLICATION

A 25635

5/6/77 9:30 A.M.
1:30 P.M.

SEWAGE DISPOSAL TESTING

STATE OF MARYLAND - DEPARTMENT OF HEALTH AND MENTAL HYGIENE

P _____

HOWARD COUNTY HEALTH DEPARTMENT
ENVIRONMENTAL HEALTH SERVICES
P O. BOX 476, ELLICOTT CITY, MARYLAND 21043
TELEPHONE: 465-5000, EXT. 356

DISTRICT 5th

DATE 4/14/77

TO: THE COUNTY HEALTH OFFICER
ELLICOTT CITY, MARYLAND

I, HEREBY, APPLY FOR THE NECESSARY TEST IN ORDER TO CONSTRUCT (OR RECONSTRUCT) A SEWAGE DISPOSAL SYSTEM.

Contract Purchaser

PROPERTY OWNER Dr. & Mrs. Fred Lewis

John F. Patrick

ADDRESS 10001 Clarksville Pike, Columbia, Md. 21044 PHONE 11922 Green St. Fulton, Md. 20759

PROPERTY LOCATION:

SUBDIVISION _____ LOT NO. Parcel A

ROAD AND DESCRIPTION Sheppards Lane

This property is not to be subdivided.

SIZE OF LOT 17.630 acres m/1 TYPE BLDG. _____ NUMBER OF BEDROOMS _____

IF NOT SINGLE RESIDENCE DESCRIBE _____

THE SYSTEM INSTALLED UNDER THIS APPLICATION IS ACCEPTABLE ONLY UNTIL PUBLIC FACILITIES BECOME AVAILABLE.

SIGNATURE OF APPLICANT /s/ Mary A. Lewis


APPROVED BY _____ FOR _____ DATE _____

REJECTED BY R. Mansfield FOR Any (KIND OF SYSTEM) DATE 6 May 77 (KIND OF SYSTEM)

HOLD PENDING FURTHER TESTS _____ DATE _____

REASONS FOR REJECTION OR HOLDING _____

THIS IS NOT A PERMIT

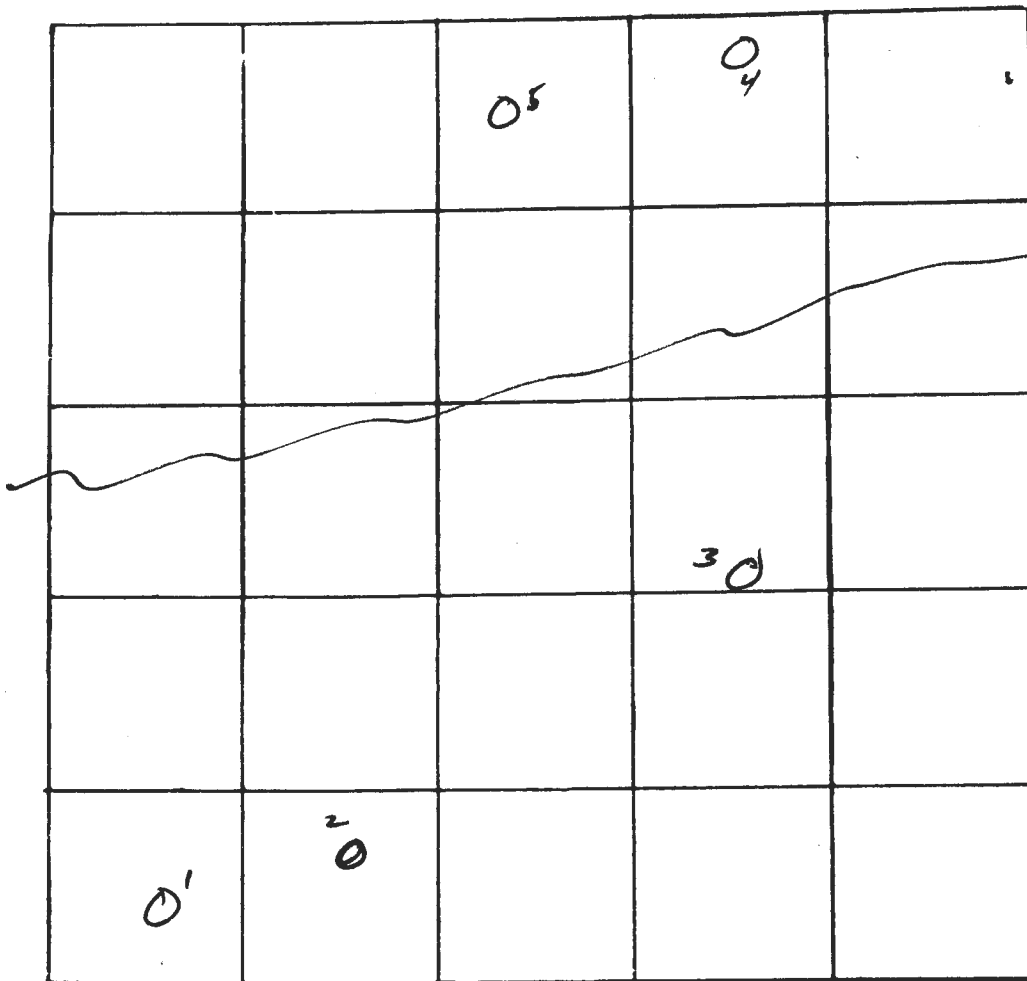

INDICATE NORTH. - NAME ADJOINING ROADWAY AS BASE LINE

← Sheppard Ln → N

DATE	TEST NO.	DEPTH	PRE-WET		TEST - 1" DROP		TIME
			START	STOP	START	STOP	
6/29/77	1	12	clay	no pore			
	2	6	clay	no pore			
	2A	12	vis	clay (clays)			
	3	12	clay	no pore			
	4	6'	11 ⁰⁵	11 ¹³	11 ¹³	11 ²⁵	12
	4A	11'	water	@ 11'			
	5	11'	water	@ 11'			

REMARKS

clay mixed with some occasional loam

TYPE OF SOIL

TESTED BY

M

ALSO PRESENT:

Fyock

S 56°23'45"E

First Line
First Parcel
MWB 212/340-7

5032.56'

26049.17'

Corner Men
60238'

RESIDUE: 70.516 Ac.±

LANE

Initial Pipe
R/W Agreement
Transcontinental Gas Pipeline Corp
MWB 215/44

975.85'

N 06°01'50"W
2450.23'

Iron Pipe

14" Line
W.H.H. 464, 767

401.45'

Iron Pipe

S 42°42'16"E
390'

PARCEL 'B'
17.630 Ac.±

N 35°00'20"W
S 35°00'20"E

PARCEL 'A'
17.630 AC.±

1012.93'

Stone
64.00'

Iron Pipe

N 42°42'16"W 1103.97'

13" Line - W.H.H. 464/767

S 24.3'
Iron Pipe 2531.04'

1941.12'
1941.12'

Iron Pipe

Iron Pipe

Iron Pipe

465.7'
Iron Pipe

SHEPPARDS

Iron Pipe

540.07'

540.07'

Iron Pipe

576.74'

Iron Pipe

576.74'

540°22'50"W 410.01'

R.R. Spike
Point of Beginning - Parcel 'B'

10" Line
11" Line
W.H.H. 464/767

540°39'41"W 393.74'

R.R. Spike
Point of Beginning - Parcel 'A'

12" Line - W.H.H. 464/767

540°00'18"W 429.17'

PROPERTY OF
FRED T. LEWIS AND

5th ELECTION DISTRICT
JUNE 1, 1972

HOWARD

PRELIMINARY

APPLICATION

A 25646

P _____

SEWAGE DISPOSAL TESTING

STATE OF MARYLAND - DEPARTMENT OF HEALTH AND MENTAL HYGIENE

HOWARD COUNTY HEALTH DEPARTMENT
ENVIRONMENTAL HEALTH SERVICES

P. O. BOX 476, ELLICOTT CITY, MARYLAND 21043
TELEPHONE: 465-5000, EXT. 356

DISTRICT 5th

DATE 4/18/77

TO: THE COUNTY HEALTH OFFICER
ELLICOTT CITY, MARYLAND

I, HEREBY, APPLY FOR THE NECESSARY TEST IN ORDER TO CONSTRUCT (OR RECONSTRUCT) A SEWAGE DISPOSAL SYSTEM.

PROPERTY OWNER Dr. & Mrs. Fred Lewis

ADDRESS 10001 Clarksville Pike, Columbia, Md. 21044 PHONE _____

PROPERTY LOCATION:

SUBDIVISION _____ LOT NO. Parcel A

ROAD AND DESCRIPTION Sheppards Lane

SIZE OF LOT 17.630 acres m/1 TYPE BLDG. 3 or 4 bedrooms
NUMBER OF BEDROOMS

IF NOT SINGLE RESIDENCE DESCRIBE _____

THE SYSTEM INSTALLED UNDER THIS APPLICATION IS ACCEPTABLE ONLY UNTIL PUBLIC FACILITIES BECOME AVAILABLE.

SIGNATURE OF APPLICANT /s/ William S. Hanna

APPROVED BY _____ FOR _____ DATE _____
(KIND OF SYSTEM)

REJECTED BY _____ FOR _____ DATE _____
(KIND OF SYSTEM)

HOLD PENDING FURTHER TESTS _____ DATE _____

REASONS FOR REJECTION OR HOLDING _____

THIS IS NOT A PERMIT

INDICATE NORTH. - NAME ADJOINING ROADWAY AS BASE LINE

DATE	TEST NO.	DEPTH	PRE-WET		TEST - 1" DROP		TIME
			START	STOP	START	STOP	

REMARKS _____

TYPE OF SOIL _____

TESTED BY _____ ALSO PRESENT: _____

PRELIMINARY

APPLICATION

A 25647

P _____

SEWAGE DISPOSAL TESTING

STATE OF MARYLAND - DEPARTMENT OF HEALTH AND MENTAL HYGIENE

HOWARD COUNTY HEALTH DEPARTMENT
ENVIRONMENTAL HEALTH SERVICES
P. O. BOX 476, ELLICOTT CITY, MARYLAND 21043
TELEPHONE: 465-5000, EXT. 356

DISTRICT 5th

DATE 4/18/77

TO: THE COUNTY HEALTH OFFICER
ELLICOTT CITY, MARYLAND

I, HEREBY, APPLY FOR THE NECESSARY TEST IN ORDER TO CONSTRUCT (OR RECONSTRUCT) A SEWAGE DISPOSAL SYSTEM.

PROPERTY OWNER Dr. & Mrs. Fred Lewis

ADDRESS 10001 Clarksville Pike, Columbia, Md. 21044 PHONE _____

PROPERTY LOCATION:

SUBDIVISION _____ LOT NO. Parcel A

ROAD AND DESCRIPTION Sheppards Lane

SIZE OF LOT 17.630 acres m/l TYPE BLDG. 3 or 4 bedrooms
NUMBER OF BEDROOMS

IF NOT SINGLE RESIDENCE DESCRIBE _____

THE SYSTEM INSTALLED UNDER THIS APPLICATION IS ACCEPTABLE ONLY UNTIL PUBLIC FACILITIES BECOME AVAILABLE.

SIGNATURE OF APPLICANT /s/ William S. Hanna

APPROVED BY _____ FOR _____ DATE _____
(KIND OF SYSTEM)

REJECTED BY _____ FOR _____ DATE _____
(KIND OF SYSTEM)

HOLD PENDING FURTHER TESTS _____ DATE _____

REASONS FOR REJECTION OR HOLDING _____

THIS IS NOT A PERMIT

INDICATE NORTH. - NAME ADJOINING ROADWAY AS BASE LINE

DATE	TEST NO.	DEPTH	PRE-WET		TEST - 1" DROP		TIME
			START	STOP	START	STOP	

REMARKS _____

TYPE OF SOIL _____

TESTED BY _____ ALSO PRESENT: _____

PRELIMINARY

APPLICATION

A 25648

P _____

SEWAGE DISPOSAL TESTING

STATE OF MARYLAND - DEPARTMENT OF HEALTH AND MENTAL HYGIENE

HOWARD COUNTY HEALTH DEPARTMENT
ENVIRONMENTAL HEALTH SERVICES
P. O. BOX 476, ELLICOTT CITY, MARYLAND 21043
TELEPHONE: 465-5000, EXT. 356

DISTRICT 5th

DATE 4/18/77

TO: THE COUNTY HEALTH OFFICER
ELLICOTT CITY, MARYLAND

I, HEREBY, APPLY FOR THE NECESSARY TEST IN ORDER TO CONSTRUCT (OR RECONSTRUCT) A SEWAGE DISPOSAL SYSTEM.

PROPERTY OWNER Dr. & Mrs. Fred Lewis

ADDRESS 10001 Clarksville Pike, Columbia, Md. 21044 PHONE _____

PROPERTY LOCATION:

SUBDIVISION _____ LOT NO. Parcel A

ROAD AND DESCRIPTION Sheppards Lane

SIZE OF LOT 17.630 acres m/l TYPE BLDG. 3 or 4 bedrooms
NUMBER OF BEDROOMS

IF NOT SINGLE RESIDENCE DESCRIBE _____

THE SYSTEM INSTALLED UNDER THIS APPLICATION IS ACCEPTABLE ONLY UNTIL PUBLIC FACILITIES BECOME AVAILABLE.

SIGNATURE OF APPLICANT /s/ William S. Hanna

APPROVED BY _____ FOR _____ DATE _____
(KIND OF SYSTEM)

REJECTED BY _____ FOR _____ DATE _____
(KIND OF SYSTEM)

HOLD PENDING FURTHER TESTS _____ DATE _____

REASONS FOR REJECTION OR HOLDING _____

THIS IS NOT A PERMIT