

Name: Ben True
Street Address: 3920 London Bridge Rd
City, State, Zip: Sukeyville, MD 21784
Date: 12/11/18

Amendment, Permit # B18003015

Approved
Gw
12/11/18

Ms. Debbie Whalen
Division of Plan Review
Department of Inspections, Licenses and Permits
Howard County Government
3430 Court House Dr
Ellicott City, MD 21043

RECEIVED

DEC 06 2018

LICENSES & PERMITS
DIVISION

Dear Ms. Whalen:

I am requesting to amend Permit # B18003015 at
Remove existing masonry side porch 3'6" x 4'6" to
replace with 3'6" x 4'6" wooden deck with
tree & vinyl railing.
requested by inspector so he can
inspect footers.

Enclosed:

1 Fee: 25⁰⁰
3 Plot Plans
 Sets of Construction Drawings
 Other: _____

If there is anything we can do to assist you, please let me know.

Sincerely,
CC: PtZ
Heath

* For pick up *

Name: Ben True
Title: Agent for AIC
Phone: 443-298-0988
Email: BenTrue213@gmail.com

018904

DUPLICATE

Name: Ben True
Street Address: 3920 Lendon Bridge Rd
City, State, Zip: Silverville, MO 21784
Date: 12/10/18

Amendment, Permit # B18003015

Ms. Debbie Whalen
Division of Plan Review
Department of Inspections, Licenses and Permits
Howard County Government
3430 Court House Dr
Ellicott City, MD 21043

RECEIVED

DEC 06 2018

LICENSES & PERMITS
DIVISION

Dear Ms. Whalen:

I am requesting to amend Permit # B18003015 at
Remove existing masonry side porch 3'6" x 4'6" to
replace with 3'6" x 4'6" wooden deck with
tree & vinyl railing.
requested by inspector so he can
inspect footers.

Enclosed:

- Fee: 25⁰⁰
- Plot Plans
- Sets of Construction Drawings
- Other: _____

12/10/18

If there is anything we can do to assist you, please let me know.

Sincerely,

CC: ~~ATZ~~
Health

DUPLICATE

*FORWARDED TO
HEALTH ON 12/7/18

* For pick up *

Name: Ben True
Title: Agent for AIC
Phone: 443-298-0988
Email: BenTrue213@gmail.com

K# 018904


DUPLICATE

REVISED

Date: 8/10/18

Comments: B 8003015
Remove Existing Masonry Porch
+ replace w/ 3'6" x 4'-0"
Wood deck

SITE PLAN
SCALE 1" = 200'

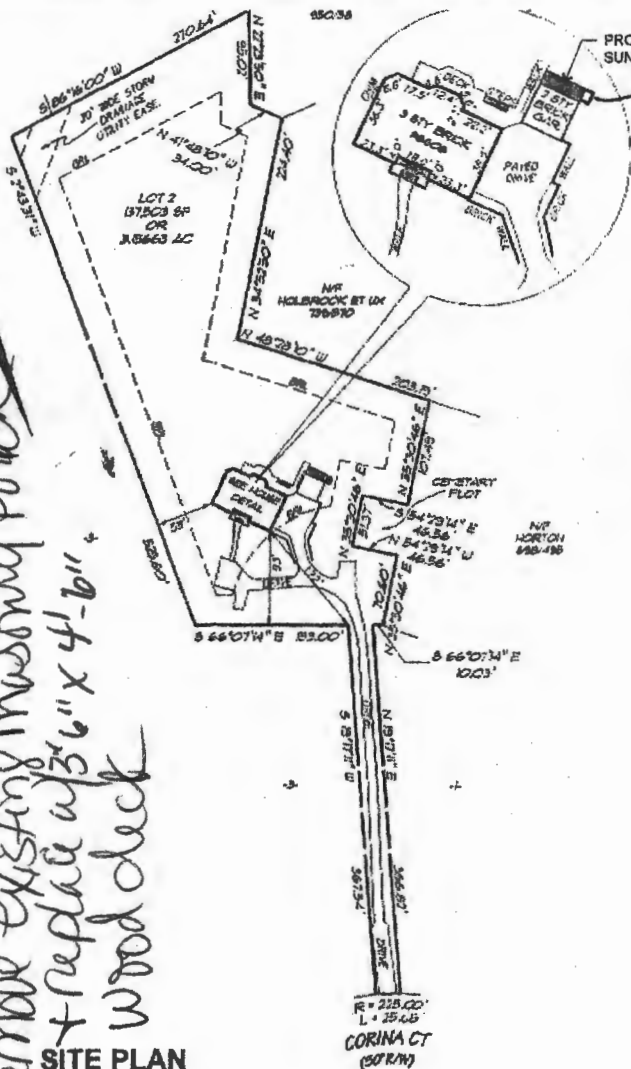

PROPOSED SUNROOM ADDITION
WAYNE JACKSON RESIDENCE
6606 CORINA COURT, COLUMBIA, MARYLAND 21044



EXISTING



PROPOSED

GENERAL PROJECT SCOPE

CONSTRUCT A NEW 21' X 14' SUNROOM ON A CURRENT OPEN FLAT DECK AND OVER AN EXISTING 2-STORY DETACHED GARAGE.

LIST OF DRAWINGS

- CVR COVER SHEET W/ SITE PLAN
- A-1 EXISTING FLOOR PLAN
- A-2 NEW WORK FLOOR PLAN
- A-3 EXTERIOR ELEVATIONS
- A-4 CROSS SECTION 1
- A-5 CROSS SECTION 2 AND DETAILS
- A-6 SECTIONS AND DETAILS

BUILDING CODES

INT'L. RESIDENTIAL CODE - 2015 EDITION
INT'L. ENERGY CONSERVATION CODE, 2015 EDITION
INT'L. MECHANICAL CODE, 2015 EDITION
THE LIFE SAFETY CODE, 2015 EDITION (NFPA 101)
LOCAL AMENDMENTS TO INT'L. CODES
2014 NATIONAL ELECTRICAL CODE (NFPA 70)
WITH LOCAL AMANDMENTS

PROJECT DIRECTORY

CLIENT / HOMEOWNER:

WAYNE AND CINDY JACKSON
8806 CORINA COURT
COLUMBIA, MD 21044
PHONE: 410.707.4920

ARCHITECT:

LEHMAN ASSOCIATES, P.C.
JOHN I. LEHMAN, AIA
6688 HINK HOLLOW ROAD
HIGHLAND, MD 20777
PHONE: 301-554-1100
EMAIL: JLEHMAN@LAPC.US

GENERAL CONTRACTOR:

ALC CONTRACTORS, LLC
ANDREW LOHMEYER, OWNER
MANCHESTER, MARYLAND
MHIC #45659
OFFICE: 410-356-7300
CELL: 443-324-7038
EMAIL: INFO@ALCHOMEBUILDERS.COM

ISSUED FOR BID, PERMIT & CONSTRUCTION
DATE: AUGUST 6, 2018



LEHMAN ASSOCIATES, PC
ARCHITECTS

PROPOSED SUNROOM ADDITION TO THE RESIDENCE OF

WAYNE AND CINDY JACKSON

6606 CORINA COURT, COLUMBIA, MD 21044

PROJ NO: 1518-417

DATE 08.06.18

BID & PERMIT

CVR