


College Avenue

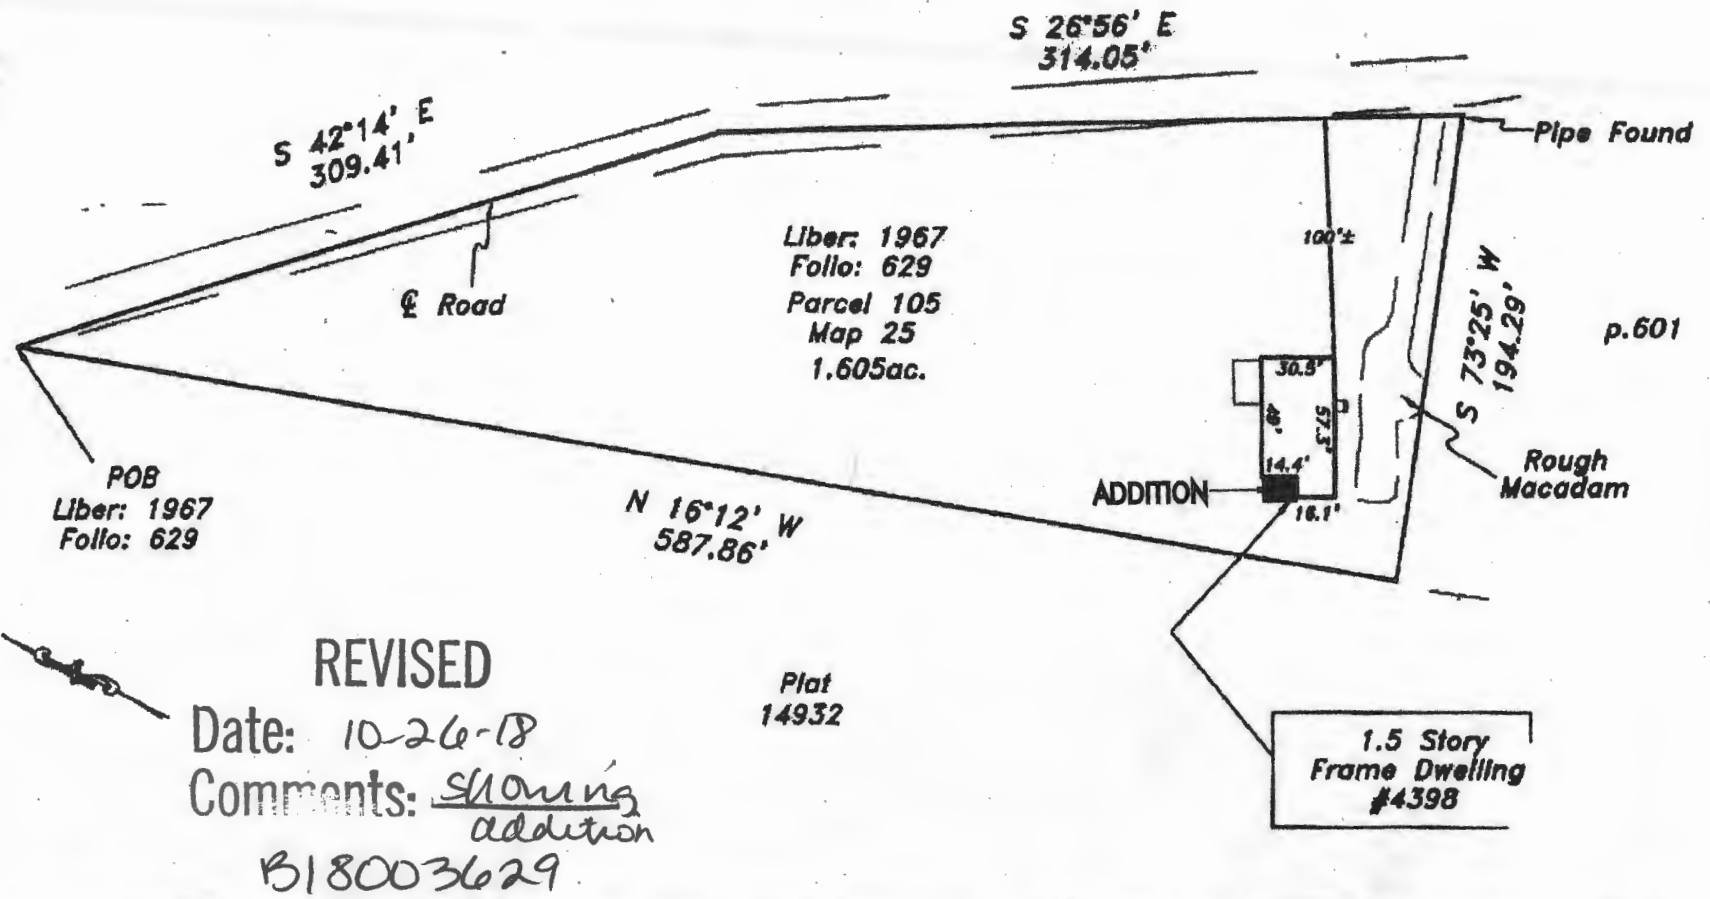

POB
Liber: 1967
Follo: 629

Liber: 1967
Follo: 629
Parcel 105
Map 25
1.605ac.

REVISED

Date: 10-26-18
Comments: Showing addition
B18003629

Plat
14932

1.5 Story
Frame Dwelling
#4398

The purpose of this drawing is to locate, describe, and represent the positions of buildings and substantial improvements affecting the property shown hereon, being known as:
4398 College Avenue
as described in a deed
recorded among the land records of Howard County, Maryland in
Liber 1967 Follo 629



James Carl Hudgins
Property Line Surveyor #96
Expiration Date: 3/11/18

LOCATION DRAWING
4398 College Avenue
2nd ELECTION DISTRICT
HOWARD COUNTY, MARYLAND

PREPARED FOR:

SAGE TITLE GROUP
THE WISE CHOICE

This is page one of a two page document. The advice found on the affixed page is an integral part of this drawing, and is not valid without all pages.

NTT Associates, Inc.
16205 Old Frederick Rd.
Mt. Airy, Maryland 21771
Phone: (410) 442-2031
Fax: (410) 442-1315
www.nttsurveyors.com

Scale:	1" = 80'
Date:	10-26-16
Field By:	DR
Drawn By:	DR
File No.:	187539ELCS
Page No.:	1 of 2