

APPLICATION

A 17930

2/23/73
9:30 A.M.

SEWAGE DISPOSAL TESTING

P _____

STATE OF MARYLAND - DEPARTMENT OF HEALTH AND MENTAL HYGIENE

HOWARD COUNTY HEALTH DEPARTMENT
ENVIRONMENTAL HEALTH SERVICES

DISTRICT 3rd

P. O. BOX 476, ELLICOTT CITY, MARYLAND 21043
TELEPHONE: 465-5000, EXT. 356

DATE 6 Feb. 1973

TO: THE COUNTY HEALTH OFFICER
ELLICOTT CITY, MARYLAND

I, HEREBY, APPLY, FOR THE NECESSARY TEST IN ORDER TO CONSTRUCT (OR RECONSTRUCT) A SEWAGE DISPOSAL SYSTEM.

PROPERTY OWNER Donald R. Jacobs

ADDRESS 10625 GRAELOCH RD. LAUREL, Md. 20810 PHONE 498-1523

PROPERTY LOCATION:

SUBDIVISION _____ LOT NO. _____

ROAD AND DESCRIPTION Southeast Side of Forsythe Road 1 1/2 miles
South of Sykesville - George R. Garratt, Jr. property

SIZE OF LOT 5 ACRE PARCEL TYPE BLDG. 4 Bedrooms
NUMBER OF BEDROOMS

IF NOT SINGLE RESIDENCE DESCRIBE _____

THE SYSTEM INSTALLED UNDER THIS APPLICATION IS ACCEPTABLE ONLY UNTIL PUBLIC FACILITIES BECOME AVAILABLE.

SIGNATURE OF APPLICANT Donald R. Jacobs


APPROVED BY _____ FOR _____ DATE _____
(KIND OF SYSTEM)

REJECTED BY _____ FOR _____ DATE _____
(KIND OF SYSTEM)

HOLD PENDING FURTHER TESTS Robert V. Tone DATE 2/23/73

REASONS FOR REJECTION OR HOLDING _____

THIS IS NOT A PERMIT

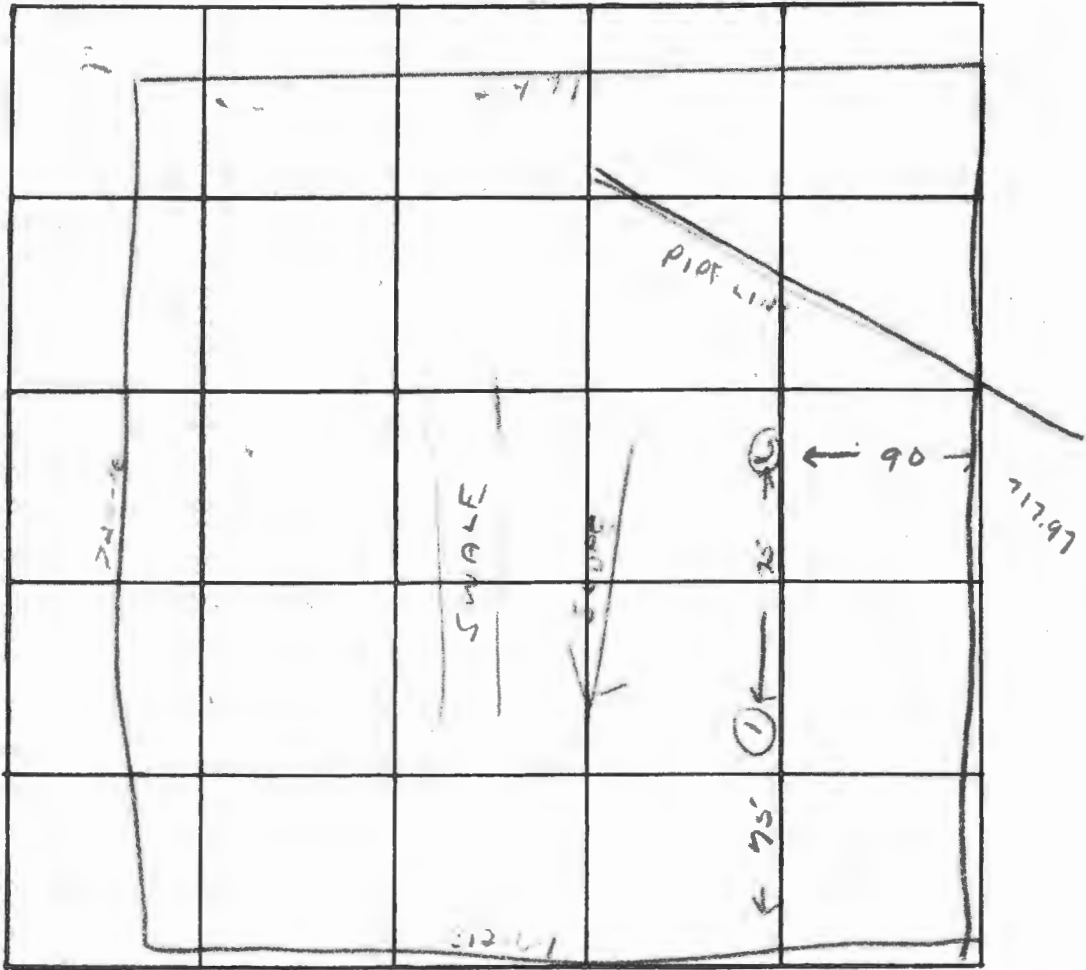

INDICATE NORTH. - NAME ADJOINING ROADWAY AS BASE LINE.

FORSYTHE RD

DATE	TEST NO.	DEPTH	PRE-WET		TEST - 1" DROP		TIME
			START	STOP	START	STOP	
2/3/73	1	8 ft	Wet	-			
	2	8 ft	Wet	-			
	3	9 ft	Water and clay				

REMARKS _____

TYPE OF SOIL _____

TESTED BY R. Tume ALSO PRESENT: _____

Signed & ready, plot must be submitted.

APPLICATION

Fill out in triplicate,
Make \$15.00 check payable
Howard County Health Dept. - Sanitation

A 17930

SEWAGE DISPOSAL TESTING

P _____

STATE OF MARYLAND - DEPARTMENT OF HEALTH AND MENTAL HYGIENE

HOWARD COUNTY HEALTH DEPARTMENT
ENVIRONMENTAL HEALTH SERVICES
P. O. BOX 476, ELLICOTT CITY, MARYLAND 21043
TELEPHONE: 463-5000, EXT. 356

DISTRICT 3rd
DATE 6 Feb. 1973

TO: THE COUNTY HEALTH OFFICER
ELLICOTT CITY, MARYLAND

I, HEREBY, APPLY FOR THE NECESSARY TEST IN ORDER TO CONSTRUCT (OR RECONSTRUCT) A SEWAGE DISPOSAL SYSTEM.

✓ PROPERTY OWNER Donald R. Jacobs

✓ ADDRESS 10625 GRAELOCH RD, LAUREL, MD. ²⁰⁸¹⁰ ✓ PHONE 498-1523

PROPERTY LOCATION:

SUBDIVISION _____ LOT NO. _____

✓ ROAD AND DESCRIPTION South EAST side of Forsythe ROAD 1 1/2 miles
South of Sykesville - George R. Garratt, Jr. property

✓ SIZE OF LOT 5 ACRE PARCEL TYPE BLDG. 4 Bedrooms
NUMBER OF BEDROOMS

IF NOT SINGLE RESIDENCE DESCRIBE _____

THE SYSTEM INSTALLED UNDER THIS APPLICATION IS ACCEPTABLE ONLY UNTIL PUBLIC FACILITIES BECOME AVAILABLE.

✓ SIGNATURE OF APPLICANT Donald R. Jacobs


APPROVED BY _____ FOR _____ DATE _____
(KIND OF SYSTEM)

REJECTED BY _____ FOR _____ DATE _____
(KIND OF SYSTEM)

HOLD PENDING FURTHER TESTS Robert V. Toman DATE 2/23/73

REASONS FOR REJECTION OR HOLDING _____

THIS IS NOT A PERMIT

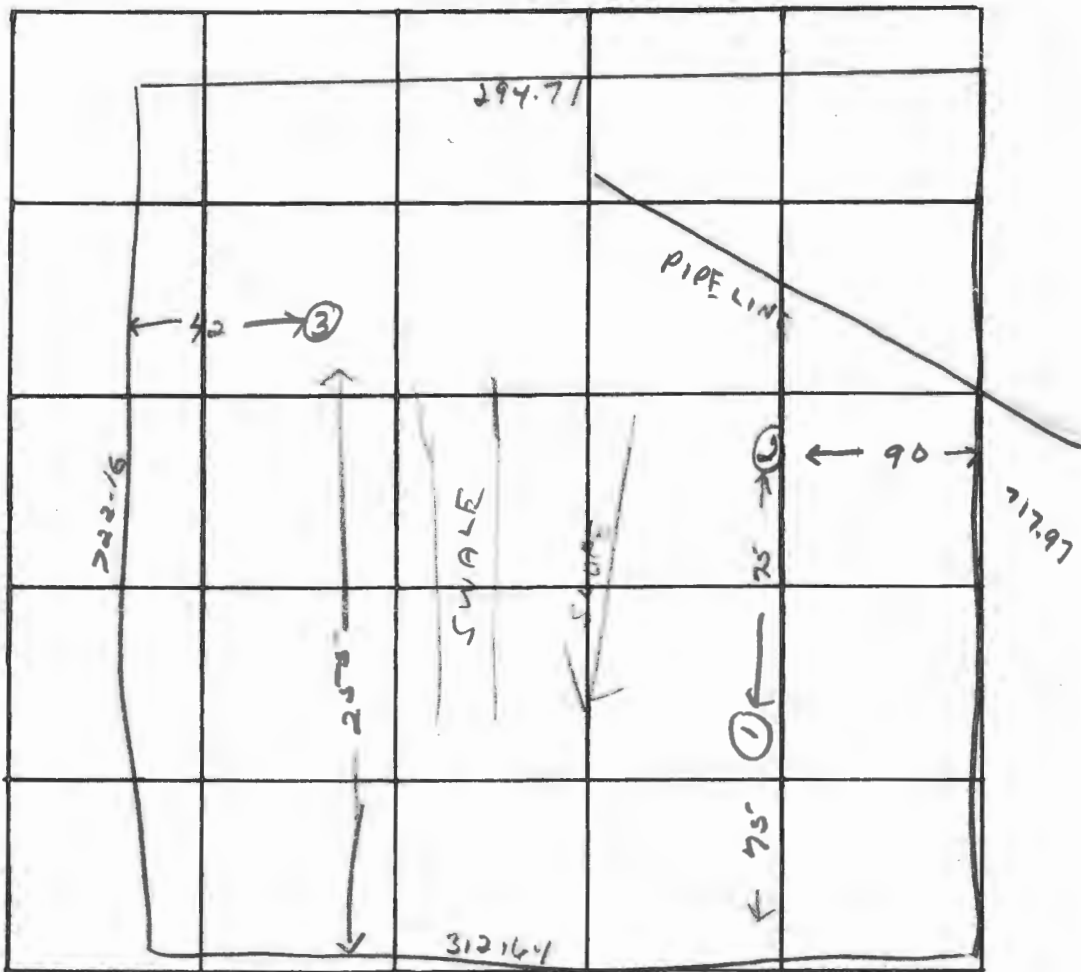

INDICATE NORTH. - NAME ADJOINING ROADWAY AS BASE LINE.


FORSYTHE Rd.

DATE	TEST NO.	DEPTH	PRE-WET		TEST - 1" DROP		TIME
			START	STOP	START	STOP	
2/23/73	1	8 ft.	Water	-			
	2	8 ft.	Water	-			
	3	9 ft.	Water	+ clay			

REMARKS _____

TYPE OF SOIL _____

TESTED BY R. Tove ALSO PRESENT _____

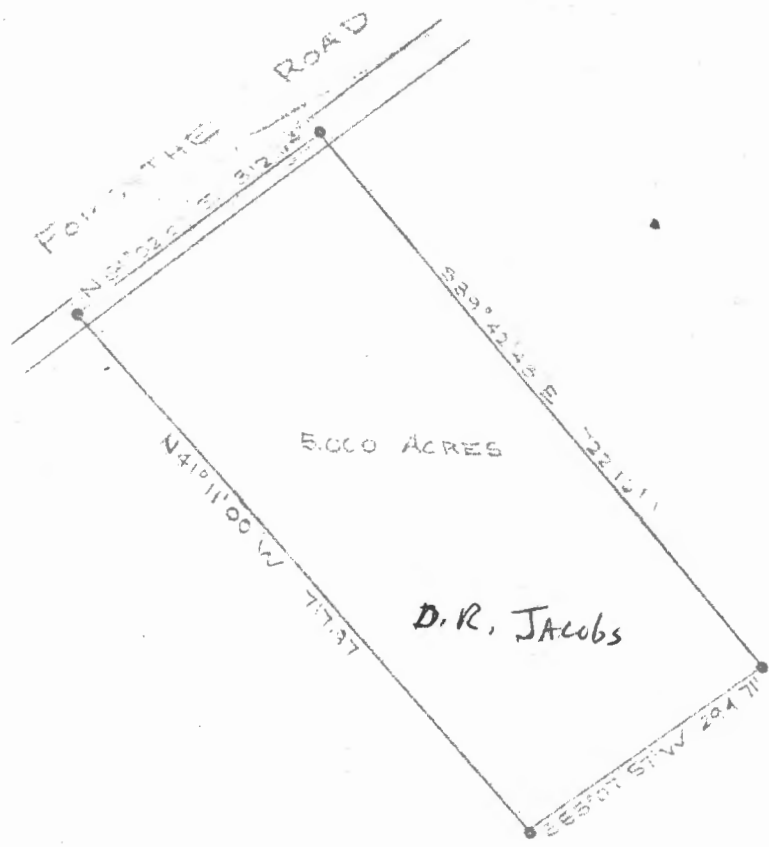

PLAT OF SURVEY
FOR

~~THIRD~~ MRS GEORGE P GARRATT, JR.
FOURTH ELECTION DISTRICT OF HOWARD COUNTY
SYKESVILLE, MARYLAND

SCALE: 1 IN = 200 FT

JULY 28 1972

Claude M. Skinner Jr.

Claude M Skinner Jr
Reg. Professional Engineer &
Land Surveyor No. 22267



1. This screen allows you to search the Real Property database and display property records.
2. Click [here](#) for a glossary of terms.
3. Deleted accounts can only be selected by Property Account Identifier.
4. The following pages are for information purpose only. The data is not to be used for legal reports or documents. While we have confidence in the accuracy of these records, the Department makes no warranties, expressed or implied, regarding the information.