

Real Property Data Search ( w4)

Search Result for HOWARD COUNTY

View Map		View GroundRent Redemption			View GroundRent Registration				
<b>Tax Exempt:</b>		<b>Special Tax Recapture:</b>							
<b>Exempt Class:</b>		NONE							
<b>Account Identifier:</b>		District - 05 Account Number - 349702							
Owner Information									
<b>Owner Name:</b>		TERRY ROBERT E TERRY FRANCES N T/E			<b>Use:</b>		RESIDENTIAL		
<b>Mailing Address:</b>		10837 BRAEBURN ROAD COLUMBIA MD 21044			<b>Principal Residence:</b>		YES		
					<b>Deed Reference:</b>		/03421/ 00177		
Location & Structure Information									
<b>Premises Address:</b>		10837 BRAEBURN RD COLUMBIA 21044-0000			<b>Legal Description:</b>		LOT 6 1.55 A 10837 BRAEBURN RD BRAEBURN SEC 1		
<b>Map:</b>	<b>Grid:</b>	<b>Parcel:</b>	<b>Sub District:</b>	<b>Subdivision:</b>	<b>Section:</b>	<b>Block:</b>	<b>Lot:</b>	<b>Assessment Year:</b>	<b>Plat No:</b>
0035	0017	0228		0000			6	2017	Plat Ref:
<b>Special Tax Areas:</b>					<b>Town:</b>		NONE		
					<b>Ad Valorem:</b>		101		
					<b>Tax Class:</b>				
<b>Primary Structure Built</b>		<b>Above Grade Living Area</b>		<b>Finished Basement Area</b>		<b>Property Land Area</b>		<b>County Use</b>	
1975		2,120 SF				1.5500 AC			
<b>Stories</b>	<b>Basement</b>	<b>Type</b>	<b>Exterior</b>	<b>Full/Half Bath</b>	<b>Garage</b>	<b>Last Major Renovation</b>			
2	YES	STANDARD UNIT	FRAME	2 full/ 1 half	1 Attached				
Value Information									
		<b>Base Value</b>		<b>Value</b>		<b>Phase-in Assessments</b>			
				As of		As of		As of	
				01/01/2017		07/01/2018		07/01/2019	
<b>Land:</b>		268,000		268,000					
<b>Improvements</b>		127,400		166,100					
<b>Total:</b>		395,400		434,100		421,200		434,100	
<b>Preferential Land:</b>		0						0	
Transfer Information									
<b>Seller:</b> ANDREW KENNETH E		<b>Date:</b> 01/17/1995			<b>Price:</b> \$237,000				
<b>Type:</b> ARMS LENGTH IMPROVED		<b>Deed1:</b> /03421/ 00177			<b>Deed2:</b>				
<b>Seller:</b> FIELDS WILLIAM KENNETH & WF		<b>Date:</b> 07/09/1992			<b>Price:</b> \$217,000				
<b>Type:</b> ARMS LENGTH IMPROVED		<b>Deed1:</b> /02596/ 00284			<b>Deed2:</b>				
<b>Seller:</b>		<b>Date:</b>			<b>Price:</b>				
<b>Type:</b>		<b>Deed1:</b>			<b>Deed2:</b>				
Exemption Information									
<b>Partial Exempt Assessments:</b>		<b>Class</b>		07/01/2018		07/01/2019			
<b>County:</b>		000		0.00					
<b>State:</b>		000		0.00					
<b>Municipal:</b>		000		0.00 0.00		0.00 0.00			
<b>Tax Exempt:</b>		<b>Special Tax Recapture:</b>							
<b>Exempt Class:</b>		NONE							
Homestead Application Information									

usual hole

# APPLICATION

A 09423

P

SEWAGE DISPOSAL TESTING

MARYLAND STATE DEPARTMENT OF HEALTH

HOWARD COUNTY

Changed 11/1/74  
WWM

ELLICOTT CITY

DISTRICT 5

DATE 11/23/64

Septic Tank - ~~1200~~ 500 gallons.

Tile field - 400 sq. ft bottom area installed at a depth ~~not more than~~ <sup>4 1/2</sup> ft. ~~Locate~~ <sup>begin</sup> the tile field between 130 ~~ft~~ ft to 160 ft from front lot line and 10 ft to 20 ft from left side lot line as seen when facing lot from Braeburn Rd.

TO: THE COUNTY HEALTH OFFICER  
ELLICOTT CITY, MARYLAND

Druncher to be ~~to~~ <sup>to</sup> address

Mix. #1 1/2 ft. gravel under pipe.

I, HEREBY, APPLY FOR THE NECESSARY TESTS IN ORDER TO CONSTRUCT (OR RECONSTRUCT) A SEWAGE DISPOSAL SYSTEM.

Spec's Attached.

PROPERTY OWNER A. H. Young, Jr., Inc.

ADDRESS Ashton, Maryland

PHONE WA 4-4103

PROPERTY LOCATION:

SUBDIVISION Braeburn

LOT NO. 6, Plat 1

ROAD AND DESCRIPTION Braeburn Road

OCCUPANT

PHONE

PERSON TO CONSTRUCT SYSTEM THE SYSTEM UNDER THIS PERMIT IS ACCEPTABLE ONLY UNTIL PUBLIC FACILITIES BECOME AVAILABLE.

ADDRESS

PHONE

SIZE OF LOT 1.550 acres

TYPE BLDG.

NUMBER OF BEDROOMS

IF NOT SINGLE RESIDENCE DESCRIBE

BLDG. PERMIT SIGNED

AND RETURNED 12/13/74

SIGNATURE OF APPLICANT /s/ A. H. Young, Jr.

APPROVED BY J. H. Kilmore

FOR Tile field (KIND OF SYSTEM)

DATE 7/29/65

REJECTED BY FOR (KIND OF SYSTEM)

DATE

HOLD PENDING FURTHER TESTS DATE


REASONS FOR REJECTION OR HOLDING

5/22/73 Hold Drain Field?

40' off left 180' in from front 10 1/2' deep wet soil Misc  
sandy 3'-9' possibly wet Hold at 9' Hold  
for supervisor CBV.

# THIS IS NOT A PERMIT

lot #6

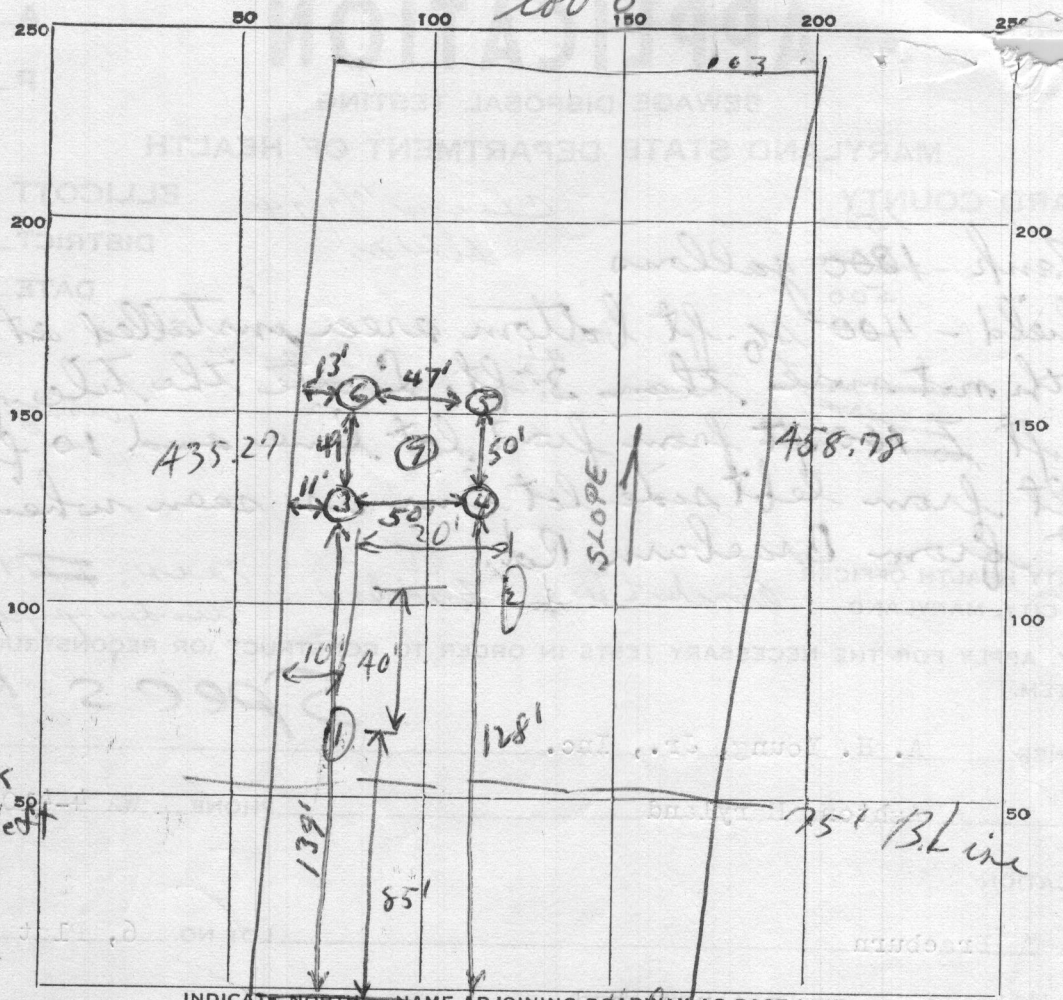

Mrs. Christine  
 9457 Marycrest Pl  
 Ch. Md.  
 Visual hole  
 180 ft. back  
 50 ft. from left

INDICATE NORTH. NAME ADJOINING ROADWAY AS BASE LINE.

Braeburn Rd. 145

DATE	TEST NO.	DEPTH	PRE-WET		TEST - 1" DROP		TIME
			START	STOP	START	STOP	
11/24/64	1	10 ft.	hit water at 10 ft.				
	2	10 ft.	not tested				
7/29/65	3	3 1/2'	10:38	10:44	10:44	10:54	10 min
	4	3 1/2'	10:55	11:00	11:00	11:10	10 min
	5	4'	10:50	10:52	10:52	10:54	2 min
	6	3 1/2'	10:49	10:52	10:52	11:01	9 min 4/41 (11 min)
	7	8 1/2'	10:42	10:53	10:53	11:03	10 min

SOIL AUGER FINDING 7/29/65 - water at 10 ft. - Hole #7 - JHN

TESTED BY RDE - 11/24/64

REMARKS 12/2/64 - Final grade before can be tested again.

ALSO PRESENT Charles Lynn LOT NO. 6, Sec. 1

Braeburn lot # 6 plat 1 Braeburn Rd.

Septic tank - 1500 gal.

Tile field - 500 sq. ft. bottom area installed at a depth of maximum  $4\frac{1}{2}$  ft. with a minimum of  $1\frac{1}{2}$  ft. gravel under pipe. inlet at distribution box max. 3

Location: tile field to start 130 ft. from front line and 10 ft. from left side line as seen when facing lot from Braeburn Rd.

\* Trenches to be perpendicular to left side line

Trenches to be minimum of 3X width center to center and each trench to be directly behind one before

\* maximum length of trench 100 ft.  
(Suggest 2 trenches of 85 ft. ea.)



SEQUENCE NO. (WRA USE ONLY) **C 1** **2315**

DATE RECEIVED (WRA USE ONLY) **12/27/74**

DATE WELL COMPLETED **12/27/74**

PERMIT NO. FROM "PERMIT TO DRILL WELL" **110-73-0885**

DRILLERS IDENTIFICATION NO. **92**

FIRST NAME **Colombio Md.**

POST OFFICE **Colombia Md.**

STATE OF MARYLAND  
WATER RESOURCES ADMINISTRATION  
TAWES STATE OFFICE BLDG., ANNAPOLIS, MD. 21401  
WELL COMPLETION REPORT

THIS REPORT MUST BE SUBMITTED WITHIN 30 DAYS AFTER WELL COMPLETION

FILL IN THIS FORM COMPLETELY

COUNTY NUMBER

OWNER **Fieltz Wilson**

STREET OR RFD **9457 Maryland Rd.**

WELL DESCRIPTION **Handy sandstone granite**

WELL LOG

DESCRIPTION (USE ADDITIONAL SHEETS IF NECESSARY)	FEET FROM	TO	CHECK IF BEARING
Handy	0	9	✓
sandstone	9	57	✓
granite	57	80	✓
	80	160	

WELL LOG

STATE THE KIND OF FORMATIONS PENETRATED, THEIR COLOR, DEPTH, THICKNESS AND IF WATER BEARING

DATE RECEIVED (WRA USE ONLY) **8-13**

DATE WELL COMPLETED **12/27/74**

DEPTH OF WELL **160** FT. (TO NEAREST FOOT)

DEPTH OF GROUT SEAL (TO NEAREST FOOT) **29**

NO. OF BAGS **4**

NO. OF POUNDS **400**

GALLONS OF WATER **25**

DEPTH OF GROUT SEAL (TO NEAREST FOOT) **29**

FROM **0** FT. TO **54** FT. (ENTER 0 IF FROM SURFACE)

CASING TYPES **ST**

INSERT **ST**

APPROPRIATE CODE BELOW **ST**

WATER LEVEL: (DISTANCE FROM LAND SURFACE) BEFORE PUMPING **17** (NEAREST FOOT)

WHEN PUMPING **22** (NEAREST FOOT)

HOURS PUMPED (TO NEAREST HOUR) **8**

PUMPING RATE (GALLONS PER MINUTE TO NEAREST GALLON) **10**

METHOD USED TO MEASURE PUMPING RATE **water**

TYPE OF PUMPED USED (CIRCLE APPROPRIATE BOX) **P** PISTON **T** TURBINE **O** OTHER (DESCRIBE BELOW)

TYPE OF PUMP (WRITE APPROPRIATE LETTER IN BOX - SEE ABOVE: A, C, J, P, R, S, T, O)

DRILLER WILL INSTALL PUMP (CIRCLE APPROPRIATE BOX) **Y** YES **N** NO

CAPACITY: GALLONS PER MINUTE (TO NEAREST GALLON) **31**

PUMP HORSE POWER **37**

PUMP COLUMN LENGTH (NEAREST FOOT) **43**

CASING HEIGHT (CIRCLE APPROPRIATE BOX AND ENTER CASING HEIGHT) **+** ABOVE **-** BELOW **51** (NEAREST FOOT)

LOCATION OF WELL ON LOT

SHOW PERMANENT STRUCTURE SUCH AS BUILDINGS, SEPTIC TANKS, AND/OR OTHER LAND MARKS AND INDICATE NOT LESS THAN TWO DISTANCES (MEASUREMENTS TO WELL).

WELL LOG

STATE THE KIND OF FORMATIONS PENETRATED, THEIR COLOR, DEPTH, THICKNESS AND IF WATER BEARING

DATE RECEIVED (WRA USE ONLY) **8-13**

DATE WELL COMPLETED **12/27/74**

DEPTH OF WELL **160** FT. (TO NEAREST FOOT)

DEPTH OF GROUT SEAL (TO NEAREST FOOT) **29**

NO. OF BAGS **4**

NO. OF POUNDS **400**

GALLONS OF WATER **25**

DEPTH OF GROUT SEAL (TO NEAREST FOOT) **29**

FROM **0** FT. TO **54** FT. (ENTER 0 IF FROM SURFACE)

CASING TYPES **ST**

INSERT **ST**

APPROPRIATE CODE BELOW **ST**

WATER LEVEL: (DISTANCE FROM LAND SURFACE) BEFORE PUMPING **17** (NEAREST FOOT)

WHEN PUMPING **22** (NEAREST FOOT)

HOURS PUMPED (TO NEAREST HOUR) **8**

PUMPING RATE (GALLONS PER MINUTE TO NEAREST GALLON) **10**

METHOD USED TO MEASURE PUMPING RATE **water**

TYPE OF PUMPED USED (CIRCLE APPROPRIATE BOX) **P** PISTON **T** TURBINE **O** OTHER (DESCRIBE BELOW)

TYPE OF PUMP (WRITE APPROPRIATE LETTER IN BOX - SEE ABOVE: A, C, J, P, R, S, T, O)

DRILLER WILL INSTALL PUMP (CIRCLE APPROPRIATE BOX) **Y** YES **N** NO

CAPACITY: GALLONS PER MINUTE (TO NEAREST GALLON) **31**



PUMP HORSE POWER **37**

PUMP COLUMN LENGTH (NEAREST FOOT) **43**


CASING HEIGHT (CIRCLE APPROPRIATE BOX AND ENTER CASING HEIGHT) **+** ABOVE **-** BELOW **51** (NEAREST FOOT)

LOCATION OF WELL ON LOT


SHOW PERMANENT STRUCTURE SUCH AS BUILDINGS, SEPTIC TANKS, AND/OR OTHER LAND MARKS AND INDICATE NOT LESS THAN TWO DISTANCES (MEASUREMENTS TO WELL).

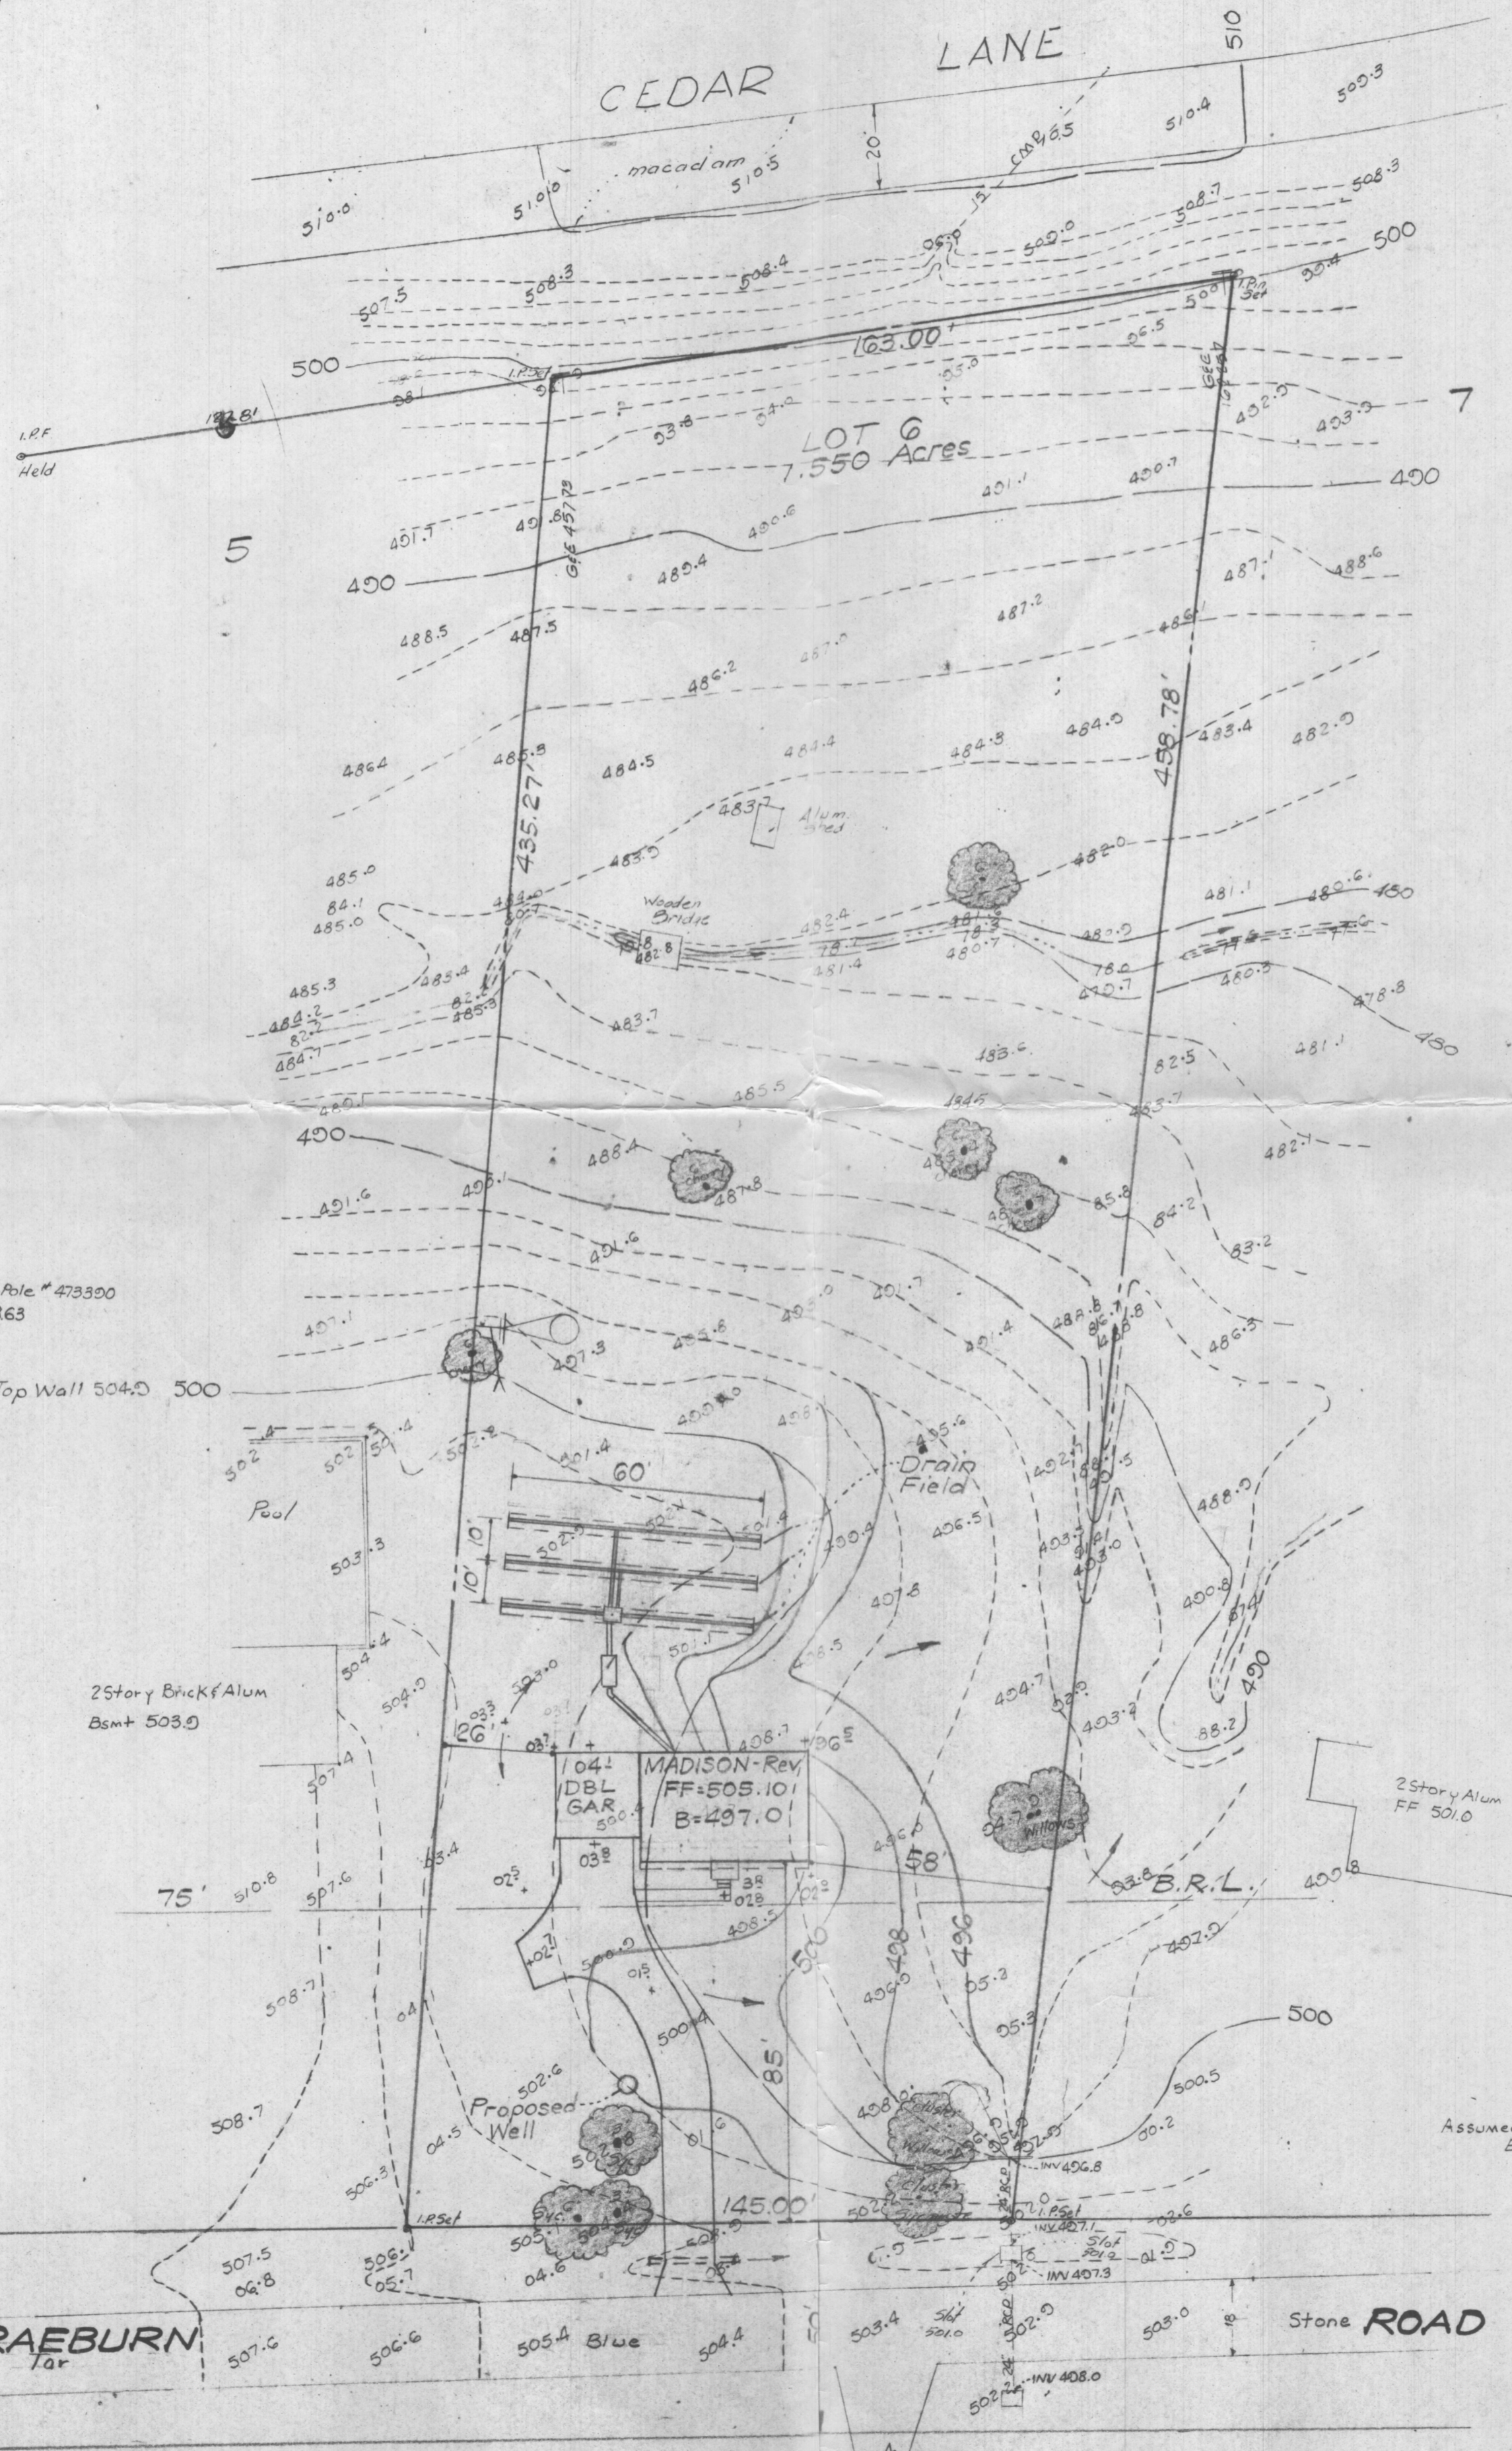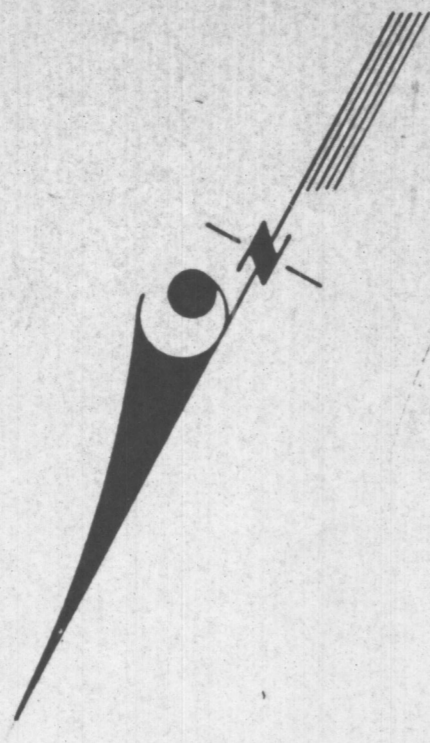

PLAN  
SCALE: 1" = 30'

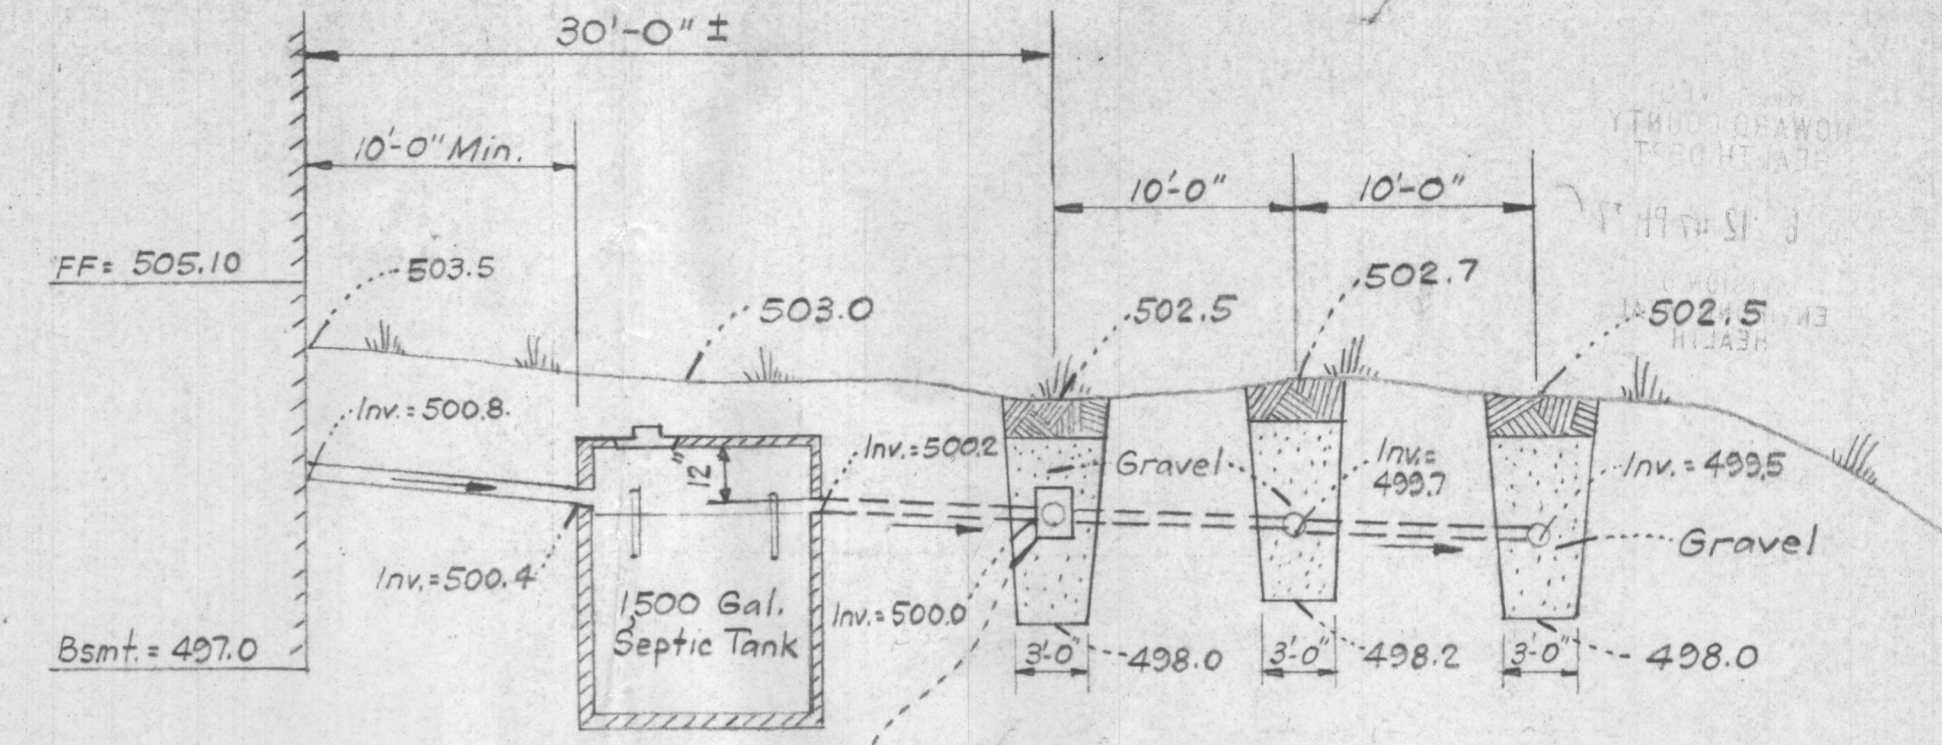

SECTION THRU SEPTIC SYSTEM  
NO SCALE

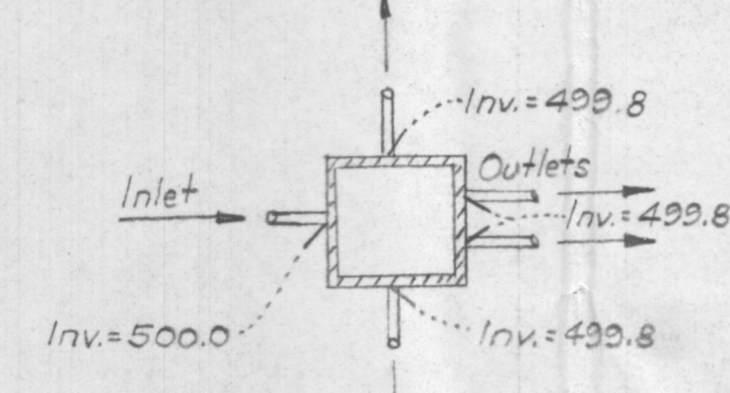

PLAN VIEW  
DISTRIBUTION BOX  
NO SCALE

LEGEND

- 1. Contour Interval 2 FT
- 2. Existing Contours - - - - - 490
- 3. Proposed Contours ——— 496
- 4. Spot Elevations +96<sup>E</sup>
- 5. Direction Of Drainage →
- 6. Trees to be Retained

OK  
12-9-74  
SWM

- NOTES:
1. Lot G was recorded in Plat Book 8 Folio 80
  2. Lot G is located on Tax Map No. 35
  3. Lot G is located on the Clarksville Quad.

Charles P & William K. Fields  
9457 Merryrest Rd.  
Columbia, Md. 21045  
Tel. 997-0974

SURVEYOR'S CERTIFICATION

I hereby certify that the elevations shown hereon are a result of actual field run topography in the datum shown.

*Donald B. Sackett*  
DONALD B. SACKETT  
Registered Land Surveyor  
Md. No. 6052



BM 60" Nail GFE Pole #473300  
Elev 498.63

Top Wall 504.5 500

25 Story Brick Alum  
Bsmt 503.9

Assumed: BM Top Head Wall  
Elev 500.0

<b>CLARK • FINEFROCK &amp; SACKETT</b> ENGINEERS • PLANNERS • SURVEYORS 11315 LOCKWOOD DRIVE SILVER SPRING, MARYLAND 20904 (301) 593-3400		
DESIGNED W.R.M.	<b>SITE DEVELOPMENT PLAN</b> LOT G PLAT ONE <b>BRAEBURN</b> 5TH ELECTION DISTRICT HOWARD COUNTY, MARYLAND FOR: Mr. WILLIAM FIELDS 9457 Merryrest Road Columbia, Md. 21045	SCALE As Shown
DRAWN K.W.C.		DRAWING 10F1
CHECKED W.R.M.		JOB NO.
DATE Dec., 1974		FILE NO. 1126-X