

Real Property Data Search ( w4)

Search Result for HOWARD COUNTY

View Map		View GroundRent Redemption				View GroundRent Registration				
<b>Tax Exempt:</b>		<b>Special Tax Recapture:</b>								
<b>Exempt Class:</b>		NONE								
<b>Account Identifier:</b>		<b>District - 05 Account Number - 415195</b>								
Owner Information										
<b>Owner Name:</b>		PRICE THOMAS H III			<b>Use:</b>		RESIDENTIAL			
<b>Mailing Address:</b>		4203 BUCKSKIN LANE DR ELLCOTT CITY MD 21042-			<b>Principal Residence:</b>		NO			
					<b>Deed Reference:</b>		/15805/ 00476			
Location & Structure Information										
<b>Premises Address:</b>		12909 FOLLY QUARTER RD ELLCOTT CITY 21042- 0000			<b>Legal Description:</b>		LOT 63 5.421 A 12909 FOLLY QUARTER RD BUCKSKIN WOODS S1 A2			
<b>Map:</b>	<b>Grid:</b>	<b>Parcel:</b>	<b>Sub District:</b>	<b>Subdivision:</b>	<b>Section:</b>	<b>Block:</b>	<b>Lot:</b>	<b>Assessment Year:</b>	<b>Plat No:</b>	15172
0022	0022	0535		0000			63	2017	<b>Plat Ref:</b>	2035/ 0027
<b>Special Tax Areas:</b>				<b>Town:</b>		NONE				
				<b>Ad Valorem:</b>		100				
				<b>Tax Class:</b>						
<b>Primary Structure Built</b>		<b>Above Grade Living Area</b>		<b>Finished Basement Area</b>		<b>Property Land Area</b>		<b>County Use</b>		
						4.2100 AC				
<b>Stories</b>	<b>Basement</b>	<b>Type</b>	<b>Exterior</b>	<b>Full/Half Bath</b>	<b>Garage</b>	<b>Last Major Renovation</b>				
Value Information										
		<b>Base Value</b>		<b>Value</b>		<b>Phase-in Assessments</b>				
				As of		As of		As of		
				01/01/2017		07/01/2018		07/01/2019		
<b>Land:</b>		103,100		93,100						
<b>Improvements</b>		0		0						
<b>Total:</b>		103,100		93,100		93,100		93,100		
<b>Preferential Land:</b>		0						0		
Transfer Information										
<b>Seller:</b> BUCKSKIN IV INC				<b>Date:</b> 09/30/2014				<b>Price:</b> \$0		
<b>Type:</b> NON-ARMS LENGTH OTHER				<b>Deed1:</b> /15805/ 00476				<b>Deed2:</b>		
<b>Seller:</b> BUCKSKIN IV INC				<b>Date:</b> 09/30/2014				<b>Price:</b> \$0		
<b>Type:</b> NON-ARMS LENGTH OTHER				<b>Deed1:</b> /15805/ 00446				<b>Deed2:</b>		
<b>Seller:</b> REUWER DONALD R JR				<b>Date:</b> 04/13/1995				<b>Price:</b> \$0		
<b>Type:</b> NON-ARMS LENGTH OTHER				<b>Deed1:</b> /03467/ 00717				<b>Deed2:</b>		
Exemption Information										
<b>Partial Exempt Assessments:</b>		<b>Class</b>		07/01/2018		07/01/2019				
<b>County:</b>		000		0.00						
<b>State:</b>		000		0.00						
<b>Municipal:</b>		000		0.00 0.00		0.00 0.00				
<b>Tax Exempt:</b>		<b>Special Tax Recapture:</b>								
<b>Exempt Class:</b>		NONE								
Homestead Application Information										
<b>Homestead Application Status:</b> No Application										

---

**Homeowners' Tax Credit Application Information**

---

**Homeowners' Tax Credit Application Status:** No Application    **Date:**

1. This screen allows you to search the Real Property database and display property records.
2. Click **here** for a glossary of terms.
3. Deleted accounts can only be selected by Property Account Identifier.
4. The following pages are for information purpose only. The data is not to be used for legal reports or documents. While we have confidence in the accuracy of these records, the Department makes no warranties, expressed or implied, regarding the information.

# APPLICATION

PERCOLATION TESTING

A 47065  
P \_\_\_\_\_

HOWARD COUNTY HEALTH DEPARTMENT  
BUREAU OF ENVIRONMENTAL HEALTH  
P.O. BOX 476 ELLICOTT CITY, MARYLAND 21043  
TELEPHONE: 461-9933

DISTRICT \_\_\_\_\_  
DATE 5/9/91

TO: THE COUNTY HEALTH OFFICER  
ELLICOTT CITY, MARYLAND

I, HEREBY, APPLY FOR THE NECESSARY TEST IN ORDER TO CONSTRUCT (OR RECONSTRUCT) A SEWAGE DISPOSAL SYSTEM.

PROPERTY OWNER DONALD R. REUWER JR.

ADDRESS 10805 HICKORY RIDGE RD PHONE 740-2100  
SUITE 210 COLUMBIA, MD. 21044

PROSPECTIVE BUYER \_\_\_\_\_

ADDRESS N/A PHONE N/A

PROPERTY LOCATION:

SUBDIVISION REUWER PROPERTY LOT NO. 17

ROAD AND DESCRIPTION FOLLY QUARTER RD.

TAX MAP 22 PARCEL # 535

SIZE OF LOT 3.2 AC. +/- TYPE BLDG SFD  
(SINGLE FAMILY DWELLING OR COMMERCIAL)

THE SYSTEM INSTALLED UNDER THIS APPLICATION IS ACCEPTABLE ONLY UNTIL PUBLIC FACILITIES BECOME AVAILABLE. I FULLY UNDERSTAND THE FEE CONNECTED WITH THE FILING OF THIS PERC TEST APPLICATION IS NON-REFUNDABLE UNDER ANY CIRCUMSTANCES. I ALSO AGREE TO COMPLY WITH ALL M.O.S.H.A. REQUIREMENTS IN TESTING THIS LOT.

Donald R. Reuwer Jr.  
(SIGNATURE OF APPLICANT)

APPROVED BY \_\_\_\_\_ FOR \_\_\_\_\_ DATE \_\_\_\_\_

REJECTED BY \_\_\_\_\_ FOR \_\_\_\_\_ DATE \_\_\_\_\_

HOLD PENDING FURTHER TESTS \_\_\_\_\_ DATE \_\_\_\_\_

REASONS FOR REJECTION OR HOLDING 6/11/91 PERC OK HOLD FOR PLAT LS  
HOUSE SITE & WELL SITE MUST BE CHANGED

HD-216








# THIS IS NOT A PERMIT

Lot 12  
SEE IT

SEE OTHER SHEET A47064

A4706

FOR LOCATION  
OF GOOD HOLES  
A47064

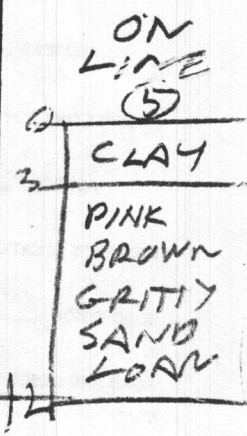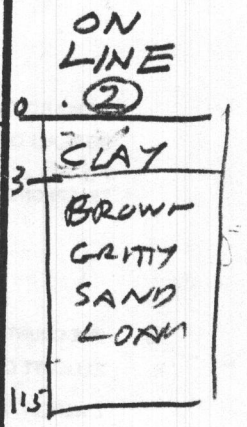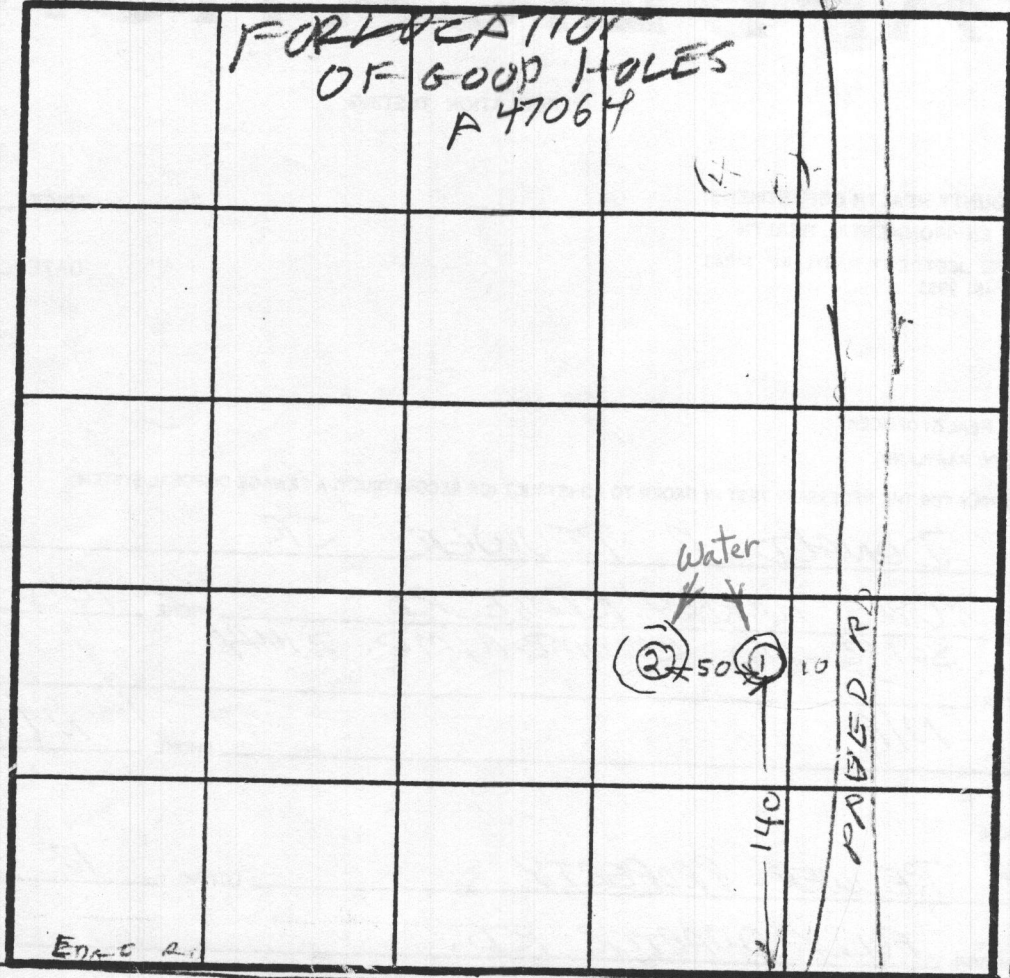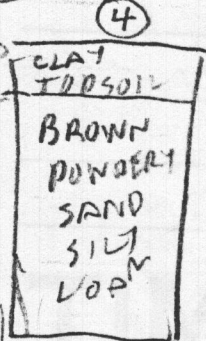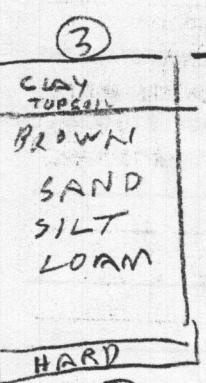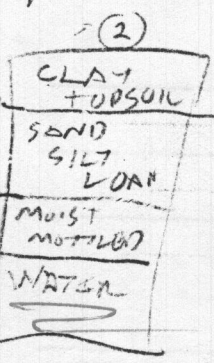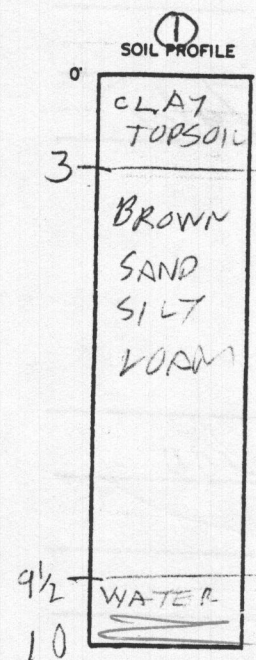

INDICATE NORTH - NAME ADJOINING ROADWAY AS BASE LINE.

FOLLY QUARTER RD

DATE	TEST NO.	DEPTH	PRE-WET		TEST - 1" DROP		TIME	
			START	STOP	START	STOP		
6/11/91	13	4	1124	1126	1126	1130		FAIL
	14	15	HOLD	FOR	TEST	FOR		FAIL
	2V	11	UNSAT.	FACTOR	UNSAT.			FAIL
	35	4.5	1209	1212	1212	1216	4	OK
	3V	10.5	OK					OK
	45	4	1222	1223	1223	1225	2	OK
	4D	8	1222	1222	1222	1224	2	OK
	4V	11	OK					
	ON LINE HOLE 2	4	1024	1025	1025	1026	1	OK
	ON LINE HOLE 5	11.5	OK					OK

O-BAD HOLE

REMARKS \_\_\_\_\_

TYPE OF SOIL \_\_\_\_\_

TESTED BY R. HODGES

ALSO PRESENT D. REWER, KETTERMAN

# APPLICATION

PERCOLATION TESTING

A 47065  
P \_\_\_\_\_

HOWARD COUNTY HEALTH DEPARTMENT  
BUREAU OF ENVIRONMENTAL HEALTH  
P.O. BOX 476 ELLICOTT CITY, MARYLAND 21043  
TELEPHONE: 461-9933

DISTRICT \_\_\_\_\_  
DATE 5/9/91

TO: THE COUNTY HEALTH OFFICER  
ELLICOTT CITY, MARYLAND

I, HEREBY, APPLY FOR THE NECESSARY TEST IN ORDER TO CONSTRUCT (OR RECONSTRUCT) A SEWAGE DISPOSAL SYSTEM.

PROPERTY OWNER DONALD R. REUWER JR.

ADDRESS 10805 HICKORY RIDGE RD PHONE 740-2100  
SUITE 210 COLUMBIA, MD. 21044

PROSPECTIVE BUYER \_\_\_\_\_

ADDRESS N/A PHONE N/A

PROPERTY LOCATION:

SUBDIVISION REUWER PROPERTY LOT NO. 17

ROAD AND DESCRIPTION FOLLY QUARTER RD.

TAX MAP 22 PARCEL # 535

SIZE OF LOT 3.2 AC. +/- TYPE BLDG. SFD  
(SINGLE FAMILY DWELLING OR COMMERCIAL)

THE SYSTEM INSTALLED UNDER THIS APPLICATION IS ACCEPTABLE ONLY UNTIL PUBLIC FACILITIES BECOME AVAILABLE. I FULLY UNDERSTAND THE FEE CONNECTED WITH THE FILING OF THIS PERC TEST APPLICATION IS NON-REFUNDABLE UNDER ANY CIRCUMSTANCES. I ALSO AGREE TO COMPLY WITH ALL M.O.S.H.A. REQUIREMENTS IN TESTING THIS LOT.

Donald R. Reuwer Jr.  
(SIGNATURE OF APPLICANT)

APPROVED BY \_\_\_\_\_ FOR \_\_\_\_\_ DATE \_\_\_\_\_

REJECTED BY \_\_\_\_\_ FOR \_\_\_\_\_ DATE \_\_\_\_\_

HOLD PENDING FURTHER TESTS \_\_\_\_\_ DATE \_\_\_\_\_

REASONS FOR REJECTION OR HOLDING 6/11/91 PERC OK HOLD FOR PLAT LOPPIN  
HOUSE SITE & WELL SITE MUST BE CHANGED

HD-216







# THIS IS NOT A PERMIT

Lot 12  
SEE OTHER

SEE OTHER SHEET A47064

A47065

FOR LICATION  
OF GOOD HOLES  
A 47064

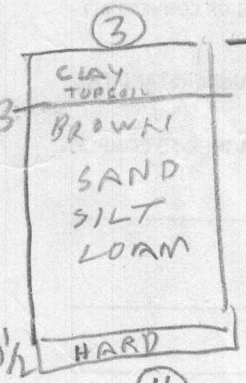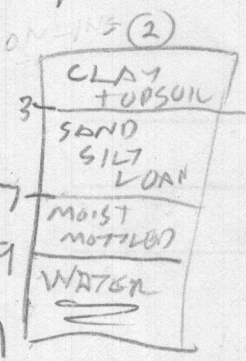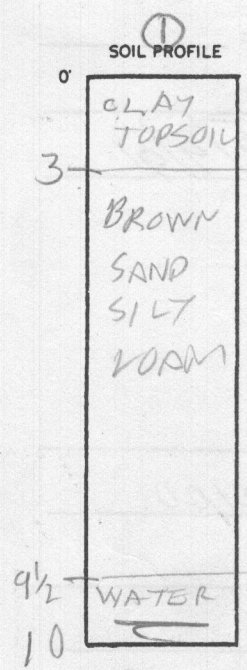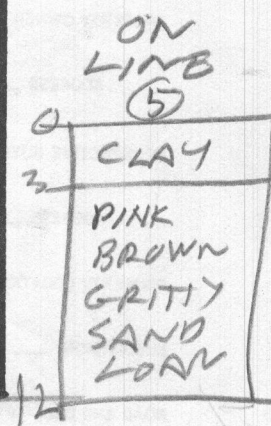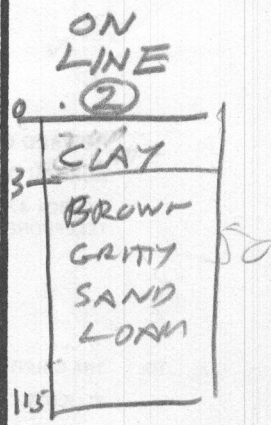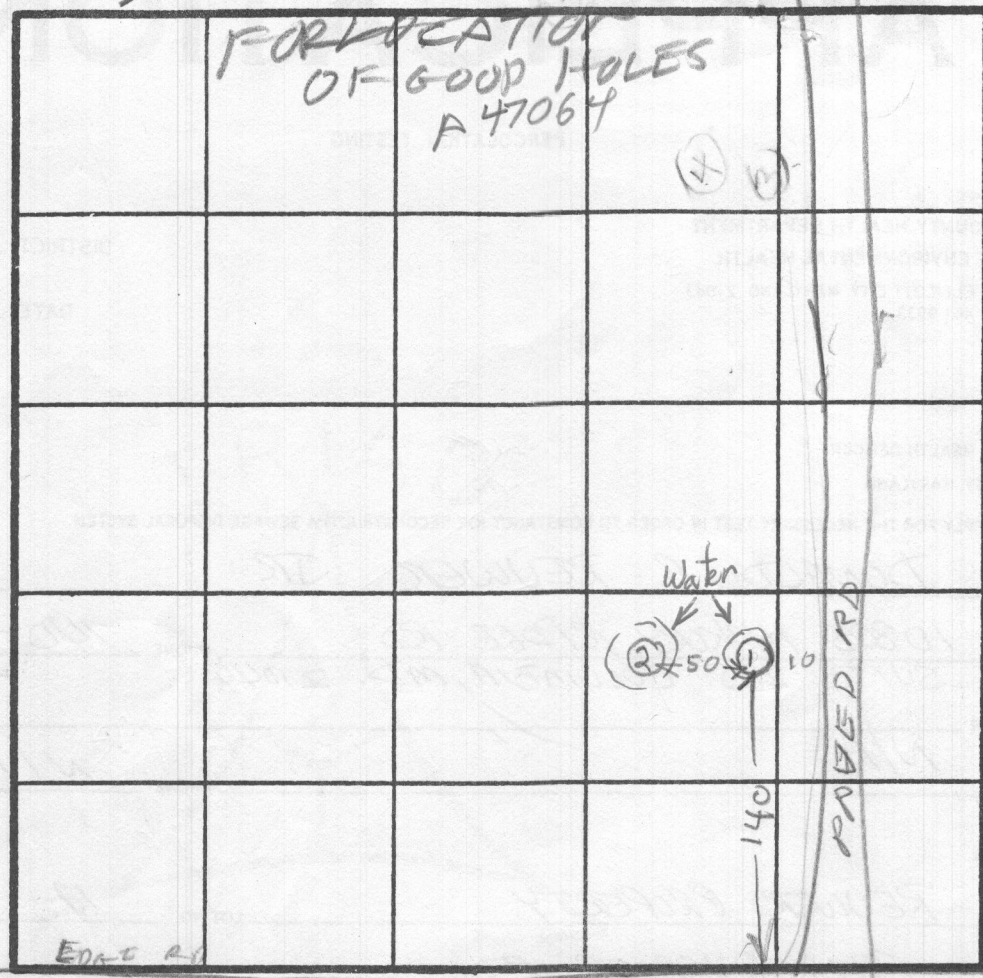

INDICATE NORTH - NAME ADJOINING ROADWAY AS BASE LINE.

KOLLY QUARTER RD

DATE	TEST NO.	DEPTH	PRE-WET		TEST - 1" DROP		TIME		
			START	STOP	START	STOP			
6/11/91	1S	4	1124	1126	1126	1130	4	FAIL	
	1V	10	HOLD	FOR WET SEASON WATER					
	2V	11	UNSATISFACTORY WATER						FAIL
	3S	4.5	1209	1212	1210	1216	4	OK	
	3V	10.5	OK						
	4S	4	1222	1223	1223	1225	2	OK	
	4D	8	1222	1222	1222	1224	2		
	4V	11	OK						
	ON LINE 4 HOLE 2	4	1024	1025	1025	1026	1	OK	
	ON LINE 4 HOLE 2	11.5	OK						
	ON LINE HOLE 5	12	OK						OK

O-BAD HOLE

REMARKS \_\_\_\_\_

TYPE OF SOIL \_\_\_\_\_

TESTED BY B. HIDDGES ALSO PRESENT D. REWER O. KETTERMAN

# APPLICATION

Received 5-6-

PERCOLATION TESTING

A 47064  
P \_\_\_\_\_

HOWARD COUNTY HEALTH DEPARTMENT  
BUREAU OF ENVIRONMENTAL HEALTH  
P.O. BOX 476 ELLICOTT CITY, MARYLAND 21043  
TELEPHONE: 461-9933

DISTRICT \_\_\_\_\_

DATE 5/9/91

Preview ok, Expand SDA  
along contours to obtain  
10,000 sq ft min. Limited  
well sites. TEN 5-8-91

TO: THE COUNTY HEALTH OFFICER  
ELLICOTT CITY, MARYLAND

I, HEREBY, APPLY FOR THE NECESSARY TEST IN ORDER TO CONSTRUCT (OR RECONSTRUCT) A SEWAGE DISPOSAL SYSTEM.

PROPERTY OWNER DONALD R. REUWER JR.

ADDRESS 10805 HICKORY RIDGE RD. PHONE 740-2100  
SUITE 210 COLUMBIA, MD. 21044

PROSPECTIVE BUYER \_\_\_\_\_  
ADDRESS N/A PHONE N/A

PROPERTY LOCATION:

SUBDIVISION REUWER PROPERTY LOT NO. 11

ROAD AND DESCRIPTION FOLLY QUARTER RD.

TAX MAP 22 PARCEL # 535

SIZE OF LOT 3.4 AC. +/- TYPE BLDG. SFD  
(SINGLE FAMILY DWELLING OR COMMERCIAL)

THE SYSTEM INSTALLED UNDER THIS APPLICATION IS ACCEPTABLE ONLY UNTIL PUBLIC FACILITIES BECOME AVAILABLE. I FULLY UNDERSTAND THE FEE CONNECTED WITH THE FILING OF THIS PERC TEST APPLICATION IS NON-REFUNDABLE UNDER ANY CIRCUMSTANCES. I ALSO AGREE TO COMPLY WITH ALL M.O.S.H.A. REQUIREMENTS IN TESTING THIS LOT.

Donald R. Reuwer Jr.  
(SIGNATURE OF APPLICANT)

APPROVED BY \_\_\_\_\_ FOR \_\_\_\_\_ DATE \_\_\_\_\_

REJECTED BY \_\_\_\_\_ FOR \_\_\_\_\_ DATE \_\_\_\_\_


HOLD PENDING FURTHER TESTS \_\_\_\_\_ DATE \_\_\_\_\_

REASONS FOR REJECTION OR HOLDING 6/25/91 PERC OK BUT LOT LINES  
WELL SITES & HOUSE SITES MUST BE CHANGED

HD-216

## THIS IS NOT A PERMIT

Lot 11

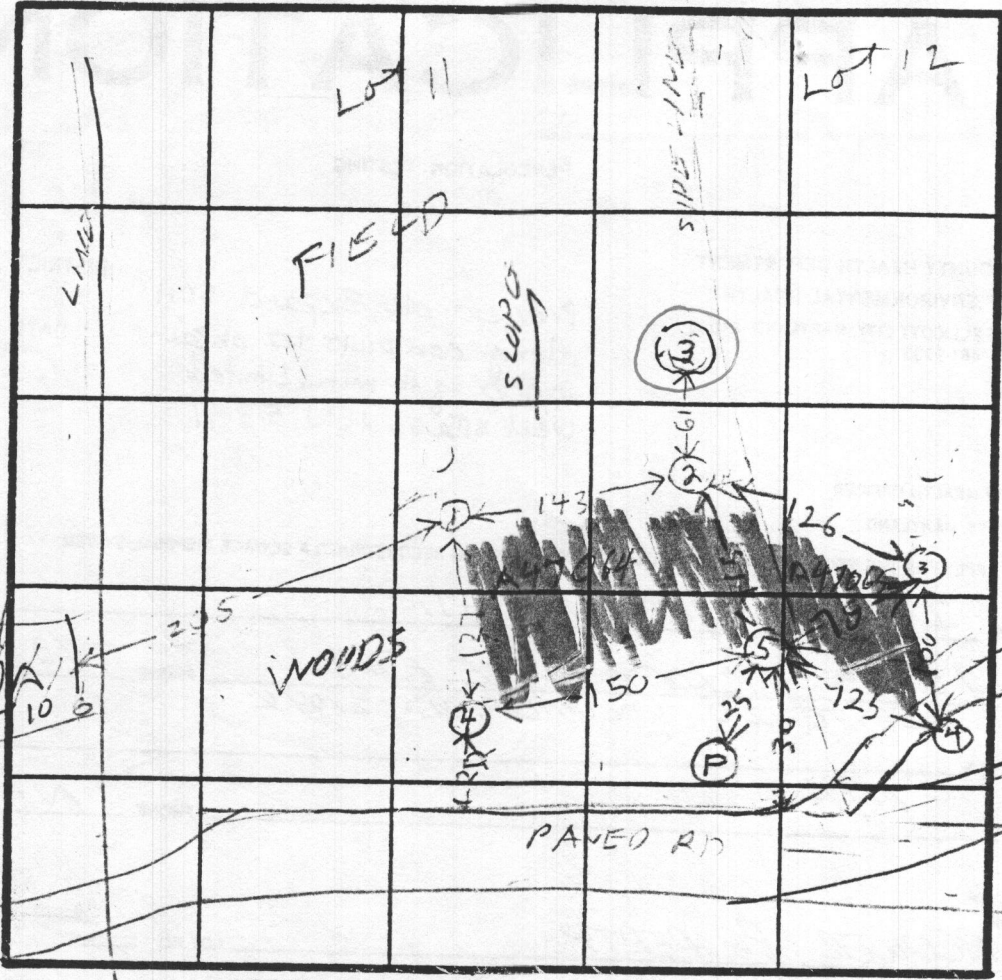

Ⓟ = GE #83572  
 ○ = BAD HOLE 150

SOIL PROFILE ②  
 0 BOSSOIL CLAY  
 3 BROWN GRITTY SAND LOAM  
 11.5

④  
 0 CLAY TOPSOIL  
 BROWN GRITTY SAND LOAM  
 ⑤  
 0 TOPSOIL CLAY  
 3 PINK BROWN GRITTY SAND LOAM

INDICATE NORTH - NAME ADJOINING ROADWAY AS BASE LINE.

DATE	TEST NO.	DEPTH	PRE-WET		TEST - 1" DROP		TIME
			START	STOP	START	STOP	
6/11/91	1S 1V	4 11.5	1014 OK	1015	1015	1016	1
6/11/91	2S 2V	4 11.5	1024 OK	1025	1025	1026	1
	③	?	NOT TESTED PER KETTERMAN JR		CLAY		
	4S 4M	4 6.5	1043 1036	1045 1037	1045	1049 1039	4 2
	4V	10	OK				
	5V	12	OK				

ON LINE LOT 11 & 12

ON LINE HOLE LOT 11 & 12

REMARKS 1 \_\_\_\_\_  
 TYPE OF SOIL \_\_\_\_\_  
 TESTED BY R. HODGES  
 ALSO PRESENT CHRIS D. REWER O. KETTERMAN JR

# APPLICATION

Received 5-6-91

6-11-91  
10:00am

PERCOLATION TESTING

A 47064  
P \_\_\_\_\_

HOWARD COUNTY HEALTH DEPARTMENT  
BUREAU OF ENVIRONMENTAL HEALTH  
P.O. BOX 476 ELLICOTT CITY, MARYLAND 21043  
TELEPHONE: 461-9933

Preview ok, Expand SDA  
along contours to obtain  
10,000 sq ft min. Limited  
well sites. JEN 5-8-91

DISTRICT \_\_\_\_\_

DATE 5/9/91

TO: THE COUNTY HEALTH OFFICER  
ELLICOTT CITY, MARYLAND

I, HEREBY, APPLY FOR THE NECESSARY TEST IN ORDER TO CONSTRUCT (OR RECONSTRUCT) A SEWAGE DISPOSAL SYSTEM.

PROPERTY OWNER DONALD R. REUWER JR.

ADDRESS 10805 HICKORY RIDGE RD. PHONE 740-2100  
SUITE 210 COLUMBIA, MD. 21044

PROSPECTIVE BUYER N/A

ADDRESS N/A PHONE N/A

PROPERTY LOCATION:

SUBDIVISION REUWER PROPERTY LOT NO. ~~11~~ 39 <sup>40/45</sup>

ROAD AND DESCRIPTION FOLLY QUARTER RD.

TAX MAP 22 PARCEL # 535

SIZE OF LOT 3.4 AC. +/- TYPE BLDG. SFD  
(SINGLE FAMILY DWELLING OR COMMERCIAL)

THE SYSTEM INSTALLED UNDER THIS APPLICATION IS ACCEPTABLE ONLY UNTIL PUBLIC FACILITIES BECOME AVAILABLE. I FULLY UNDERSTAND THE FEE CONNECTED WITH THE FILING OF THIS PERC TEST APPLICATION IS NON-REFUNDABLE UNDER ANY CIRCUMSTANCES. I ALSO AGREE TO COMPLY WITH ALL M.O.S.H.A. REQUIREMENTS IN TESTING THIS LOT. Donald R. Reuwer Jr.  
(SIGNATURE OF APPLICANT)

APPROVED BY \_\_\_\_\_ FOR \_\_\_\_\_ DATE \_\_\_\_\_

REJECTED BY \_\_\_\_\_ FOR \_\_\_\_\_ DATE \_\_\_\_\_


HOLD PENDING FURTHER TESTS \_\_\_\_\_ DATE \_\_\_\_\_

REASONS FOR REJECTION OR HOLDING 6/25/91 PERC OK BUT LOT LINES  
WELL SITE & HOUSE SITE MUST BE CHANGED

HD-216

# THIS IS NOT A PERMIT

Lot 11

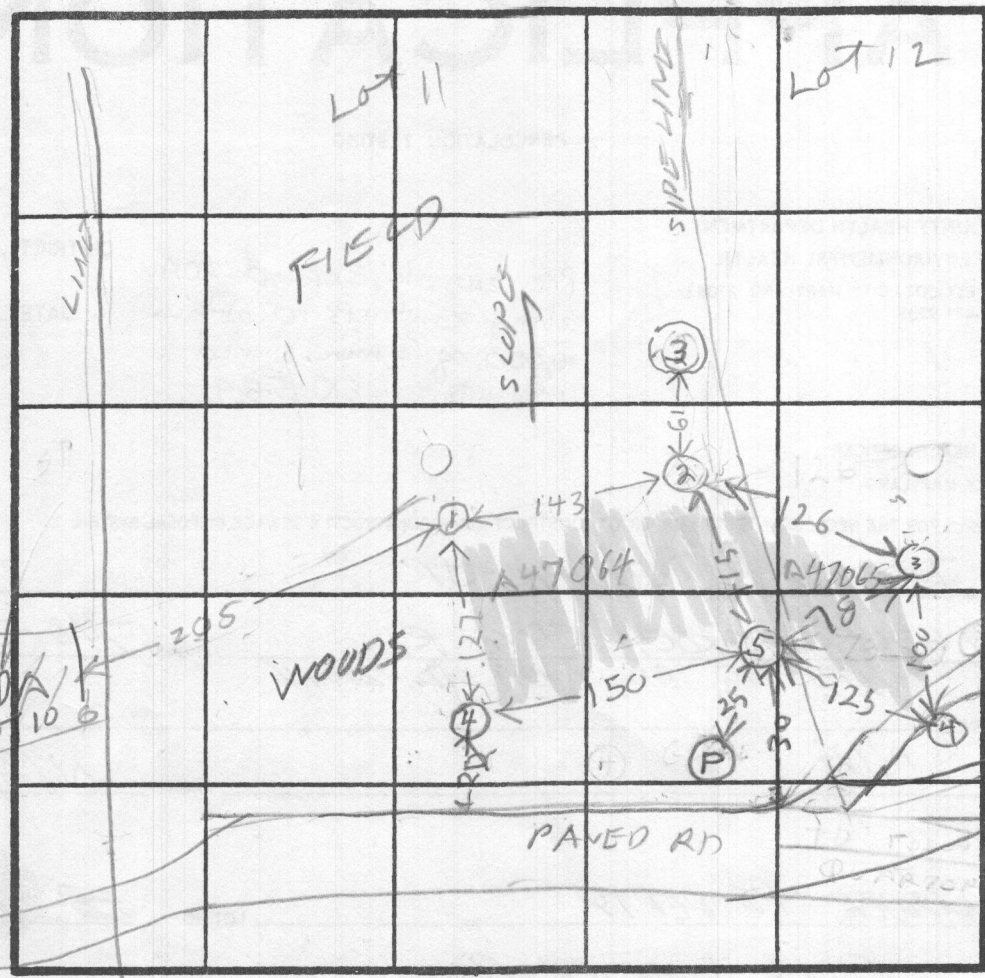

⊖ = GE #88572  
 ○ = BAD HOLE 150

SOIL PROFILE 2  
 0' TOPSOIL CLAY  
 3' BROWN GRITTY SAND LOAM

4  
 0' CLAY TOPSOIL  
 2' BROWN GRITTY SAND LOAM

5  
 0' TOPSOIL CLAY  
 3' PINK BROWN GRITTY SAND LOAM

INDICATE NORTH - NAME ADJOINING ROADWAY AS BASE LINE.

DATE	TEST NO.	DEPTH	PRE-WET		TEST - 1' DROP		TIME	
			START	STOP	START	STOP		
6/11/91	1S	4	1014	1015	1015	1016	1	
	1V	11.5	OK					
6/11/91	2S	4	1024	1025	1025	1026	1	
	2V	11.5	OK					
	3V	?	NOT TESTED CLAY PER KETTERMAN JR					
	4S	4	1043	1045	1045	1049	4	
	4M	6.5	1036	1037	1037	1039	2	
	4V	10	OK					
	5V	12	OK					

ON LINE HOLE LOT 11 & 12

ON LINE HOLE LOT 11 & 12

REMARKS 1

TYPE OF SOIL


TESTED BY R. HODGES

ALSO PRESENT CHRIS D. REWER O. KETTERMAN JR







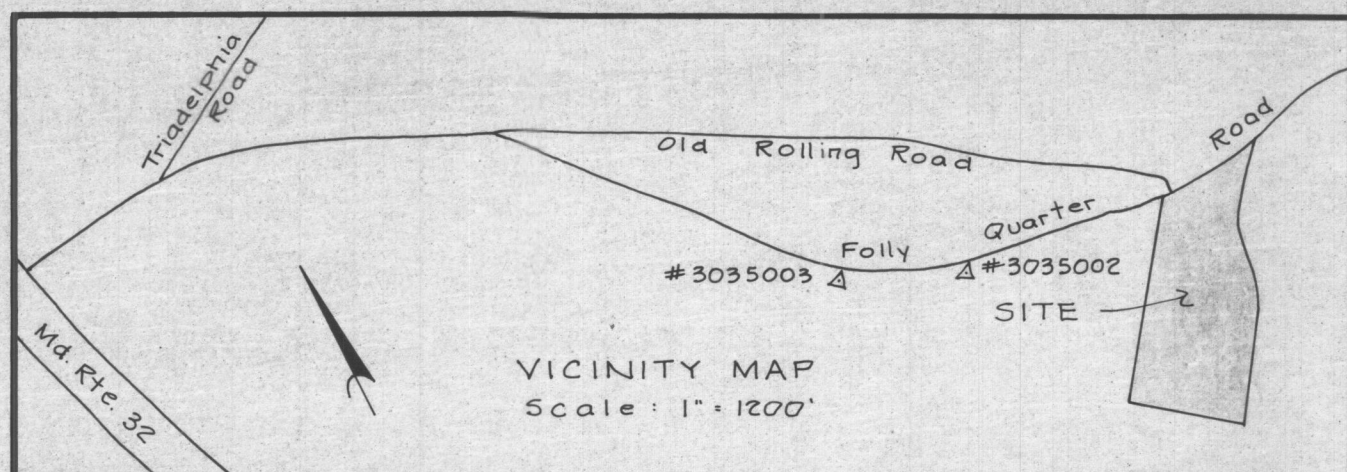


CURVE		DATA				
Nos.	Δ	Rad.	Arc	Tan.	Ch.	L.C.B.
2-3	22° 32' 02"	1200.30	472.06	239.12	469.03	N 87° 33' 34" E
5-6	27° 53' 00"	226.41	110.18	56.20	109.10	S 29° 29' 04" W
7-8	20° 16' 01"	254.76	90.12	45.53	89.64	S 25° 40' 35" W

COORDINATE		SCHEDULE
No.	North	East
1	518,270.51	810,716.52
2	518,257.45	810,784.84
3	518,261.05	811,253.86
4	518,285.58	811,372.23
5	517,968.87	811,072.46
6	517,873.90	811,018.76
7	517,433.51	810,896.27
8	517,352.72	810,857.43
9	517,279.84	810,804.85
10	516,798.38	810,456.90
11	516,765.79	810,429.01
12	517,241.62	809,858.45

Maryland State Grid System  
No. Co. Control Stations 3035002 & 3035003

NOTES:

- Subject property zoned R as per 8-2-85 Comprehensive Zoning Plan.
- For flag or pipestem lot, refuse collection, snow removal and road maintenance are provided to the junction of the flag or pipe stem lot driveway.
- This area designates a private sewage easement of approx. 10,000 Sq. Ft. as req'd. by the Md. State Dept. of Health and Mental Hygiene for individual sewage disposal. Improvements of any nature in this area shall become null and void upon connection to a public sewage system. The county Health officer shall have the authority to grant variances for encroachments into the private sewage easement. Recordation of a modified sewage easement shall not be necessary.
- The lots shown hereon comply with the minimum ownership width and lot areas as req'd. by the Md. State Dept. of Health and Mental Hygiene.
- O denotes pipes set  
■ denotes concrete monument to be set
- Subject To V.P. 85-55

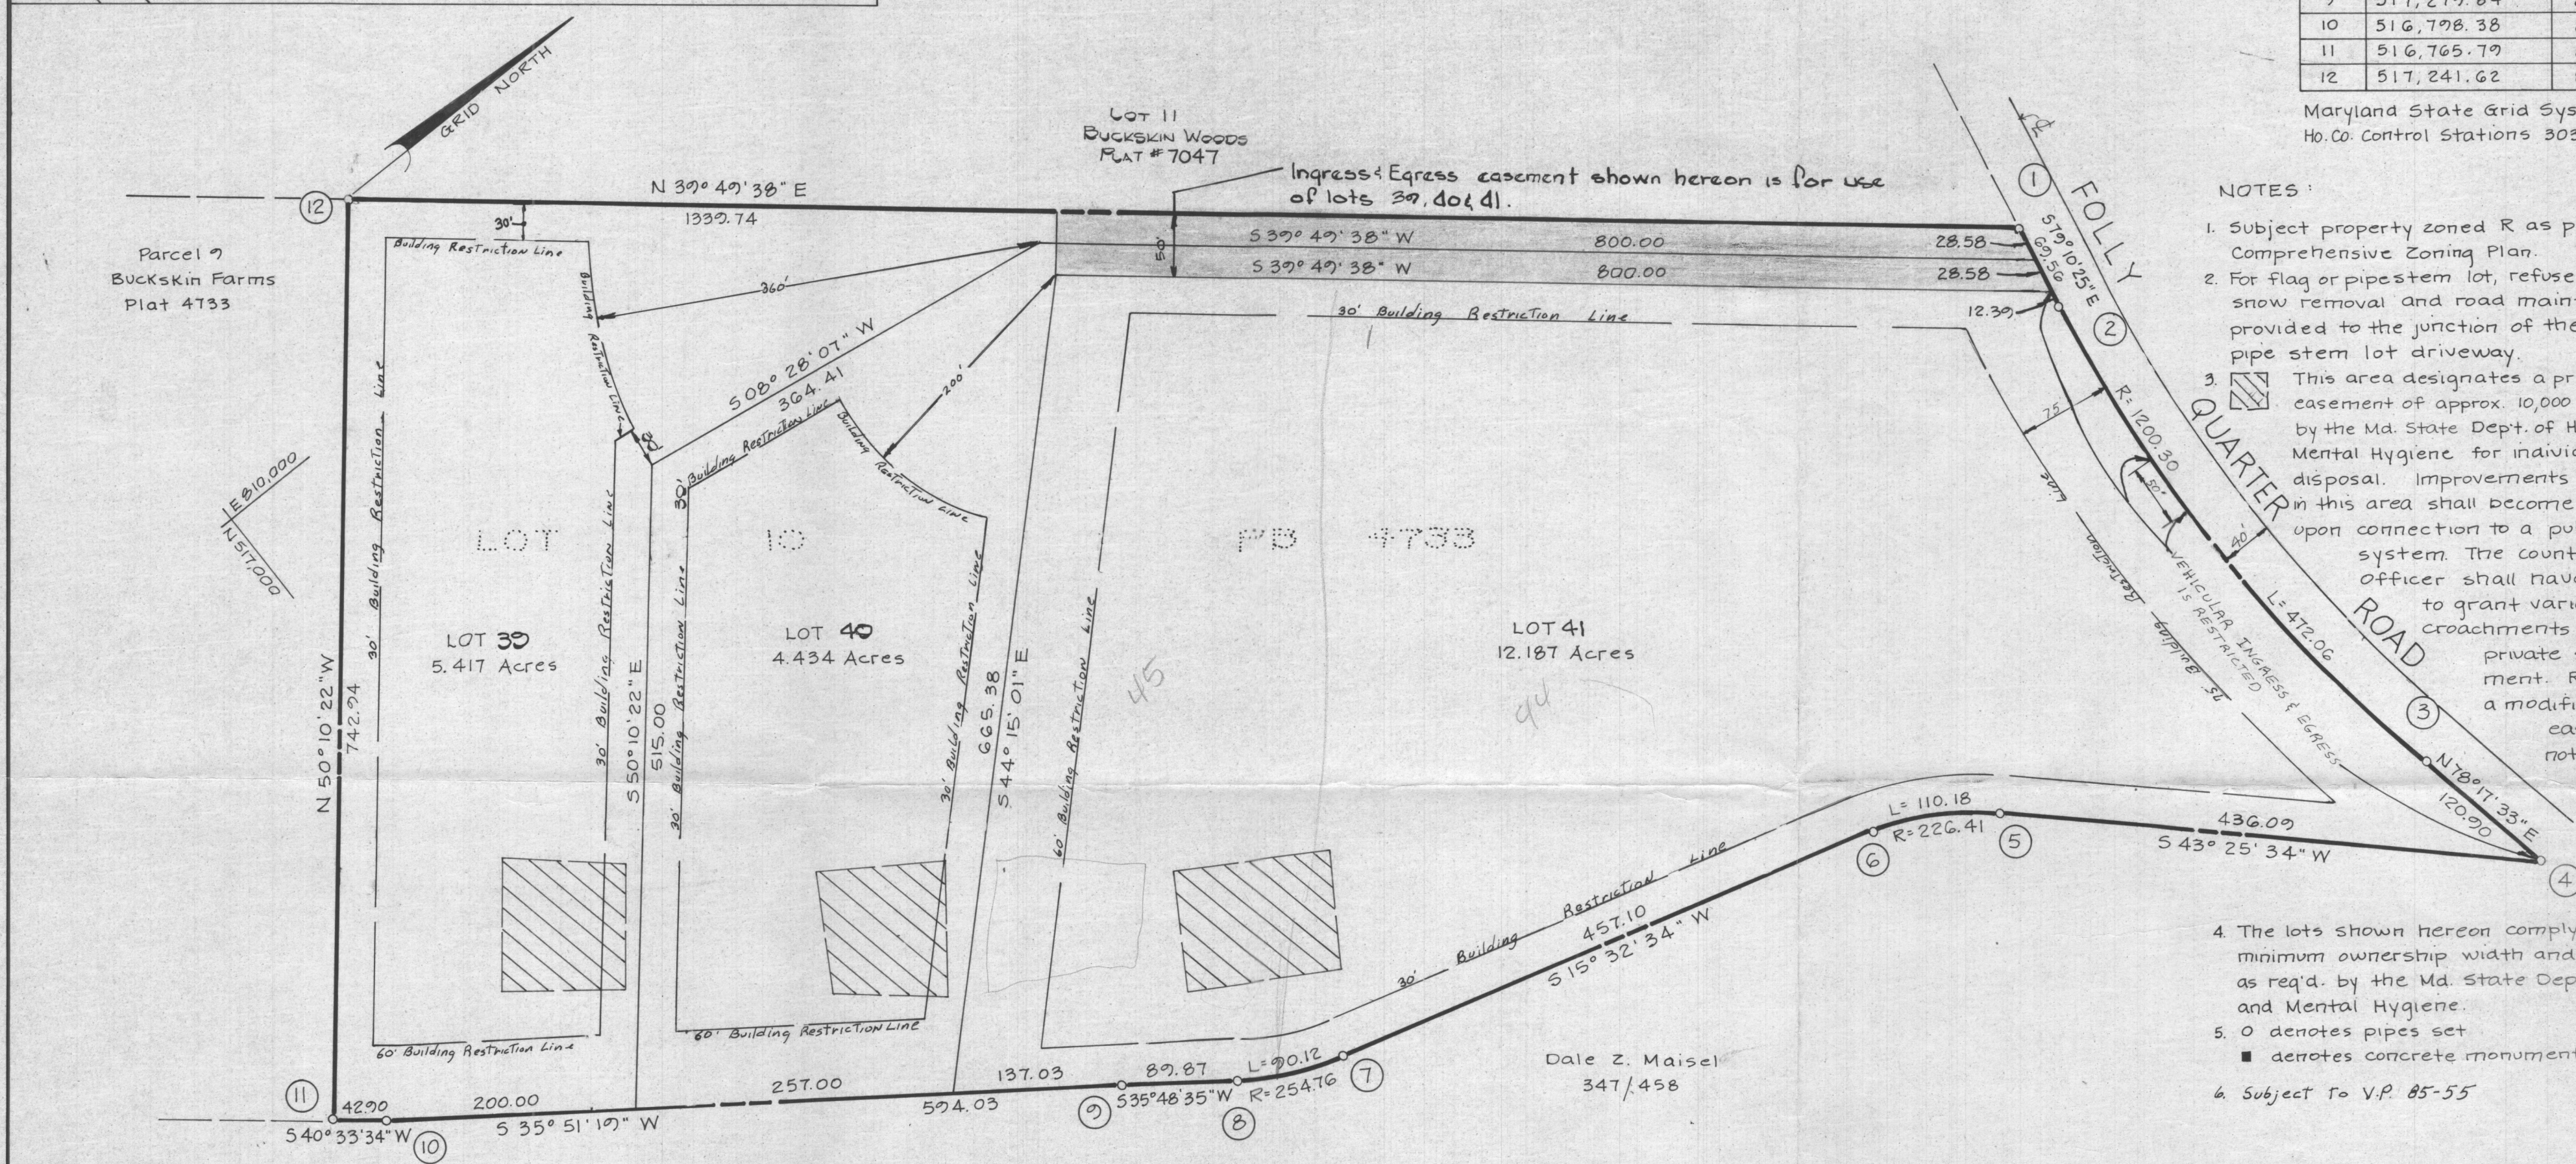

TABULATION:

TOTAL NO. OF LOTS and/or PARCELS to be recorded	3
TOTAL AREA OF LOTS and/or PARCELS	22.038 Acres
TOTAL AREA OF ROADWAYS incl. widening strips	0
TOTAL AREA OF SUBDIVISION	22.038 Acres

**APPROVED:** FOR PRIVATE WATER and PRIVATE SEWERAGE SYSTEMS, IN CONFORMANCE WITH THE MASTER PLAN OF WATER AND SEWERAGE FOR HOWARD CO., HOWARD CO. DEPT. OF HEALTH and MENTAL HYGIENE.  
*Josephine Boyles* 6-23-87  
County Health Officer Date

**APPROVED:** HOWARD COUNTY OFFICE OF PLANNING AND ZONING.  
*Thomas L. Harris* 6-30-87  
Director Date

**APPROVED:** FOR STORM DRAINAGE SYSTEMS, and PUBLIC ROADS, HOWARD CO. DEPT. OF PUBLIC WORKS.  
*James J. [Signature]* 6/23/87  
Director Date

OWNER'S DEDICATION

I, (We) DALE Z. MAISEL owner(s) of the property shown and described hereon, hereby adopt this plan of subdivision and in consideration of the approval of this Final Plat by the Office of Planning and Zoning, establish the min. Bldg. Restriction Lines and grant unto Howard Co., Md., its successors and assigns, (1) the right to lay, construct and maintain sewers, drains, water pipes and other municipal utilities and services, in and under all roads and street rights-of-way and the specific easement areas shown hereon; (2) the right to require dedication for public use the beds of the streets and/or roads and floodplains and open space where applicable, and for good and other valuable consideration, hereby grant the right and option to Howard County, Md., to acquire the fee simple title to the beds of the streets and/or roads and floodplains, storm drainage facilities and open space where applicable; (3) the right to require dedication of waterways and drainage easements for the specific purpose of their construction, repair and maintenance; and (4) that no bldg. or similar structure of any kind shall be erected on or over the said easements and rights-of-way.  
Owner Dale Z. Maisel Date 1-17-86  
Witness [Signature] Date 1-17-86

SURVEYOR'S CERTIFICATE

I hereby certify that the Final Plat shown hereon is correct, that it is a subdivision of Part the lands conveyed by Dale Z. Maisel to Dale Z. Maisel deed dated July 15, 1980 and recorded in the Land Records of Howard County in Liber 1007 Folio 476, and that all monuments are in place, or will be in place prior to the acceptance of the streets in the subdivision by Howard Co. as shown, in accordance with the Annotated Code of Maryland, as amended.  
*James Carl Hudgins* PLS #96 1-17-86  
Surveyor Date

**NTT ASSOCIATES, INC.**  
SURVEYING & LAND DEVELOPMENT  
16205 Old Frederick Road  
Mt. Airy, Maryland 21111  
(301) 442-2031

RECORDED July 8, 1987 PLAT 7281  
HOWARD COUNTY

**BUCKSKIN WOODS SECTION 1 AREA 2**  
LOTS 39, 40 and 41  
A RESUBDIVISION OF LOT 19  
Tax Map 22  
Parcel 526  
Plat Ref. # 4733  
SIGNED FILE COPY  
5th Election District, Howard County, Md.  
Scale: 1" = 100' Date: Jan 13, 1985  
SS-14 F-51-05  
F-87-27