

Real Property Data Search

Search Result for HOWARD COUNTY

View Map		View GroundRent Redemption			View GroundRent Registration				
Tax Exempt:		Special Tax Recapture:							
Exempt Class:		NONE							
Account Identifier:		District - 01 Account Number - 178733							
Owner Information									
Owner Name:		SCHARF HAROLD V SCHARF DARLA			Use:		RESIDENTIAL		
Mailing Address:		5030 MONTGOMERY RD ELLCOTT CITY MD 21043-6719			Principal Residence:		YES		
					Deed Reference:		/00906/ 00089		
Location & Structure Information									
Premises Address:		5030 S MONTGOMERY RD ELLCOTT CITY 21043-0000			Legal Description:		1.396 A 5030 MONTGOMERY RD ELLCOTT CITY		
Map:	Grid:	Parcel:	Sub District:	Subdivision:	Section:	Block:	Lot:	Assessment Year:	Plat No:
0031	0014	0621		0000				2018	Plat Ref:
Special Tax Areas:					Town:		NONE		
					Ad Valorem:		104		
					Tax Class:				
Primary Structure Built		Above Grade Living Area		Finished Basement Area		Property Land Area		County Use	
1959		1,030 SF				1.3900 AC			
Stories	Basement	Type		Exterior	Full/Half Bath	Garage	Last Major Renovation		
1	YES	STANDARD UNIT		FRAME	1 full				
Value Information									
		Base Value		Value		Phase-in Assessments			
				As of		As of		As of	
				01/01/2018		07/01/2018		07/01/2019	
Land:		146,400		146,400					
Improvements		112,000		95,400					
Total:		258,400		241,800		241,800		241,800	
Preferential Land:		0						0	
Transfer Information									
Seller:				Date:		Price:			
Type:				Deed1:		Deed2:			
Seller:				Date:		Price:			
Type:				Deed1:		Deed2:			
Seller:				Date:		Price:			
Type:				Deed1:		Deed2:			
Exemption Information									
Partial Exempt Assessments:		Class		07/01/2018		07/01/2019			
County:		000		0.00					
State:		000		0.00					

APPLICATION

A 28077

SEWAGE DISPOSAL TESTING

P _____

STATE OF MARYLAND - DEPARTMENT OF HEALTH AND MENTAL HYGIENE

DISTRICT 1st

DATE 5/22/78

*Prep. 7/28/78
6/16/78 A.M.
9:30*

HOWARD COUNTY HEALTH DEPARTMENT
ENVIRONMENTAL HEALTH SERVICES
P. O. BOX 476, ELLICOTT CITY, MARYLAND 21043
TELEPHONE: 465-5000, EXT. 356

TO: THE COUNTY HEALTH OFFICER
ELLICOTT CITY, MARYLAND

I, HEREBY, APPLY FOR THE NECESSARY TEST IN ORDER TO CONSTRUCT (OR RECONSTRUCT) A SEWAGE DISPOSAL SYSTEM.

PROPERTY OWNER Mr. & Mrs. Victor Scharf

1663

ADDRESS 5030 Montgomery Road, Ellicott City, Md. PHONE 465-7026

PROPERTY LOCATION:

SUBDIVISION _____ LOT NO. _____

ROAD AND DESCRIPTION behind 5030 Montgomery Road

SIZE OF LOT 20,000 sq. ft. m/1 TYPE BLDG. 3 or 4 bedrooms

NUMBER OF BEDROOMS

IF NOT SINGLE RESIDENCE DESCRIBE _____

THE SYSTEM INSTALLED UNDER THIS APPLICATION IS ACCEPTABLE ONLY UNTIL PUBLIC FACILITIES BECOME AVAILABLE.

SIGNATURE OF APPLICANT *Staree Lee Scharf*

APPROVED BY _____ FOR _____ DATE _____

(KIND OF SYSTEM)

REJECTED BY _____ FOR _____ DATE _____

(KIND OF SYSTEM)

HOLD PENDING FURTHER TESTS _____ DATE _____

REASONS FOR REJECTION OR HOLDING 28 July 98 - Fails - poor soil throughout

(check 3 groundwater) (GLK)

THIS IS NOT A PERMIT

500/223

ROW FIRE SET

N 29° 45' W - 165.00'

INTENDING

SUBDIVISION


1.396 AC ±

N 67° 17' E - 462.00'



125'-

559° 12' W - 459.74'

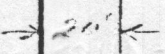

ROW FIRE SET

S 30° 21' E - 100.00'

MONTGOMERY ROAD

90'





GEORGE F. FRIZZELL & WIFE
LINE 25E T40N 200

BOUNDARY SURVEY
FOR CONVEYANCE OF REPER
TO

MRS. VICTOR SCHARR
5030 MONTGOMERY ROAD

5030 Montgomery Rd

27 July 78 (GLK)

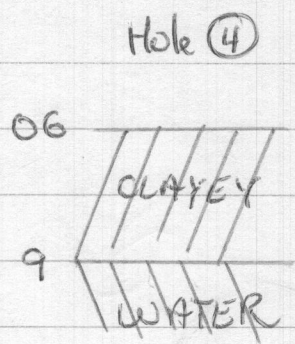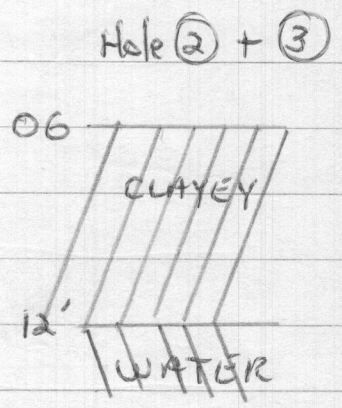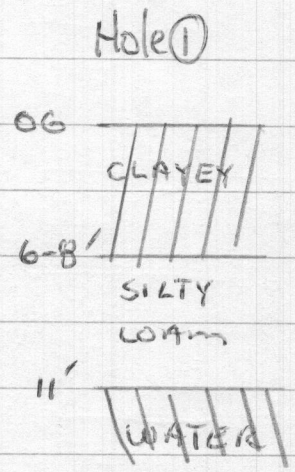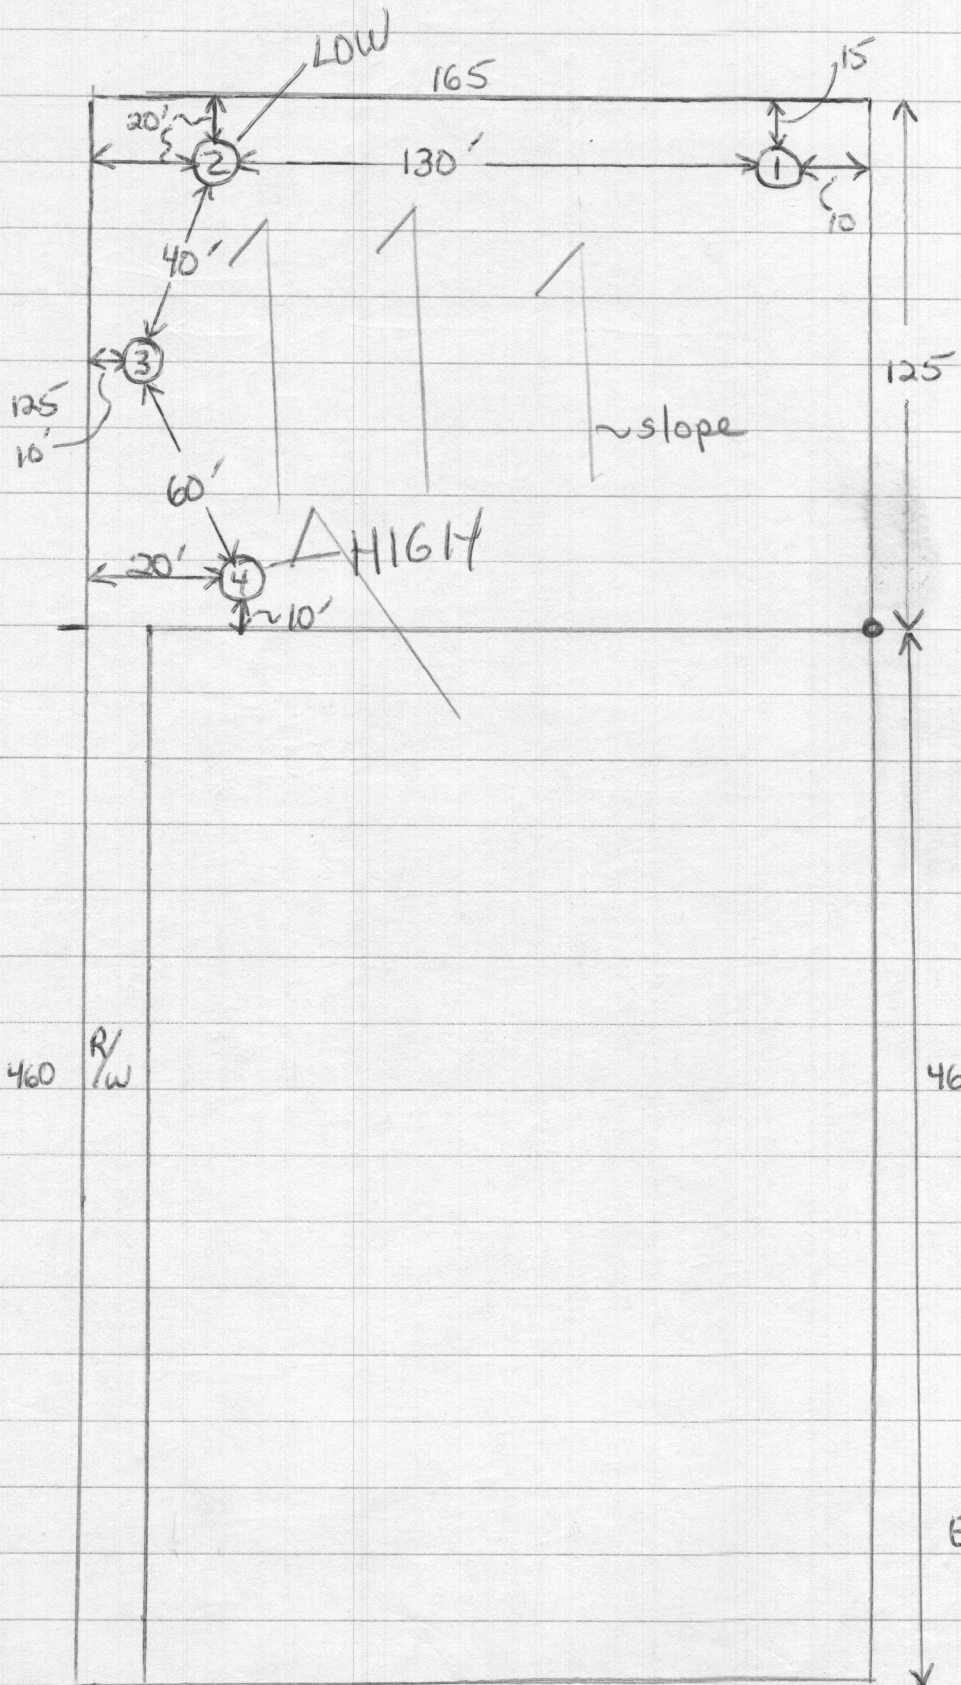

Elevation ④ ③ ② ≈ 3-4'

5030 Montgomery Rd