

Real Property Data Search (w1)

Search Result for HOWARD COUNTY

View Map		View GroundRent Redemption			View GroundRent Registration				
Tax Exempt:		Special Tax Recapture:							
Exempt Class:		NONE							
Account Identifier:		District - 04 Account Number - 330811							
Owner Information									
Owner Name:		WEEMS WALTER W			Use:		RESIDENTIAL		
Mailing Address:		1145 HOODS MILL RD COOKSVILLE MD 21723-9701			Principal Residence:		NO		
					Deed Reference:		/01266/ 00152		
Location & Structure Information									
Premises Address:		1125 ROUTE 97 RD COOKSVILLE 21723-0000			Legal Description:		P/O LOT 5 5.6539 A 1125 ROUTE 97 WOODBINE		
Map:	Grid:	Parcel:	Sub District:	Subdivision:	Section:	Block:	Lot:	Assessment Year:	Plat No:
0008	0006	0242		0000			5	2017	Plat Ref:
Special Tax Areas:				Town:		NONE			
				Ad Valorem:		100			
				Tax Class:					
Primary Structure Built		Above Grade Living Area		Finished Basement Area		Property Land Area		County Use	
						5.6500 AC			
Stories	Basement	Type	Exterior	Full/Half Bath	Garage	Last Major Renovation			
Value Information									
			Base Value	Value	Phase-in Assessments				
				As of	As of		As of		
				01/01/2017	07/01/2018		07/01/2019		
Land:		214,800		194,800					
Improvements		0		0					
Total:		214,800		194,800		194,800		194,800	
Preferential Land:		0						0	
Transfer Information									
Seller: WEEMS WALTER W & WF				Date: 06/29/1984		Price: \$30,000			
Type: NON-ARMS LENGTH OTHER				Deed1: /01266/ 00152		Deed2:			
Seller:				Date:		Price:			
Type:				Deed1:		Deed2:			
Seller:				Date:		Price:			
Type:				Deed1:		Deed2:			
Exemption Information									
Partial Exempt Assessments:		Class		07/01/2018		07/01/2019			
County:		000		0.00					
State:		000		0.00					
Municipal:		000		0.00 0.00		0.00 0.00			
Tax Exempt:		Special Tax Recapture:							
Exempt Class:		NONE							
Homestead Application Information									

Homestead Application Status: No Application


Homeowners' Tax Credit Application Information

Homeowners' Tax Credit Application Status: No Application **Date:**

1. This screen allows you to search the Real Property database and display property records.
2. Click **here** for a glossary of terms.
3. Deleted accounts can only be selected by Property Account Identifier.
4. The following pages are for information purpose only. The data is not to be used for legal reports or documents. While we have confidence in the accuracy of these records, the Department makes no warranties, expressed or implied, regarding the information.



John E. Peirish
12/4/69
Claude Skuse

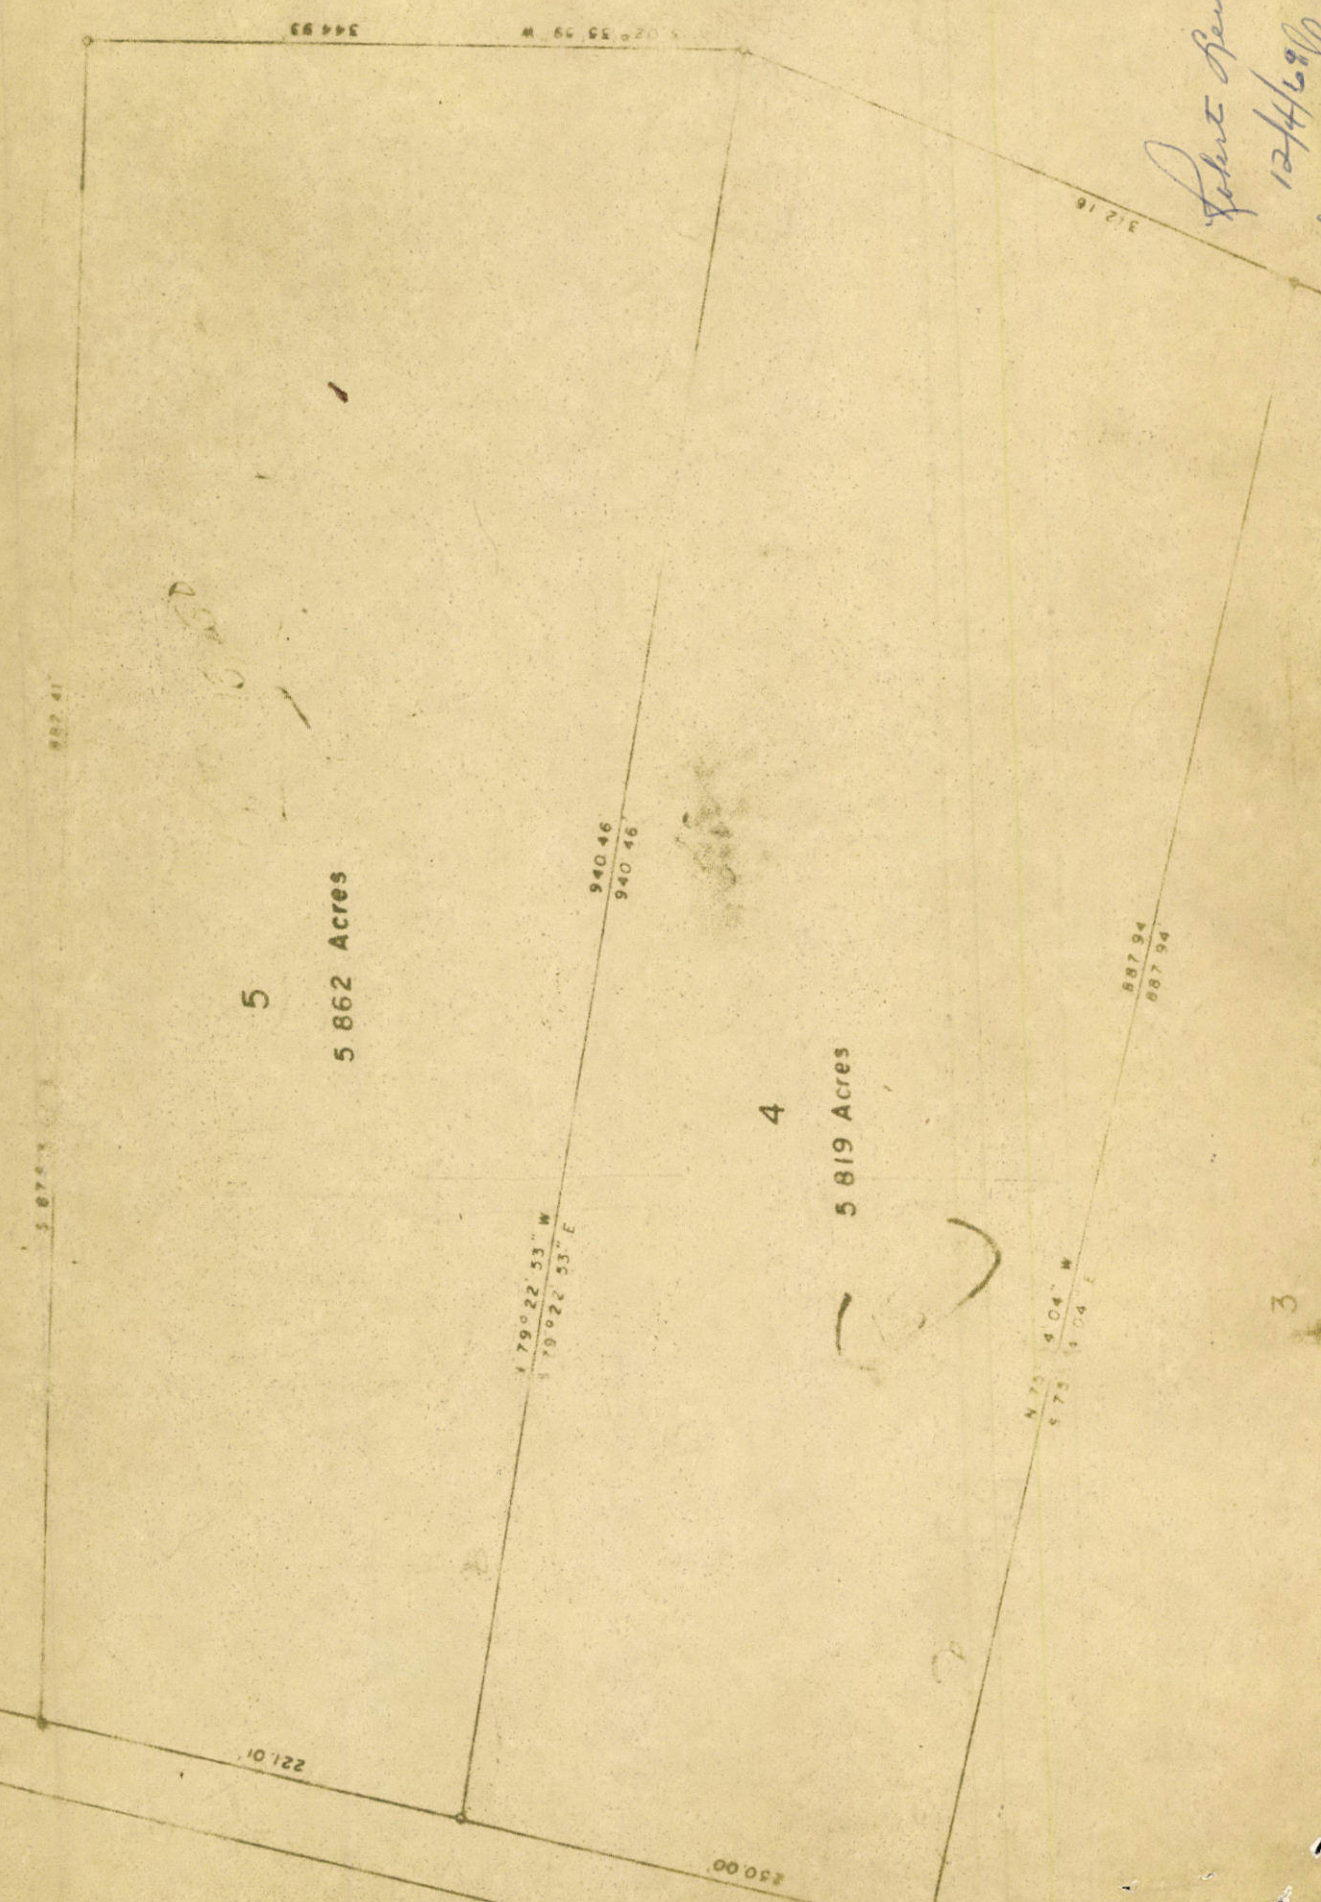

5
5.862 Acres

4
5.819 Acres

3
5.000 Acres

S 79° 22' 53" W
S 79° 22' 53" E

S 73° 4' 04" W
S 73° 4' 04" E

940.46
940.46

887.94
887.94

221.01

230.00

1336.01

97

346.94

346.94

312.10

882.41

5.875

APPLICATION

Weems

A 18139

P _____

SEWAGE DISPOSAL TESTING

STATE OF MARYLAND - DEPARTMENT OF HEALTH AND MENTAL HYGIENE

HOWARD COUNTY HEALTH DEPARTMENT *Septic Tank - 1250yd.* DISTRICT 4th
ENVIRONMENTAL HEALTH SERVICES
P. O. BOX 476, ELLICOTT CITY, MARYLAND 21043 *Drain Field - Three (3)* DATE 3/23/73
TELEPHONE: 465-5000, EXT. 356

4-12' Lines
4/13/73
9:30

*trenches - 60ft long - 3 ft wide. Dig trenches 6ft deep
and use 2 1/2 of gravel beneath pipe. Locate drain field
between 110 and 125 ft. from front lot line and 95 and 125-
ft. from left side line as seen from Rt. 97.*

TO: THE COUNTY HEALTH OFFICER
ELLICOTT CITY, MARYLAND

I, HEREBY, APPLY FOR THE NECESSARY TEST IN ORDER TO CONSTRUCT (OR RECONSTRUCT) A SEWAGE DISPOSAL SYSTEM.

PROPERTY OWNER Robert R. Levick (*New Owner*) *(Contract Purchaser - Mr. Weems, Marriottsville, Md.)*
ADDRESS Cooksville, Md. PHONE 531-5458
Any questions call Louise Adams,

PROPERTY LOCATION:

SUBDIVISION _____ LOT NO. 5

ROAD AND DESCRIPTION Route 25 97

SIZE OF LOT ~~5.862 acres~~ 5.862 acres TYPE BLDG. 3 or 4 bedrooms
NUMBER OF BEDROOMS

IF NOT SINGLE RESIDENCE DESCRIBE _____

THE SYSTEM INSTALLED UNDER THIS APPLICATION IS ACCEPTABLE ONLY UNTIL PUBLIC FACILITIES BECOME AVAILABLE.

SIGNATURE OF APPLICANT /s/ Louise H. Adams


APPROVED BY Robert V. Tane FOR Drain Field DATE 4/16/73
(KIND OF SYSTEM)

REJECTED BY _____ FOR _____ DATE _____
(KIND OF SYSTEM)

HOLD PENDING FURTHER TESTS _____ DATE _____

REASONS FOR REJECTION OR HOLDING _____

THIS IS NOT A PERMIT

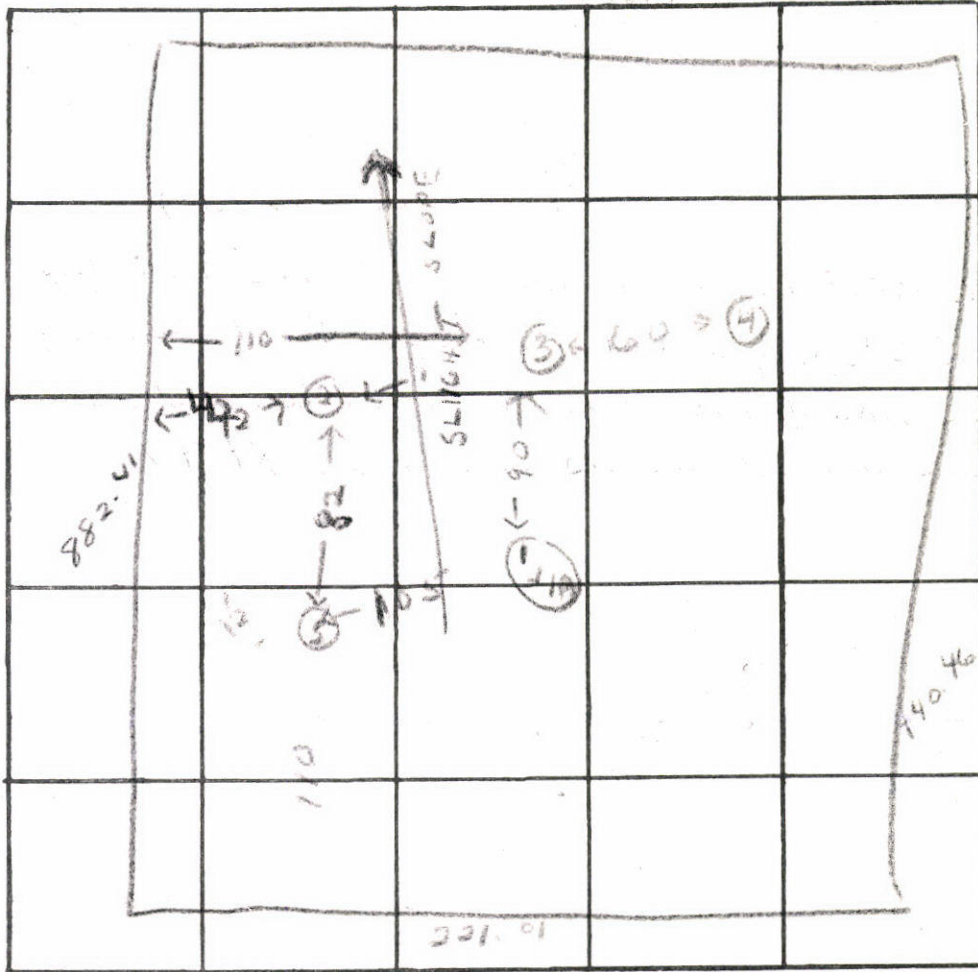

INDICATE NORTH. - NAME ADJOINING ROADWAY AS BASE LINE.

DATE	TEST NO.	DEPTH	PRE-WET		TEST - 1" DROP		TIME	
			START	STOP	START	STOP		
4/13/23	1	4 1/2	2 ³⁷	2 ⁴⁵	2 ⁴⁵	2 ⁵⁶	11 min	
	2	3 1/2	2 ⁴⁵	3 ⁰⁷	3 ⁰⁷	3 ⁴⁰	33 min	
	3	3 1/2	2 ⁵⁷	3 ⁰⁵	3 ⁰⁵	3 ²⁰	15 min	
	1A	9 1/2	Water	-				
	2A	10 ft	Water	-				
	4	3 1/2	3 ¹³	3 ¹⁷	3 ¹⁷	3 ²⁴	72 min	
	5	10 ft	Water	-			had soil from 4 ft	
			All holes have best soil starting at 4 1/2 ft.					

REMARKS _____

TYPE OF SOIL _____

TESTED BY RT ALSO PRESENT: _____