

1. This screen allows you to search the Real Property database and display property records.
2. Click [here](#) for a glossary of terms.
3. Deleted accounts can only be selected by Property Account Identifier.
4. The following pages are for information purpose only. The data is not to be used for legal reports or documents. While we have confidence in the accuracy of these records, the Department makes no warranties, expressed or implied, regarding the information.

APPLICATION

3/1/84
1:30 p.m.
Jed.

SEWAGE DISPOSAL TESTING

STATE OF MARYLAND - DEPARTMENT OF HEALTH AND MENTAL HYGIENE

HOWARD COUNTY HEALTH DEPARTMENT
ENVIRONMENTAL HEALTH SERVICES

P. O. BOX 476 ELLICOTT CITY, MARYLAND 21043
TELEPHONE: 992-2330

A _____
A 33579

DISTRICT 1

DATE 2/23/84

TO: THE COUNTY HEALTH OFFICER
ELLICOTT CITY, MARYLAND

I, HEREBY, APPLY FOR THE NECESSARY TEST IN ORDER TO CONSTRUCT (OR RECONSTRUCT) A SEWAGE DISPOSAL SYSTEM.

PROPERTY OWNER James & Sharon Hickey
ADDRESS ~~6052 Hunt Club Road~~
7230 Montgomery Rd #3C
Bella Md, 21227 PHONE 242-4112 work
796-7252 -home
PROPERTY LOCATION: _____

SUBDIVISION _____ LOT NO. _____

ROAD AND DESCRIPTION 6052 Hunt Club Road - off Hunt Club Rd. - off Wash. Blvd.
first driveway on left go back around bend until you see barn fenced in
area with horses

SIZE OF LOT 4 acres TYPE BLDG. 3
(NUMBER OF BEDROOMS)

THE SYSTEM INSTALLED UNDER THIS APPLICATION IS ACCEPTABLE ONLY UNTIL PUBLIC FACILITIES BECOME AVAILABLE. I FULLY UNDERSTAND THE

FEE CONNECTED WITH THE FILING OF THIS PERC TEST APPLICATION IS NON-REFUNDABLE UNDER ANY CIRCUMSTANCES. I ALSO AGREE TO COMPLY

WITH ALL M.O.S.H.A. REQUIREMENTS IN TESTING THIS LOT. Sharon W. Hickey
(SIGNATURE OF APPLICANT)

APPROVED BY _____ FOR _____ DATE _____

REJECTED BY _____ FOR _____ DATE _____

HOLD PENDING FURTHER TESTS _____ DATE _____

REASONS FOR REJECTION OR HOLDING 3/1/84 - DIE MORE SLOW PERC R/H

THIS IS NOT A PERMIT

APPLICATION

SEWAGE DISPOSAL TESTING

STATE OF MARYLAND - DEPARTMENT OF HEALTH AND MENTAL HYGIENE

A _____

P 33589

HOWARD COUNTY HEALTH DEPARTMENT
ENVIRONMENTAL HEALTH SERVICES

P. O. BOX 476 ELLICOTT CITY, MARYLAND 21043
TELEPHONE: 992-2330

DISTRICT 1

DATE 2/23/80

TO: THE COUNTY HEALTH OFFICER
ELLICOTT CITY, MARYLAND

I, HEREBY, APPLY FOR THE NECESSARY TEST IN ORDER TO CONSTRUCT (OR RECONSTRUCT) A SEWAGE DISPOSAL SYSTEM.

PROPERTY OWNER James & Sharon Hickey

ADDRESS ~~6052 Hunt Club Road~~ PHONE ~~796-7252~~ home
7230 Montgomery Rd # 3C 242 4112 work
Bath Yrd 21227

PROPERTY LOCATION: _____

SUBDIVISION _____ LOT NO. _____

ROAD AND DESCRIPTION 6052 Hunt Club Road - off Hunt Club Rd - off Wash Blvd

first driveway on left go back around bend until you see born fenced in
area with houses

SIZE OF LOT 4 acres TYPE BLDG. 3
(NUMBER OF BEDROOMS)

THE SYSTEM INSTALLED UNDER THIS APPLICATION IS ACCEPTABLE ONLY UNTIL PUBLIC FACILITIES BECOME AVAILABLE. I FULLY UNDERSTAND THE FEE CONNECTED WITH THE FILING OF THIS PERC TEST APPLICATION IS NON-REFUNDABLE UNDER ANY CIRCUMSTANCES. I ALSO AGREE TO COMPLY WITH ALL M.O.S.H.A. REQUIREMENTS IN TESTING THIS LOT.

Sharon W. Hickey
(SIGNATURE OF APPLICANT)

APPROVED BY _____ FOR _____ DATE _____

REJECTED BY _____ FOR _____ DATE _____




HOLD PENDING FURTHER TESTS _____ DATE _____

REASONS FOR REJECTION OR HOLDING _____

THIS IS NOT A PERMIT

SEC PLAT

① SOIL PROFILE

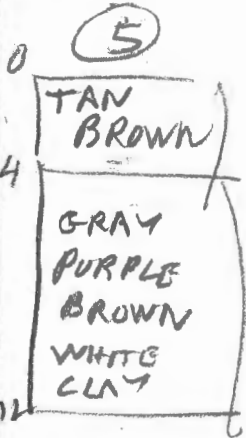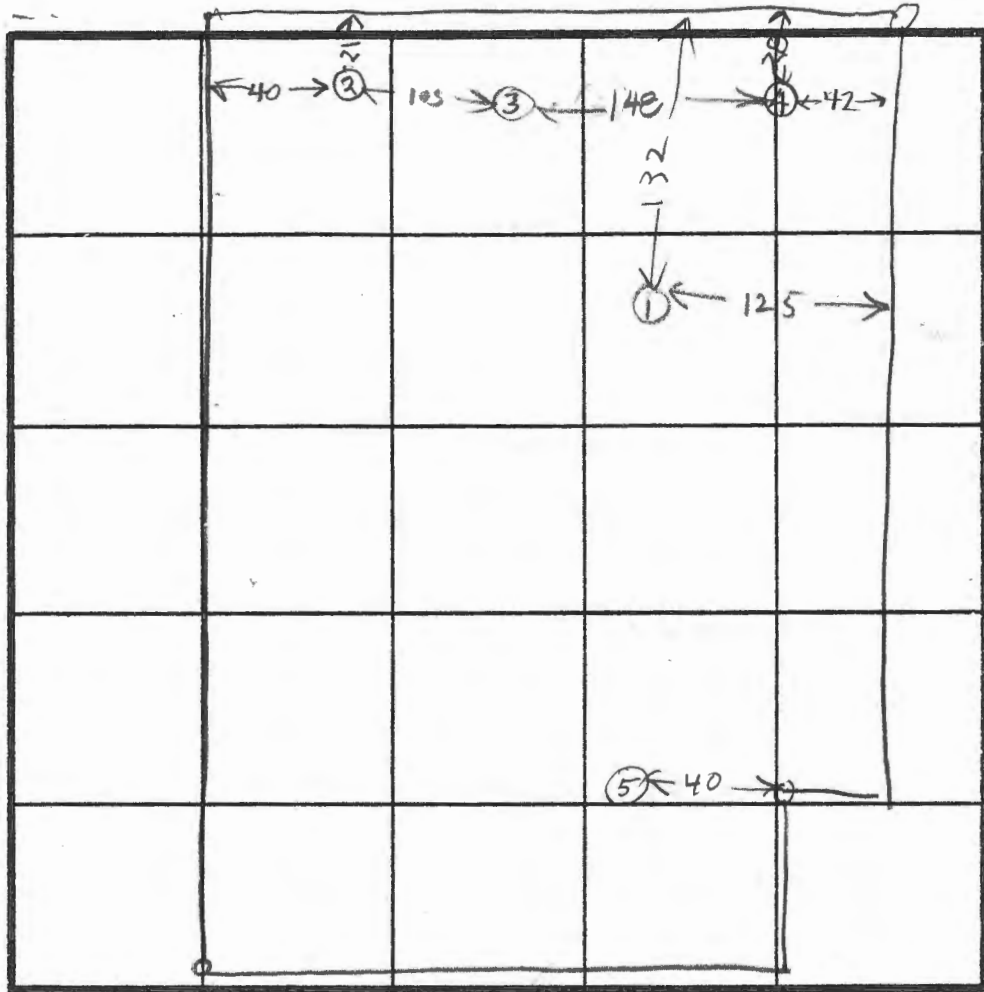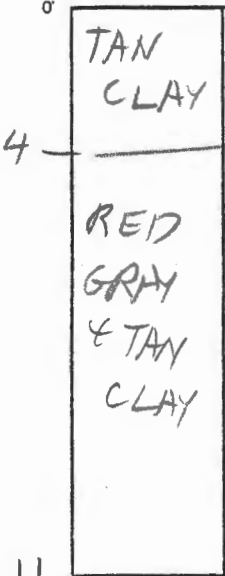

INDICATE NORTH - NAME ADJOINING ROADWAY AS BASE LINE.



DATE	TEST NO.	DEPTH	PRE-WET		TEST - 1" DROP		TIME
			START	STOP	START	STOP	
8/1/04	4S	4 1/2	2 34	311	little perc		
	4V	10	LOOKS	BAD			
	3D	8	2 53	327	little perc		
	3V	10	LOOKS	BAD			
	2D	7 1/2	317	342	little perc		
	2V	7 1/2	LOOKS	BAD			
	1V	11	LOOKS	BAD			
	5V	12	LOOKS	BAD			

REMARKS _____

TYPE OF SOIL _____


TESTED BY

RAYMOND HOWE

ALSO PRESENT

WARREN LOWE } BACK
 GEORGE LOWE } HOE
 SHARON HICKET OWNER

S 70° 07' W 352.83'

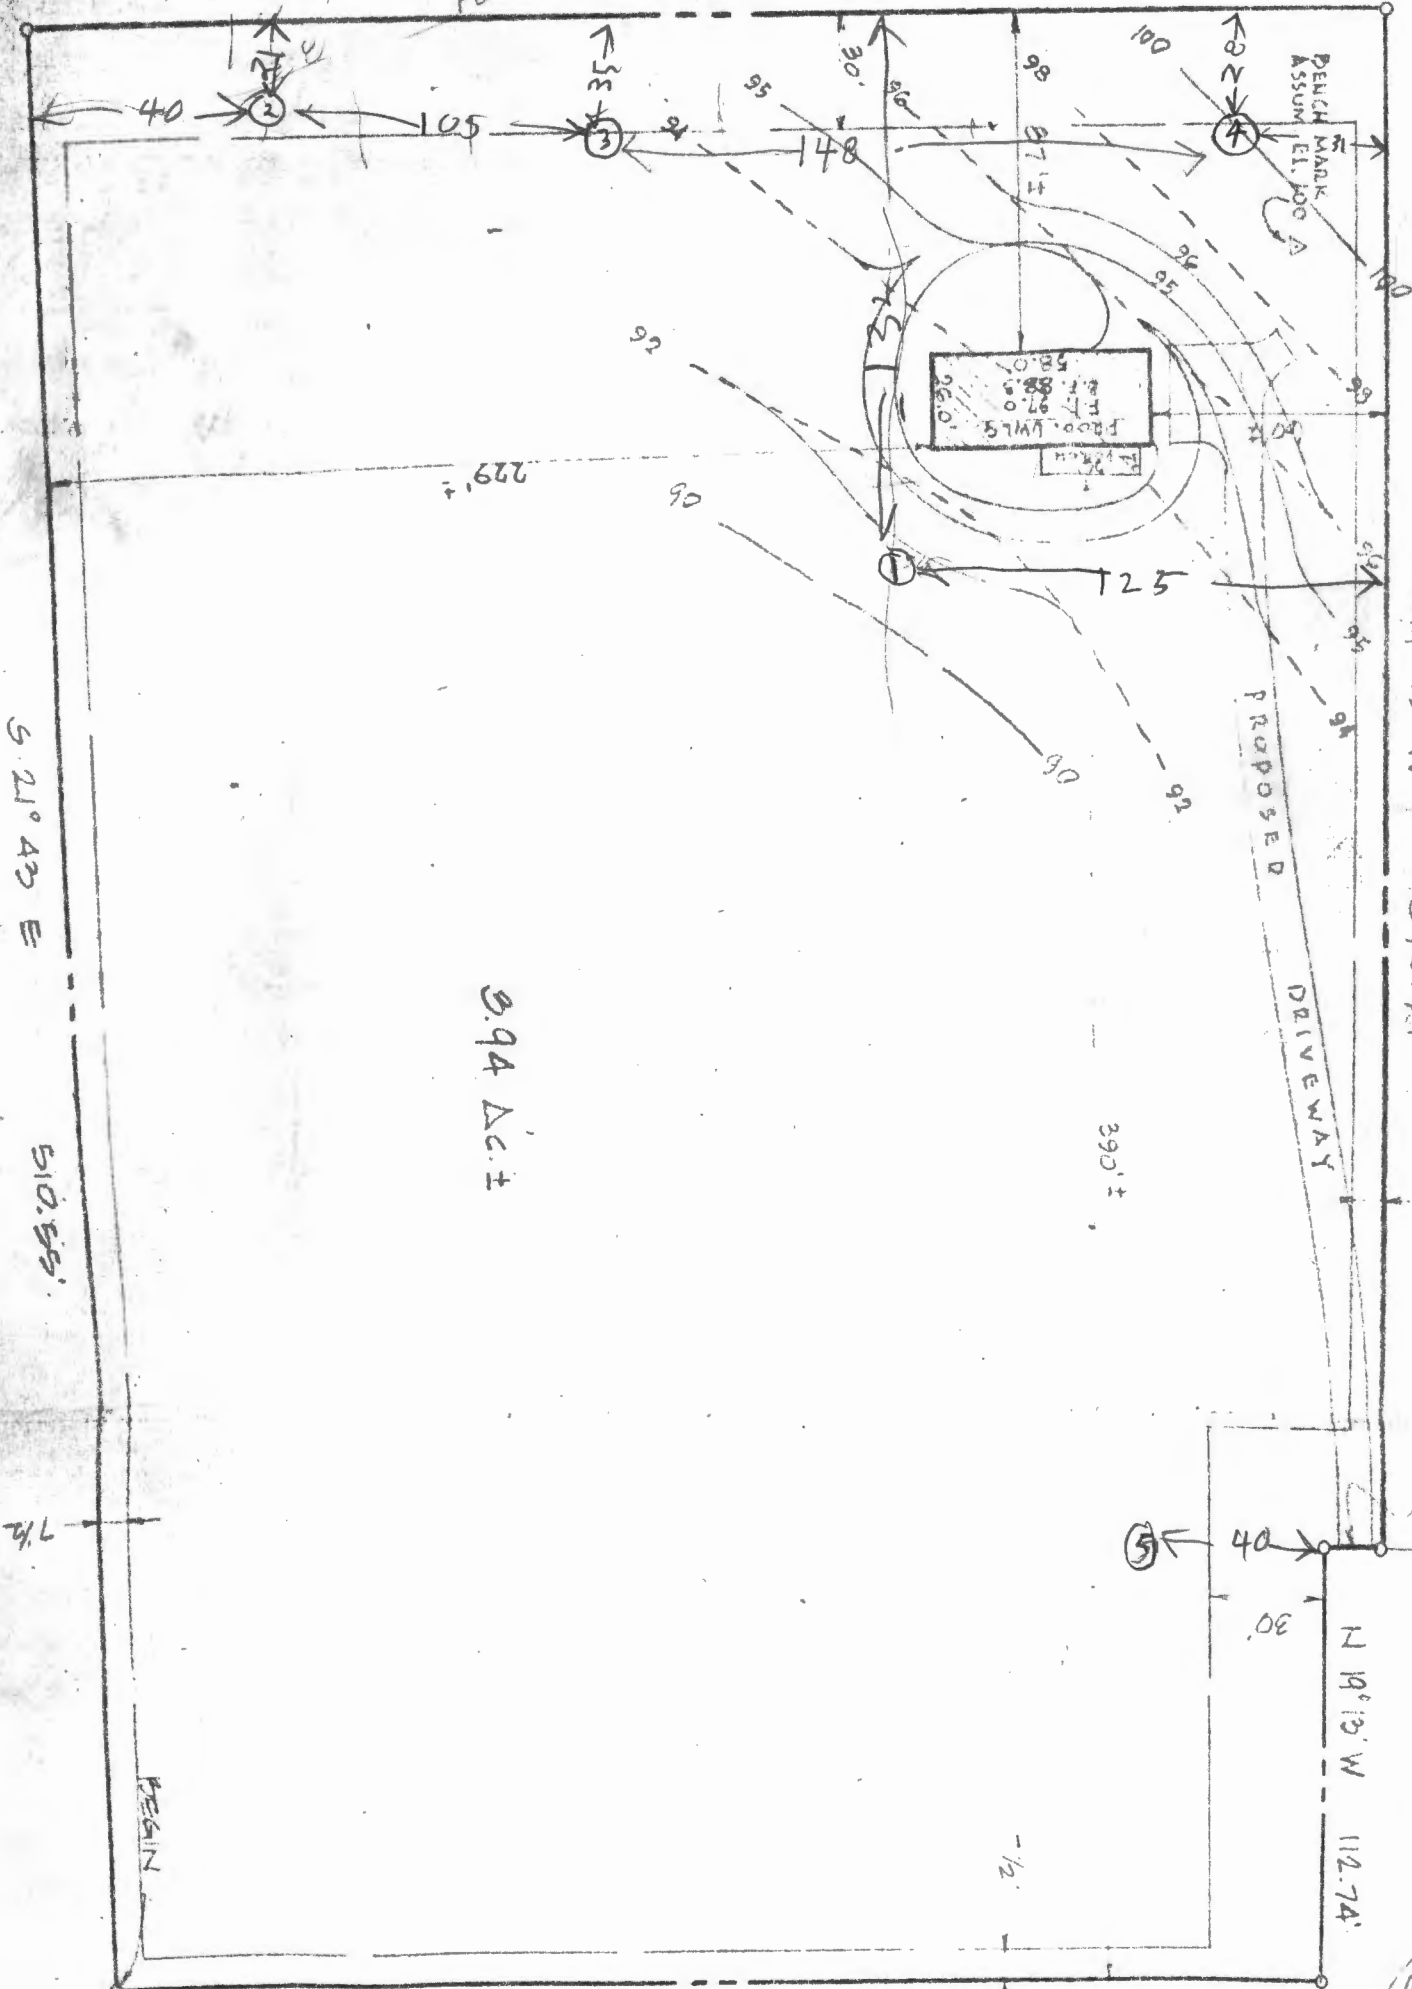

S 21° 43' E 510.53'

3.94 AC. ±

N 19° 13' W 396.74'

N 19° 13' W 112.74'

N 69° 55' E 315.91'

TO BALTIMORE WASHINGTON
BLVD.

PLOT PLAN

PROPERTY OF MR. & MRS. J.W.

12/29/53

300/111
PLOT PLAN (12/29/53)