

Real Property Data Search

Search Result for HOWARD COUNTY

View Map		View GroundRent Redemption			View GroundRent Registration				
Tax Exempt:		Special Tax Recapture:							
Exempt Class:		NONE							
Account Identifier:		District - 05 Account Number - 341191							
Owner Information									
Owner Name:		LI MING ZHAO CUIWEI			Use:		RESIDENTIAL		
Mailing Address:		6457 HAVILAND MILL RD CLARKSVILLE MD 21029-			Principal Residence:		YES		
					Deed Reference:		/15392/ 00206		
Location & Structure Information									
Premises Address:		6457 HAVILAND MILL RD CLARKSVILLE 21029-0000			Legal Description:		1.003 A 6457 HAVILAND MILL RD CLARKSVILLE		
Map:	Grid:	Parcel:	Sub District:	Subdivision:	Section:	Block:	Lot:	Assessment Year:	Plat No:
0034	0013	0257		0000				2017	Plat Ref:
Special Tax Areas:				Town:		NONE			
				Ad Valorem:		100			
				Tax Class:					
Primary Structure Built		Above Grade Living Area		Finished Basement Area		Property Land Area		County Use	
2014		4,182 SF		1200 SF		1.0000 AC			
Stories	Basement	Type	Exterior	Full/Half Bath	Garage	Last Major Renovation			
2	YES	STANDARD UNIT	FRAME	4 full/ 1 half	1 Attached				
Value Information									
		Base Value		Value		Phase-in Assessments			
				As of		As of		As of	
				01/01/2017		07/01/2018		07/01/2019	
Land:		225,600		225,600					
Improvements		463,400		574,200					
Total:		689,000		799,800		762,867		799,800	
Preferential Land:		0						0	
Transfer Information									
Seller: DH LAND LLC				Date: 12/20/2013		Price: \$420,000			
Type: ARMS LENGTH VACANT				Deed1: /15392/ 00206		Deed2:			
Seller: NORTHERN LLLP				Date: 02/27/2013		Price: \$303,000			
Type: ARMS LENGTH VACANT				Deed1: /14718/ 00239		Deed2:			
Seller: ADAMS LOUISE H				Date: 07/31/1997		Price: \$67,500			
Type: ARMS LENGTH VACANT				Deed1: /04026/ 00513		Deed2:			
Exemption Information									
Partial Exempt Assessments:		Class		07/01/2018		07/01/2019			
County:		000		0.00					
State:		000		0.00					
Municipal:		000		0.00 0.00		0.00 0.00			
Tax Exempt:		Special Tax Recapture:							

APPLICATION

PERCOLATION TESTING

A 57018 D

P _____

HOWARD COUNTY HEALTH DEPARTMENT
BUREAU OF ENVIRONMENTAL HEALTH
3525-H ELLICOTT MILLS DRIVE/ELLICOTT CITY, MARYLAND 21043
TELEPHONE: 313-2640

EXISTING
RECORDED
LOT

DISTRICT 5

DATE 29-96

+ 3 LOT SUBDIVISION
AD JOINING

TO: THE COUNTY HEALTH OFFICER
ELLICOTT CITY, MARYLAND

I HEREBY APPLY FOR THE NECESSARY TEST PRIOR TO APPLICATION FOR PERMIT TO CONSTRUCT (OR RECONSTRUCT) A SEWAGE DISPOSAL SYSTEM.

PROPERTY OWNER Highland Development Corporation

ADDRESS Po Box 228 CLARKSVILLE MD 21029 PHONE 531-5534

AGENT OR PROSPECTIVE BUYER Richard Bennett

ADDRESS 9 Ave PHONE 9 Ave

PROPERTY LOCATION:

SUBDIVISION Harris Property LOT NO. 4

ROAD AND DESCRIPTION 6453 HAVILAND Mill Road
CLARKSVILLE MD

TAX MAP 34 PARCEL # 257

SIZE OF LOT 1 Acre TYPE BLDG. Single Family
(SINGLE FAMILY DWELLING OR COMMERCIAL)

THE SYSTEM INSTALLED UNDER THIS APPLICATION IS ACCEPTABLE ONLY UNTIL PUBLIC FACILITIES BECOME AVAILABLE. I FULLY UNDERSTAND THE FEE CONNECTED WITH THE FILING OF THIS PERC TEST APPLICATION IS NON-REFUNDABLE UNDER ANY CIRCUMSTANCES. I ALSO AGREE TO COMPLY WITH ALL M.O.S.H.A. REQUIREMENTS IN TESTING THIS LOT. Richard Bennett
(SIGNATURE OF APPLICANT)

APPROVED BY _____ FOR _____ DATE _____

DISAPPROVED BY _____ FOR _____ DATE _____

HOLD PENDING FURTHER TESTS _____

REASONS FOR REJECTION OR HOLDING PERC OK - HOLD FOR PLAT 9/4/96 MR

PERCOLATION TEST PLAT/PRELIMINARY PLAT - TITLE OR I.D. # _____ DATE _____


SITE DEVELOPMENT PLAN/FINAL PLAT - TITLE OR I.D. # _____ DATE _____

THIS IS NOT A PERMIT

A57018D
COUNTY #

SOIL PROFILE

0' ALL
brn sa cl
1 in
brn sa mica lm
10-15% saprolite & other frags

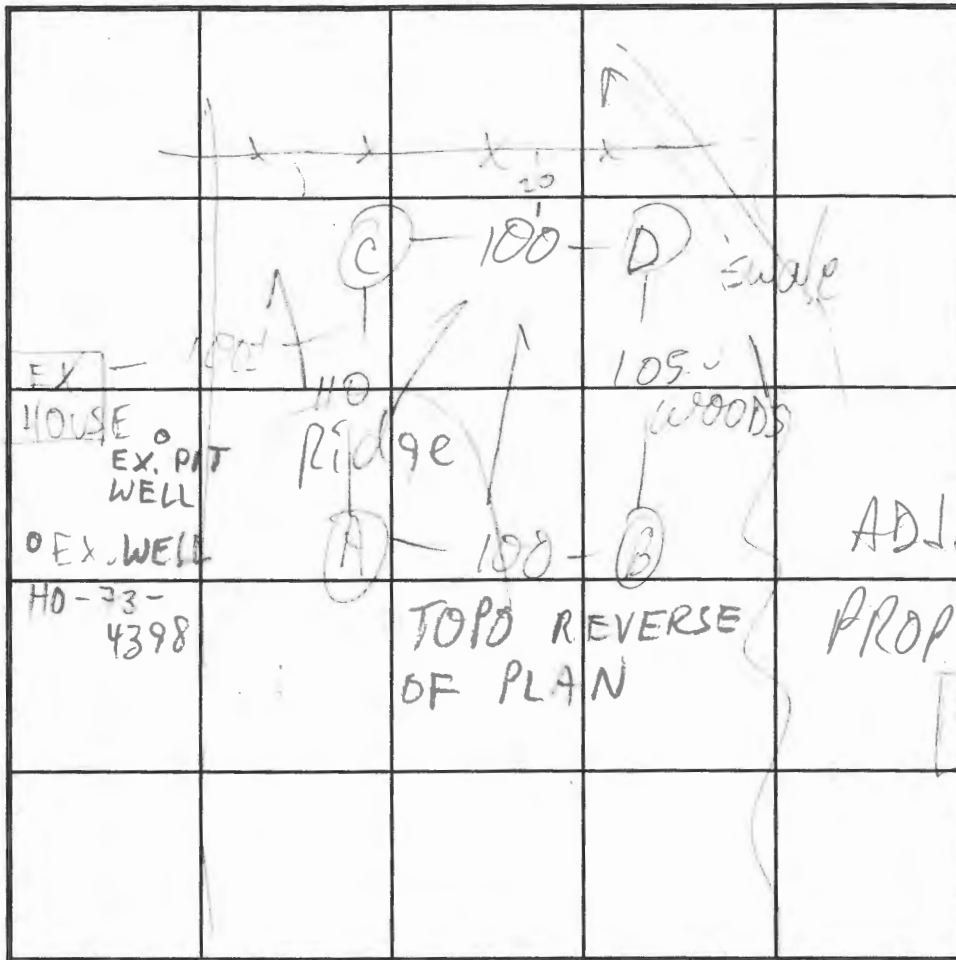

SOIL PROFILE

0'

HAV. MILL RD INDICATE NORTH - NAME ADJOINING ROADWAY AS BASE LINE.

DATE	TEST NO.	DEPTH	PRE-WET		TEST - 1" DROP		TIME
			START	STOP	START	STOP	
8/12/96	A S	3	9:29	9:30	9:30	9:32	Z
	A V	12	see profile				
	B S	2 1/2	9:34	9:35	9:35	9:37	Z
	B M	6	9:34	9:35	9:35	9:37	Z
	A V	12	see profile				
	D S	3'3"	9:41	9:42	9:43	9:45	FAST Z
	D V	12	see profile				
	C S	3	9:46	9:47	9:47	9:49	Z
	C V	12	see profile				

REMARKS _____

TYPE OF SOIL _____

TESTED BY M. Rifkin ALSO PRESENT Demmitt, J. Allen

TRENCH DESIGN DATA: AVERAGE PERCOLATION TIME 2 TRENCH WIDTH 2

INLET DEPTH 3 MAXIMUM BOTTOM DEPTH 7 SQ. FT./BEDROOM 180

C1 7843

SEQUENCE NO. (MDE USE ONLY)

STATE OF MARYLAND WELL COMPLETION REPORT

THIS REPORT MUST BE SUBMITTED WITHIN 45 DAYS AFTER WELL IS COMPLETED.

(THIS NUMBER IS TO BE PUNCHED IN COLS. 3-6 ON ALL CARDS)

COUNTY NUMBER A57018D

ST/CO USE ONLY DATE Received

DATE WELL COMPLETED 102896

Depth of Well 440 (TO NEAREST FOOT)

PERMIT NO. FROM "PERMIT TO DRILL WELL" A0-94-0935

OWNER Semmit Richard last name first name HAYLAND Mill rd TOWN Clarksville SUBDIVISION HARRIS PROP SECTION LOT 4 Par 257

WELL LOG table with columns: DESCRIPTION, FEET (FROM, TO), check if water bearing. Includes entries for Sand (0-59) and Gray Mica Rock (59-440).

GROUTING RECORD form including: WELL HAS BEEN GROUTED (Y), TYPE OF GROUTING MATERIAL (CEMENT CM, BENTONITE CLAY BC), NO. OF BAGS (20), NO. OF POUNDS (1880), GALLONS OF WATER (120), DEPTH OF GROUT SEAL (0-56).

CASING RECORD form including: casing types insert appropriate code below (ST for STEEL, CO for CONCRETE, PL for PLASTIC, OT for OTHER).

MAIN CASING TYPE form including: Nominal diameter top (main) casing (6), Total depth of main casing (62).

OTHER CASING (if used) form including: diameter inch, depth (feet) from to.

SCREEN RECORD form including: screen type or open hole insert appropriate code below (ST for STEEL, BR for BRASS BRONZE, PL for PLASTIC, HO for OPEN HOLE, OT for OTHER).

WELL HYDROFRACTURED Y (yes) N (no)

CIRCLE APPROPRIATE LETTER: A (well abandoned and sealed), E (electric log obtained), P (test well converted to production well).

I HEREBY CERTIFY THAT THIS WELL HAS BEEN CONSTRUCTED IN ACCORDANCE WITH COMAR 26.04.04 "WELL CONSTRUCTION" AND IN CONFORMANCE WITH ALL CONDITIONS STATED IN THE ABOVE CAPTIONED PERMIT...

TYPE: MWD/MSD/MGD DRILLERS LIC. NO. 24

DRILLERS SIGNATURE Joseph L. Marple LIC. NO.

SITE SUPERVISOR (sign. of driller or journeyman responsible for sitework if different from permittee)

DEPTH (nearest ft.) table with rows E1, S2, E3 and columns for depth measurements (8, 9, 11, 15, 17, 21, 23, 24, 26, 30, 32, 36, 38, 39, 41, 45, 47, 51).


GRAVEL PACK IF WELL DRILLED WAS FLOWING WELL INSERT F IN BOX 68

MDE USE ONLY (NOT TO BE FILLED IN BY DRILLER) T (E.R.O.S.) W Q

TELESCOPE CASING LOG INDICATOR OTHER DATA

PUMPING TEST form including: HOURS PUMPED (6), PUMPING RATE (001.3), METHOD USED TO MEASURE PUMPING RATE (Bucket), WATER LEVEL (distance from land surface) BEFORE PUMPING (77) ft., WHEN PUMPING (377) ft., TYPE OF PUMP USED (for test) S (submersible).

PUMP INSTALLED form including: DRILLER WILL INSTALL PUMP YES (NO), IF DRILLER INSTALLS PUMP, THIS SECTION MUST BE COMPLETED FOR ALL WELLS, TYPE OF PUMP INSTALLED PLACE (A,C,J,P,R,S,T,O) IN BOX 29, CAPACITY: GALLONS PER MINUTE, PUMP HORSE POWER, PUMP COLUMN LENGTH, CASING HEIGHT (circle appropriate box and enter casing height) above/below LAND SURFACE.

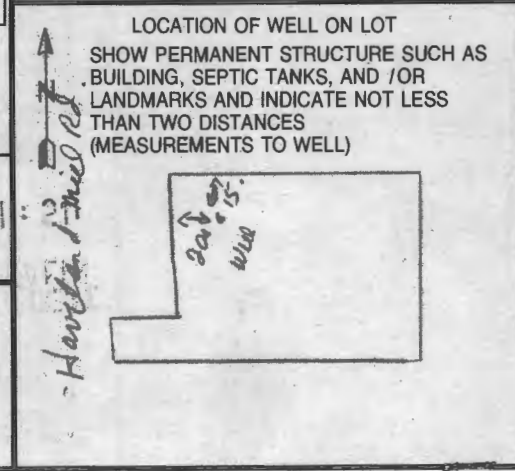

B 1 **4614** SEQUENCE NO. (MDE USE ONLY)

(THIS NUMBER IS TO BE PUNCHED IN COLS. 3-6 ON ALL CARDS)

STATE OF MARYLAND
PERMIT TO DRILL WELL
please print or type

STATE PERMIT NUMBER
HO-94-0935
fill in this form completely

Date Received (APA) **09/17/96**

OWNER INFORMATION

Demmitt Last Name
Richard Owner First Name
PO BOX 228 Street or RFD
CLARKSVILLE Town
MD 21029 State Zip

B 3 **LOCATION OF WELL**

HOWARD COUNTY
HARRIS PROPERTY SUBDIVISION
SECTION **4** LOT **4**
CLARKSVILLE NEAREST TOWN
MILES FROM TOWN (enter 0 if in town) **4** MI

DRILLER INFORMATION CIRCLE: MSD/MGD/MWD

Joseph L. Mayne Driller's Name
Joseph L. Mayne Well Drilling Firm Name
5512 Ridge Rd Mt. Airy, Md. 21771 Address
Joseph L. Mayne Signature
9/17/96 Date

B 4 **DIRECTION OF WELL FROM TOWN (CIRCLE BOX)**

Hamiland mill Road NEAR WHAT ROAD
ON WHICH SIDE OF ROAD (CIRCLE APPROPRIATE BOX) **WEST**
125 DISTANCE FROM ROAD
ENTER FT OR MI **FT**
TAX MAP: **34** BLK: **13** PARCEL **257**

B 2 **WELL INFORMATION**

APPROX. PUMPING RATE (GAL. PER MIN.) **5**
AVERAGE DAILY QUANTITY NEEDED (GAL. PER DAY) **500**

USE FOR WATER (CIRCLE APPROPRIATE BOX)

HOME (SINGLE OR DOUBLE HOUSEHOLD UNIT ONLY)
 FARMING (LIVESTOCK WATERING & AGRICULTURAL IRRIGATION)
 INDUSTRIAL, COMMERCIAL, STATE AND FEDERAL GOV. OTHER (REQUIRES APPROPRIATION PERMIT)
 PUBLIC OR PRIVATE WATER COMPANY (REQUIRES APPROPRIATION PERMIT AND STATE HEALTH DEPARTMENT APPROVAL)
 TEST, OBSERVATION, MONITORING (MAY REQUIRE APPROPRIATION PERMIT)

NOT TO BE FILLED IN BY DRILLER
HEALTH DEPARTMENT APPROVAL

Howard COUNTY NAME
A57018D COUNTY NO.
STATE SIGNATURE **Mark E. Ripkin** DATE ISSUED **10/2/97**
NORTH GRID **495000** EAST GRID **0803000**

APPROXIMATE DEPTH OF WELL **280** FEET

APPROXIMATE DIAMETER OF WELL **6** INCH

METHOD OF DRILLING (circle one)

BORED (or Augered) JETTED Jetted & DRIVEN
 AIR-ROTARY AIR-PERCussion ROTARY (Hydraulic Rotary)
 CABLE REVerse-ROTary DRive-POINT

SHOW MAJOR FEATURES OF BOX & LOCATE WELL WITH AN X
SOURCES OF DRILLING WATER
1. **WELL**
2.
3.


WRITE THE BOX NUMBER FROM THE MAP HERE

80X3
49X5

REPLACEMENT OR DEEPEMED WELLS (CIRCLE APPROPRIATE BOX)

THIS WELL WILL NOT REPLACE AN EXISTING WELL
 THIS WELL WILL REPLACE A WELL THAT WILL BE ABANDONED AND SEALED
 THIS WELL WILL REPLACE A WELL THAT WILL BE USED AS A STANDBY-CONTACT LOCAL APPROVING AUTHORITY FOR POLICY ON STANDBY WELLS
 THIS WELL WILL DEEPEM AN EXISTING WELL

PERMIT NUMBER OF WELL TO BE REPLACED OR DEEPEMED (IF AVAILABLE) _____

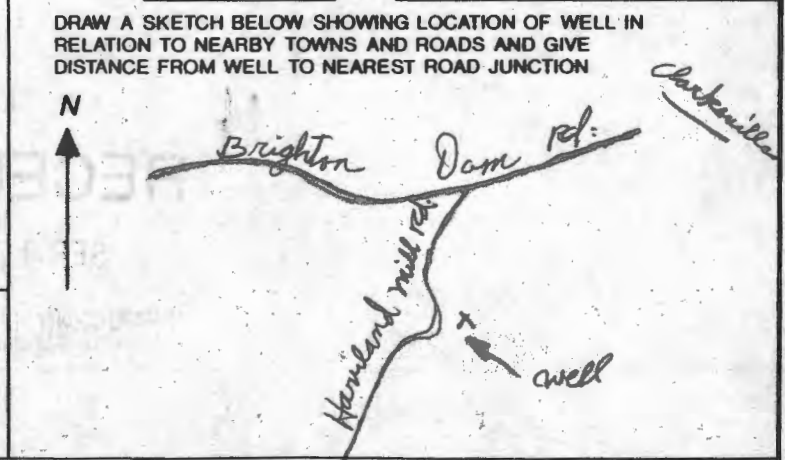

Not to be filled in by driller (MDE OR COUNTY USE ONLY)

APPROP. PERMIT NUMBER **GAP**

FORCE **MA** PERMIT No. **HO-94-0935**

SPECIAL CONDITIONS
NOTE - APPROVING AUTHORITIES SHOULD USE SEPARATE SHEET IF NEEDED

FIELD DATA SHEET
HOWARD COUNTY WELL YIELD TEST

Well Permit No. HO - 94-0935
 Location of property (road) HAVILAND MILL RD. PAR 257
 Subdivision HARRIS PROP. Lot 4 Block _____ Plat _____ Sec. _____
 Well Driller J. MAYNE Owner RICHARD DEMM. + +

Depth of well 440'
 Distance of measuring point (M.P.) above ground 1'
 Static water level (S.W.L.) below M.P. 77'

I. High rate pumping -- reservoir drawdown

Time pump started 6:45 Pumping rate 20 gpm
 Total time 45 min to reach pumping water level _____ ft. below M.P.

II. Recovery pump test data - observations to be recorded every 15 minutes

TIME (in 15 minute intervals)	WATER LEVEL below M.P.	PUMPING RATE time to fill 5/1 gallon bucket	FLOW METER READING (if used)	CALCULATED FLOW (gallons per minute)
7:00	212	3 sec.		20 gpm
7:15	302	4		15
7:30	377	5		12
7:45	373	50		1.2
8:00	373	45		1.3
8:15	372	45		1.3
8:30	372	45		1.3
8:45	371	45		1.3
9:00	370	45		1.3
9:15	370	45		1.3
9:30	369	45		1.3
9:45	368	45		1.3
10:00	366	45		1.3
10:15	366	45		1.3
10:30	366	45		1.3
10:45	366	45		1.3
11:00	366	45		1.3
11:15	366	45		1.3
11:30	365	45		1.3
11:45	365	45		1.3
12:00	365	45		1.3
12:15	365	45		1.3
12:30	365	45		1.3
12:45	365	45		1.3
1:00	365	45		1.3
1:15	365	45		1.3
1:30	365	45		1.3

HD-224
 1:15
 1:30

SUBDIVISION: Harris Property
Haviland Mill Rd

A 57018 D

LOT NUMBER: 4

DRY WELL OR DRY WELL AND TRENCH

_____ sq. ft./bedroom

	<u>Septic Tank</u>	<u>Minimum Total Square Feet</u>
3 bedroom	1000 gallon	_____
4 bedroom	1250 gallon	_____
5 bedroom	1500 gallon	_____

Inlet _____ feet below original grade.

Bottom maximum depth _____ feet below original grade.

Effective area begins at _____ feet below original grade.

NOTE: If trench is used to make up absorbent area, run the trench on level ground and leave a 5-foot earth buffer between dry well and trench. No trench is to exceed 100 feet in length. Trench inlet to be same as dry well, with _____ feet of stone below distribution pipe.

TRENCHES

180 sq. ft./bedroom

Trench to be 2 wide.

Inlet 3 feet below original grade.

Bottom maximum depth 7 feet below original grade.


Effective area begins at 3 feet below original grade.

4 feet of stone below distribution pipe.

- NOTE:
- (1) No trench to exceed 100 feet in length.
 - (2) If more than one trench used, a distribution box is required.
 - (3) Trenches to be installed on level ground.
 - (4) Call for inspection of trench before gravel is installed.
 - (5) Provide 6" - 8" diameter cleanout and cap to grade or above on septic tank and drywell.
 - (6) If a garbage disposal is used, increase septic tank capacity by 50% and increase absorbent sidewall area by 22%.

LOCATION: START THE FIRST TRENCH 120' FROM THE REAR
(168.30') LOT LINE AND 30' FROM THE RIGHT LOT
LINE. RUN TRENCHES ON CONTOUR TO LEFT SIDE
OF LOT.

MR 10/28/96

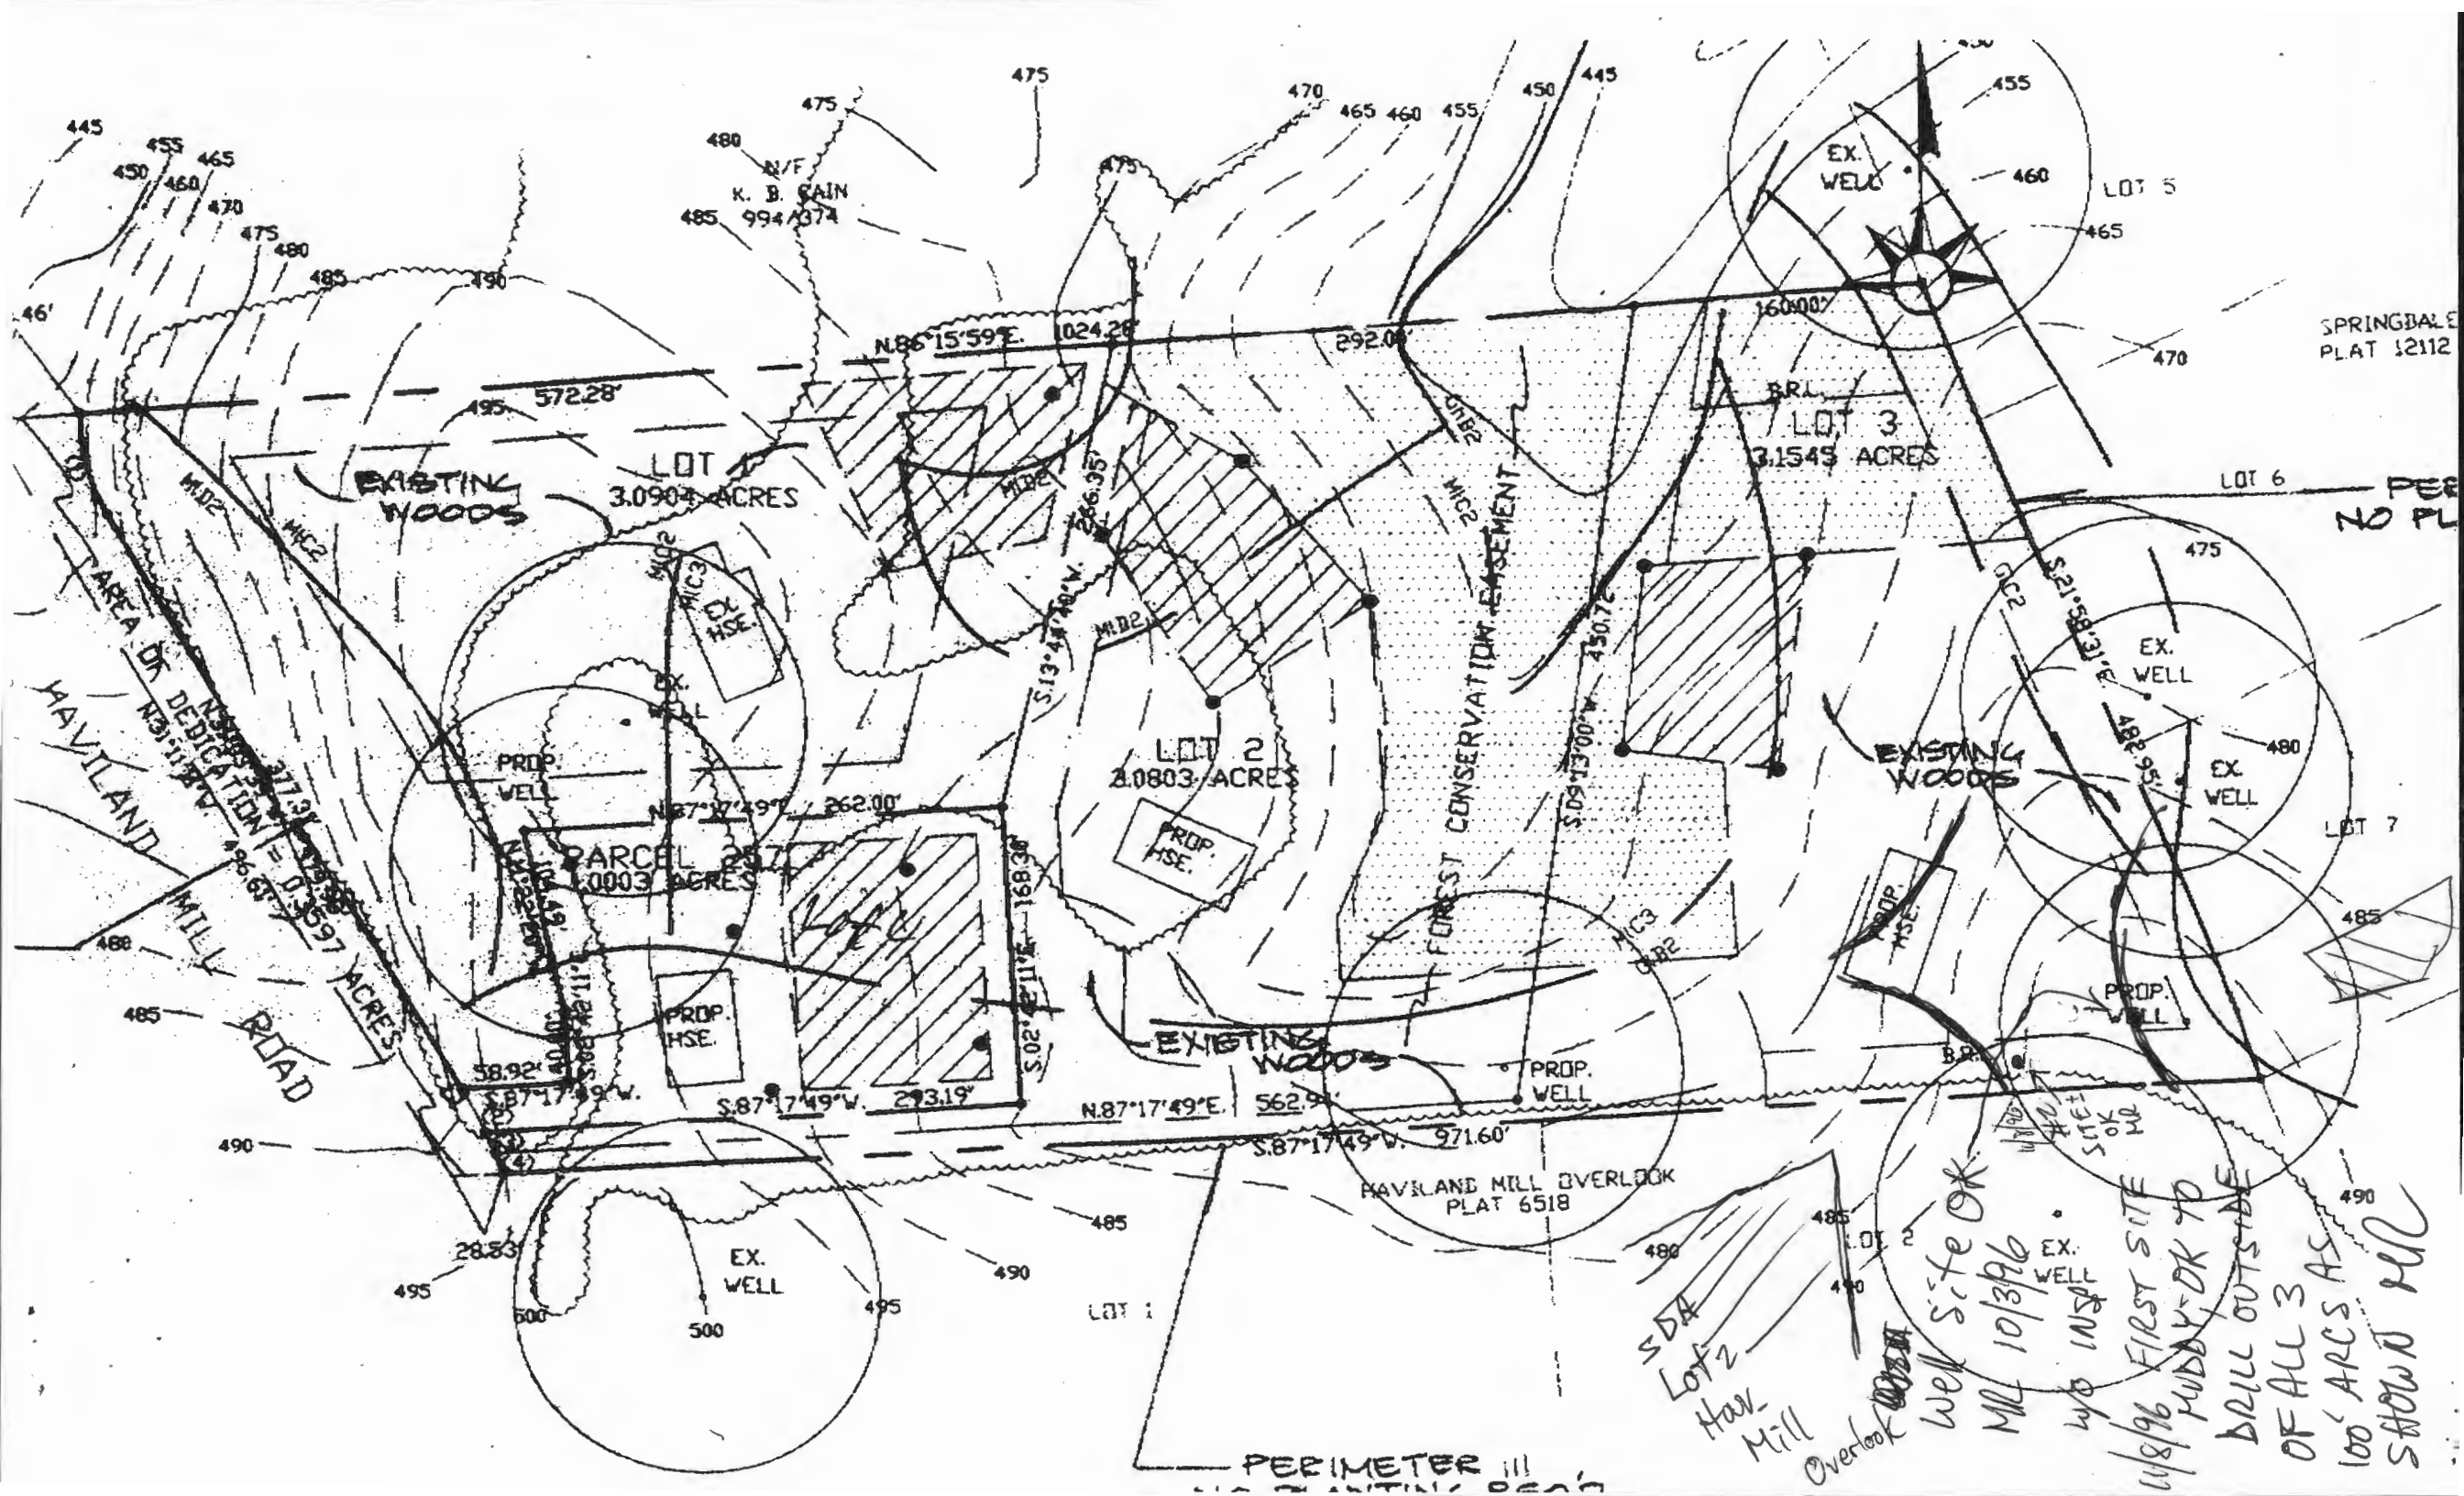

SPRINGDALE PLAT 12112

LOT 6 PER NO PL


LOT 7

HAYVILAND MILL OVERLOOK PLAT 6518

LOT 1

SDA
 Lot 2
 Hay-Mill
 Overlook
 well site OK
 MILL 10/3/96
 W/O INSP
 4/8/96 FIRST SITE
 FUDDY OK TO
 DRILL OUTSIDE
 OF ALL 3
 100' ARCS AS
 SHOWN ALL

PERIMETER III

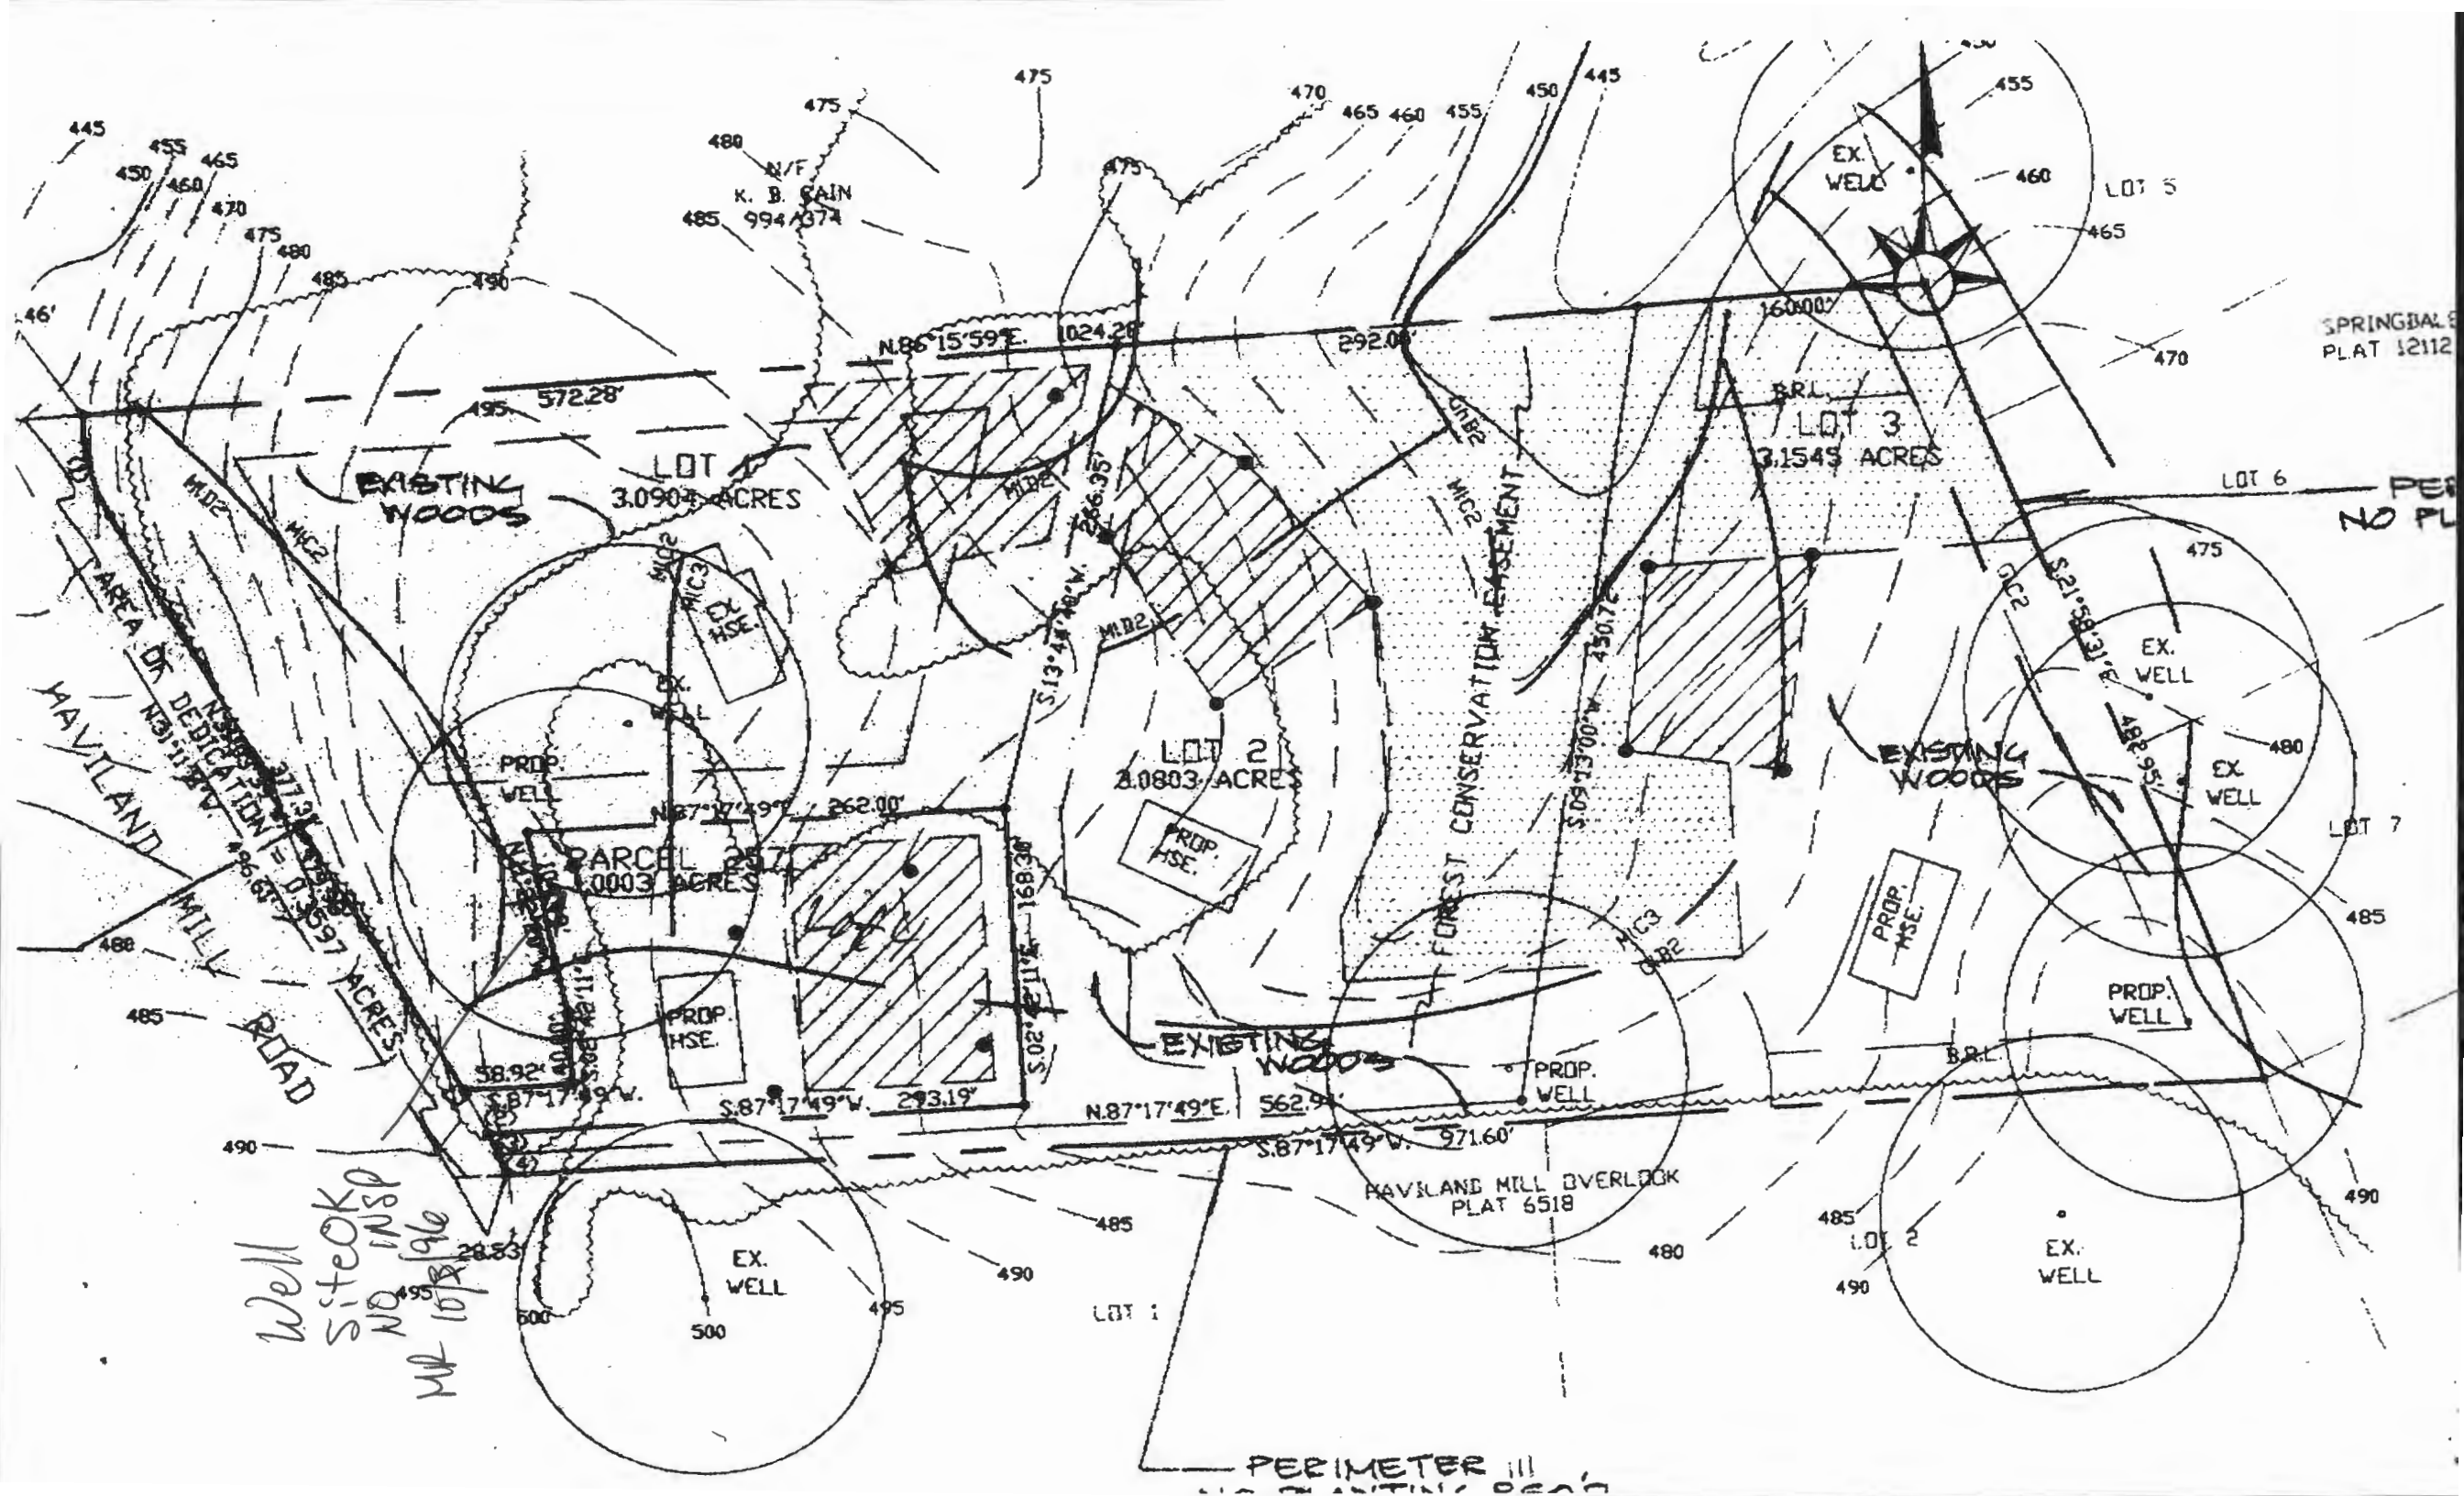

N/F
K. B. GAIN
994/374

SPRINGDALE
PLAT 12112

HAYLAND MILL ROAD
AREA OF DEDICATION = 0.3597 ACRES

EXISTING WOODS

LOT 1
3.0903 ACRES

LOT 3
3.1545 ACRES

LOT 2
3.0803 ACRES

EXISTING WOODS

PARCEL
1.0003 ACRES

EXISTING WOODS

HAYLAND MILL OVERLOOK
PLAT 6518

Well Site OK
NO INSP
MR 10/2/96

PERIMETER III