

**COMPLETE THIS FORM WHEN DROPPING OFF ANY
CORRESPONDENCE AND/OR PLANS TO THE HOWARD COUNTY
DEPARTMENT OF INSPECTIONS, LICENSES AND PERMITS COUNTER:**

Date: 4.17.19
To: Health Dept.
(Person's Name and Division)
From: Steve Appler (410) 818 7382
(Your Name, Company Name and Telephone Number)
Subject: Project name B19000142
Project site address 10548 German Rd, Laurel MD 20723
Permit # B1900142 SDP # _____
Other information pertinent to this project _____

Please check the attachments below that you are submitting with this transmittal:

- Letter of response to address plan review comment letter
- Revised plans and/or revised details: When submitting for a complete re-review, **duplicate sets shall be submitted.**
- Letter Summarizing Changes
- Energy conservation calculations
- Copies of plot plan w/ updated septic (be specific).
 - Health Department Request
 - DPZ/ DED Request
 - Applicant's Request
- Two sets of single family dwelling model plans to be placed on permanent file: Model name and/or # _____
- Other _____

Contact Person Information: (Required)

Steve Appler
Please Print Name

Telephone No: 410 818 7382

E-Mail Address: Steve@cairn
customhomes.com

PLEASE ASSURE ALL DOCUMENTS AND/OR REVISIONS ARE APPROPRIATELY SIGNED AND SEALED, IF NECESSARY, BY A LICENSED ARCHITECT OR ENGINEER. PLEASE BE ADVISED THAT INSUFFICIENT INFORMATION MAY RESULT IN THE DELAY OF REVIEW BY THE PLANS EXAMINER. THE DEPARTMENT OF INSPECTIONS, LICENSES AND PERMITS WILL CONTACT YOU IF THERE IS A PROBLEM. IN ADDITION, ONCE THE BUILDING PERMIT IS APPROVED BY THE PLAN REVIEW DIVISION AND ALL OTHER REQUIRED SIGNATORY AGENCIES, AND THE BUILDING PERMIT IS READY FOR ISSUANCE, THE PERMIT DIVISION WILL NOTIFY THE APPROPRIATE CONTACT PERSON FOR PERMIT PICK UP. ALL PERMIT STATUS INQUIRIES SHALL BE DIRECTED TO THE PERMIT DIVISION AT 410-313-2455. CODE RELATED QUESTIONS AND PLAN REVIEW INQUIRIES SHALL BE DIRECTED TO THE PLAN REVIEW DIVISION AT 410-313-2436. PLEASE ALLOW A MINIMUM OF FIVE (5) WORKING DAYS FOR ANY PLAN SUBMITTALS TO BE REVIEWED. THANK YOU.

Received by AKH

PER HEALTH
DEPT

White-Plan Review / Yellow-Applicant / Pink-Permit Division
t:\Operations\Updated forms\transmit.frm - Rev. 04/2014

approved
4/23/19
SW

AKH

COMPLETE THIS FORM WHEN DROPPING OFF ANY
CORRESPONDENCE AND/OR PLANS TO THE HOWARD COUNTY
DEPARTMENT OF INSPECTIONS, LICENSES AND PERMITS COUNTER:

Date: 4.17.19
To: Health Dept.
(Person's Name and Division)
From: Steve Appler (410) 818 7382
(Your Name, Company Name and Telephone Number)
Subject: Project name B19000142
Project site address 10548 German Rd, Laurel MD 20723
Permit # B1900142 SDP # _____
Other information pertinent to this project _____

Please check the attachments below that you are submitting with this transmittal:

- Letter of response to address plan review comment letter
- Revised plans and/or revised details: When submitting for a complete re-review, duplicate sets shall be submitted.
- Letter Summarizing Changes
- Energy conservation calculations
- Copies of plot plan w/ updated septic (be specific).
- Health Department Request DPZ/ DED Request Applicant's Request
- Two sets of single family dwelling model plans to be placed on permanent file: Model name and/or # _____
- Other _____

Contact Person Information: (Required)

Steve Appler
Please Print Name

Telephone No: 410 818 7382

E-Mail Address: steve@cairn
customhomes.com

PLEASE ASSURE ALL DOCUMENTS AND/OR REVISIONS ARE APPROPRIATELY SIGNED AND SEALED, IF NECESSARY, BY A LICENSED ARCHITECT OR ENGINEER. PLEASE BE ADVISED THAT INSUFFICIENT INFORMATION MAY RESULT IN THE DELAY OF REVIEW BY THE PLANS EXAMINER. THE DEPARTMENT OF INSPECTIONS, LICENSES AND PERMITS WILL CONTACT YOU IF THERE IS A PROBLEM. IN ADDITION, ONCE THE BUILDING PERMIT IS APPROVED BY THE PLAN REVIEW DIVISION AND ALL OTHER REQUIRED SIGNATORY AGENCIES, AND THE BUILDING PERMIT IS READY FOR ISSUANCE, THE PERMIT DIVISION WILL NOTIFY THE APPROPRIATE CONTACT PERSON FOR PERMIT PICK UP. ALL PERMIT STATUS INQUIRIES SHALL BE DIRECTED TO THE PERMIT DIVISION AT 410-313-2455. CODE RELATED QUESTIONS AND PLAN REVIEW INQUIRIES SHALL BE DIRECTED TO THE PLAN REVIEW DIVISION AT 410-313-2436. PLEASE ALLOW A MINIMUM OF FIVE (5) WORKING DAYS FOR ANY PLAN SUBMITTALS TO BE REVIEWED. THANK YOU.

Received by AKH

PER HEALTH
DEPT

AKH



RECEIVED

APR 17 2019

**LICENSES & PERMITS
DIVISION**

4/17/2019

Howard County
Health Dept & Plan Review

RE: B19000142

To whom it may concern:

Please see the attached revision of plot plans, with updated septic field now present, as requested by the Health Department.

If there are any questions, please call me at 410-818-7382.

Thank you,

Steve Appler (homeowner)

REVISED
 Date: 4/17/19
 Comments: B19000142
 UPDATED SEPTIC

NOTE: Total area of land disturbance for the proposed additions shown on this plan is =4655 sq. ft.

NOTE: THIS PROPERTY IS BEING SERVED BY PUBLIC WATER


SEPTIC INFORMATION

NOTE: PROP. SEPTIC TANK LOCATION TO BE THE SAME AS THE EXISTING SEPTIC TANK LOCATION.

EXIST. SEPTIC TANK INV. IN=360.30
 EXIST. SEPTIC TANK INV. OUT=360.00
 PROP. SEPTIC TANK INV. IN=360.30
 PROP. SEPTIC TANK INV. OUT=360.00

EXIST. GROUND ELEV. AT EXIST. SEPTIC TANK=362.90 PROP. GROUND ELEV. AT PROP. SEPTIC TANK=363.00

EXIST. SHC INV. AT FOUNDATION=362.99
 PROP. SHC INV. AT FOUNDATION=362.20

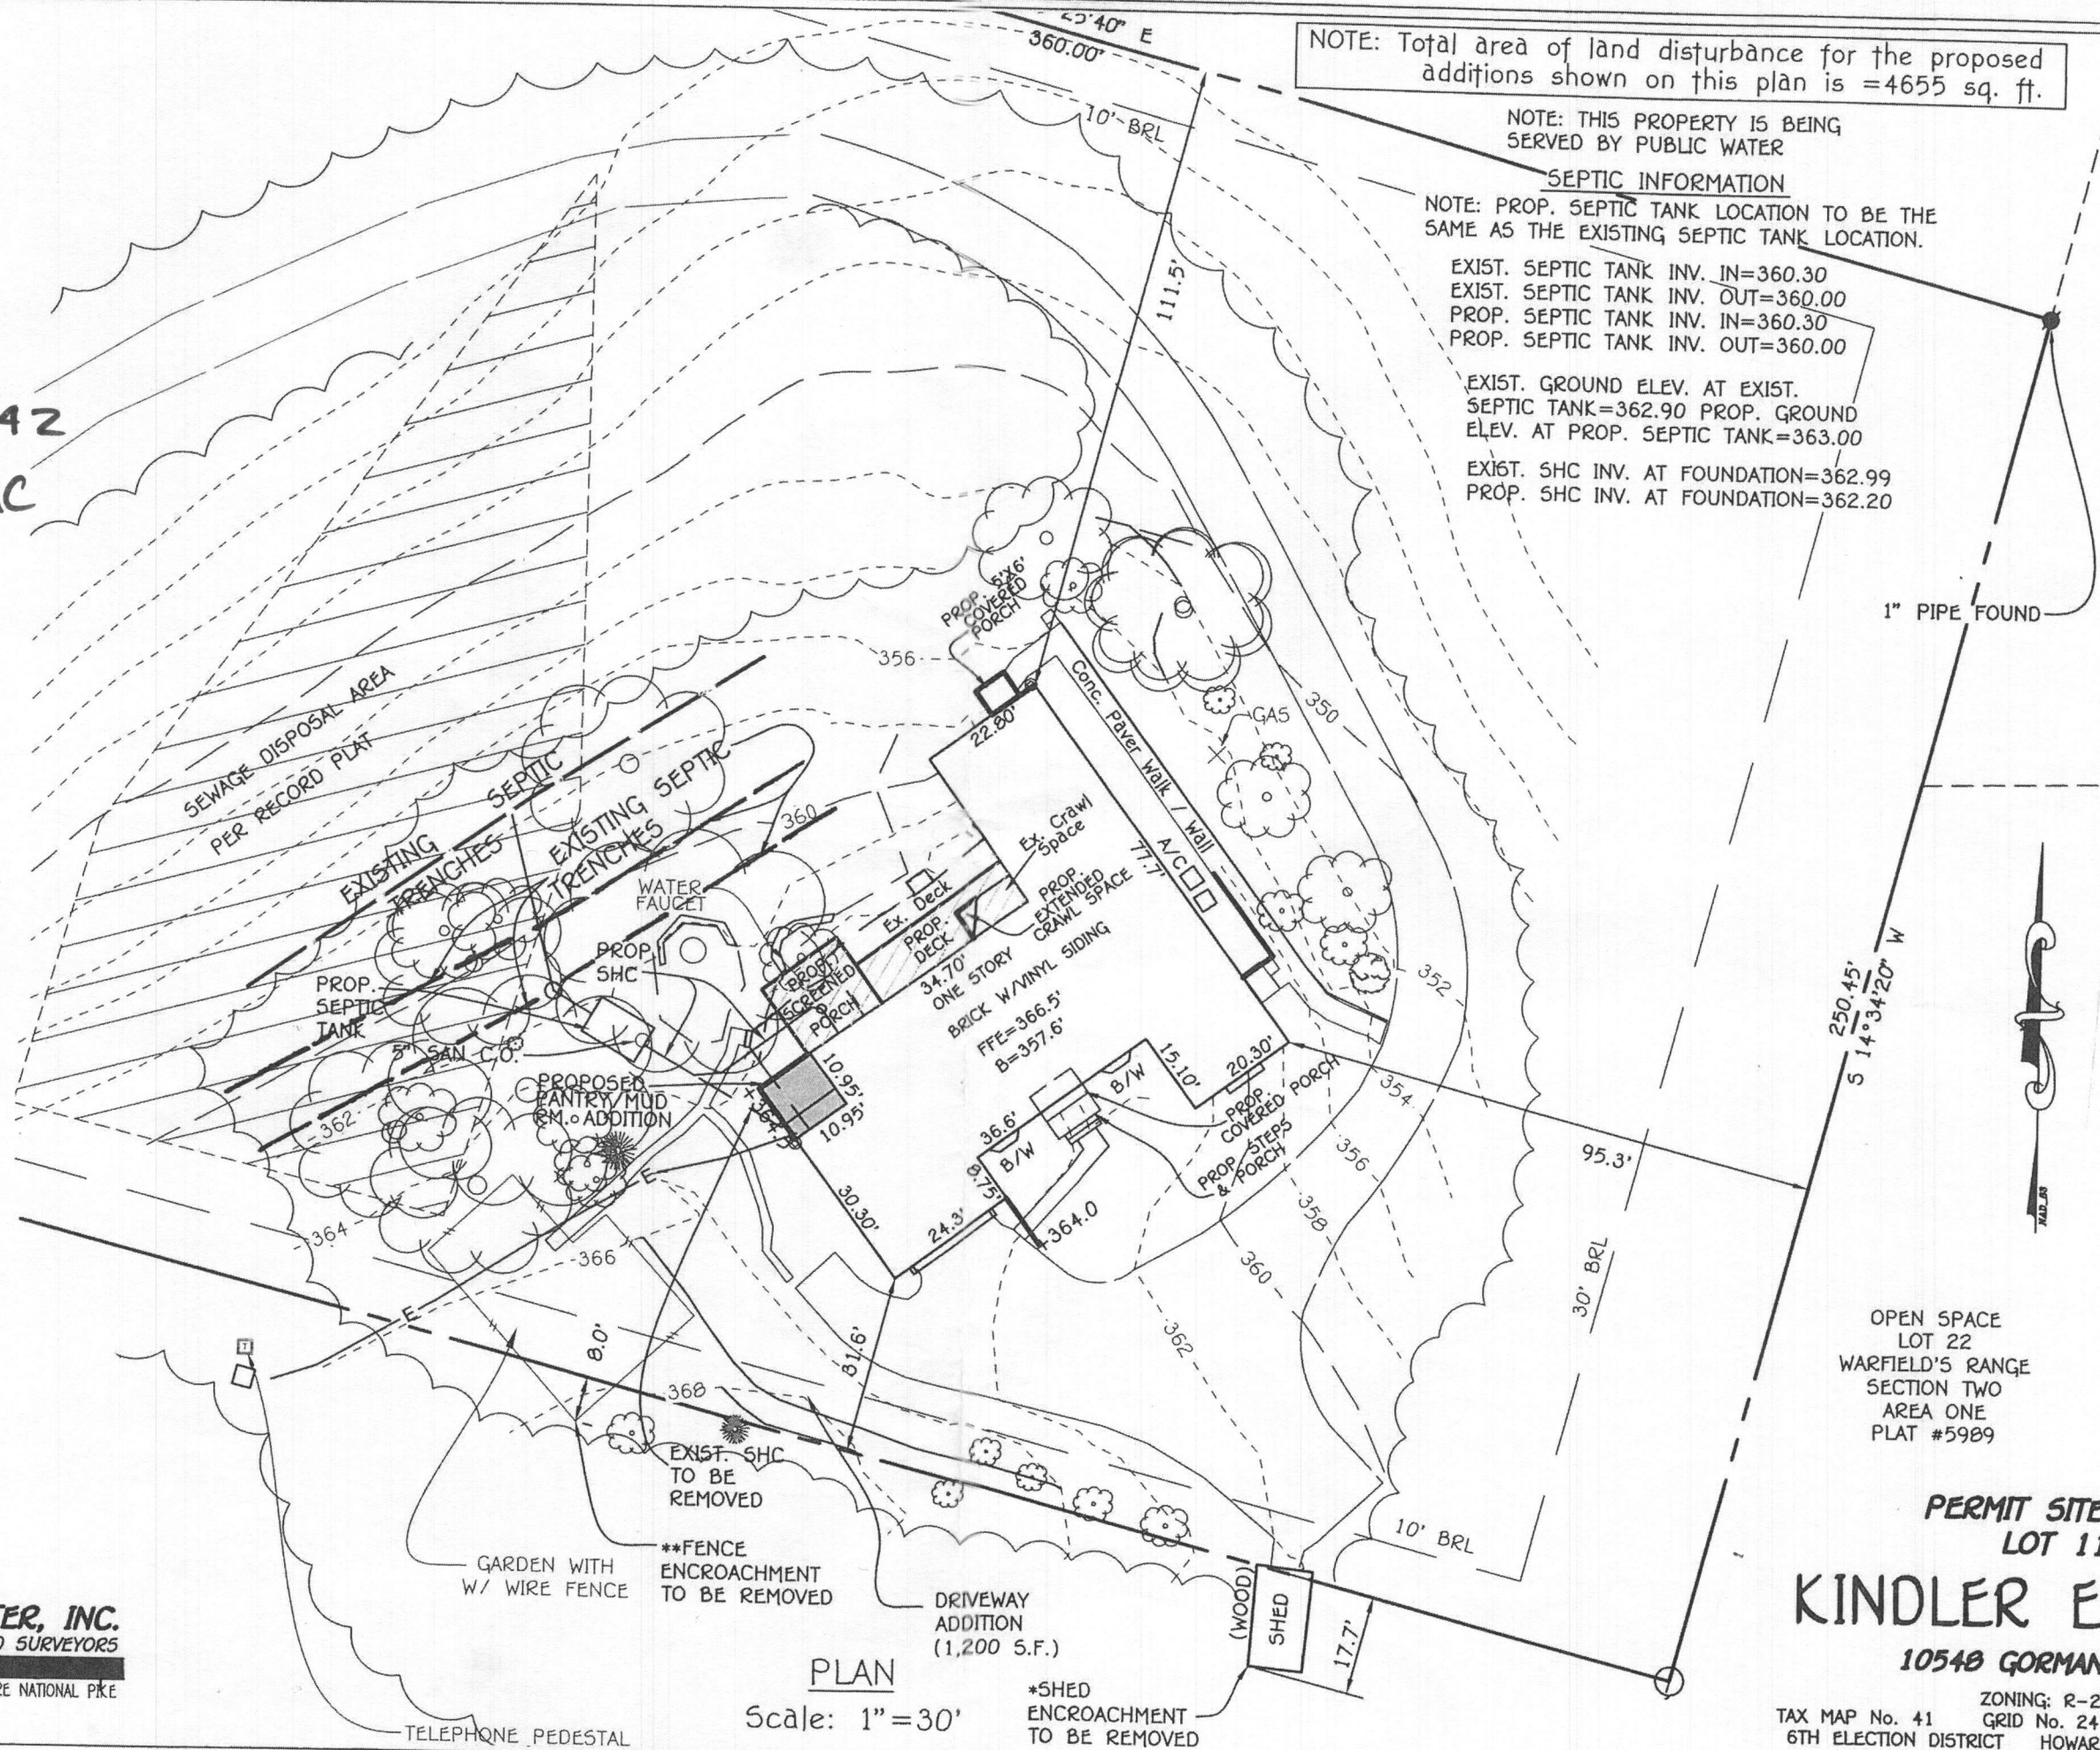

1" PIPE FOUND



OPEN SPACE
 LOT 22
 WARFIELD'S RANGE
 SECTION TWO
 AREA ONE
 PLAT #5989

PERMIT SITE PLAN
 LOT 11
KINDLER ESTATES
 10548 GORMAN ROAD

ZONING: R-20
 TAX MAP No. 41 GRID No. 24 PARCEL No. 424
 6TH ELECTION DISTRICT HOWARD COUNTY, MARYLAND
 DATE: APRIL 16, 2019

OWNER
 LISA R. APPLER
 MARTIN STEVEN APPLER
 10548 GORMAN ROAD
 LAUREL, MD 20723

FISHER, COLLINS & CARTER, INC.
 CIVIL ENGINEERING CONSULTANTS & LAND SURVEYORS
 CENTENNIAL SQUARE OFFICE PARK - 10272 BALTIMORE NATIONAL P.K.E.
 ELLICOTT CITY, MARYLAND 21042
 (410) 461 - 2855

PLAN
 Scale: 1"=30'

*SHED ENCROACHMENT TO BE REMOVED

**FENCE ENCROACHMENT TO BE REMOVED

EXIST. SHC TO BE REMOVED

GARDEN WITH W/ WIRE FENCE

TELEPHONE PEDESTAL

REVISED
 Date: 4/17/19
 Comments: B19000142
 UPDATED SEPTIC

NOTE: Total area of land disturbance for the proposed additions shown on this plan is =4655 sq. ft.


NOTE: THIS PROPERTY IS BEING SERVED BY PUBLIC WATER

SEPTIC INFORMATION
 NOTE: PROP. SEPTIC TANK LOCATION TO BE THE SAME AS THE EXISTING SEPTIC TANK LOCATION.

EXIST. SEPTIC TANK INV. IN=360.30
 EXIST. SEPTIC TANK INV. OUT=360.00
 PROP. SEPTIC TANK INV. IN=360.30
 PROP. SEPTIC TANK INV. OUT=360.00

EXIST. GROUND ELEV. AT EXIST. SEPTIC TANK=362.90
 PROP. GROUND ELEV. AT PROP. SEPTIC TANK=363.00

EXIST. SHC INV. AT FOUNDATION=362.99
 PROP. SHC INV. AT FOUNDATION=362.20

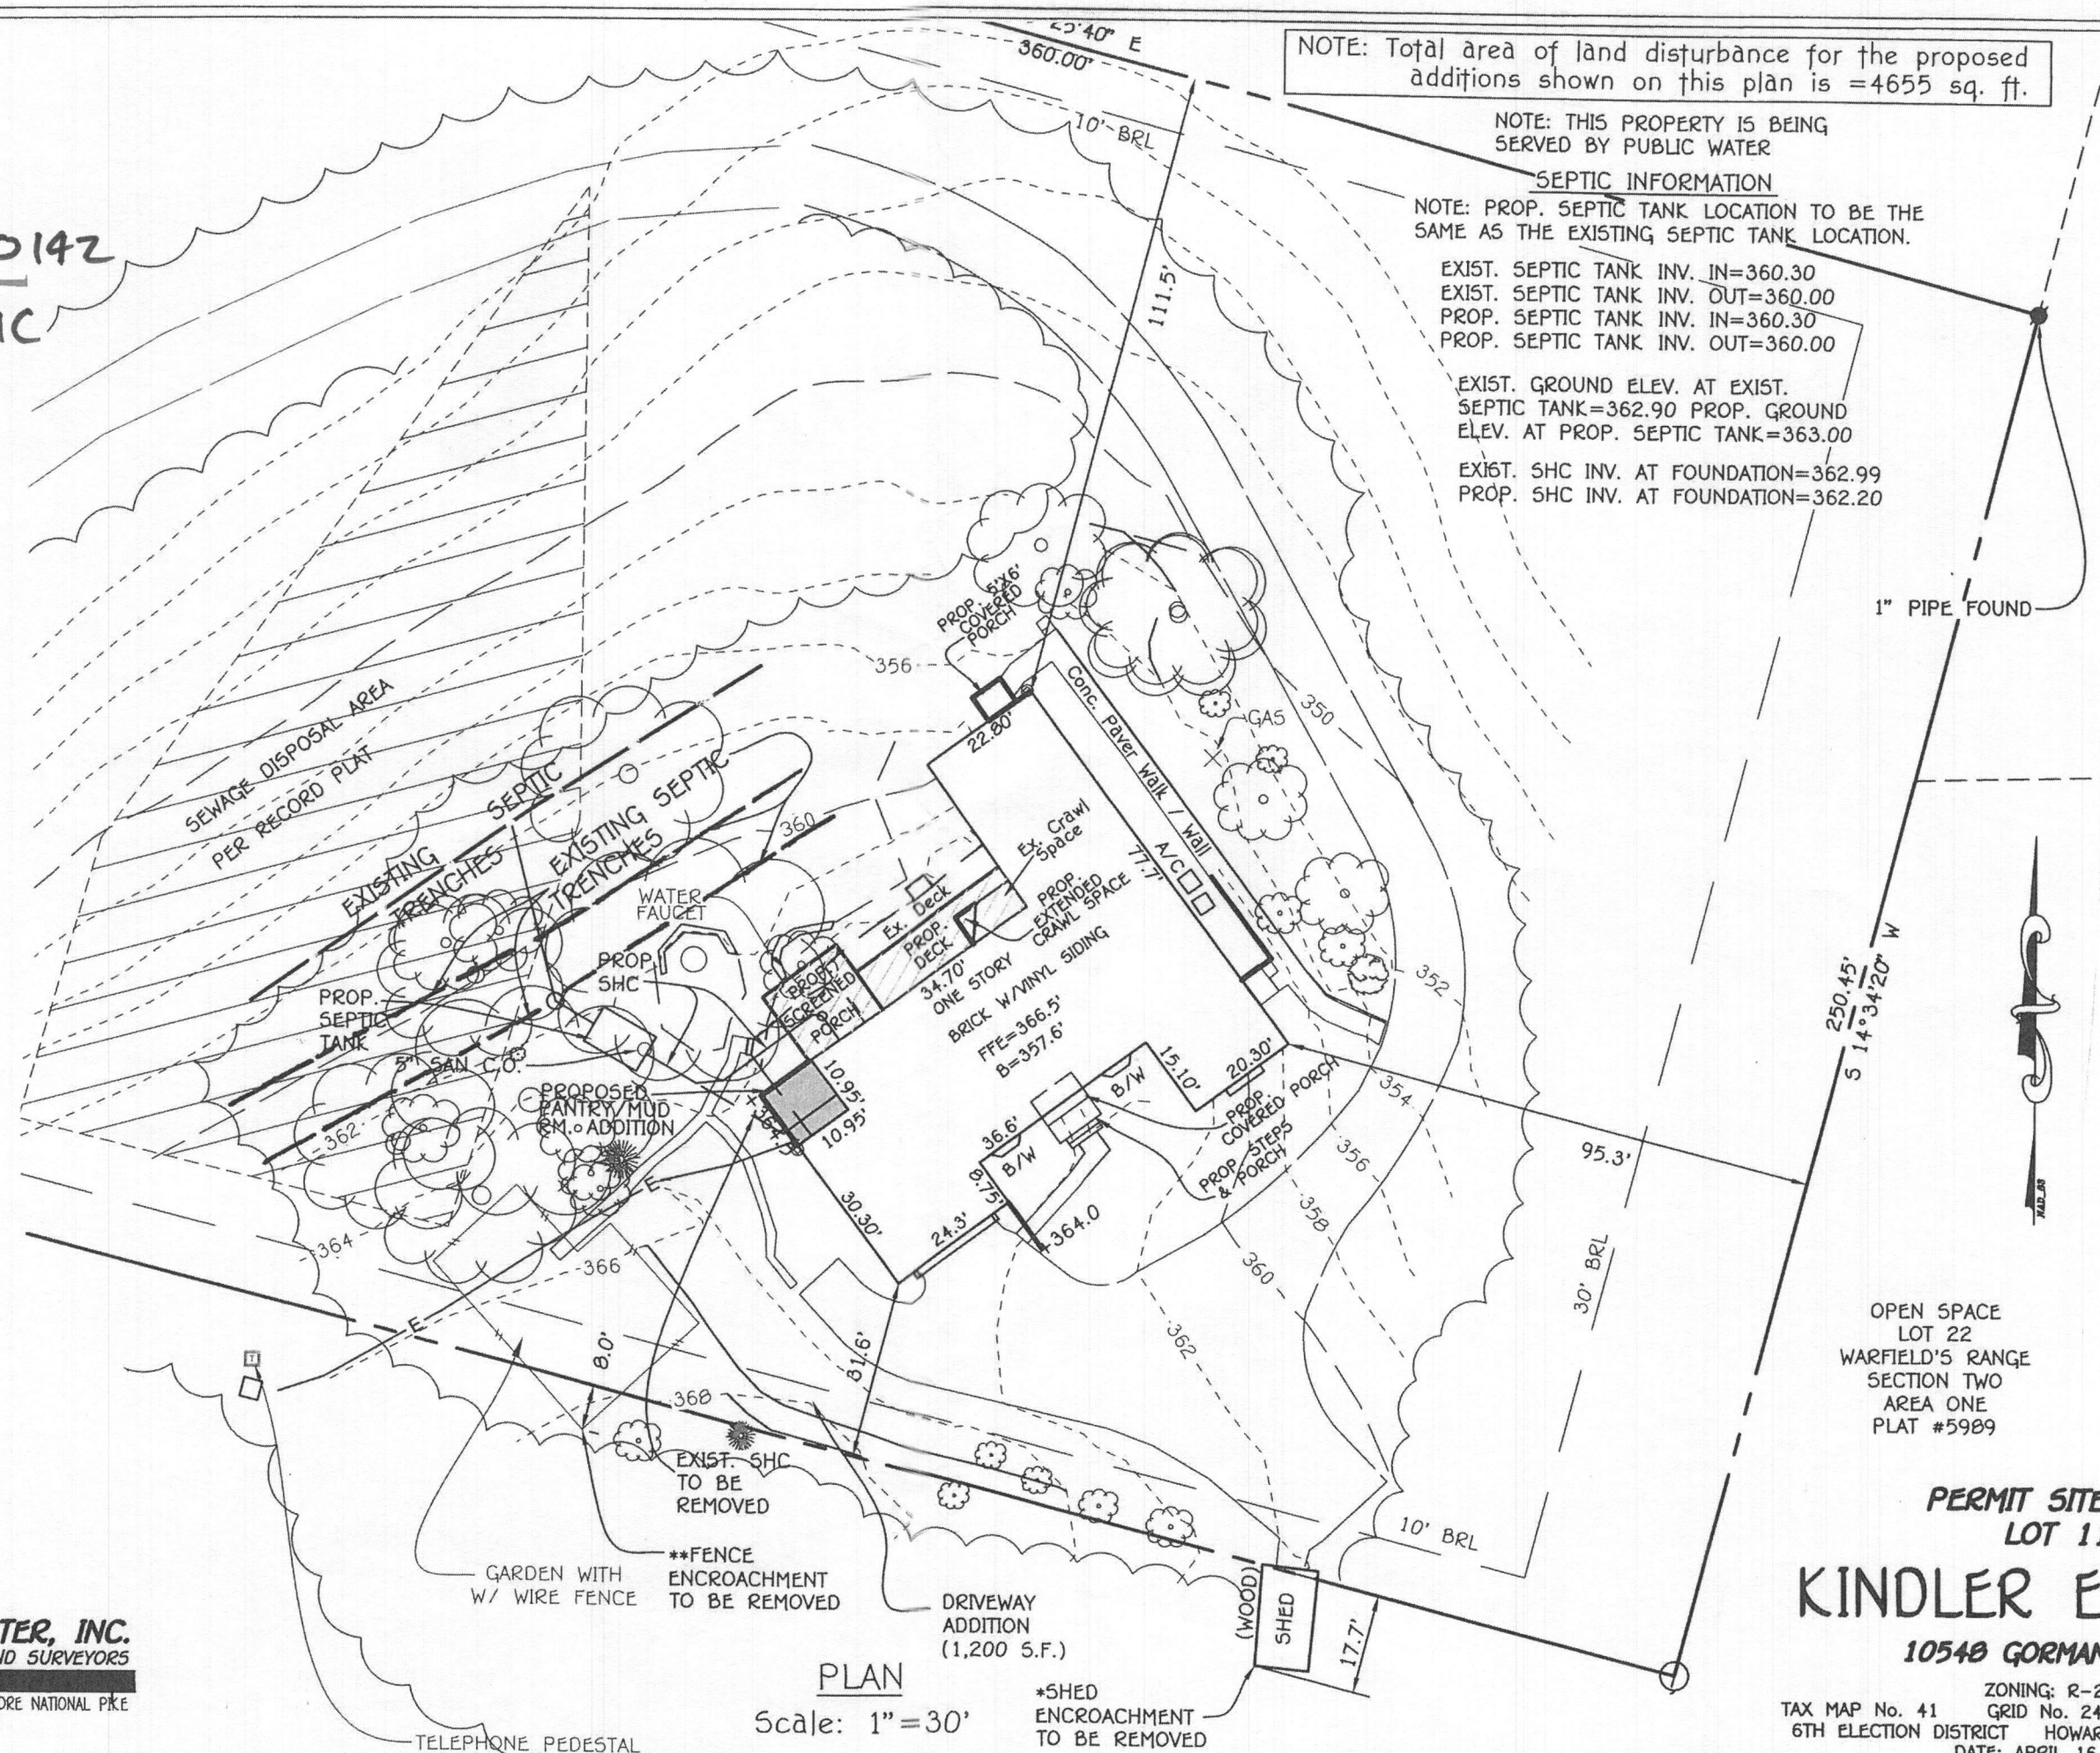

1" PIPE FOUND

250.45'
 S 14° 34' 20" W



OPEN SPACE
 LOT 22
 WARFIELD'S RANGE
 SECTION TWO
 AREA ONE
 PLAT #5989

PERMIT SITE PLAN
 LOT 11
KINDLER ESTATES
 10548 GORMAN ROAD

ZONING: R-20
 TAX MAP No. 41 GRID No. 24 PARCEL No. 424
 6TH ELECTION DISTRICT HOWARD COUNTY, MARYLAND
 DATE: APRIL 16, 2019

OWNER
 LISA R. APPLER
 MARTIN STEVEN APPLER
 10548 GORMAN ROAD
 LAUREL, MD 20723

FISHER, COLLINS & CARTER, INC.
 CIVIL ENGINEERING CONSULTANTS & LAND SURVEYORS
 CENTENNIAL SQUARE OFFICE PARK - 10272 BALTIMORE NATIONAL PkE
 ELLICOTT CITY, MARYLAND 21042
 (410) 461 - 2855

PLAN
 Scale: 1"=30'

*SHED ENCROACHMENT TO BE REMOVED

TELEPHONE PEDESTAL

REVISED
 Date: 4/17/19
 Comments: B19000142
 UPDATED SEPTIC

NOTE: Total area of land disturbance for the proposed additions shown on this plan is =4655 sq. ft.

NOTE: THIS PROPERTY IS BEING SERVED BY PUBLIC WATER


SEPTIC INFORMATION

NOTE: PROP. SEPTIC TANK LOCATION TO BE THE SAME AS THE EXISTING SEPTIC TANK LOCATION.

EXIST. SEPTIC TANK INV. IN=360.30
 EXIST. SEPTIC TANK INV. OUT=360.00
 PROP. SEPTIC TANK INV. IN=360.30
 PROP. SEPTIC TANK INV. OUT=360.00

EXIST. GROUND ELEV. AT EXIST. SEPTIC TANK=362.90
 PROP. GROUND ELEV. AT PROP. SEPTIC TANK=363.00

EXIST. SHC INV. AT FOUNDATION=362.99
 PROP. SHC INV. AT FOUNDATION=362.20

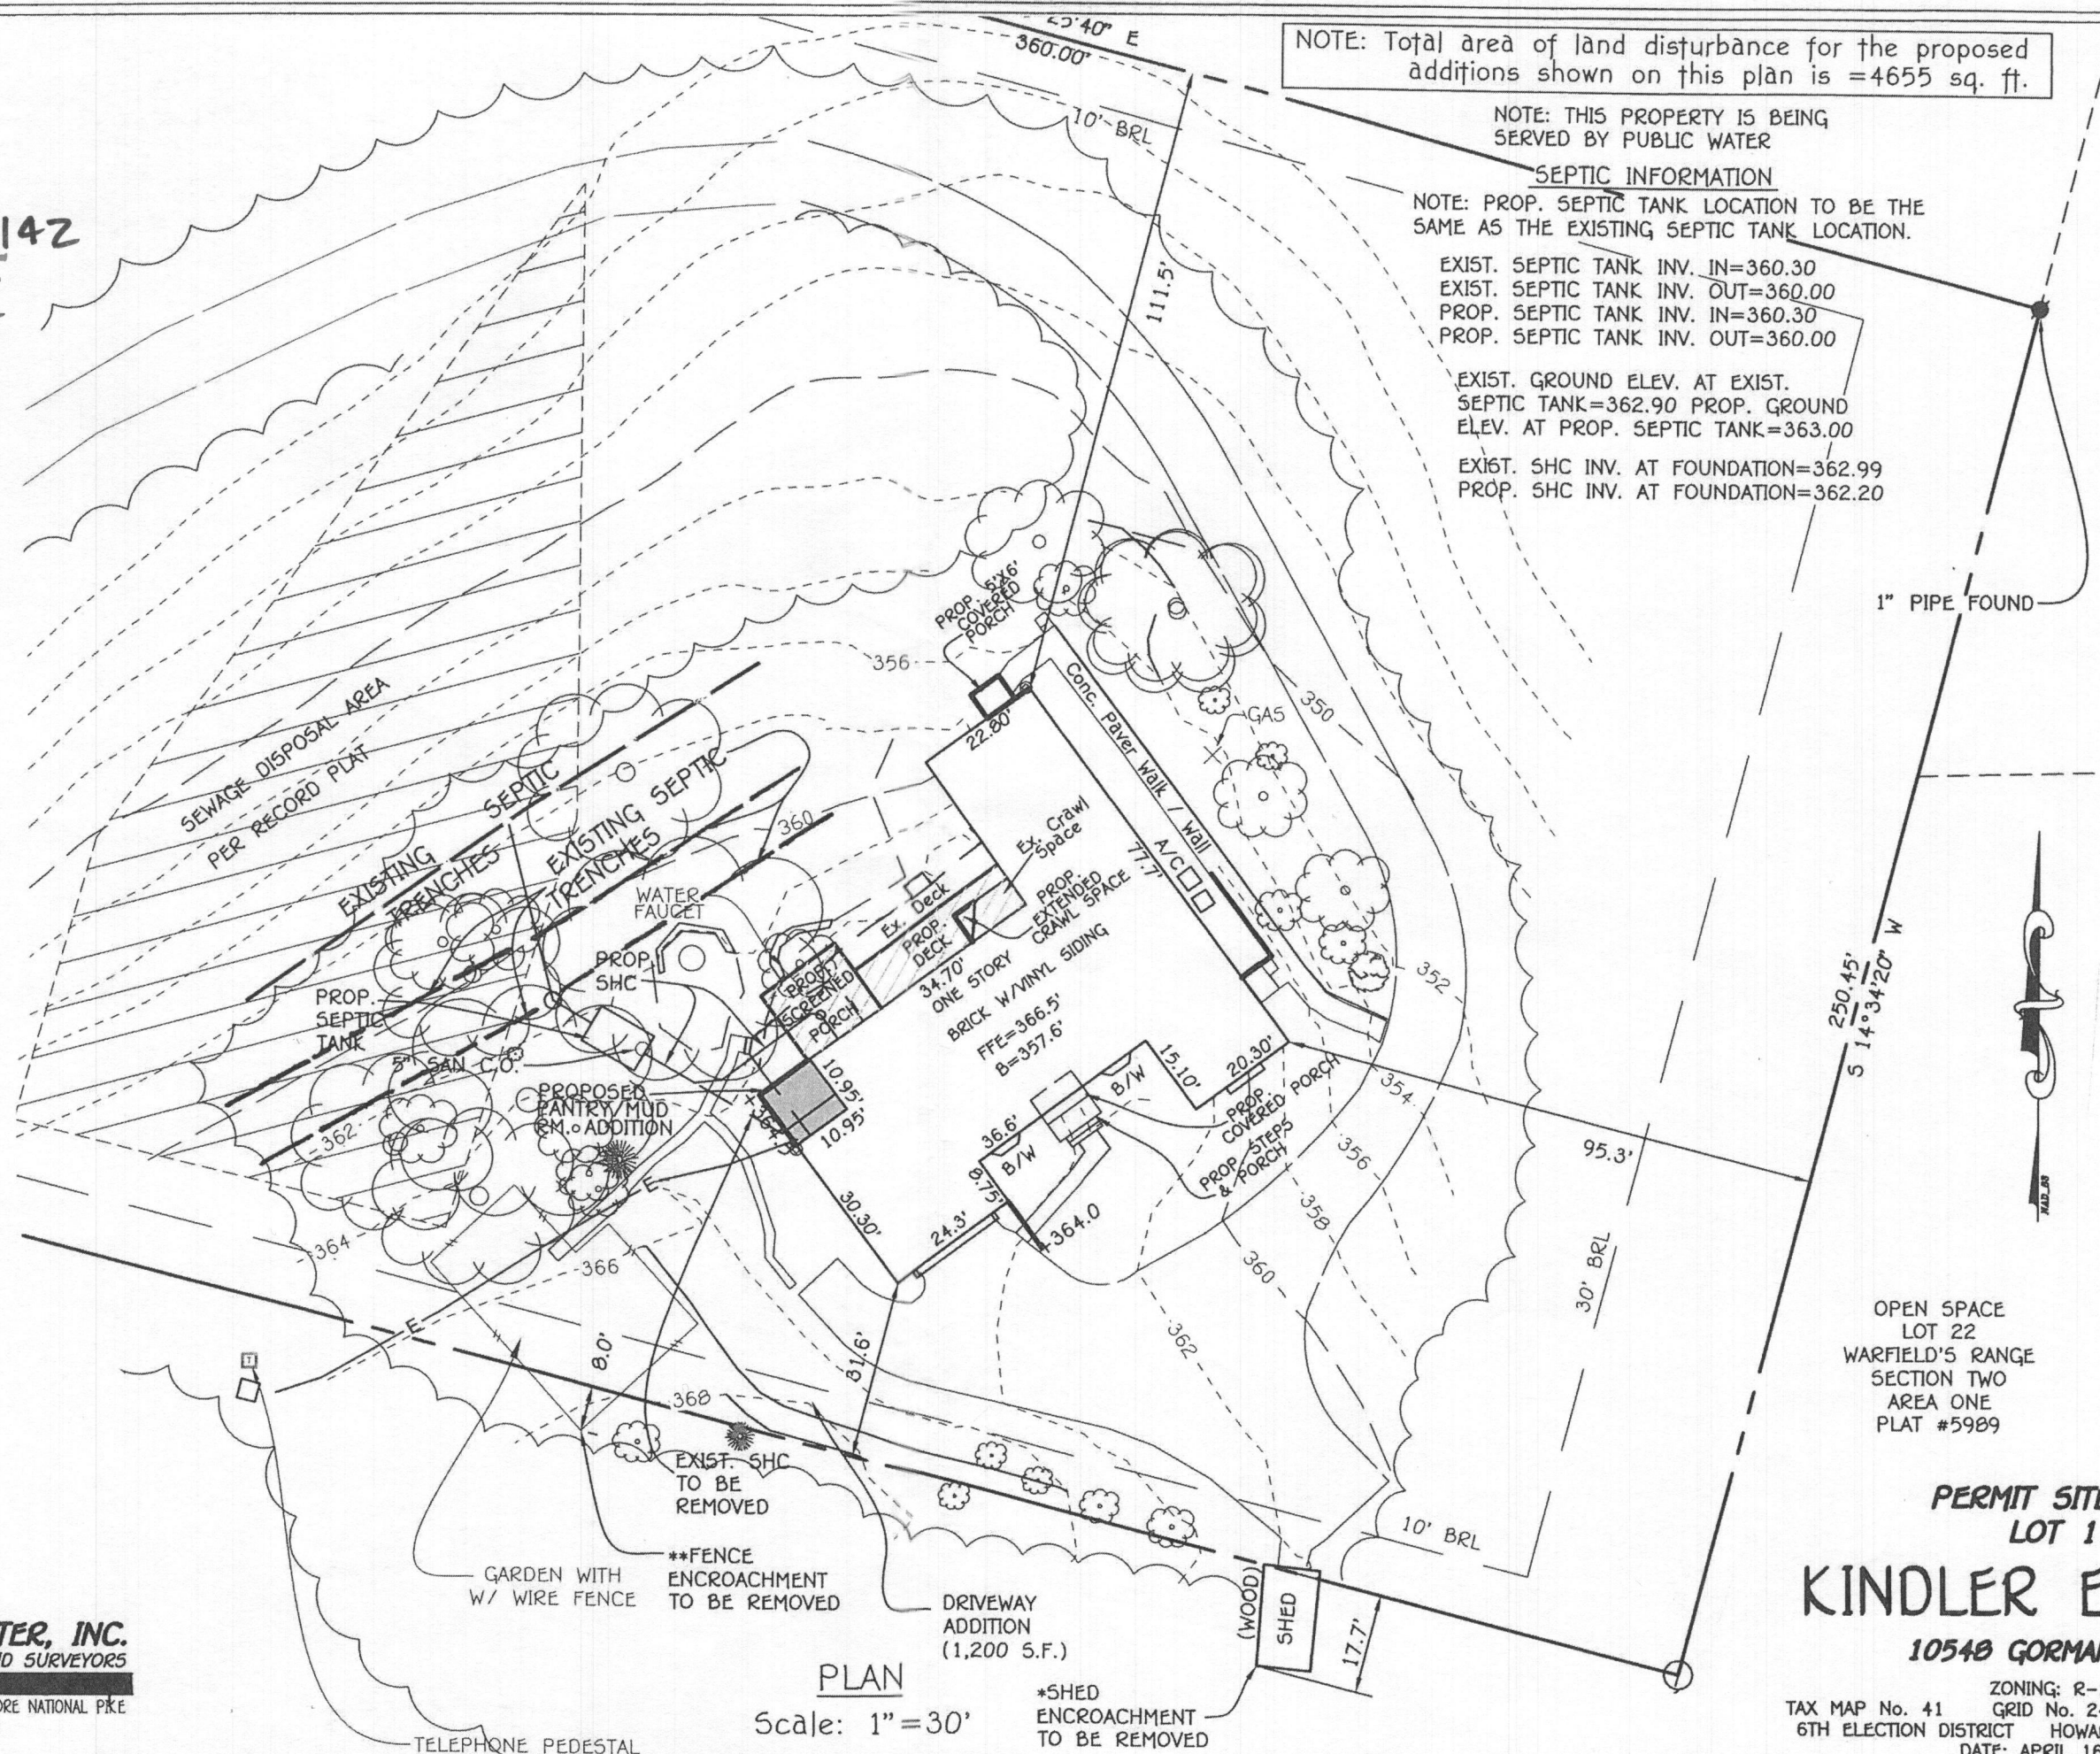

1" PIPE FOUND



OPEN SPACE
 LOT 22
 WARFIELD'S RANGE
 SECTION TWO
 AREA ONE
 PLAT #5989

PERMIT SITE PLAN
LOT 11
KINDLER ESTATES
 10548 GORMAN ROAD

ZONING: R-20
 TAX MAP No. 41 GRID No. 24 PARCEL No. 424
 6TH ELECTION DISTRICT HOWARD COUNTY, MARYLAND
 DATE: APRIL 16, 2019

OWNER
 LISA R. APPLER
 MARTIN STEVEN APPLER
 10548 GORMAN ROAD
 LAUREL, MD 20723

FISHER, COLLINS & CARTER, INC.
 CIVIL ENGINEERING CONSULTANTS & LAND SURVEYORS
 CENTENNIAL SQUARE OFFICE PARK - 10272 BALTIMORE NATIONAL PIKE
 ELLICOTT CITY, MARYLAND 21042
 (410) 461 - 2855

PLAN
 Scale: 1" = 30'

TELEPHONE PEDESTAL

*SHED ENCROACHMENT TO BE REMOVED

**FENCE ENCROACHMENT TO BE REMOVED

EXIST. SHC TO BE REMOVED

DRIVEWAY ADDITION (1,200 S.F.)

(WOOD) SHED

REVISED
 Date: 4/17/19
 Comments: B19000142
 UPDATED SEPTIC

NOTE: Total area of land disturbance for the proposed additions shown on this plan is =4655 sq. ft.


NOTE: THIS PROPERTY IS BEING SERVED BY PUBLIC WATER

SEPTIC INFORMATION
 NOTE: PROP. SEPTIC TANK LOCATION TO BE THE SAME AS THE EXISTING SEPTIC TANK LOCATION.

EXIST. SEPTIC TANK INV. IN=360.30
 EXIST. SEPTIC TANK INV. OUT=360.00
 PROP. SEPTIC TANK INV. IN=360.30
 PROP. SEPTIC TANK INV. OUT=360.00

EXIST. GROUND ELEV. AT EXIST. SEPTIC TANK=362.90
 PROP. GROUND ELEV. AT PROP. SEPTIC TANK=363.00

EXIST. SHC INV. AT FOUNDATION=362.99
 PROP. SHC INV. AT FOUNDATION=362.20

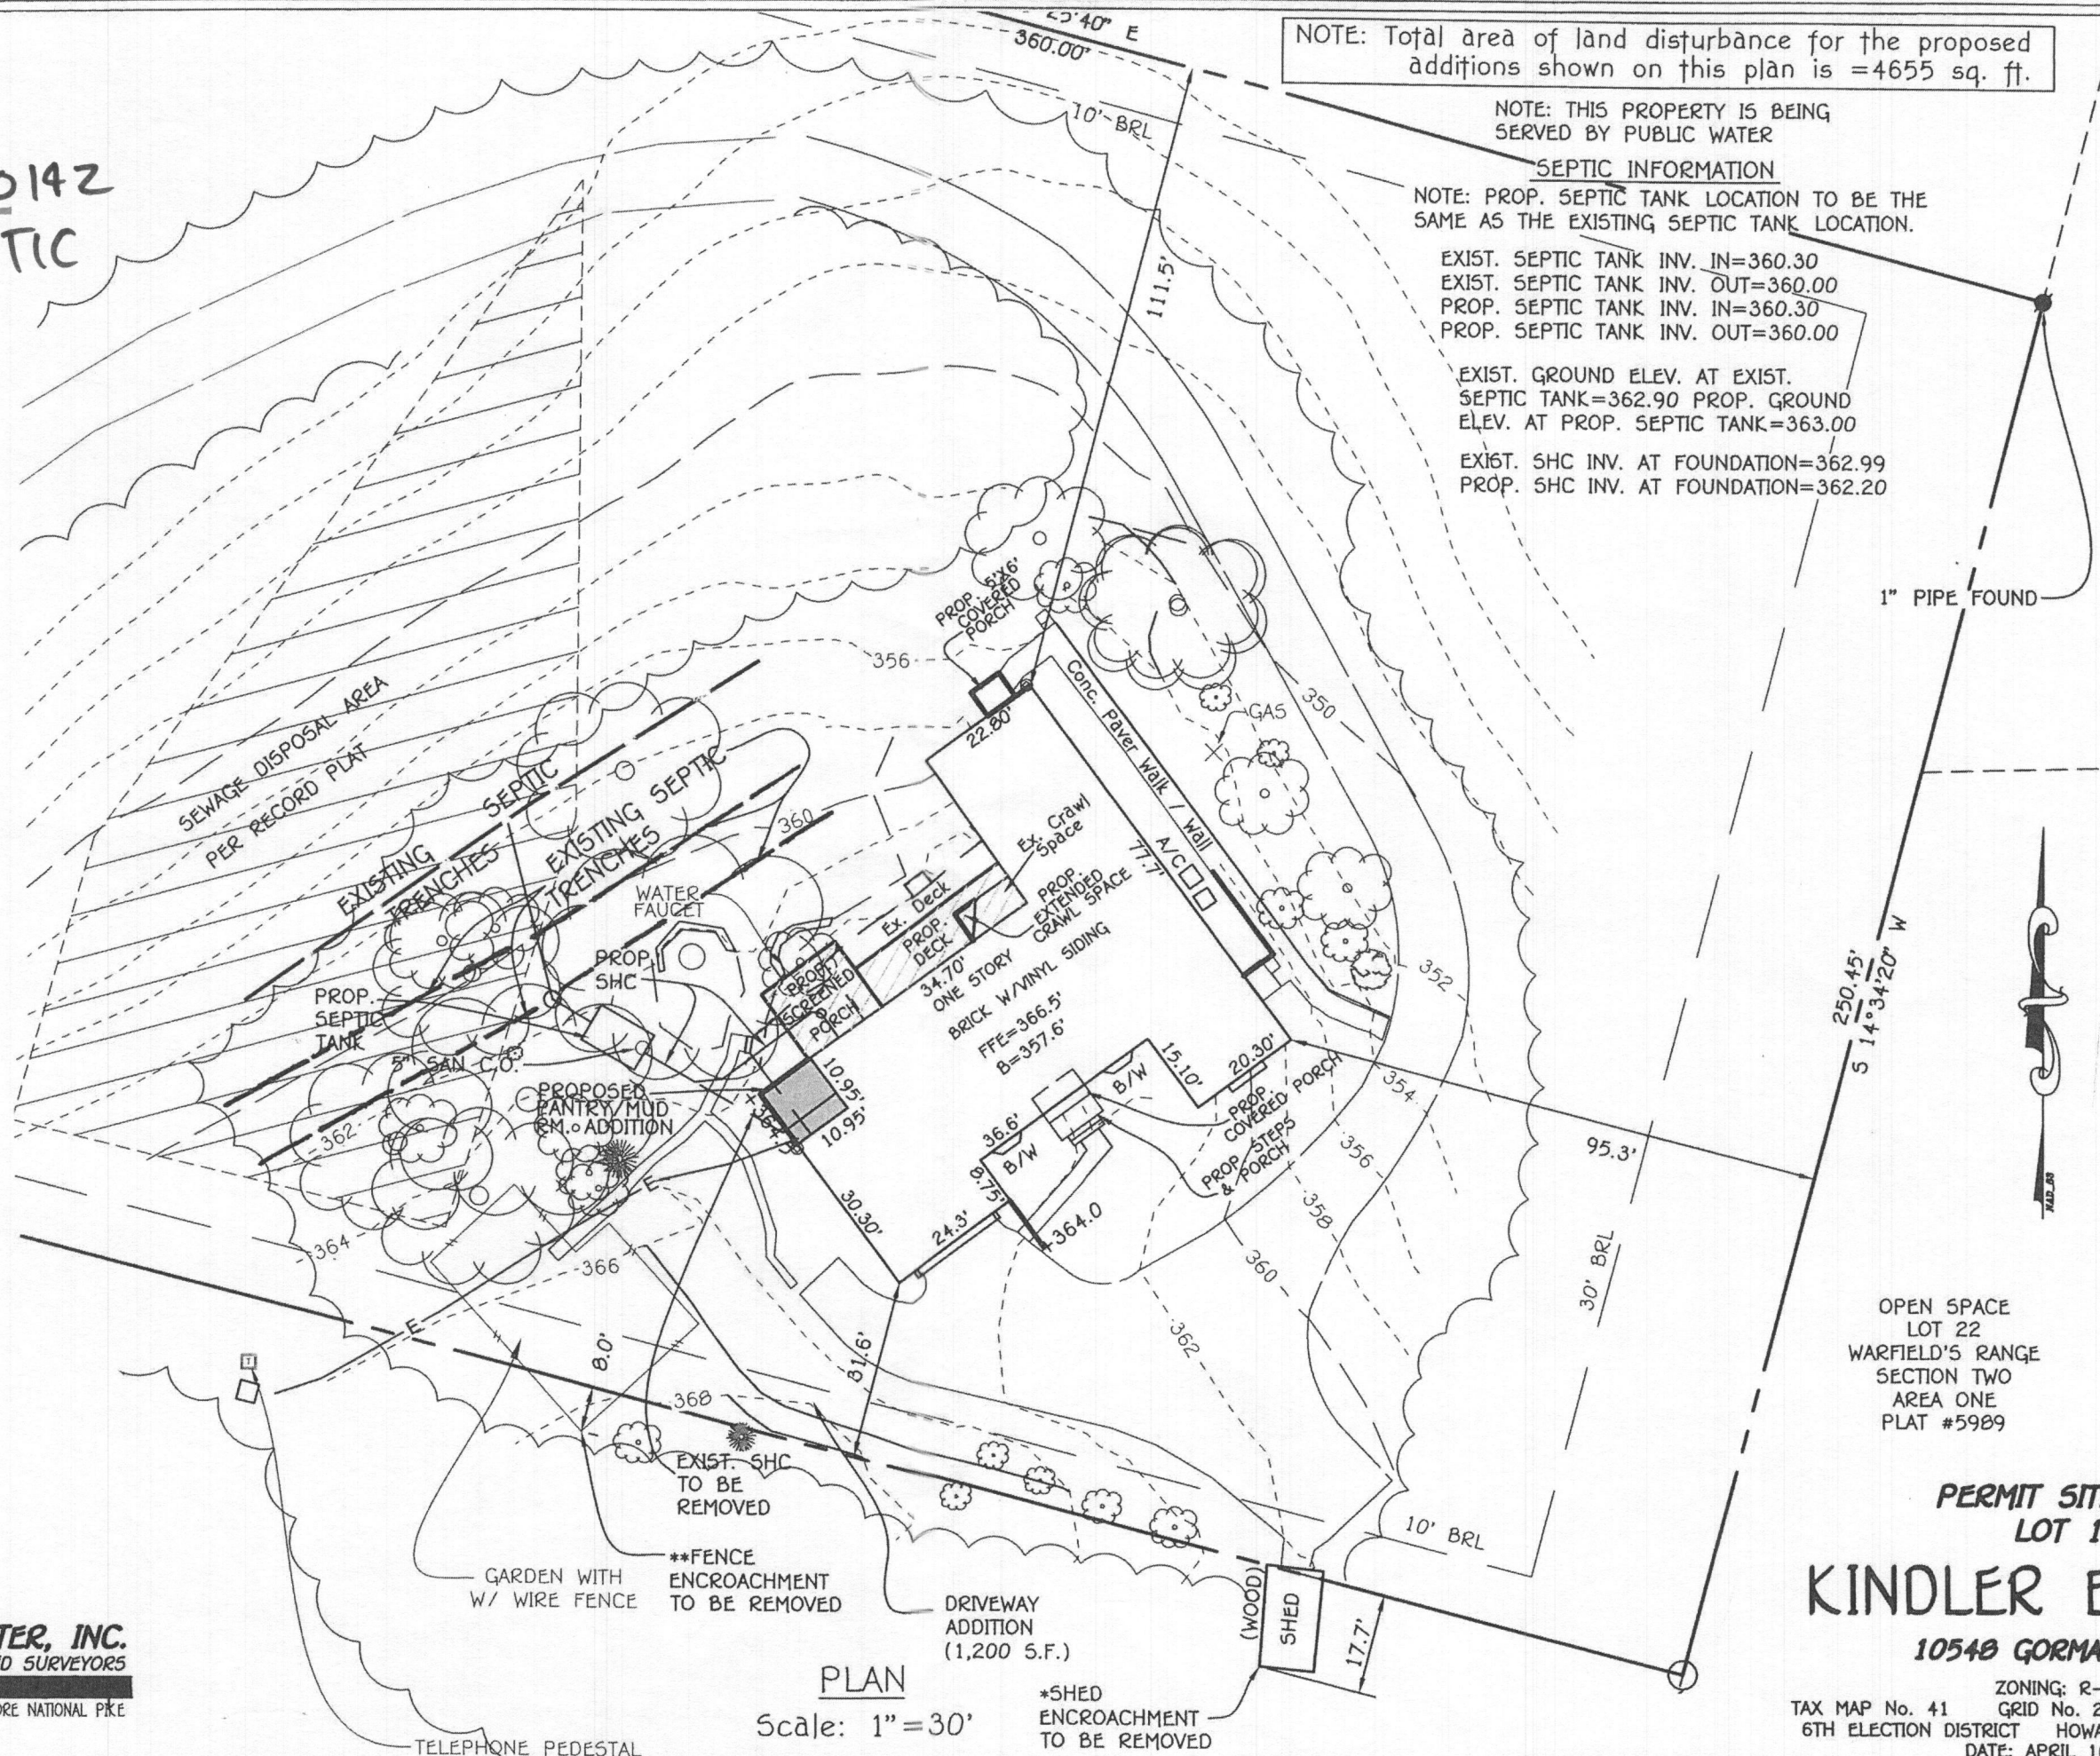

1" PIPE FOUND

250.45'
 S 14°34'20" W



OPEN SPACE
 LOT 22
 WARFIELD'S RANGE
 SECTION TWO
 AREA ONE
 PLAT #5989

PERMIT SITE PLAN
 LOT 11
KINDLER ESTATES
 10548 GORMAN ROAD

ZONING: R-20
 TAX MAP No. 41 GRID No. 24 PARCEL No. 424
 6TH ELECTION DISTRICT HOWARD COUNTY, MARYLAND
 DATE: APRIL 16, 2019

OWNER
 LISA R. APPLER
 MARTIN STEVEN APPLER
 10548 GORMAN ROAD
 LAUREL, MD 20723

FISHER, COLLINS & CARTER, INC.
 CIVIL ENGINEERING CONSULTANTS & LAND SURVEYORS
 CENTENNIAL SQUARE OFFICE PARK - 10272 BALTIMORE NATIONAL PKE
 ELLICOTT CITY, MARYLAND 21042
 (410) 461 - 2855

PLAN
 Scale: 1"=30'

GARDEN WITH W/ WIRE FENCE
 **FENCE ENCROACHMENT TO BE REMOVED

DRIVEWAY ADDITION
 (1,200 S.F.)

*SHED ENCROACHMENT TO BE REMOVED

TELEPHONE PEDESTAL