
 WATER WELL ABANDONMENT-SEALING REPORT FORM

SUBMIT COPIES OF COMPLETED FORM TO:

- * COUNTY ENVIRONMENTAL AGENCY (contact MDE, WMA if address needed)
- * WELL OWNER
- * MDE, WATER MANAGEMENT ADMINISTRATION, WELL PROGRAM

APPROVED
 07/22/2019

DATE WELL ABANDONED: 6-7-19 (month/day/year)

* PERMIT NUMBER OF ABANDONED WELL (if any) _____


* PERMIT NUMBER OF REPLACEMENT WELL: _____

* PERSON ABANDONING WELL: Andrew Houseman WELL DRILLER'S LICENSE NUMBER: 224

* OWNER'S NAME: SEH Excavating Cont. CIRCLE: MWD / MSD / MGD

* WELL LOCATION:
 COUNTY: Howard
 NEAREST TOWN: Laurel
 TAX MAP 50 BLOCK _____ PARCEL 384
 SUBDIVISION: _____
 SECTION: _____ LOT: _____
 STREET ADDRESS: 10101 North 2nd Street

SITE LOCATION MAP

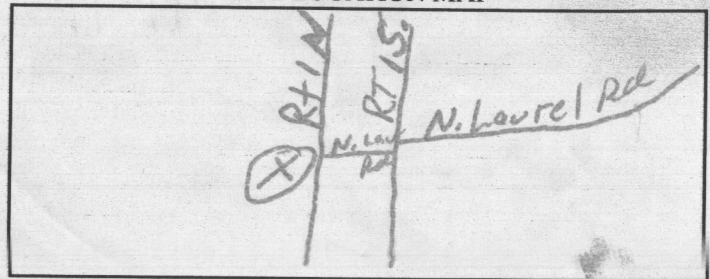

LOG OF SEALING MATERIAL

MATERIAL	FEET	
	FROM	TO
Concrete	12	0
VOLUME OF MATERIAL USED		
Concrete 5.5 yards		

* TYPE OF WELL BEING ABANDONED:
 DRILLED JETTED
 BORED HAND DUG
 OTHER (specify) _____

* USE CODE:
 DOMESTIC MUNICIPAL/PUBLIC
 IRRIGATION INDUSTRIAL
 TEST/OBSERVATION GEOTHERMAL

* TYPE OF CASING:
 STEEL PLASTIC
 CONCRETE OTHER (specify) _____

SIZE OF CASING: 42" INCHES IN DIAMETER

DEPTH OF WELL: 12 FEET DEEP

WAS ANY CASING REMOVED? YES NO
 If yes, length removed, in feet: _____

WAS CASING RIPPED OR PERFORATED? YES NO

SIGNATURE-MASTER WELL DRILLER OR SUPERVISING SANITARIAN LICENSE#

224

MWD / MSD / MGS
 CIRCLE ONE

6-7-19
 DATE

COUNTY

Pursuant to § 10-624 of the State Govt. Article of the Maryland Code, personal info requested on this form is used in processing this form pursuant to COMAR 26.04.04. Failure to provide the info may result in this form not being processed. You have the right to inspect, amend, or correct this form. The Maryland Department of the Environment is subject to the Maryland Public Information Act. This form may be made available on the Internet via MDE's website and is subject to inspection or copying, in whole or in part, by the public and other governmental agencies, if not protected by federal or State Law.

1110.86
 Paul

Real Property Data Search (w4)

Search Result for HOWARD COUNTY

[View Map](#) [View GroundRent Redemption](#) [View GroundRent Registration](#)

Tax Exempt: **Special Tax Recapture:**
Exempt Class: NONE

Account Identifier: **District - 06 Account Number - 601456**

Owner Information

Owner Name: HOWARD COUNTY MARYLAND **Use:** EXEMPT COMMERCIAL
 DEPT OF PUBLIC WORKS **Principal Residence:** NO
Mailing Address: 3430 COURT HOUSE DR **Deed Reference:** /18452/ 00464
 ELLICOTT CITY MD 21043-

Location & Structure Information

Premises Address: NORTH SECOND ST **Legal Description:** PAR. G 2.4454 A. OPEN SPACE
 LAUREL 20723-0000 NORTH SECOND ST
 LAUREL PARK STATION, PH 1

Map:	Grid:	Parcel:	Sub District:	Subdivision:	Section:	Block:	Lot:	Assessment Year:	Plat No:	Plat Ref:	
0050	0010	0384		4740			PAR G	2017			24740-53

Special Tax Areas: **Town:** NONE
Ad Valorem:
Tax Class:

Primary Structure Built **Above Grade Living Area** **Finished Basement Area** **Property Land Area** **County Use**
 2.4454 AC

Stories **Basement** **Type** **Exterior** **Full/Half Bath** **Garage** **Last Major Renovation**

Value Information

	Base Value	Value	Phase-in Assessments	
		As of	As of	As of
		01/01/2017	07/01/2018	07/01/2019
Land:	2,700	2,700		
Improvements	0	0		
Total:	2,700	2,700		2,700
Preferential Land:	0			0

Transfer Information

Seller: 20006 DELAWARE INC **Date:** 11/19/2018 **Price:** \$0
Type: NON-ARMS LENGTH OTHER **Deed1:** /18452/ 00464 **Deed2:**

Seller: **Date:** **Price:**
Type: **Deed1:** **Deed2:**

Seller: **Date:** **Price:**
Type: **Deed1:** **Deed2:**

Exemption Information

Partial Exempt Assessments:	Class	07/01/2018	07/01/2019
County:	500	0.00	2,700.00
State:	500	0.00	2,700.00
Municipal:	500	0.00 0.00	0.00 0.00

Tax Exempt: **Special Tax Recapture:**
Exempt Class: NONE

Homestead Application Information

Homestead Application Status: No Application

Homeowners' Tax Credit Application Information

Homeowners' Tax Credit Application Status: No Application **Date:**