

C1 9300 SEQUENCE NO. (MDE USE ONLY)

STATE OF MARYLAND WELL COMPLETION REPORT FILL IN THIS FORM COMPLETELY PLEASE TYPE

THIS REPORT MUST BE SUBMITTED AFTER WELL IS COMPLETED. COUNTY NUMBER A58527 B

ST/CO USE ONLY DATE Received MM 12 DD 24 YY 98

DATE WELL COMPLETED MM 12 DD 24 YY 98 Depth of Well 22 300 26 (TO NEAREST FOOT)

PERMIT NO. FROM "PERMIT TO DRILL WELL" HO-94-1952

OWNER Anderson last name Old Frederick Road first name TOWN Woodstock SUBDIVISION Shadow Shade SECTION LOT 2

WELL LOG Table with columns: DESCRIPTION, FEET (FROM, TO), check if water bearing. Includes entries for Top Soil, Sand shale, Clay, Sand silt, Clay, Sandstone, Mica, Sandstone, Mica Flint mixed.

GROUTING RECORD WELL HAS BEEN GROUTED (Y) (N) TYPE OF GROUTING MATERIAL (C) (M) (B) (C) CEMENT BENTONITE CLAY NO. OF BAGS 22 NO. OF POUNDS 2200 GALLONS OF WATER 110 DEPTH OF GROUT SEAL (to nearest foot) from 0 ft. to 54 ft.

CASING RECORD casing types insert appropriate code below MAIN CASING TYPE (S) (T) (6) (70) Nominal diameter top (main) casing (nearest inch)! Total depth of main casing (nearest foot)

OTHER CASING (if used) diameter inch depth (feet) from to

SCREEN RECORD screen type or open hole (S) (T) (B) (R) (H) (O) (P) (L) (O) (T) (O) (T) STEEL BRASS OPEN HOLE BRONZE PLASTIC OTHER

NUMBER OF UNSUCCESSFUL WELLS: 0 WELL HYDROFRACTURED (Y) (N)

CIRCLE APPROPRIATE LETTER A A WELL WAS ABANDONED AND SEALED WHEN THIS WELL WAS COMPLETED E ELECTRIC LOG OBTAINED P TEST WELL CONVERTED TO PRODUCTION WELL

I HEREBY CERTIFY THAT THIS WELL HAS BEEN CONSTRUCTED IN ACCORDANCE WITH COMAR 26.04.04 "WELL CONSTRUCTION" AND IN CONFORMANCE WITH ALL CONDITIONS STATED IN THE ABOVE CAPTIONED PERMIT.

DRILLERS LIC. NO. MW D 040 DRILLERS SIGNATURE George F. Easterday LIC. NO. MW D 501

SITE SUPERVISOR (sign. of driller or journeyman responsible for sitework if different from permittee)

DEPTH (nearest ft.) 1 2 3 76

GRAVEL PACK IF WELL DRILLED WAS FLOWING WELL INSERT F IN BOX 68 MDE USE ONLY (NOT TO BE FILLED IN BY DRILLER) T (E.R.O.S.) W Q TELESCOPE CASING LOG INDICATOR OTHER DATA

PUMPING TEST HOURS PUMPED (nearest hour) 3 PUMPING RATE (gal. per min.) 8.5 METHOD USED TO MEASURE PUMPING RATE Bucket WATER LEVEL (distance from land surface) BEFORE PUMPING 24 ft. WHEN PUMPING 71 ft. TYPE OF PUMP USED (for test) (A) air (P) piston (T) turbine (C) centrifugal (R) rotary (O) other (describe below) (J) jet (S) submersible

PUMP INSTALLED DRILLER INSTALLED PUMP (CIRCLE) (YES) (NO) IF DRILLER INSTALLS PUMP, THIS SECTION MUST BE COMPLETED FOR ALL WELLS. TYPE OF PUMP INSTALLED PLACE (A,C,J,P,R,S,T,O) IN BOX 29. CAPACITY: GALLONS PER MINUTE (to nearest gallon) 31 35 PUMP HORSE POWER 37 41 PUMP COLUMN LENGTH (nearest ft.) 43 47 CASING HEIGHT (circle appropriate box and enter casing height) (+) above (2) (nearest foot) (-) below

LOCATION OF WELL ON LOT SHOW PERMANENT STRUCTURES AND INDICATE NOT LESS THAN TWO DISTANCES (MEASUREMENTS TO WELL) well 10' 45' Old Frederick Rd. Side line

B 1 2439

SEQUENCE NO. (MDE USE ONLY)

STATE OF MARYLAND PERMIT TO DRILL WELL please print or type

STATE PERMIT NUMBER

HO-94-1952 fill in this form completely

Date Received (APA)

10-5-98

OWNER INFORMATION RN 7621

Anderson Debra

15 Last Name Owner First Name 34

7057 Mink Hollow Rd

36 Street or RFD 55

Highland, Md 20977

57 Town 70 State 72 Zip 76

DRILLER INFORMATION

George F. Easterday

M W D 040

Driller's Name 76 License No. 81

L. Franklin Easterday, Inc.

Firm Name

9265 Brown Church Rd., MT. Airy, Md. 21771

Address

Signature: George F. Easterday Date: 10/2/1998

B 2 WELL INFORMATION APPROX. PUMPING RATE (GAL. PER MIN.) 5

AVERAGE DAILY QUANTITY NEEDED (GAL. PER DAY) 14 500 20

USE FOR WATER (CIRCLE APPROPRIATE BOX)

- DOMESTIC POTABLE SUPPLY & RESIDENTIAL IRRIGATION
FARMING (LIVESTOCK WATERING & AGRICULTURAL IRRIGATION)
INDUSTRIAL, COMMERCIAL, DEWATERING
PUBLIC WATER SUPPLY WELL
TEST, OBSERVATION, MONITORING
GEO-THERMAL

APPROXIMATE DEPTH OF WELL 300 FEET

APPROXIMATE DIAMETER OF WELL 6 INCH

METHOD OF DRILLING (circle one)

- BORED (or Augered) JETTED Jetted & DRIVEN
AIR-ROTary AIR-PERcussion ROTARY (Hydraulic Rotary)
CABLE REVerse-ROTary DRive-POINT

REPLACEMENT OR DEEPEINED WELLS (CIRCLE APPROPRIATE BOX)

- THIS WELL WILL NOT REPLACE AN EXISTING WELL
THIS WELL WILL REPLACE A WELL THAT WILL BE ABANDONED AND SEALED
THIS WELL WILL REPLACE A WELL THAT WILL BE USED AS A STANDBY-CONTACT LOCAL APPROVING AUTHORITY FOR POLICY ON STANDBY WELLS
THIS WELL WILL DEEPEIN AN EXISTING WELL

PERMIT NUMBER OF WELL TO BE REPLACED OR DEEPEINED (IF AVAILABLE) 41

Not to be filled in by driller (MDE OR COUNTY USE ONLY)

APPROP. PERMIT NUMBER 54 G A P 63

PERMIT No. HO-94-1952

SPECIAL CONDITIONS

NOTE - APPROVING AUTHORITIES SHOULD USE SEPARATE SHEET IF NEEDED -

B 3 HOWARD LOCATION OF WELL CC#

8 COUNTY 21

Shadow Shade

23 SUBDIVISION 42

SECTION 44 46 LOT 2 48 50


Woodstock

52 NEAREST TOWN 71

MILES FROM TOWN (enter 0 if in town) 1 M I 73 76 77 78

B 4 1 2

DIRECTION OF WELL FROM TOWN (CIRCLE BOX)

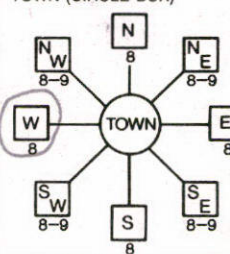

Old Frederick Rd

11 NEAR WHAT ROAD 30

ON WHICH SIDE OF ROAD (CIRCLE APPROPRIATE BOX)



34 450 37 DISTANCE FROM ROAD ENTER FT OR MI 38 39

TAX MAP: BLK: PARCEL

NOT TO BE FILLED IN BY DRILLER HEALTH DEPARTMENT APPROVAL

Howard H58527B

COUNTY NAME COUNTY NO.

STATE SIGNATURE INSERT S

DATE ISSUED 11/5/98 Kim Maitland 11/5/99

43 MM DD YY 48 CO SIGNATURE EXP. DATE

NORTH GRID 542 000 EAST GRID 831 000

SHOW MAJOR FEATURES OF BOX & LOCATE WELL WITH AN X


SOURCES OF DRILLING WATER 1. wells

WRITE THE BOX NUMBER FROM THE MAP HERE

E 830 1 N 540 2


Handwritten notes: 12/7/98 Groat 1:00 location appears ok - no prep. state. CA open 20' long cement 70' casing

DRAW A SKETCH BELOW SHOWING LOCATION OF WELL IN RELATION TO NEARBY TOWNS AND ROADS AND GIVE DISTANCE FROM WELL TO NEAREST ROAD JUNCTION

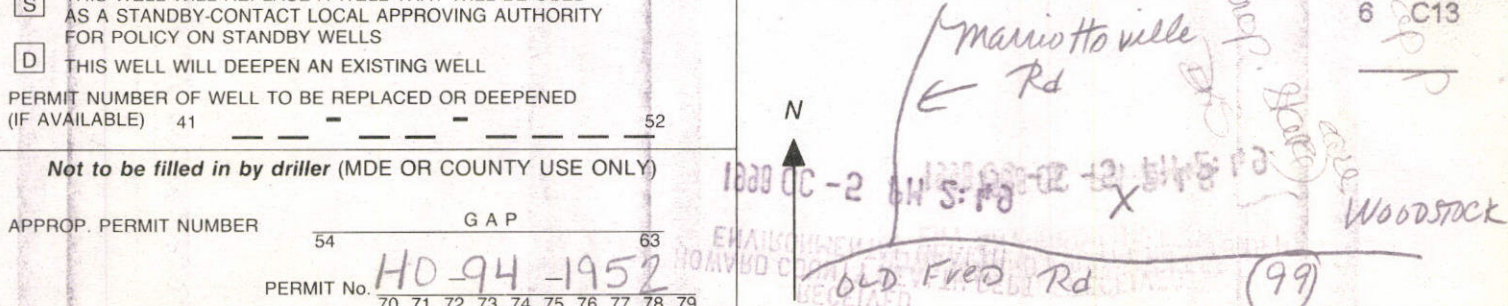





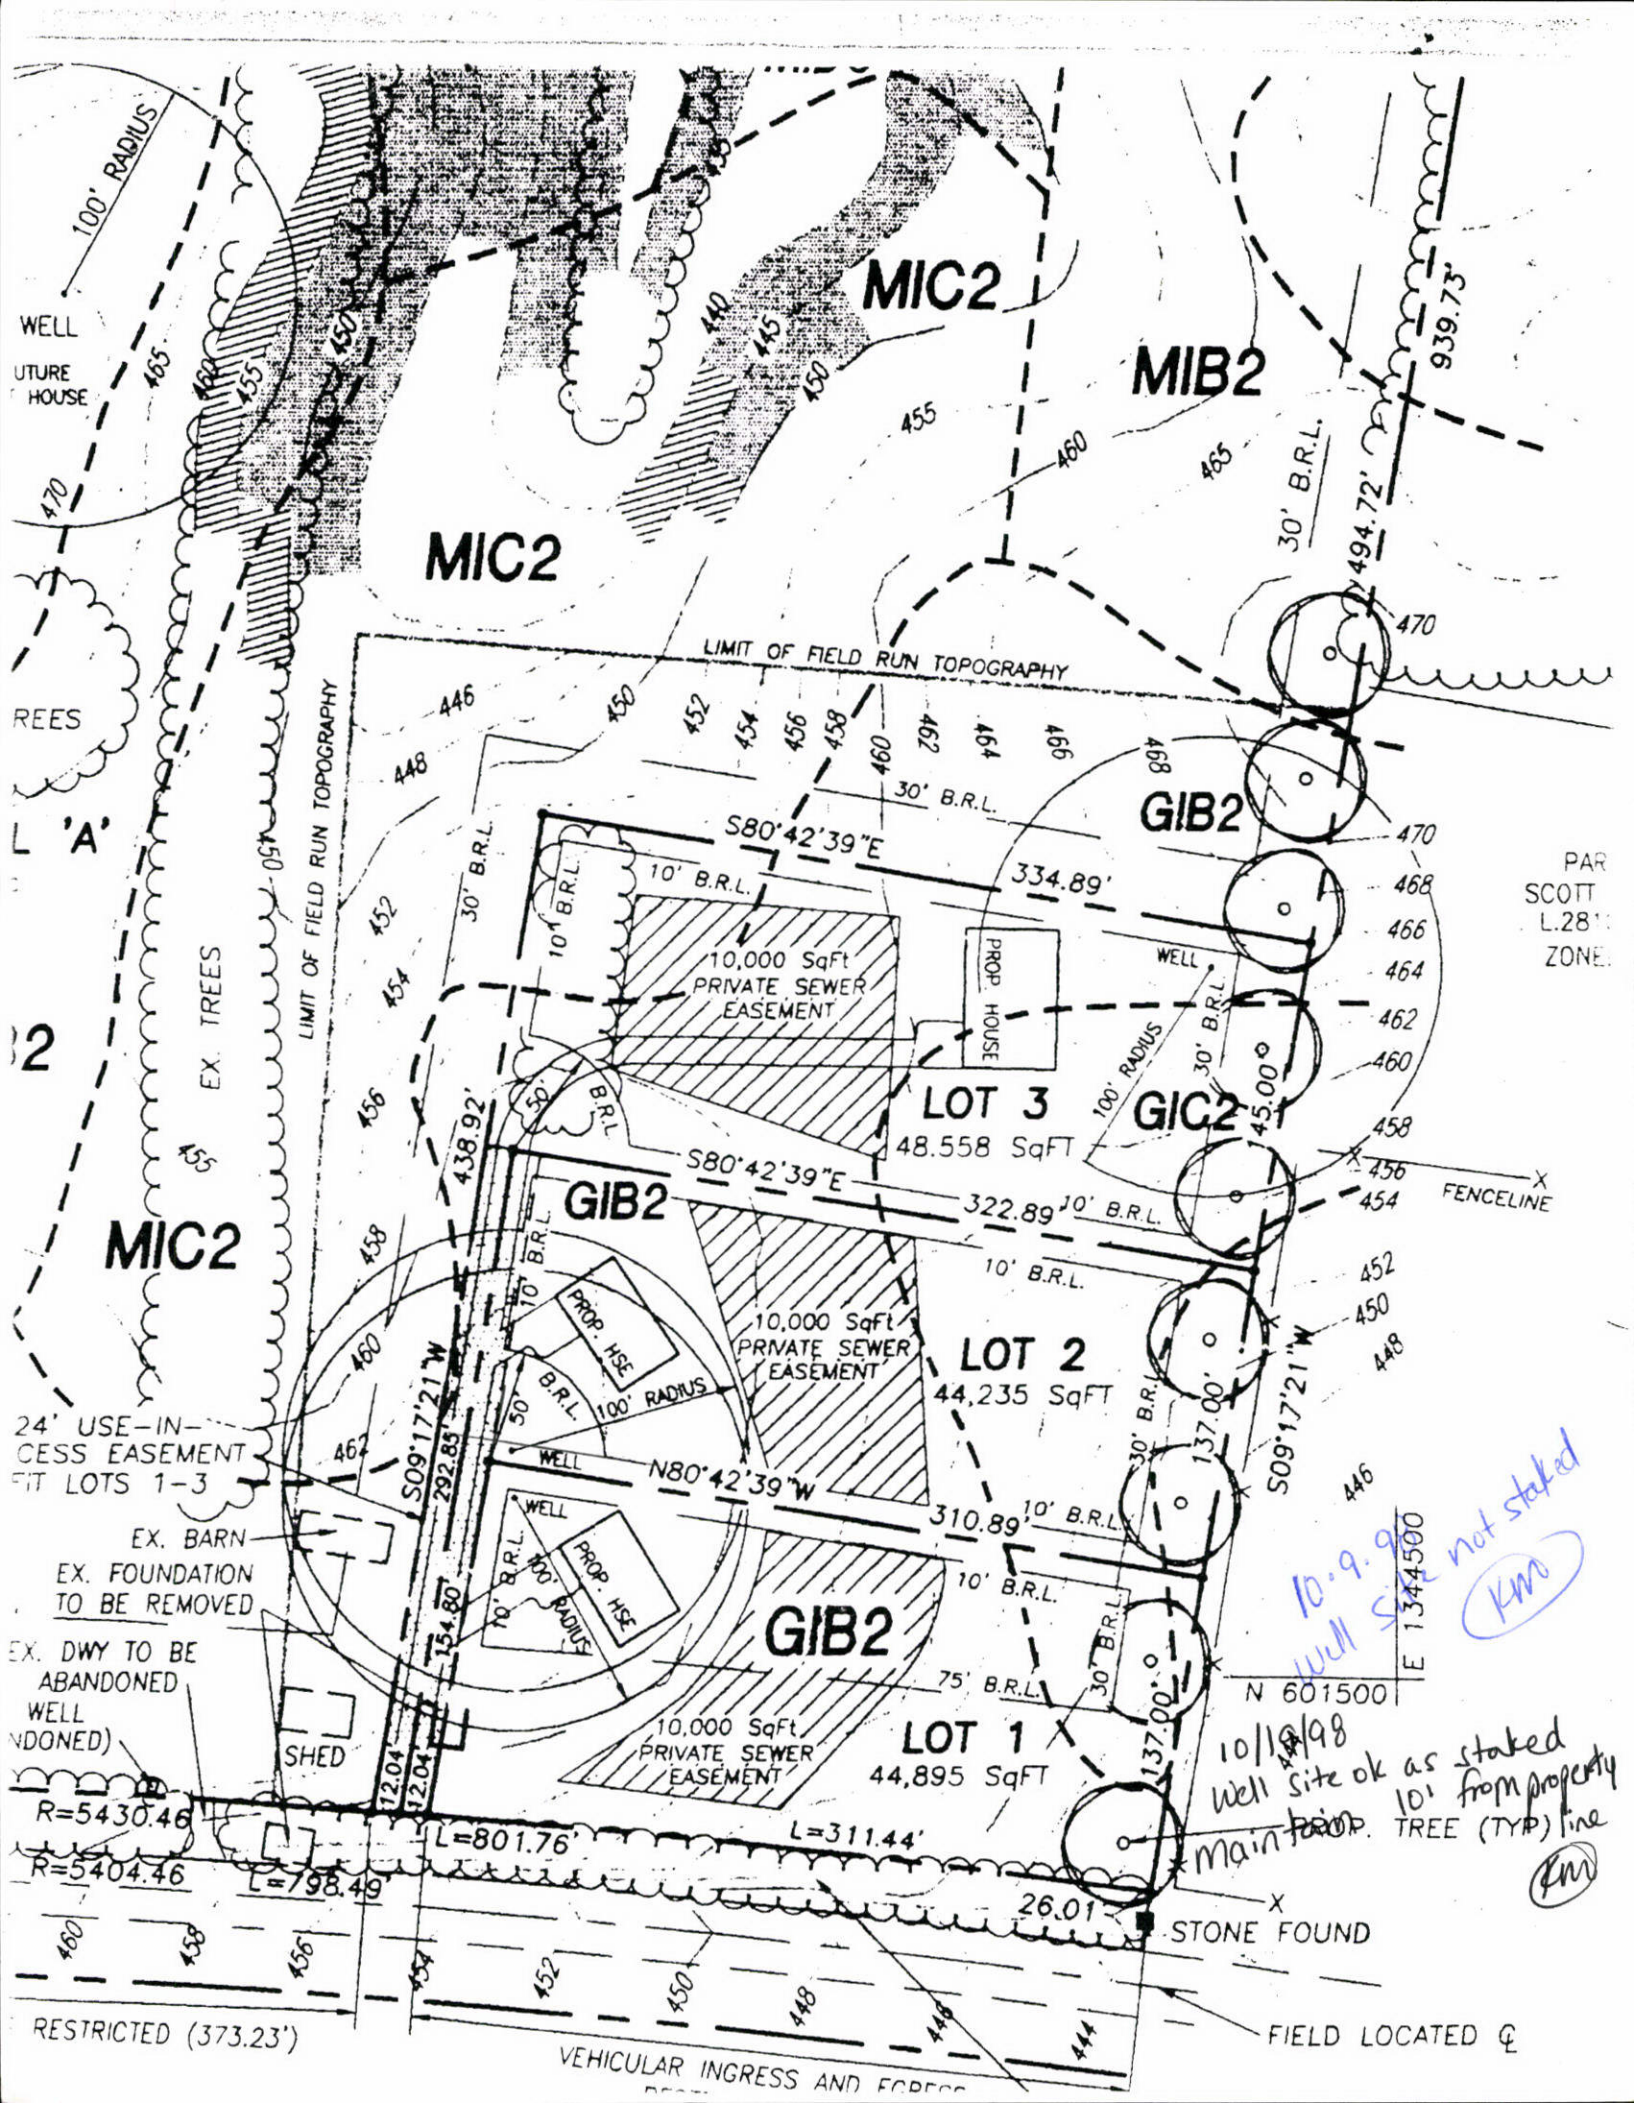

MIC2

MIB2

MIC2

GIB2

GIC2

GIB2

GIB2

LOT 3  
48,558 SqFt

LOT 2  
44,235 SqFt

LOT 1  
44,895 SqFt

10,000 SqFt  
PRIVATE SEWER  
EASEMENT

10,000 SqFt  
PRIVATE SEWER  
EASEMENT

10,000 SqFt  
PRIVATE SEWER  
EASEMENT

WELL  
UTURE HOUSE

REES

'A'

2

MIC2

24' USE-IN-  
ACCESS EASEMENT  
FIT LOTS 1-3

EX. BARN  
EX. FOUNDATION  
TO BE REMOVED

EX. DWY TO BE  
ABANDONED  
WELL  
(NDONED)

SHED

R=5430.46

R=5404.46

RESTRICTED (373.23')

LIMIT OF FIELD RUN TOPOGRAPHY

LIMIT OF FIELD RUN TOPOGRAPHY

EX. TREES

580'42'39" E

580'42'39" E

N80'42'39" W

S09'17'21" W

S09'17'21" W

L=801.76'

L=311.44'

N 601500

E 1344500

FENCELINE

WELL

WELL


10-9-98  
Well site ok as staked  
10' from property  
TREE (TYP) line  
KMO

Main STONE FOUND

FIELD LOCATED @

VEHICULAR INGRESS AND EGRESS

PAR  
SCOTT  
L.2811  
ZONE

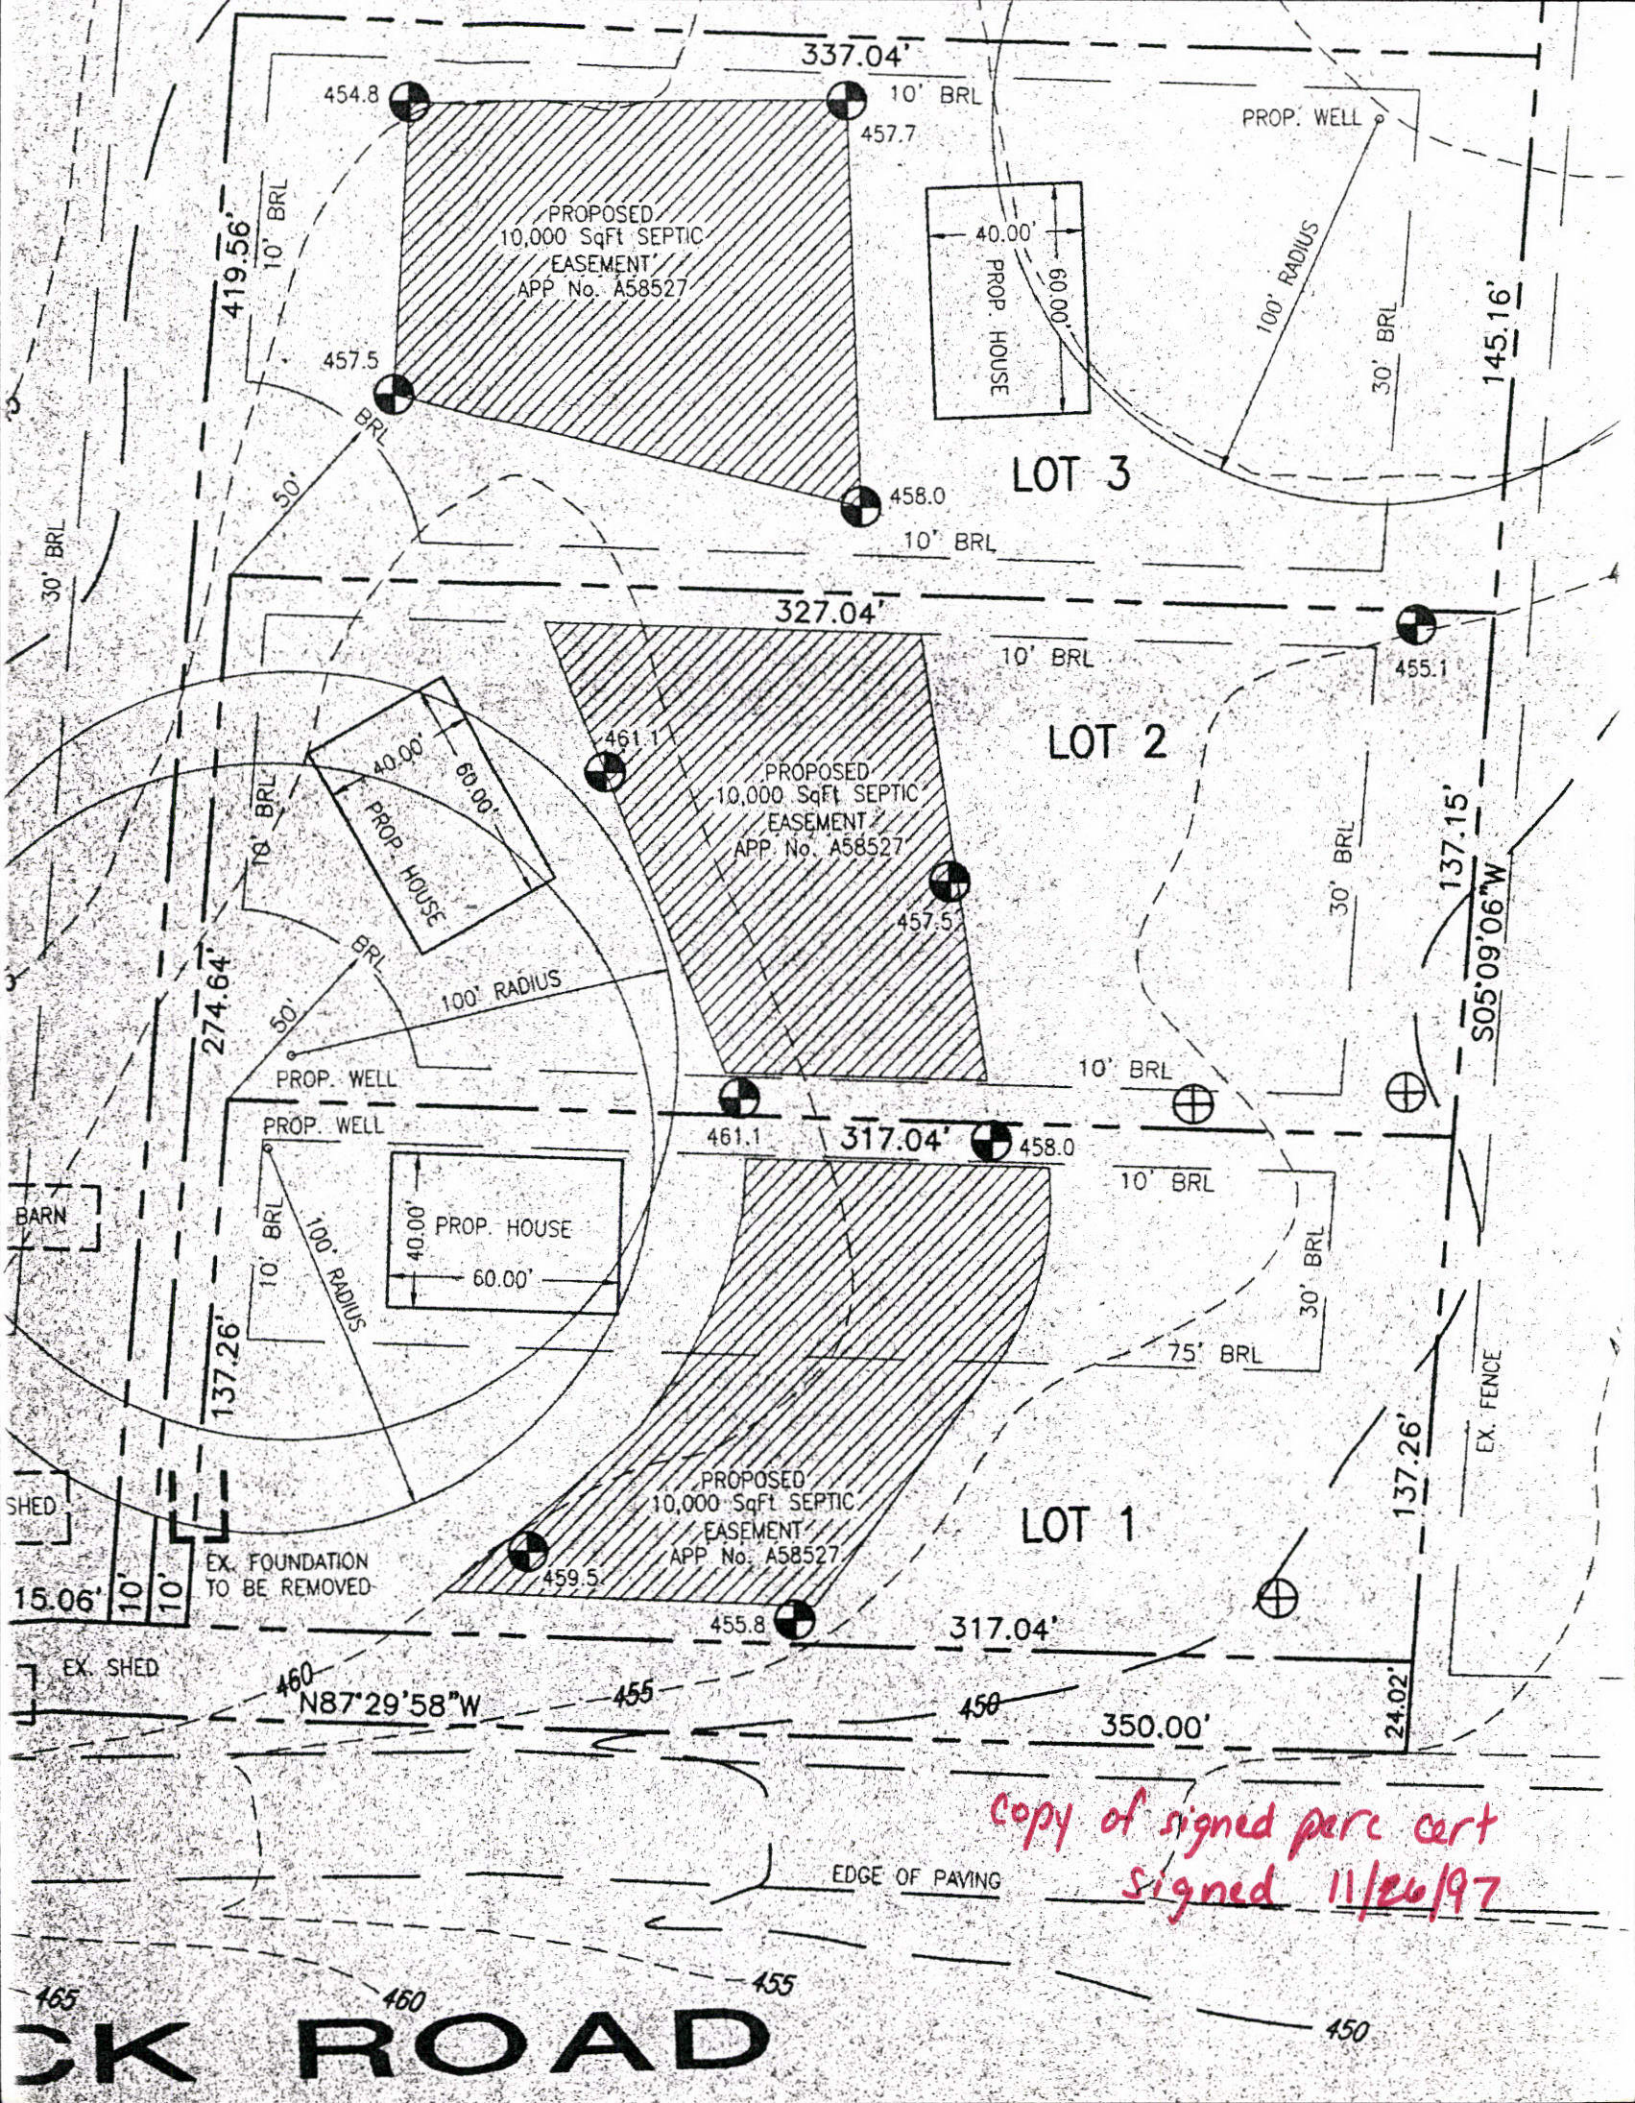

Copy of signed perc cert  
 signed 11/26/97

CK ROAD