

**COMPLETE THIS FORM WHEN DROPPING OFF ANY  
CORRESPONDENCE AND/OR PLANS TO THE HOWARD COUNTY  
DEPARTMENT OF INSPECTIONS, LICENSES AND PERMITS COUNTER:**

Date: 5/1/19

To: Ryan Rappaport  
(Person's Name and Division)

From: Michelle Cleary 443 610 7514  
(Your Name, Company Name and Telephone Number)

Subject: Project name \_\_\_\_\_  
Project site address 13822 Mill Creek Ct  
Permit # B19001027 SDP # \_\_\_\_\_  
Other information pertinent to this project \_\_\_\_\_

- Please check the attachments below that you are submitting with this transmittal:
- Letter of response to address plan review comment letter
  - Revised plans and/or revised details: When submitting for a complete re-review, **duplicate sets shall be submitted.**
  - Letter Summarizing Changes
  - Energy conservation calculations
  - Copies of Site Plan (be specific). Review location
  - Health Department Request  DPZ/ DED Request  Applicant's Request
  - Two sets of single family dwelling model plans to be placed on permanent file: Model name and/or # \_\_\_\_\_
  - Other \_\_\_\_\_

**Contact Person Information: (Required)**

Michelle Cleary  
Please Print Name

Telephone No: 443 610 7514  
E-Mail Address: Michelle.Rappaport@approved.com


**PLEASE ASSURE ALL DOCUMENTS AND/OR REVISIONS ARE APPROPRIATELY SIGNED AND SEALED, IF NECESSARY, BY A LICENSED ARCHITECT OR ENGINEER. PLEASE BE ADVISED THAT INSUFFICIENT INFORMATION MAY RESULT IN THE DELAY OF REVIEW BY THE PLANS EXAMINER. THE DEPARTMENT OF INSPECTIONS, LICENSES AND PERMITS WILL CONTACT YOU IF THERE IS A PROBLEM. IN ADDITION, ONCE THE BUILDING PERMIT IS APPROVED BY THE PLAN REVIEW DIVISION AND ALL OTHER REQUIRED SIGNATORY AGENCIES, AND THE BUILDING PERMIT IS READY FOR ISSUANCE, THE PERMIT DIVISION WILL NOTIFY THE APPROPRIATE CONTACT PERSON FOR PERMIT PICK UP. ALL PERMIT STATUS INQUIRIES SHALL BE DIRECTED TO THE PERMIT DIVISION AT 410-313-2455. CODE RELATED QUESTIONS AND PLAN REVIEW INQUIRIES SHALL BE DIRECTED TO THE PLAN REVIEW DIVISION AT 410-313-2436. PLEASE ALLOW A MINIMUM OF FIVE (5) WORKING DAYS FOR ANY PLAN SUBMITTALS TO BE REVIEWED. THANK YOU.**

Received by LR

**RECEIVED**  
MAY 01 2019  
LICENSES & PERMITS  
DIVISION  
Health

Issued  
Permit  
25-  
7169  
RRA 5/13/19

STATE OF MARYLAND  
 DEPARTMENT OF NATURAL RESOURCES  
 LIBER 939 FOLIO 287  
 ZONED: RR-DEO

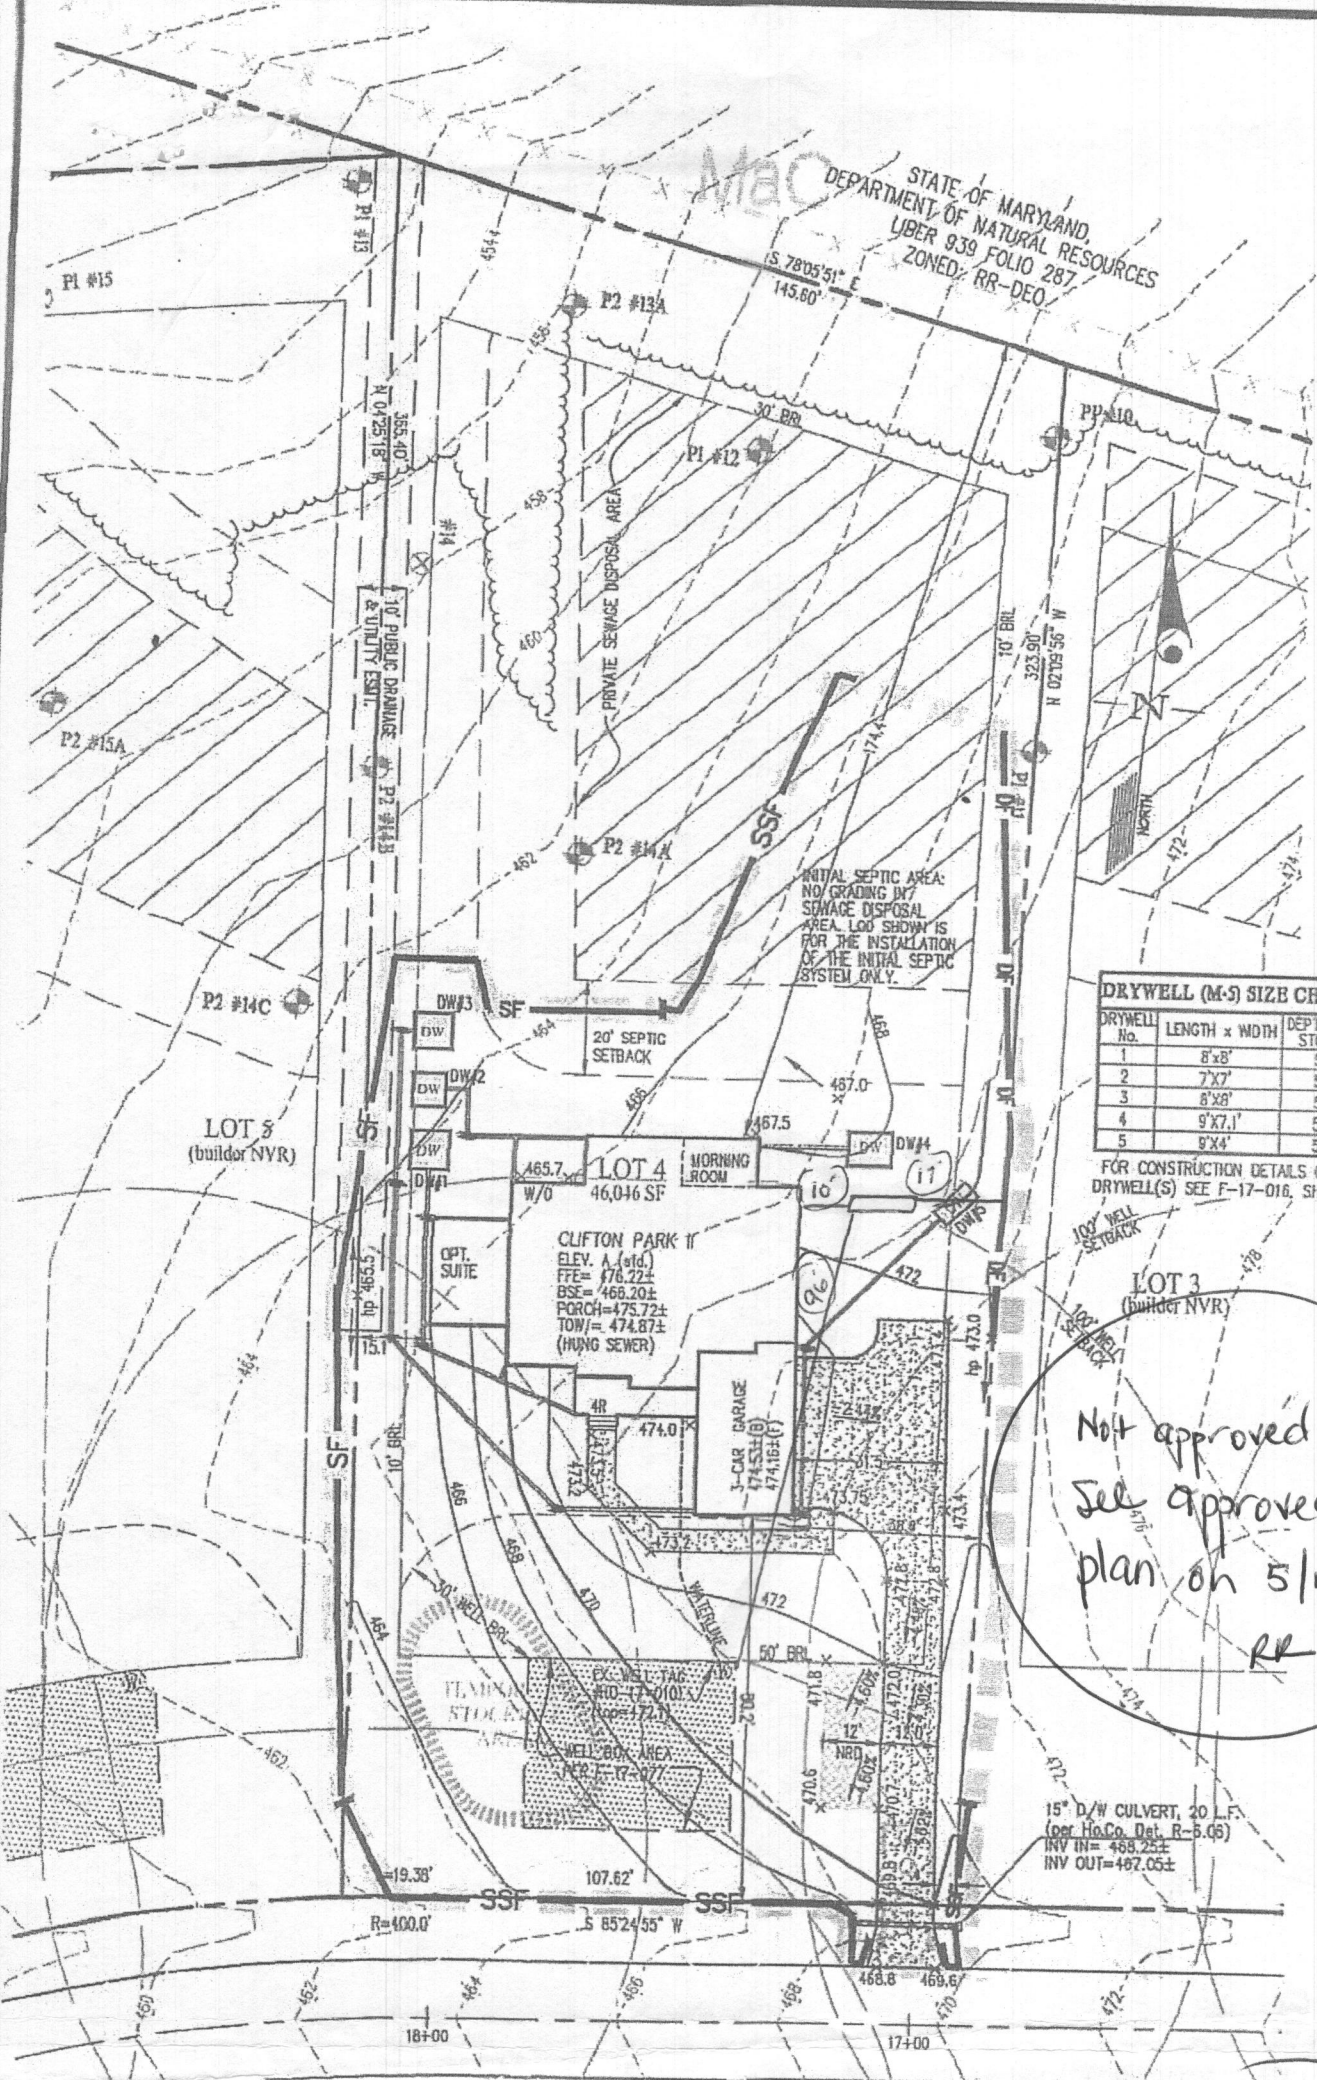

**DRYWELL (M-S) SIZE CHART**

DRYWELL No.	LENGTH x WIDTH	DEPTH OF STONE
1	8'x8'	5'
2	7'x7'	5'
3	8'x8'	5'
4	9'x7.1'	5'
5	8'x4'	5'

FOR CONSTRUCTION DETAILS OF DRYWELL(S) SEE F-17-016, SHEET 33.

Not approved  
 See approved  
 plan on 5/13/19  
 RR

MILL CREEK COURT  
 (PUBLIC ACCESS STREET)

NOTE: THE FRONT DOOR FOR LOT 4 FACES SOUTH.

BUILDING PERMIT PLOT PLAN

1"=40'



DES. NVR INC.  
 DRN. 9720 PATUXENTS WOODS DRIVE  
 COLUMBIA, MD 21045  
 PH: 410-379-5956  
 CHK.

CRAWFORD SUBDIVISION  
 LOT 4 (13822 MILL CREEK CT.)  
 Plat No. 24600-24607

G. L. W. No.	17071
ZONING	RR-DEO
TAX MAP/GRID	34&39-19&6
DATE	JAN. 2019
SCALE	1"=40'
SHEET	1 OF 1

1000 096 us TANK # R19000498

