



# APPLICATION

## FOR PERCOLATION TESTING AND SITE EVALUATION

TEST DATE(S) \_\_\_\_\_ TEST TIME \_\_\_\_\_

(AP) 55531010

AGENCY REVIEW: \_\_\_\_\_

DATE 11-12-14

DO NOT WRITE ABOVE THIS LINE

I HEREBY APPLY FOR THE NECESSARY TESTING/EVALUATION PRIOR TO ISSUANCE OF SEWAGE DISPOSAL SYSTEM PERMIT(S) TO:

CHECK AS NEEDED:

- CONSTRUCT NEW SEPTIC SYSTEM(S)
- REPAIR/ADD TO AN EXISTING SEPTIC SYSTEM
- REPLACE AN EXISTING SEPTIC SYSTEM

CHECK AS NEEDED:

- NEW STRUCTURE(S)
- ADDITION TO AN EXISTING STRUCTURE
- REPLACE AN EXISTING STRUCTURE

CHECK ONE:

- CREATE NEW LOT(S)
- BUILD ON AN EXISTING LOT IN A SUBDIVISION
- BUILD ON AN EXISTING PARCEL OF RECORD

IS THE PROPERTY WITHIN 2500' OF ANY RESERVOIR?

- YES
- NO

THE TYPE OF STRUCTURE IS:

- RESIDENTIAL WITH 4-5 PROPOSED BEDROOMS IN THE COMPLETED STRUCTURE (NOTE **UNKNOWN** IF APPROPRIATE)
- COMMERCIAL (PROVIDE DETAIL OF NUMBERS AND TYPES OF EMPLOYEES/ CUSTOMERS ON ACCOMPANYING PLAN)
- INSTITUTIONAL/GOVERNMENT (PROVIDE DETAIL OF NUMBERS AND TYPES OF EMPLOYEES/USERS ON ACCOMPANYING PLAN)

PROPERTY OWNER(S) THE WILBUR AND EVELYN HINKLE FAMILY LIMITED PARTNERSHIP (ATTN: PHILLIP HINKLE)

DAYTIME PHONE \_\_\_\_\_ CELL 443-864-7470 FAX 410-223-4341

MAILING ADDRESS 13915 KENNARD ROAD GLENELL MD 21737  
STREET CITY/TOWN STATE ZIP

APPLICANT WILLIAMSBURG GROUP LLC, BOB CORBETT

DAYTIME PHONE \_\_\_\_\_ CELL 410-977-3343 FAX 410-997-4358

MAILING ADDRESS 5485 HARPERS FARM Rd #200 COLUMBIA, MD 21044  
STREET CITY/TOWN STATE ZIP

APPLICANT'S ROLE:  DEVELOPER  BUILDER  BUYER  RELATIVE/FRIEND  REALTOR  CONSULTANT

PROPERTY LOCATION  
SUBDIVISION/PROPERTY NAME HINKLE PROPERTY LOT NO. 93 7

PROPERTY ADDRESS 12545 SCAGGSVILLE Rd HIGHLAND MD  
STREET TOWN/POST OFFICE

TAX MAP PAGE(S) 40 GRID \_\_\_\_\_ PARCEL(S) 93 PROPOSED LOT SIZE 50,000-60,000 SF 1 AC +/-

AS APPLICANT, I UNDERSTAND THE FOLLOWING: THE SYSTEM INSTALLED SUBSEQUENT TO THIS APPLICATION IS ACCEPTABLE ONLY UNTIL PUBLIC SEWERAGE IS AVAILABLE. THIS APPLICATION IS COMPLETE WHEN ALL APPLICABLE FEES AND A SUITABLE SITE PLAN HAVE BEEN RECEIVED. I ACCEPT THE RESPONSIBILITY FOR COMPLIANCE WITH ALL M.O.S.H.A. AND "MISS UTILITY" REQUIREMENTS. APPROVAL IS BASED UPON SATISFACTORY REVIEW OF A PERC CERTIFICATION PLAN.


TEST RESULTS WILL BE MAILED TO APPLICANT.

SIGNATURE OF APPLICANT

HOWARD COUNTY HEALTH DEPARTMENT, BUREAU OF ENVIRONMENTAL HEALTH, WELL AND SEPTIC PROGRAM  
7178 COLUMBIA GATEWAY DRIVE COLUMBIA, MARYLAND 21046 (410) 313-2640 FAX (410) 313-2648  
TDD (410) 313-2323 TOLL FREE 1-877-4MD-DHMH

Proposed Lot 7

AVP

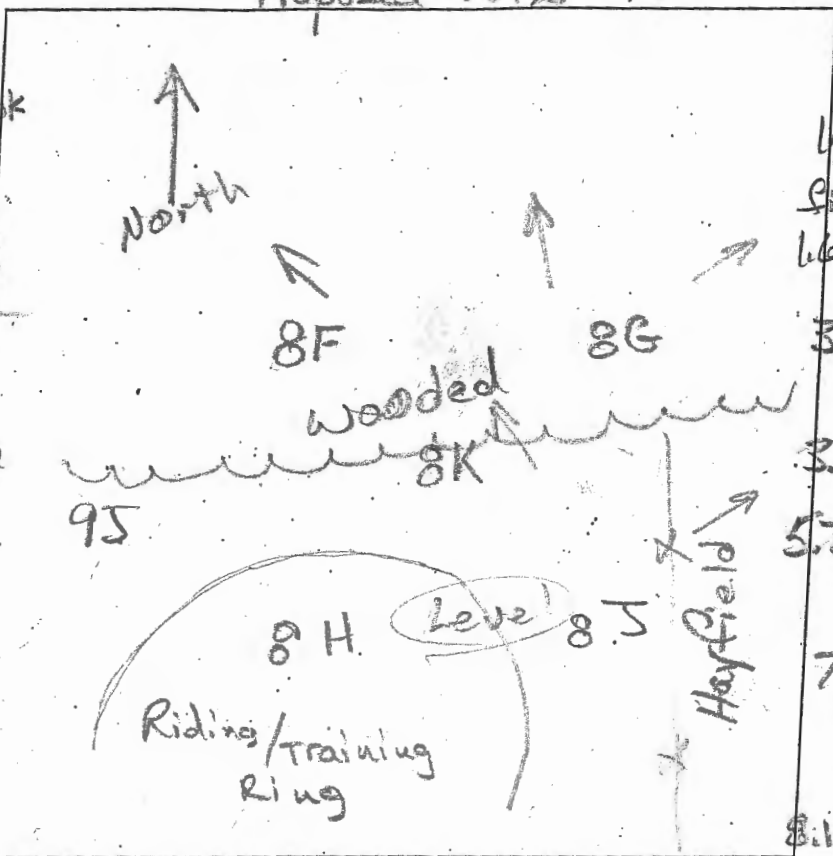

0.4' dk brn L 2 sbk  
 red-brn L  
 Thick platy  
 red L thick platy  
 few mica  
 25' red-yel & yel-brn sl  
 thick platy  
 common mica  
 3.8' red-yellow  
 lt. yel-brn sl  
 6' very pale brn  
 & dk. brn ls  
 thick platy  
 12' few mica

8H  
 brn L dm  
 4' red-yel L  
 1.5' blue-gray  
 fine crusher run  
 1.6' brn red L  
 thick platy  
 few mica  
 3' red & red-yel  
 sl thin platy  
 dense, few mica  
 3.6' red-yel chsl  
 5.7' dm, ss  
 red-yel sl  
 dm, dense  
 7' red-yel  
 & brn-yel ls.  
 thick platy  
 few mica  
 8.1' dk brn &  
 v. pale brn ls  
 thick platy  
 few mica  
 12'

8S  
 2' dk. brn L thick  
 to red L platy  
 red-yel & brn  
 sl thick platy  
 many mica  
 3.8' red-yel  
 pbsl, dm  
 5' red-yel dk. brn  
 & v. pale brn  
 ls. thick platy  
 12' many mica

8G  
 dk. brn L 2 sbk  
 red-brn L  
 thin platy  
 2' yel-red L  
 thick platy  
 2.5' yel-red L  
 thin platy  
 3.8' red-yel sl, few mica  
 brn-yel ls, mica  
 thick platy  
 7' red-yel, dk. brn  
 & very pale brn  
 ls, thick platy  
 12' few mica

DATE	TEST #	DEPTH	START	BREAK 1" DROP	STOP 2" DROP	TIME OF 2ND INCH	P/F/H
5/12/15	8K	53' 12'	12:57	1:01	1:18	9	P
5/12/15	8J	53' 12'	1:15	1:20	1:33	13	P
5/12/15	8G	12'	Visual	Sidewall 0.8 gpd/1.2"	3.8"-8"		P
5/12/15	8F	12'	Visual	Sidewall 1.2 gpd/1.2"	14"-8"		P
5/12/15	8H	8' 12'	2:27	2:29	2:32	3	P

8F  
 very dk. brn  
 L 2 v. sbk  
 yel-brn L  
 1 sbk  
 1.1' red & brn col  
 R v. sbk  
 2.5' red L, 3 v. sbk  
 red sl, thick platy  
 many mica  
 4' red & dk. brn  
 ls, thin platy  
 many mica  
 9.5' dk. brn & v. pale brn ls, thick platy, many fine mica.

REMARKS \_\_\_\_\_  
 SANITARIAN R Bricker BACKHOE Mike Johnson OTHERS \_\_\_\_\_  
 TEST HOLES USED IN SDA \_\_\_\_\_ AVG. PERC TIME \_\_\_\_\_ SQ. FT/BR \_\_\_\_\_  
 TRENCH WIDTH \_\_\_\_\_ INLET DEPTH \_\_\_\_\_ MAX. BOT DEPTH \_\_\_\_\_ EFFECTIVE SW \_\_\_\_\_

