



Howard County
Health Department

Bureau of Environmental Health
7178 Gateway Drive Columbia, MD 21046
(410) 313-2640 Fax (410) 313-2648
TDD (410) 313-2323 Toll Free 1-866-313-6300
website: www.hchealth.org

Maura J. Rossman, M.D., Health Officer

July 22, 2019

To Whom It May Concern:

George Streaker paid for a repair septic permit, in the amount of \$165.00 after the payment it was then found that the septic problem could be fixed with a minor septic repair which incurs the fee of \$55.00. No work was performed by the Health Dept. So therefore Mr. Streaker is requesting a refund in the amount of \$165.00. (receipt #64828). If you have any other questions please call Jeff Williams at 410-313-4261.

Mail Check To
Clear View Farm
13370 State Route 144
West Friendship, Md 21794

#64828 04/11/2019 written by: Juanita King
#95875 04/11/2019 written by: Willie Sims

Thanks in advance,


Juanita King ext: 4251


Jeff Williams
Well & Septic Supervisor

4-11-19

I George Straker would like to get a refund for
165.00 dollars Because We did NOT NEED THE
PERKULOSUN TEST FOR 13540 RT 144 WEST FRIENDSHIP

SEND TO Clear View Farm 13370 STATE ROUTE 144
WEST FRIENDSHIP MD 21794

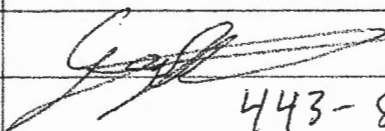
443-834-2402

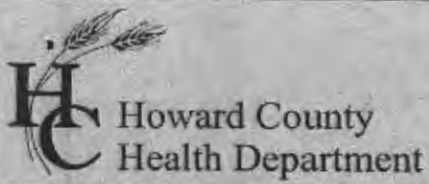

Bureau of Environmental Health
 8930 Stanford Boulevard, Columbia, MD 21045
 Main: 410-313-2640 | Fax: 410-313-2648
 TDD 410-313-2323 | Toll Free 1-866-313-6300
www.hchealth.org
 Facebook: www.facebook.com/hocohealth

Maura J. Rossman, M.D., Health Officer

RECEIPT DATE: 4/11/19

ONSITE SEWAGE DISPOSAL SYSTEM

P 564838

INSTALLATION APPROVAL DATE: 4/11/19 (K)

PERMIT
MINOR REPAIR

A —

PROPERTY ADDRESS: 13540 Frederick Road

SUBDIVISION: _____ LOT: _____ TAX ID: 03-304442

CONTRACTOR: George Streaker EMAIL: _____

CONTRACTOR ADDRESS: 13370 Frederick Road, West Friendship, MD 21794 PHONE: _____

PROPERTY OWNER: Clear View Farm LLC. EMAIL: _____

OWNER ADDRESS: 13370 Frederick Road, West Friendship, MD 21794 PHONE: _____

NUMBER OF BEDROOMS: 5 SEPTIC TANK SIZE: unknown DRAINFIELD SIZE/TYPE: unknown


LOCATION:	
NOTES:	Replace broken Pipe.

ISSUED BY: K. Wolf ISSUE DATE: 4/11/19 EXPIRATION DATE: 4/11/20

- NOTE: CONTRACTOR MUST SCHEDULE AN INSPECTION AND GAIN APPROVAL OF ALL COMPONENTS PRIOR TO COVERING
- NOTE: AN ELECTRICAL PERMIT IS REQUIRED FOR INSTALLATION OF ANY ELECTRICAL COMPONENTS OF THE SYSTEM
- NOTE: MDE RECOMMENDS SEPTIC TANKS, BAT, AND OTHER PRETREATMENT UNITS BE PUMPED AT A FREQUENCY ADEQUATE TO ENSURE THAT SOLIDS ARE NOT DISCHARGED TO THE DISPOSAL AREA

NEITHER THE HOWARD COUNTY COUNCIL NOR THE HEALTH DEPARTMENT IS RESPONSIBLE FOR THE SUCCESSFUL OPERATION OF ANY SYSTEM. PERMITTEE RESPONSIBLE FOR OBTAINING FINAL APPROVAL ON THIS PERMIT. CALL 410-313-1771 FOR INSPECTION OF SEPTIC SYSTEM.

NOT TO SCALE

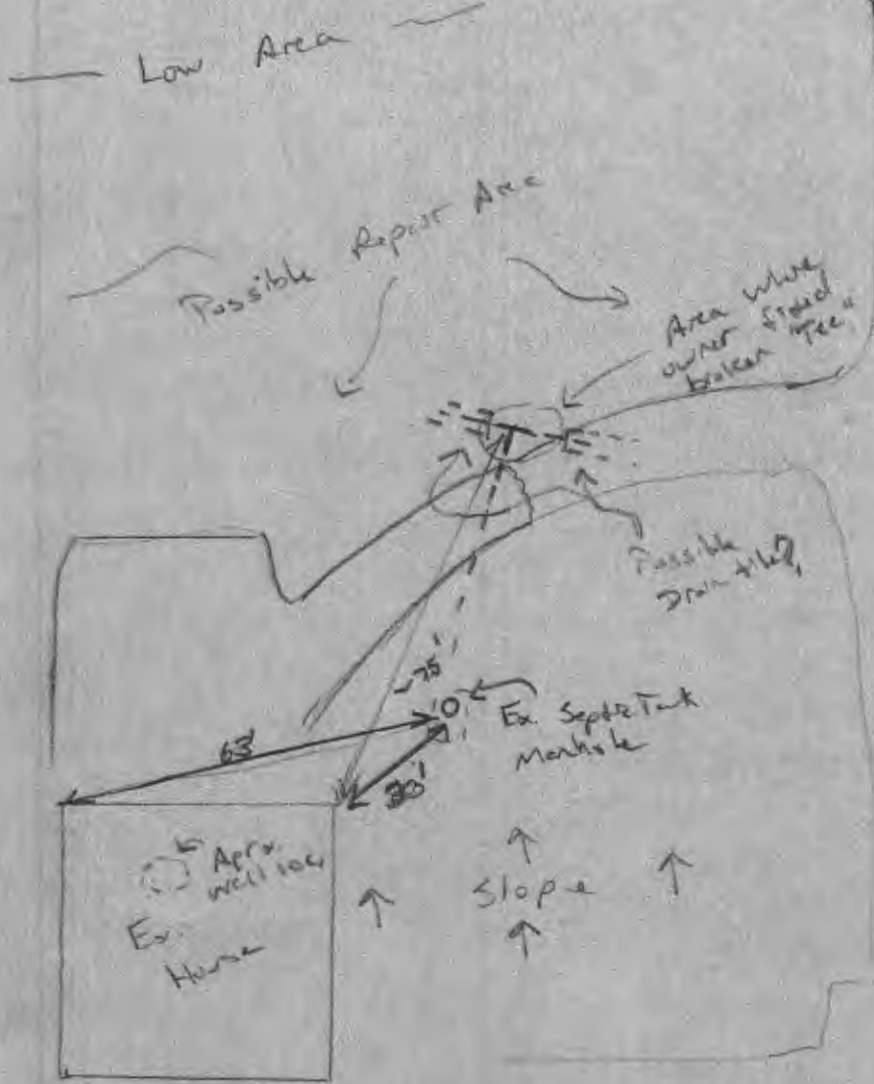

ROAD NAME
- Frederick Rd -

TRENCH/DRAINFIELD DATA

WIDTH	INLET	BOTTOM
_____	_____	_____
_____	_____	_____
NUMBER OF TRENCHES _____
 TOTAL LENGTH _____
 ABSORPTION AREA _____
 DISTRIBUTION BOX LEVEL _____
 DISTRIBUTION BOX BAFFLE _____
 DISTRIBUTION BOX PORT _____

SEPTIC TANK DATA

SEPTIC TANK 1 LEVEL _____
 MANUFACTURER _____
 CAPACITY _____ GAL
 SEAM LOC _____
 TANK LID DEPTH _____
 BAFFLES _____
 BAFFLE FILTER _____
 MANHOLE LOC _____
 6" PORT LOC _____
 WATERTIGHT TEST _____
 SLOTTED _____
 DATE ON LID _____

PUMP/SEPTIC TANK / LEVEL _____
 MANUFACTURER _____
 CAPACITY _____ GAL
 SEAM LOC _____
 TANK LID DEPTH _____
 BAFFLES _____
 BAFFLE FILTER _____
 MANHOLE LOC _____
 6" PORT LOC _____
 WATERTIGHT TEST _____
 SLOTTED _____
 DATE ON LID _____

PRE-CONSTRUCTION:

INSTALLATION: 4/11/19 onsite w/ Mr. Streaker Jr. Dig up area of replacement pipe. Exposed entire section of "Tee" that was replaced by Mr. Streaker. Could not determine where pipes led to. OK to cover work. Explained to Mr. Streaker we will be in contact soon to perform another dye test of the system. (Km)

FINAL INSPECTOR

K. Wally

DATE OF APPROVAL

4/11/19