

Real Property Data Search (w3)

Search Result for HOWARD COUNTY

View Map		View GroundRent Redemption		View GroundRent Registration	
Tax Exempt:		Special Tax Recapture:			
Exempt Class:		AGRICULTURAL TRANSFER TAX			
Account Identifier:		District - 03 Account Number - 322548			
Owner Information					
Owner Name:	BROOKHART BARBARA L BROOKHART RAYMOND A		Use:	AGRICULTURAL	
Mailing Address:	11300 BARLEY FIELD WAY MARRIOTTSVILLE MD 21104- 1339		Principal Residence:	YES	
			Deed Reference:	/04281/ 00270	
Location & Structure Information					
Premises Address:		11300 BARLEY FIELD WAY MARRIOTTSVILLE 21104-0000		Legal Description:	PAR H 26.19 A PRES P 11300 BARLEY FIELD WAY WOODFORDS GRANT RSB LOTS
Map:	Grid:	Parcel:	Sub District:	Subdivision:	Section:
0010	0016	0027		1021	
					Block:
					0
					Lot:
					PAR H
					Assessment Year:
					2019
					Plat No:
					20668
					Plat Ref:
Special Tax Areas:		Town:		NONE	
		Ad Valorem:		100	
		Tax Class:			
Primary Structure Built	Above Grade Living Area	Finished Basement Area	Property Land Area	County Use	
2001	3,529 SF		26.1900 AC	000000	
Stories	Basement	Type	Exterior	Full/Half Bath	Garage
2	NO	SPLIT LEVEL	BRICK	3 full/ 1 half	1 Attached
Value Information					
	Base Value	Value	Phase-in Assessments		
		As of	As of	As of	
		01/01/2019	07/01/2019	07/01/2020	
Land:	257,900	217,500			
Improvements	499,900	567,200			
Total:	757,800	784,700	766,767	775,733	
Preferential Land:	12,500			12,500	
Transfer Information					
Seller: POWELL THOMAS H		Date: 05/01/1998		Price: \$200,000	
Type: ARMS LENGTH VACANT		Deed1: /04281/ 00270		Deed2:	
Seller:		Date:		Price:	
Type:		Deed1:		Deed2:	
Seller:		Date:		Price:	
Type:		Deed1:		Deed2:	
Exemption Information					
Partial Exempt Assessments:	Class	07/01/2019	07/01/2020		
County:	000	0.00			
State:	000	0.00			
Municipal:	000	0.00 0.00	0.00 0.00		
Tax Exempt:		Special Tax Recapture:			
Exempt Class:		AGRICULTURAL TRANSFER TAX			
Homestead Application Information					

APPLICATION

A 22443
~~22442~~

P _____

Preliminary SEWAGE DISPOSAL TESTING
STATE OF MARYLAND - DEPARTMENT OF HEALTH AND MENTAL HYGIENE

HOWARD COUNTY HEALTH DEPARTMENT
ENVIRONMENTAL HEALTH SERVICES
P. O. BOX 476, ELLICOTT CITY, MARYLAND 21043
TELEPHONE: 465-5000, EXT. 356

DISTRICT 3
DATE 11/4/75

*11/6/75
9:30*

*4-13' Loled
on 10,000 ft.*

TO: THE COUNTY HEALTH OFFICER
ELLICOTT CITY, MARYLAND

I, HEREBY, APPLY FOR THE NECESSARY TEST IN ORDER TO CONSTRUCT (OR RECONSTRUCT) A SEWAGE DISPOSAL SYSTEM.

PROPERTY OWNER Thomas H. Powell & wife
(Criswell - contract purchaser)
ADDRESS Marriottsville Road, Ellicott City, Md. PHONE 465-7777
Any questions call: John Schneider

PROPERTY LOCATION:

SUBDIVISION _____ LOT NO. _____

ROAD AND DESCRIPTION Marriottsville Road (see plat for location)

SIZE OF LOT 5.000 acres TYPE BLDG. 3 or 4

IF NOT SINGLE RESIDENCE DESCRIBE _____
NUMBER OF BEDROOMS (Single Fmly. Dwllg.)

THE SYSTEM INSTALLED UNDER THIS APPLICATION IS ACCEPTABLE ONLY UNTIL PUBLIC FACILITIES BECOME AVAILABLE.

SIGNATURE OF APPLICANT /s/ John Schneider

APPROVED BY _____ FOR _____ DATE _____
(KIND OF SYSTEM)

REJECTED BY RJ O Hart FOR Any DATE 11/4/75
(KIND OF SYSTEM)

HOLD PENDING FURTHER TESTS _____ DATE _____

REASONS FOR REJECTION OR HOLDING _____

THIS IS NOT A PERMIT

APPLICATION

A 22443
~~22442~~

SEWAGE DISPOSAL TESTING

P _____

STATE OF MARYLAND - DEPARTMENT OF HEALTH AND MENTAL HYGIENE

HOWARD COUNTY HEALTH DEPARTMENT
ENVIRONMENTAL HEALTH SERVICES
P. O. BOX 476, ELLICOTT CITY, MARYLAND 21043
TELEPHONE: 465-5000, EXT. 356

DISTRICT 3

DATE 11/4/75

TO: THE COUNTY HEALTH OFFICER
ELLICOTT CITY, MARYLAND

I, HEREBY, APPLY FOR THE NECESSARY TEST IN ORDER TO CONSTRUCT (OR RECONSTRUCT) A SEWAGE DISPOSAL SYSTEM.

PROPERTY OWNER Thomas H. Powell & wife
(Criswell - contract purchaser) Any questions call:
ADDRESS Marriottsville Road, Ellicott City, Md. PHONE John Schneider
465-7777

PROPERTY LOCATION:

SUBDIVISION _____ LOT NO. _____

ROAD AND DESCRIPTION Marriottsville Road (see plat for location)

SIZE OF LOT 5,000 acres TYPE BLDG. 3 or 4

NUMBER OF BEDROOMS

IF NOT SINGLE RESIDENCE DESCRIBE _____ (Single Fmly. Dwlg.)

THE SYSTEM INSTALLED UNDER THIS APPLICATION IS ACCEPTABLE ONLY UNTIL PUBLIC FACILITIES BECOME AVAILABLE.

SIGNATURE OF APPLICANT /s/ John Schneider

APPROVED BY _____ FOR _____ DATE _____

(KIND OF SYSTEM)


REJECTED BY _____ FOR _____ DATE _____

(KIND OF SYSTEM)

HOLD PENDING FURTHER TESTS _____ DATE _____

REASONS FOR REJECTION OR HOLDING _____

THIS IS NOT A PERMIT

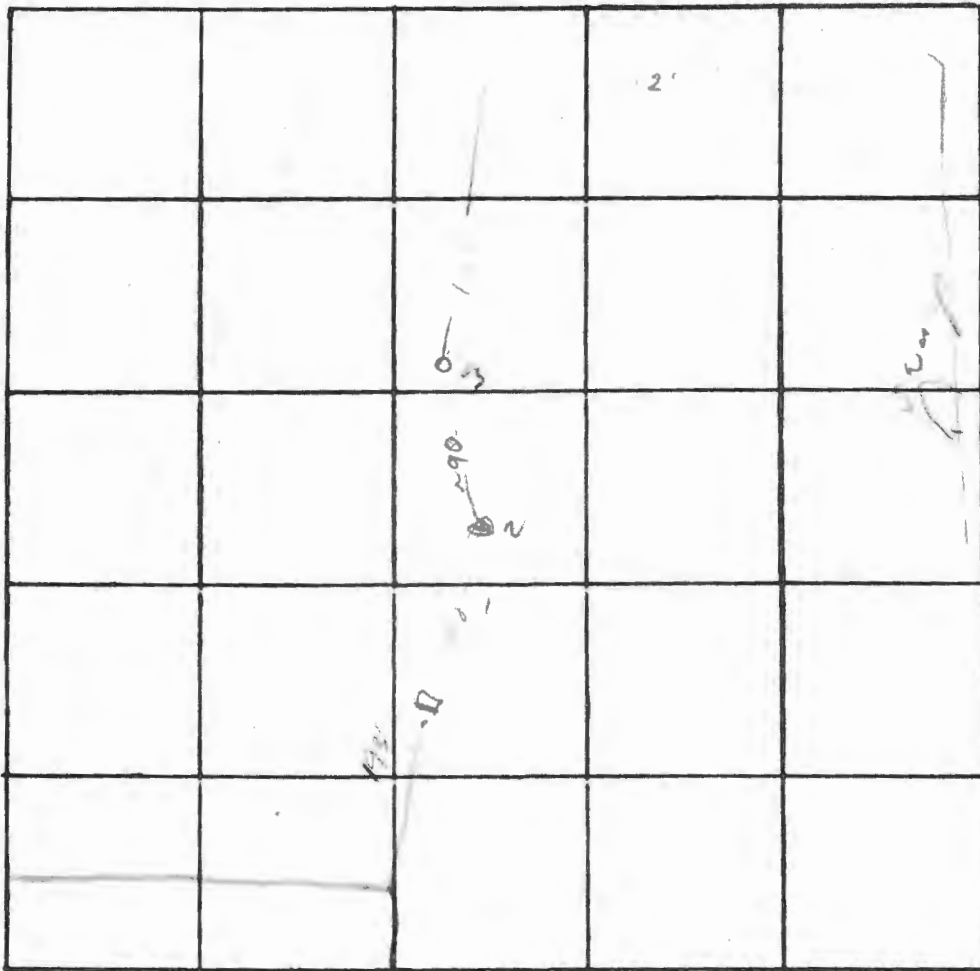

INDICATE NORTH. - NAME ADJOINING ROADWAY AS BASE LINE.

3
 3
 4 with clay
 clay
 1100

DATE	TEST NO.	DEPTH	PRE-WET		TEST - 1" DROP		TIME
			START	STOP	START	STOP	
11/6/4	1	5'	10.0				
11	2	8'	6.0				
	3	10'	6.0				
	4	5'	6.0				

REMARKS _____

TYPE OF SOIL _____

TESTED BY O'Neil ALSO PRESENT: _____

