

7/13/76 - Failed F.S.
Siter 711
Julio 742
9:30
2/18/75

APPLICATION

A 23420

SEWAGE DISPOSAL TESTING

P _____

STATE OF MARYLAND - DEPARTMENT OF HEALTH AND MENTAL HYGIENE

HOWARD COUNTY HEALTH DEPARTMENT
ENVIRONMENTAL HEALTH SERVICES
P. O. BOX 476, ELLICOTT CITY, MARYLAND 21043
TELEPHONE: 465-5000, EXT. 356

DISTRICT 1

DATE 6/16/76

TO: THE COUNTY HEALTH OFFICER
ELLICOTT CITY, MARYLAND

I, HEREBY, APPLY FOR THE NECESSARY TEST IN ORDER TO CONSTRUCT (OR RECONSTRUCT) A SEWAGE DISPOSAL SYSTEM.

PROPERTY OWNER Emma A. Pierson

Any questions call:

ADDRESS 5266 Waterloo Road, Ellicott City, Md. PHONE 730-6127

Mrs. Radke

PROPERTY LOCATION:

SUBDIVISION _____ LOT NO. 2

ROAD AND DESCRIPTION Montgomery Road - approx. 1 mile past intersection of
Rt. 175 & Rt. 103 on right side

SIZE OF LOT 0.687 acres TYPE BLDG. 3 or 4

NUMBER OF BEDROOMS

IF NOT SINGLE RESIDENCE DESCRIBE _____ (Single Fmly. Dwllg.)

THE SYSTEM INSTALLED UNDER THIS APPLICATION IS ACCEPTABLE ONLY UNTIL PUBLIC FACILITIES BECOME AVAILABLE.

SIGNATURE OF APPLICANT /s/ Emma Pierson

APPROVED BY _____ FOR _____ DATE _____

(KIND OF SYSTEM)

REJECTED BY Frank Skinner FOR any DATE 7/13/76


(KIND OF SYSTEM)

HOLD PENDING FURTHER TESTS _____ DATE _____

REASONS FOR REJECTION OR HOLDING _____

THIS IS NOT A PERMIT

CASE NO.

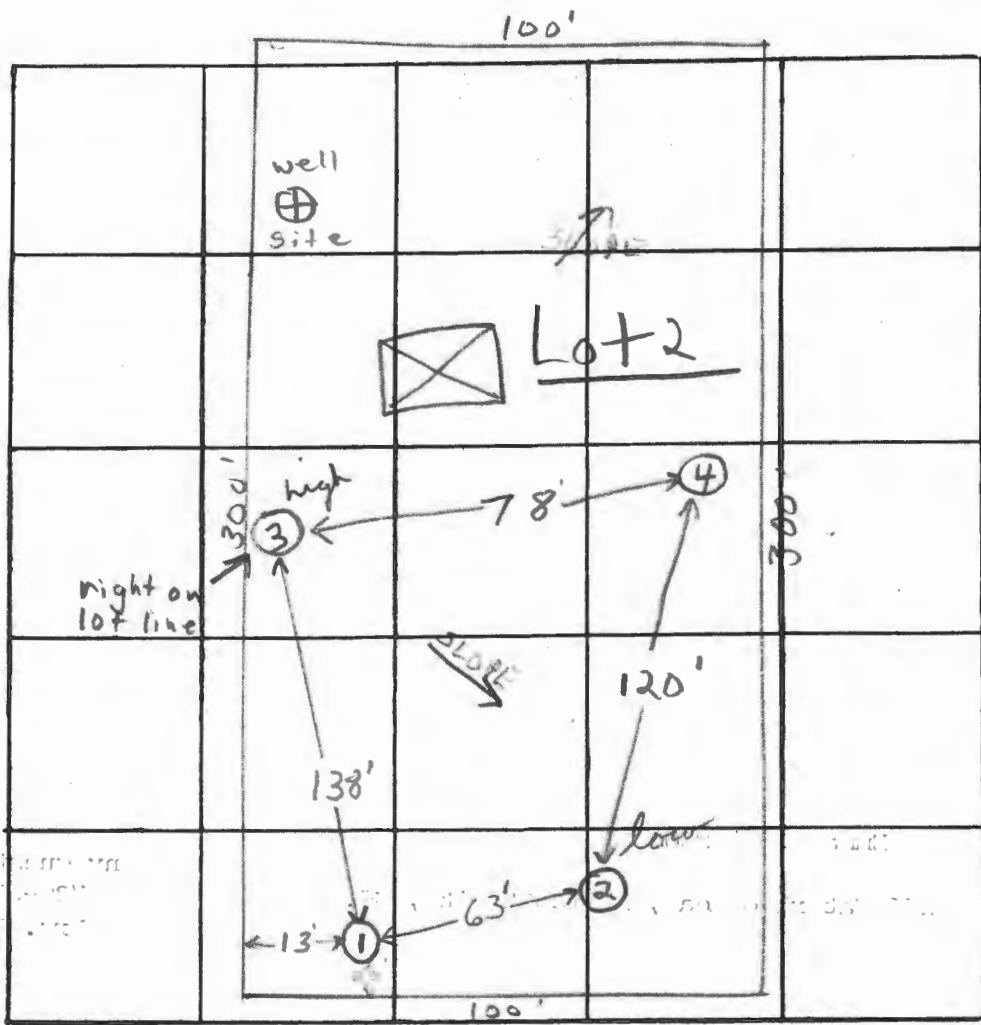

INDICATE NORTH. - NAME ADJOINING ROADWAY AS BASE LINE.

Montgomery Road

DATE	TEST NO.	DEPTH	PRE-WET		TEST - 1" DROP		TIME	
			START	STOP	START	STOP		
7/13/72	1A	13'	9:42	9:50	9:50	10:19	28 min	
	1	6'	9:43	10:18	10:18		Failed	
	2	6'	9:48	9:56	9:56	10:17	21 min	
	2A	13 1/2'	9:47				Failed	
	3 high	6'	10:28				Failed	
	3A	14'	10:28				Failed	
	4	13 1/2'	Clay & gravel to 12'; sandy clay below					

REMARKS: Public H₂O sewer manometer on this lot applies

TYPE OF SOIL: clayey to 4-6'; sandy clay below

TESTED BY: F.S. ALSO PRESENT: Brittingham & Mrs Pierson

APPLICATION

A 23420

SEWAGE DISPOSAL TESTING

P _____

STATE OF MARYLAND - DEPARTMENT OF HEALTH AND MENTAL HYGIENE

HOWARD COUNTY HEALTH DEPARTMENT
ENVIRONMENTAL HEALTH SERVICES
P. O. BOX 476, ELLICOTT CITY, MARYLAND 21043
TELEPHONE: 465-5000, EXT. 356

DISTRICT 1

DATE 6/16/76

TO: THE COUNTY HEALTH OFFICER
ELLICOTT CITY, MARYLAND

I, HEREBY, APPLY FOR THE NECESSARY TEST IN ORDER TO CONSTRUCT (OR RECONSTRUCT) A SEWAGE DISPOSAL SYSTEM.

PROPERTY OWNER Emma A. Pierson

Any questions call:

ADDRESS 5266 Waterloo Road, Ellicott City, Md. PHONE 730-6127

Mrs. Radke

PROPERTY LOCATION:

SUBDIVISION _____ LOT NO. 2

ROAD AND DESCRIPTION Montgomery Road - approx. 1 mile past intersection of
Rt. 175 & Rt. 103 on right side

SIZE OF LOT 0.697 acres TYPE BLDG. 3 or 4

NUMBER OF BEDROOMS

IF NOT SINGLE RESIDENCE DESCRIBE _____
(Single Fam., Dwlg.)

THE SYSTEM INSTALLED UNDER THIS APPLICATION IS ACCEPTABLE ONLY UNTIL PUBLIC FACILITIES BECOME AVAILABLE.

SIGNATURE OF APPLICANT /s/ Emma Pierson

APPROVED BY _____ FOR _____ DATE _____
(KIND OF SYSTEM)

REJECTED BY _____ FOR _____ DATE _____
(KIND OF SYSTEM)

HOLD PENDING FURTHER TESTS _____ DATE _____

REASONS FOR REJECTION OR HOLDING _____

THIS IS NOT A PERMIT

INDICATE NORTH. - NAME ADJOINING ROADWAY AS BASE LINE.

DATE	TEST NO.	DEPTH	PRE-WET		TEST - 1" DROP		TIME
			START	STOP	START	STOP	

REMARKS _____

TYPE OF SOIL _____

TESTED BY _____ ALSO PRESENT: _____

7/13/76
9:30

Lot 3

New line of division:
N 18° 21' 43" W, 100.00

GRID NORTH

I.P. Set

I.P. Set

LOT 2
0.687 Ac. ±

Lot 1

Residue

191/565

300.00'

565° 39' 22" W
New line of division

New line of division
N 68° 39' 22" E
300.00'

I.P. Set

I.P. Set
P.O.B.

518° 21' 48" E 100.00'

507° 09' 55" W 103.00'
From end of 2nd Line
of 191/565

MONTGOMERY ROAD
(40' R/W)

approx. 1 mile
past intersection
of Rt. 175 & Rt. 103
on right side.

4 bedrooms



DESCRIPTION PLAT OF
LOT 2

EMMA A. PIERSON PROPERTY
5266 Waterloo Rd. - S.C. 730-6127
1st Election Dist. Howard Co., Md.
Scale: 1" = 50' February 10, 1975

Recorded Liber 711
Folio 742

Feb. 18, 1975

John B. Gary
John B. Gary, P.E., S. State, Md.

GARY AND ASSOCIATES INC.

BUILDERS-ENGINEERS-SURVEYORS
HOLZ BUILDING 615 Old Edmondson Ave.
Catonsville Maryland 21228
301-788-2618