

RECORDED

APPLICATION

A 10318

SEWAGE DISPOSAL TESTING

P _____

MARYLAND STATE DEPARTMENT OF HEALTH

HOWARD COUNTY

ELLICOTT CITY

~~Septic Tank - 750 gallons~~

DISTRICT 4

DATE 6/14/65

~~Dry well - 12 ft in dia. by 9 ft deep
below the inlet pipe located 66 ft from front lot
line and 81 ft from right side lot line as seen
when facing lot from Old Frederick Rd.~~

TO: THE COUNTY HEALTH OFFICER
ELLICOTT CITY, MARYLAND

VOID

I, HEREBY, APPLY FOR THE NECESSARY TESTS IN ORDER TO CONSTRUCT (OR RECONSTRUCT) A SEWAGE DISPOSAL SYSTEM.

PROPERTY OWNER Oliver C. & Margaret P. Shipley

ADDRESS 2625 Purnell Drive, Baltimore, Md. 21207 PHONE WI 4-3016

PROPERTY LOCATION:

SUBDIVISION _____ LOT NO. _____

ROAD AND DESCRIPTION Old Frederick Rd. - & Rt. 40 - about 133 ft. off Rt. 40
north side - wooded lot

OCCUPANT _____ PHONE _____

PERSON TO CONSTRUCT SYSTEM _____

ADDRESS _____ PHONE _____

SIZE OF LOT 1 acre TYPE BLDG. 3
NUMBER OF BEDROOMS

IF NOT SINGLE RESIDENCE DESCRIBE _____

SIGNATURE OF APPLICANT Oliver C. Shipley


APPROVED BY J. H. Kilmora FOR Dry well DATE 6/17/65
(KIND OF SYSTEM)

REJECTED BY _____ FOR _____ DATE _____
(KIND OF SYSTEM)

HOLD PENDING FURTHER TESTS _____ DATE _____

REASONS FOR REJECTION OR HOLDING _____

THIS IS NOT A PERMIT

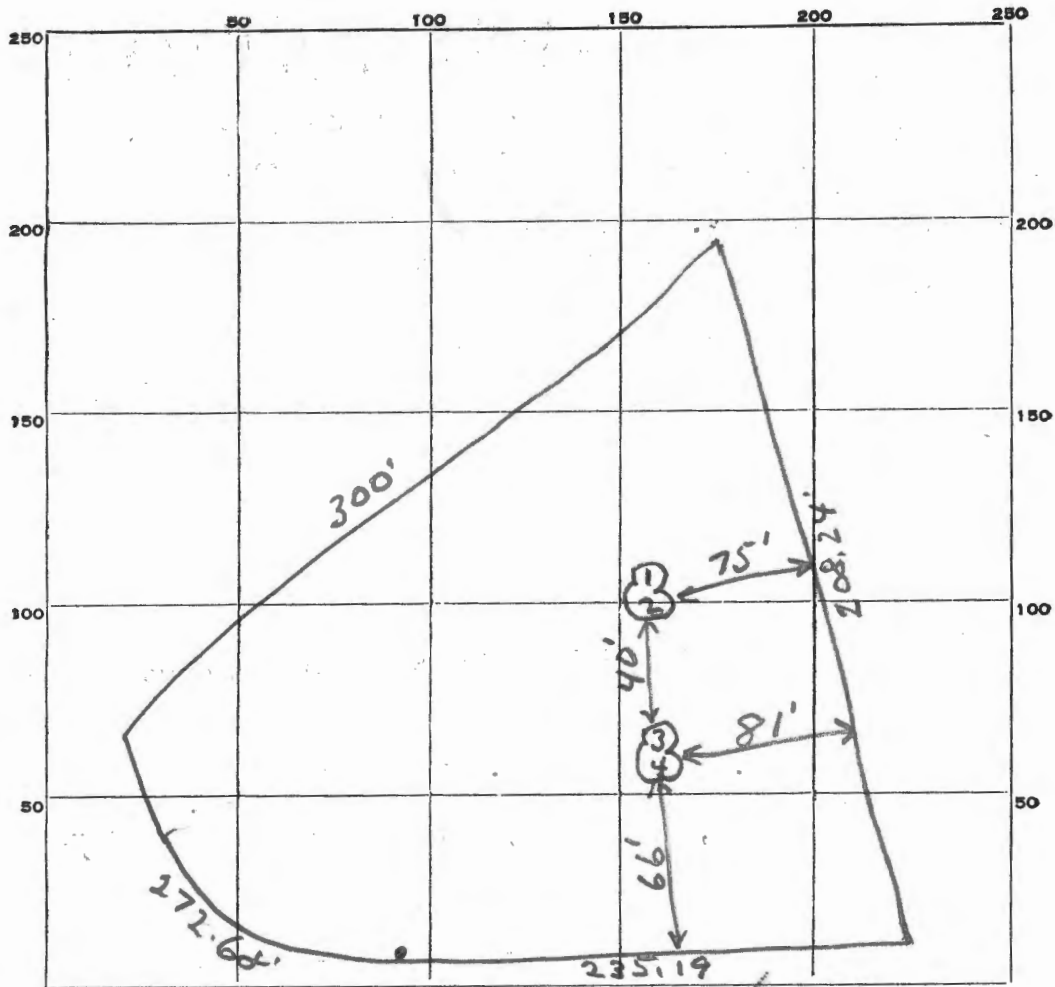

INDICATE NORTH. - NAME ADJOINING ROADWAY AS BASE LINE.
OLD FREDERICK RD.

DATE	TEST NO.	DEPTH	PRE-WET		TEST - 1" DROP		TIME
			START	STOP	START	STOP	
	1	9	9:51	10:00	10:00	10:15	15 min
	2	4' ✓	9:53	9:57	9:57	10:03	6 min
	3	9	9:57	10:04	10:04	10:11	7 min
	4	4' ✓	10:01	10:05	10:05	10:11	6 min

3 + 8 1/2

SOIL AUGER FINDING _____

TESTED BY JHK

REMARKS Human Site

TO MORGAN STATION RD.

OLD FREDERICK ROAD

OLIVER SHIPLEY

1 ACRE Reserved


ROUTE 40
WEST LANE

Plan of a subdivision of a property of
EMMA SHIPLEY
 NEAR COOKSVILLE
 Fourth Election District, Howard County, Md
 December, 1951

Scale: 1" = 100'

J.R. Curtis, Engineer

2 BL.

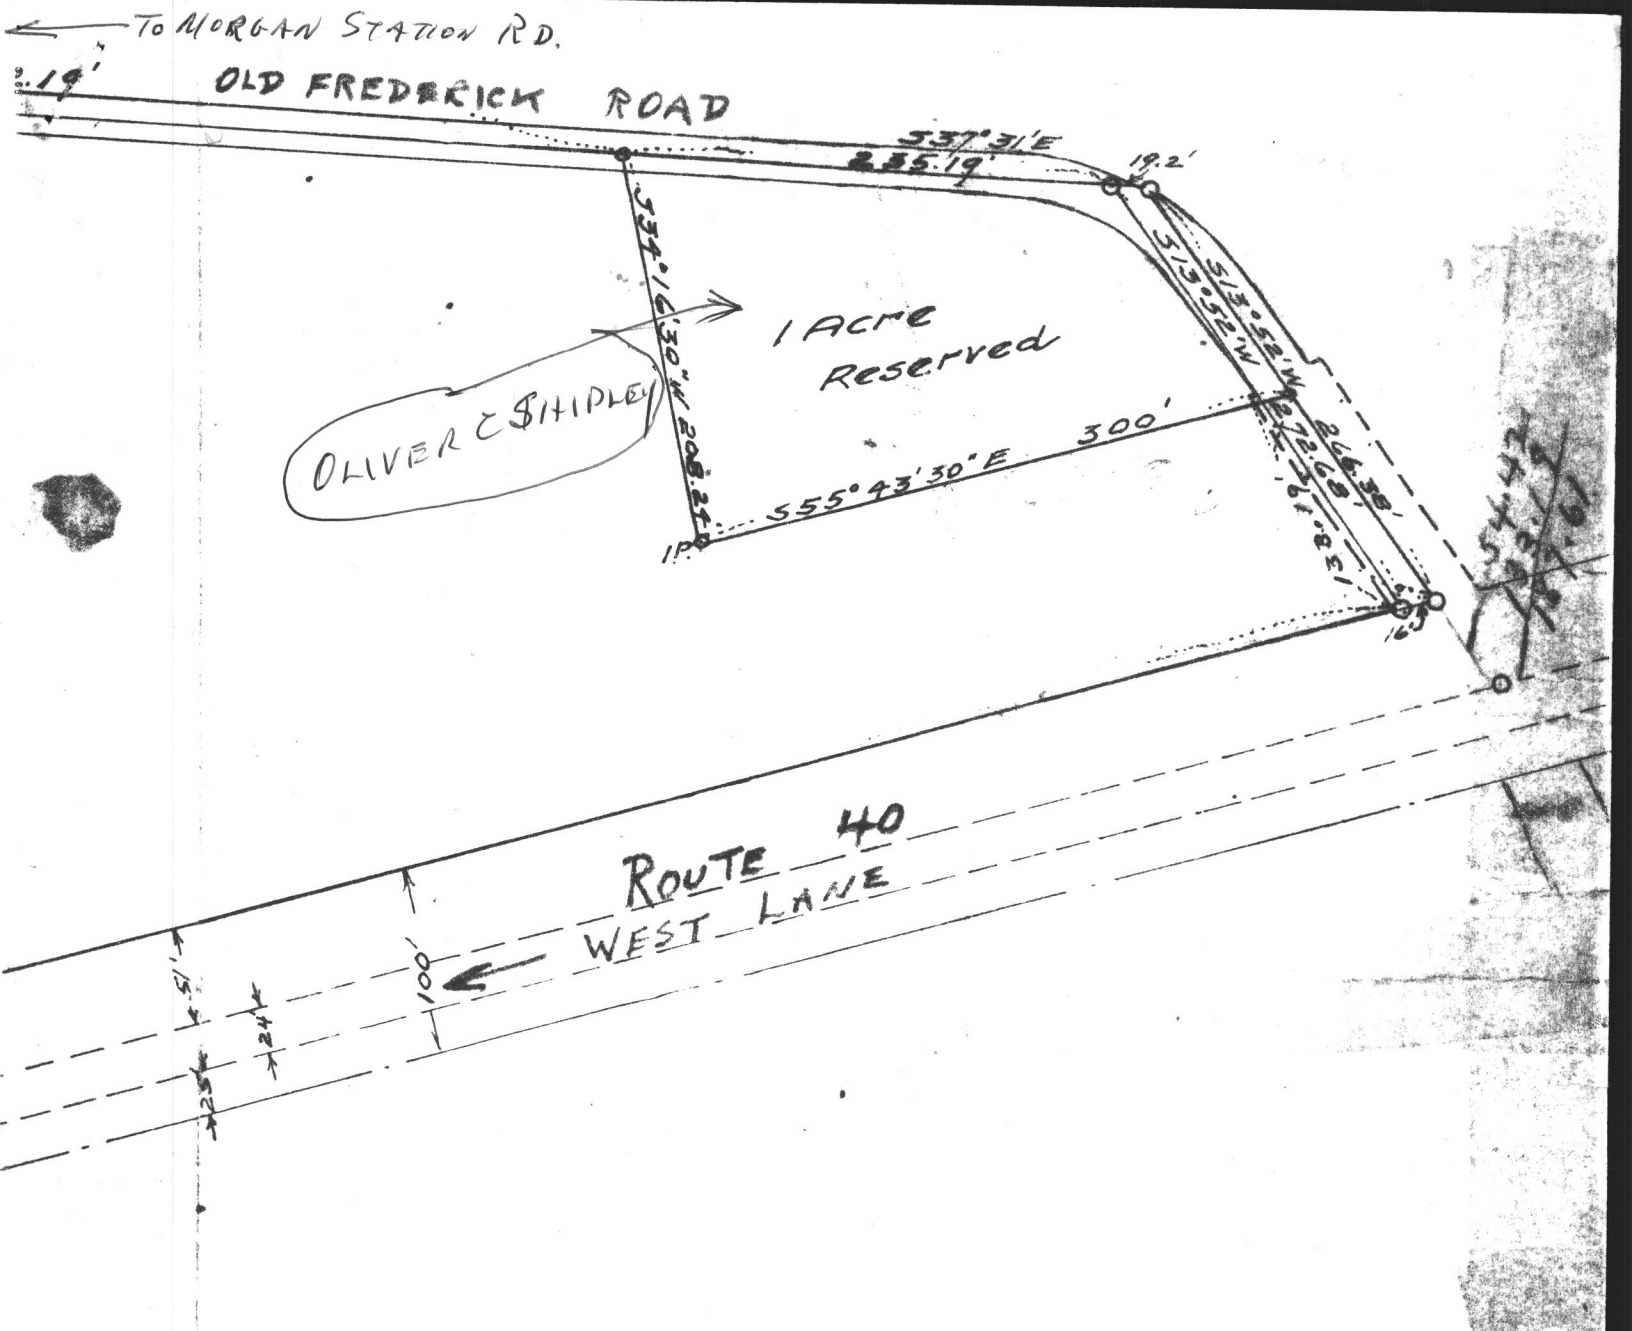

Applied for
Peric Test permit
today 6/14/65

Olesin C Shuplin
2625 Burnell Dr
Baltimore 21207

Mr Seibe will call
about inspection etc

O C Shuplin

