

Prod.

APPLICATION

A 25924

P _____

SEWAGE DISPOSAL TESTING

STATE OF MARYLAND - DEPARTMENT OF HEALTH AND MENTAL HYGIENE

HOWARD COUNTY HEALTH DEPARTMENT
ENVIRONMENTAL HEALTH SERVICES
P. O. BOX 476, ELLICOTT CITY, MARYLAND 21043
TELEPHONE: 465-5000, EXT. 356

*SYSTEM FIRST
SHALLOW DW
IN HOLES*

DISTRICT 4TH

DATE 5/23/77

*C. Smith wants to install system before building permit
FF said shallow ditch at holes*

TO: THE COUNTY HEALTH OFFICER
ELLICOTT CITY, MARYLAND

I, HEREBY, APPLY FOR THE NECESSARY TEST IN ORDER TO CONSTRUCT (OR RECONSTRUCT) A SEWAGE DISPOSAL SYSTEM.

PROPERTY OWNER EARL M. GRAY

ADDRESS WOODBINE ROAD SHADY GLENN PHONE 795-4166

PROPERTY LOCATION:

442 2045

SUBDIVISION PROPERTY OF EARL M. GRAY LOT NO. NEW 2

ROAD AND DESCRIPTION 1200th SOUTH OLD ROVER RD. & PEPPER CORN RD.

SIZE OF LOT 4 AC ± TYPE BLDG. 30R4
NUMBER OF BEDROOMS

IF NOT SINGLE RESIDENCE DESCRIBE _____

THE SYSTEM INSTALLED UNDER THIS APPLICATION IS ACCEPTABLE ONLY UNTIL PUBLIC FACILITIES BECOME AVAILABLE.

SIGNATURE OF APPLICANT Charles J. Gray


APPROVED BY _____ FOR _____ DATE _____
(KIND OF SYSTEM)

REJECTED BY _____ FOR _____ DATE _____
(KIND OF SYSTEM)

HOLD PENDING FURTHER TESTS _____ DATE _____

REASONS FOR REJECTION OR HOLDING _____

THIS IS NOT A PERMIT

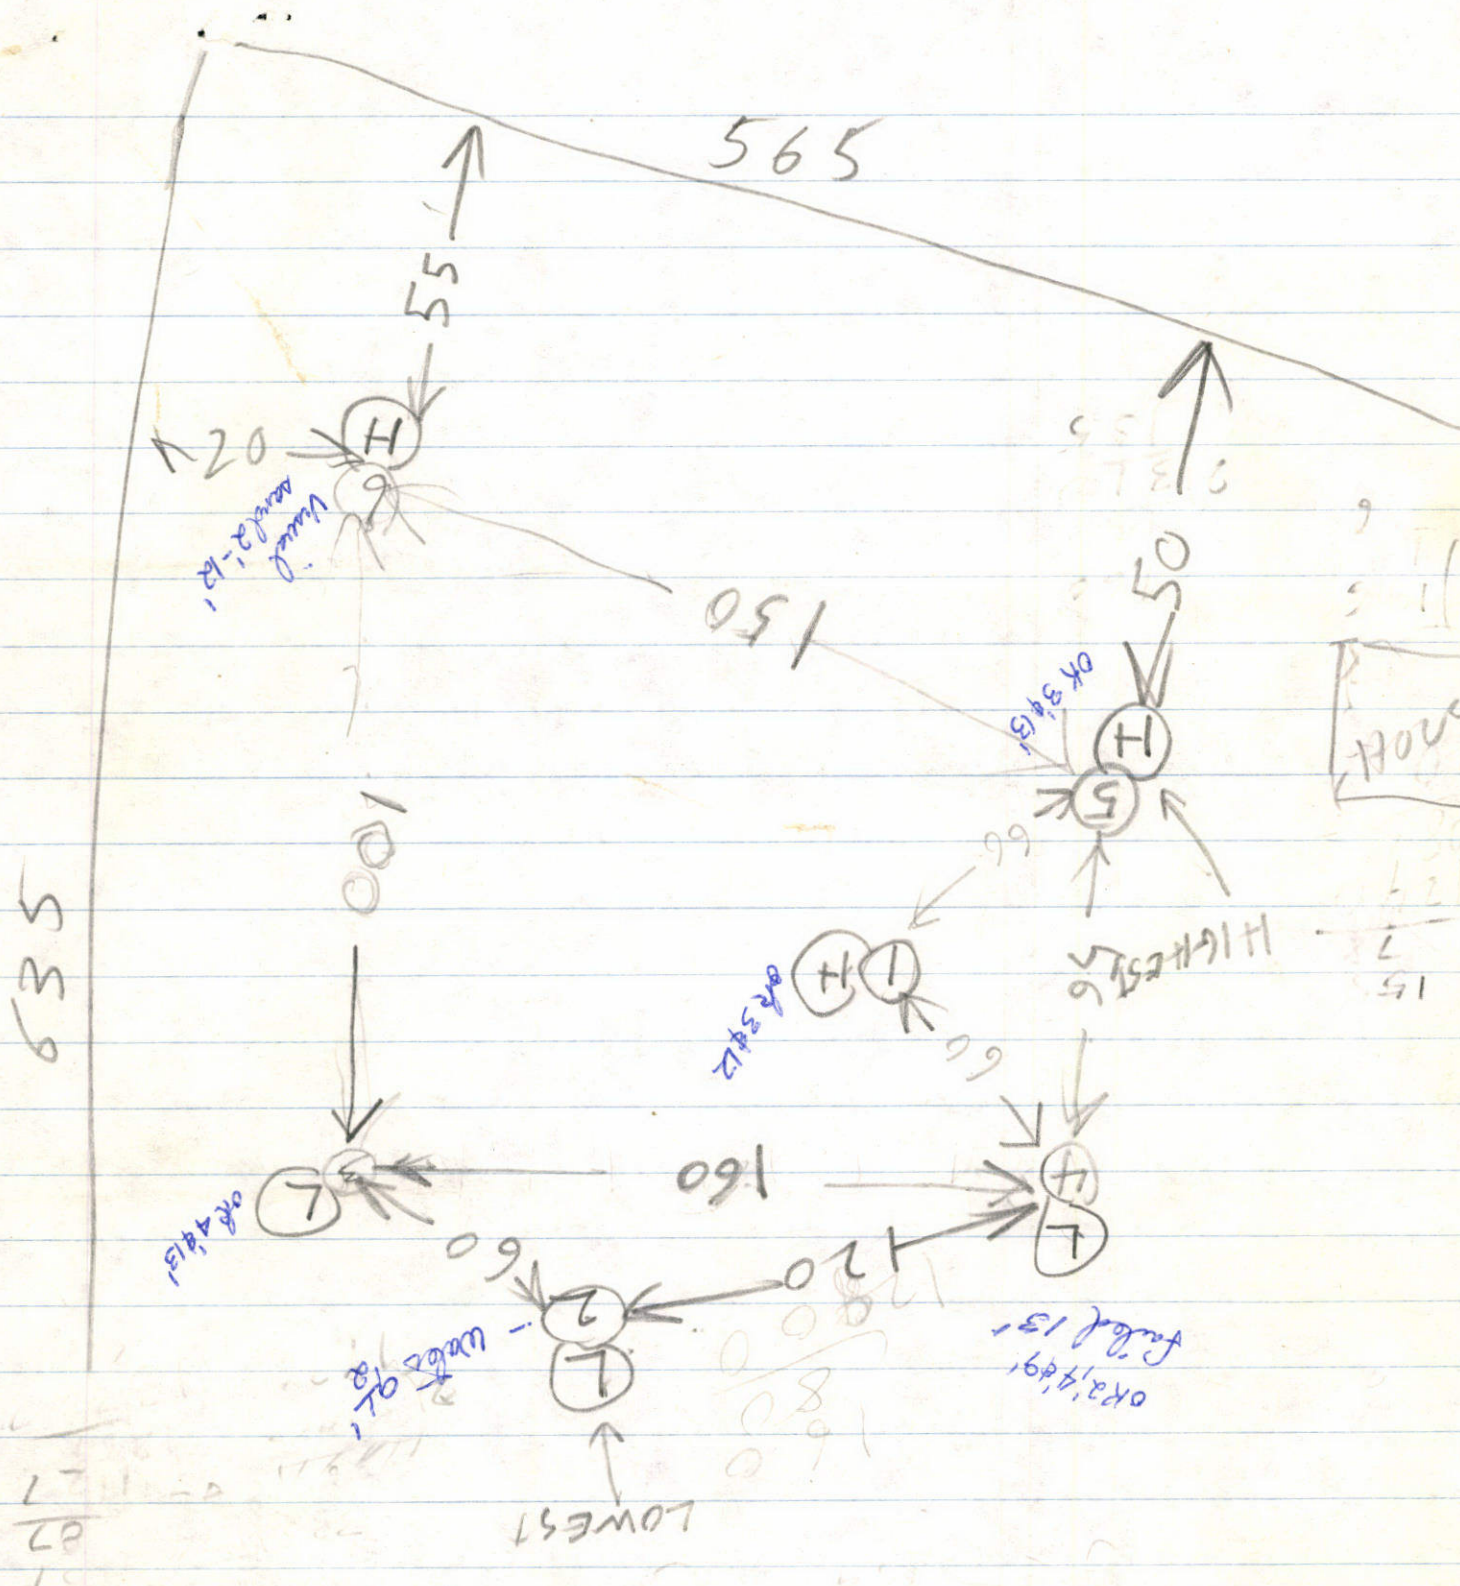

HOUSE

HIGHEST 6

LOWEST

535


565

164
159
2) 323
161

58
3
159

1
27
1

15'

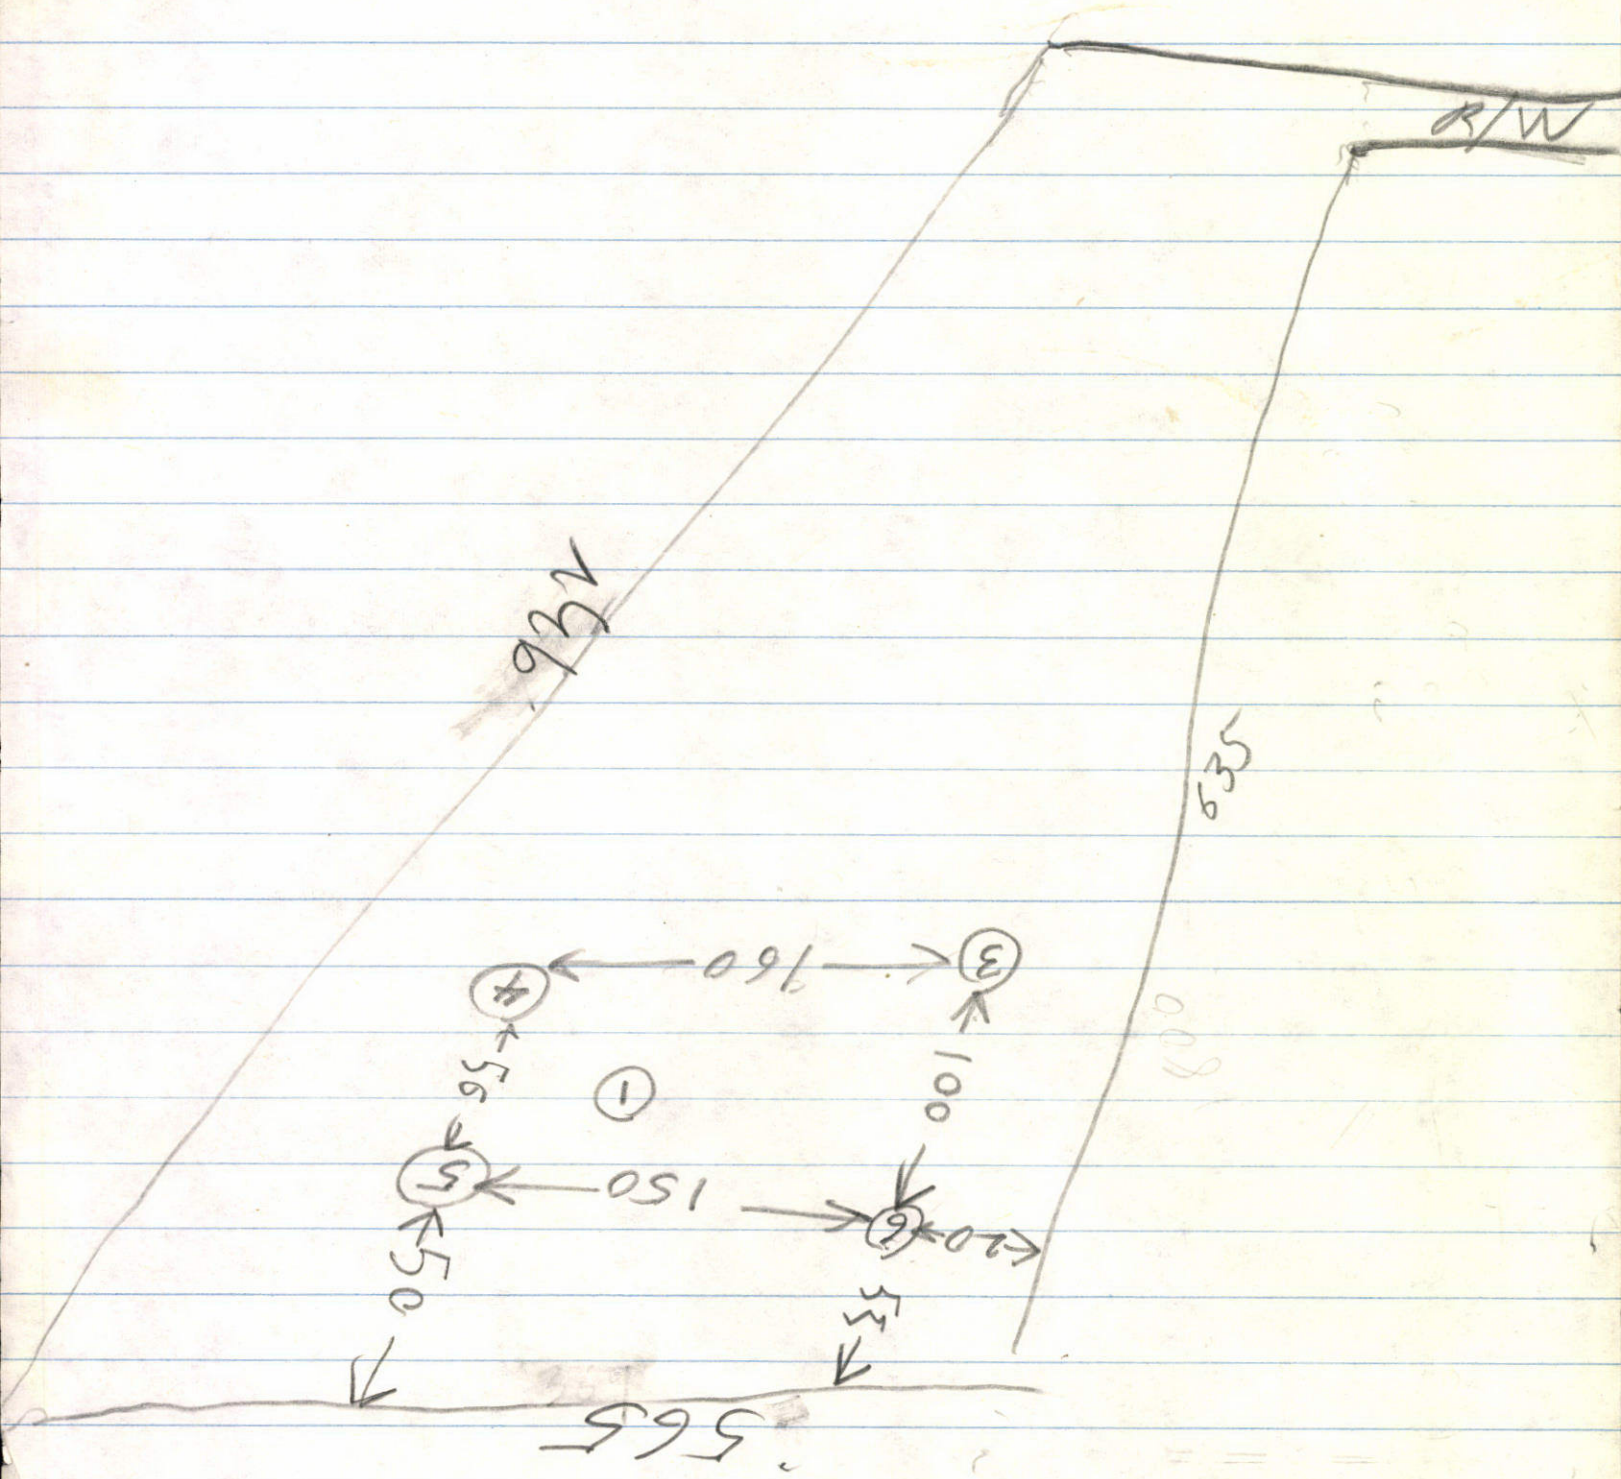

0 0

7500

SEPTIC TANK: 3 BEDROOM, 1000 GALLON

4 BEDROOM, 1250 GALLON

EARL GRAY PROP
LOT NEW 2

DRY WELL TO HAVE 120 SQUARE FEET OF SIDEWALL AREA PER BEDROOM

DRY WELL INLET TO BE MAX. 3 FEET BELOW ORIGINAL GRADE.

DRY WELL BOTTOM (MAXIMUM DEPTH) TO BE 70 FEET BELOW ORIGINAL GRADE.

PLACE THE DRY WELL 50 FEET FROM THE BACK LOT LINE AND 150 FEET FROM THE

RIGHT LOT LINE AS SEEN WHEN FACING THE LOT FROM THE BACK ROAD. LOT LINE

RUN DITCH OFF DW TO MAKE NECESSARY
FOOTAGE MAKE DITCH 10 FT DEEP

NOTE THE BACK LOT LINE IS
362 FT LONG AND SEPARATES
THIS LOT FROM THE DUANE
MILLER PROP

COUNT ONLY ONE SIDE OF DITCH
AS ABSORBENT AREA

15
7
305