

APPLICATION

PERCOLATION TESTING

A 516518

P _____

HOWARD COUNTY HEALTH DEPARTMENT
BUREAU OF ENVIRONMENTAL HEALTH
3525-H ELLICOTT MILLS DRIVE/ELLICOTT CITY, MARYLAND 21043
TELEPHONE: 313-2640

DISTRICT _____

DATE 2/19/02

TO: THE COUNTY HEALTH OFFICER
ELLICOTT CITY, MARYLAND

I HEREBY APPLY FOR THE NECESSARY TEST PRIOR TO APPLICATION FOR PERMIT TO CONSTRUCT (OR RECONSTRUCT) A SEWAGE DISPOSAL SYSTEM.

PROPERTY OWNER Dunn's

ADDRESS _____ PHONE _____

AGENT OR PROSPECTIVE BUYER _____

ADDRESS _____ PHONE _____

PROPERTY LOCATION: Waterford Farm
SUBDIVISION (Not part of Waterford Farm) LOT NO. Parcel 3
Subdivision

ROAD AND DESCRIPTION _____

TAX MAP _____ PARCEL # _____

SIZE OF LOT 50 Acres TYPE BLDG. Existing Tenant House
(SINGLE FAMILY DWELLING OR COMMERCIAL)

THE SYSTEM INSTALLED UNDER THIS APPLICATION IS ACCEPTABLE ONLY UNTIL PUBLIC FACILITIES BECOME AVAILABLE. I FULLY UNDERSTAND THE FEE CONNECTED WITH THE FILING OF THIS PERC TEST APPLICATION IS NON-REFUNDABLE UNDER ANY CIRCUMSTANCES. I ALSO AGREE TO COMPLY WITH ALL M.O.S.H.A. REQUIREMENTS IN TESTING THIS LOT.

(SIGNATURE OF APPLICANT)

APPROVED BY _____ FOR _____ DATE _____

DISAPPROVED BY _____ FOR _____ DATE _____

HOLD PENDING FURTHER TESTS _____

REASONS FOR REJECTION OR HOLDING _____

PERCOLATION TEST PLAT/PRELIMINARY PLAT - TITLE OR I.D. # _____ DATE _____

SITE DEVELOPMENT PLAN/FINAL PLAT - TITLE OR I.D. # _____ DATE _____

THIS IS NOT A PERMIT


516518

NOT TO SCALE


COUNTY #

SOIL PROFILE


3-A

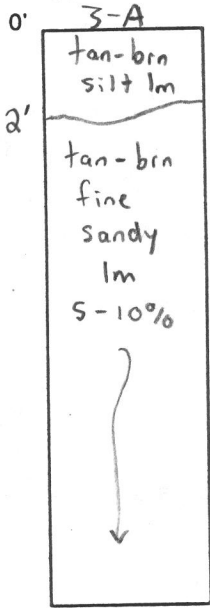


3-B

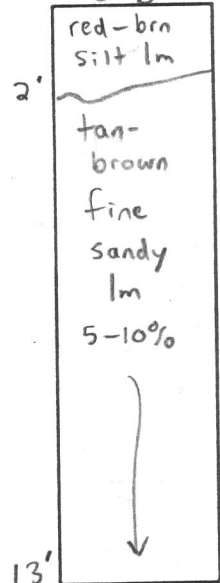

3-C/D

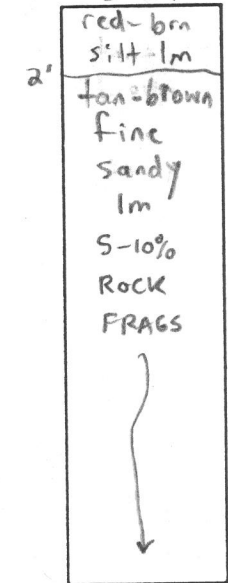


13'

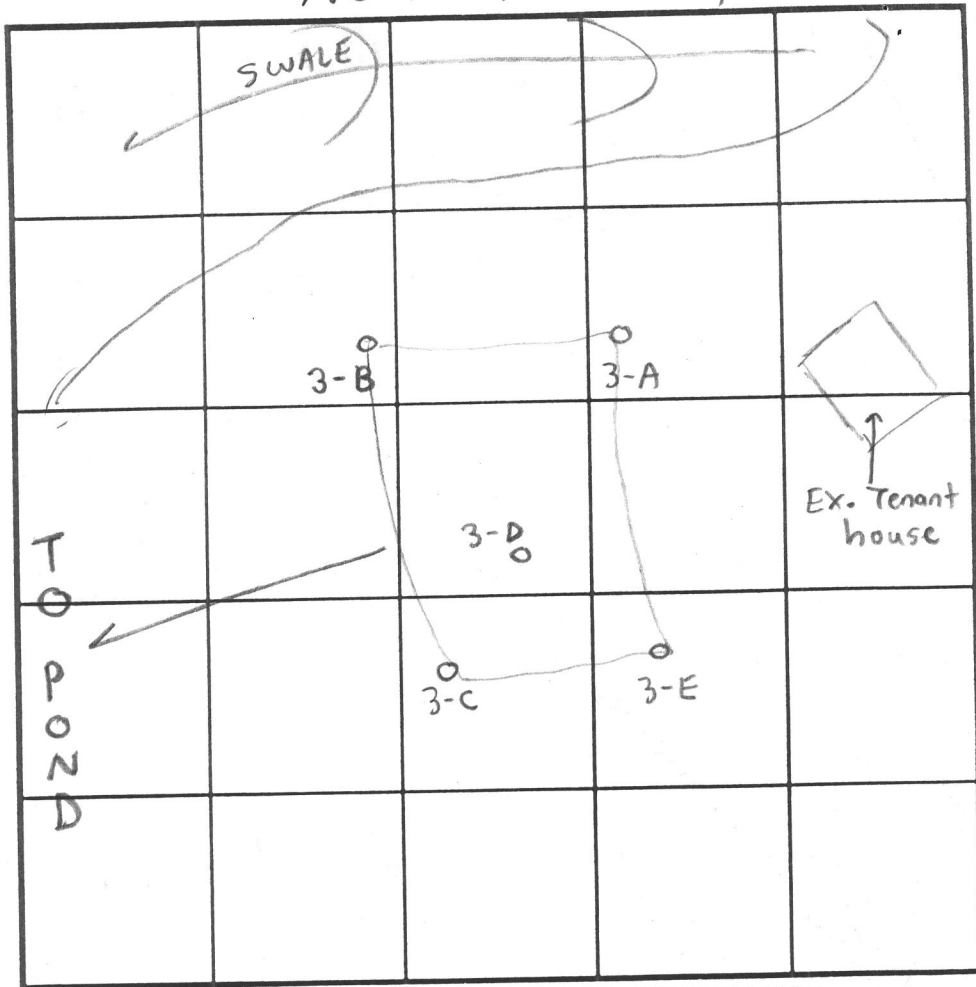

SOIL PROFILE

3-E

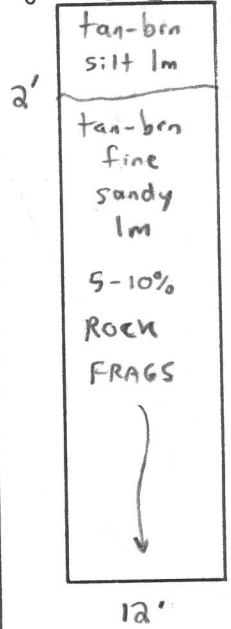

INDICATE NORTH - NAME ADJOINING ROADWAY AS BASE LINE.

DATE	TEST NO.	DEPTH	PRE-WET		TEST - 1' DROP		TIME	
			START	STOP	START	STOP		
6/25/02	3-A	4 1/2" T / 12 6" V	12:17 pm	12:21 pm	12:21 pm	12:28 pm	7 min	OK
	3-B	5 1/2" T / 13' V	12:04 pm	12:08 pm	12:08 pm	12:15 pm	7 min	OK
	3-C	6' T / 13' V	11:48 pm	11:53 pm	11:53 pm	12:03 pm	10 min	OK
	3-D	13' V	(VISUAL OK)		SEE SOIL PROFILE			OK
	3-E	5' T / 12' V	11:38 pm	11:45 pm	11:45 pm	12:00 pm	15 min	OK

REMARKS

TYPE OF SOIL Glenelg Jeff Allen = Backhoe Richard Demmitt

TESTED BY SRK ALSO PRESENT Chuck Sharp

TRENCH DESIGN DATA: AVERAGE PERCOLATION TIME _____ TRENCH WIDTH _____

INLET DEPTH _____ MAXIMUM BOTTOM DEPTH _____ SQ. FT./BEDROOM _____