

Should be rejected, tested Sept. (drytime of yr.) in drought summer
re test needed in wet season
F.F.

APPLICATION

A 10938

P _____

SEWAGE DISPOSAL TESTING

MARYLAND STATE DEPARTMENT OF HEALTH

HOWARD COUNTY

ELLICOTT CITY

DISTRICT 3

Septic Tank - 750 gallons
Tile field - 300 sq. ft. bottom area installed
at a depth of 3 ft. Place the tile field 110 ft to 170 ft.
from front property line and 460 ft. to 540 ft. from the
left side property line as seen when facing the lot from
Rosemary Lane.

DATE 9/21/65

TO: THE COUNTY HEALTH OFFICER
ELLICOTT CITY, MARYLAND

I, HEREBY, APPLY FOR THE NECESSARY TESTS IN ORDER TO CONSTRUCT (OR RECONSTRUCT) A SEWAGE DISPOSAL SYSTEM.

PROPERTY OWNER Ray Bateman

ADDRESS Green Bridge Rd., Dorton, Maryland PHONE AT 6-2003

PROPERTY LOCATION:

SUBDIVISION _____ LOT NO. _____

ROAD AND DESCRIPTION Rosemary Lane - off Triadelphia Rd. - approx. 2000 ft. off
Triad. on Rosemary Lane

OCCUPANT _____ PHONE _____

PERSON TO CONSTRUCT SYSTEM _____

ADDRESS _____ PHONE _____

SIZE OF LOT 4.2 acres TYPE BLDG. _____

NUMBER OF BEDROOMS

IF NOT SINGLE RESIDENCE DESCRIBE _____

SIGNATURE OF APPLICANT Edward Seager

APPROVED BY JH Kalmore FOR Tile field DATE 9/30/65

(KIND OF SYSTEM)


REJECTED BY _____ FOR _____ DATE _____

(KIND OF SYSTEM)

HOLD PENDING FURTHER TESTS _____ DATE _____

REASONS FOR REJECTION OR HOLDING _____

THIS IS NOT A PERMIT

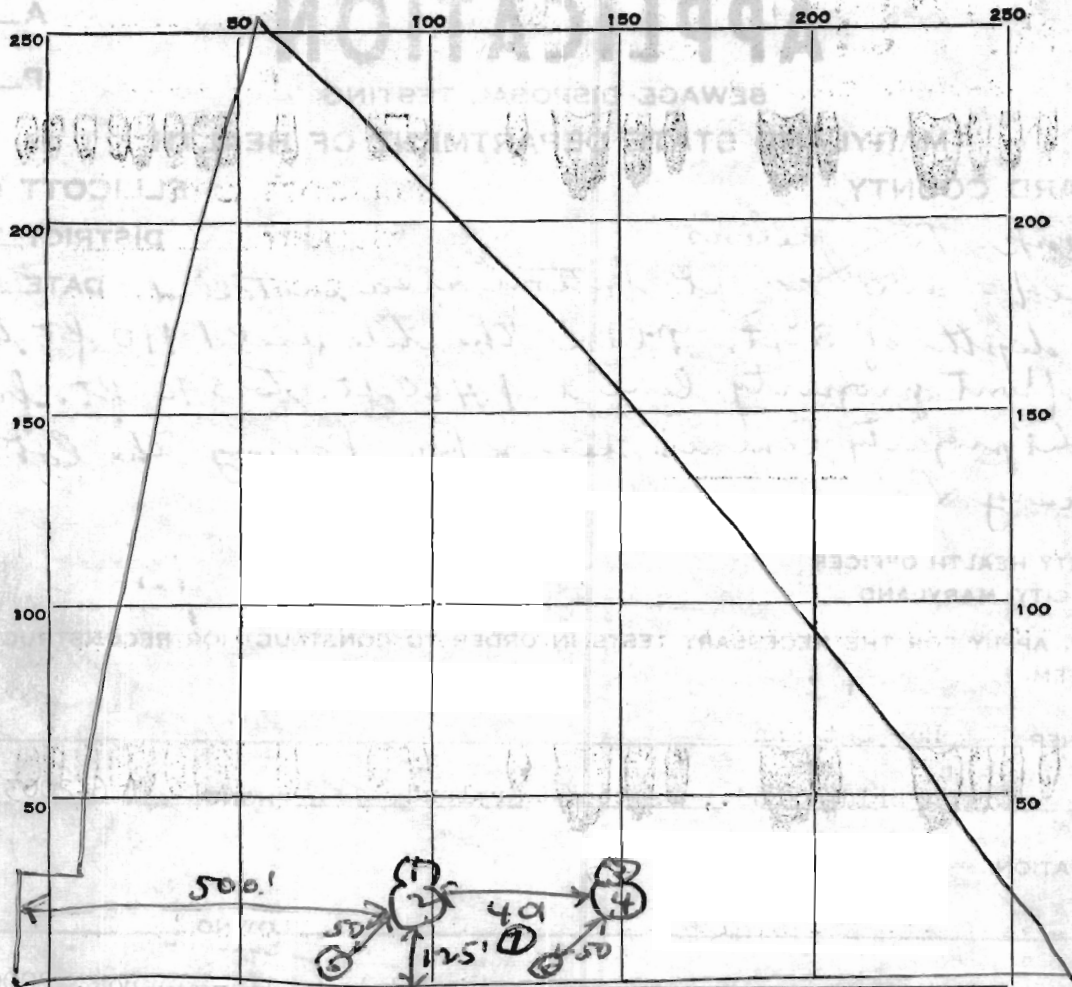

INDICATE NORTH. - NAME ADJOINING ROADWAY AS BASE LINE.

Rosemary La.

| DATE | TEST NO. | DEPTH | PRE-WET | | TEST - 1" DROP | | TIME | |
|---------|----------|--------|--|-------|----------------|------------------|--------|--|
| | | | START | STOP | START | STOP | | |
| 9/30/65 | 2 | 8' | Water at 8 ft. not tested | | | | | |
| | 1 | 3 1/2' | 11:16 | 11:18 | 11:18 | 11:21 | 3 min | |
| | 3 | 3 1/2' | 11:16 | 11:28 | 11:28 | 11:40 | 12 min | |
| | 4 | 8' | Not tested | | | | | |
| | 6 | 3 1/2' | 11:20 | 11:24 | 11:24 | 11:28 | 4 min | |
| | 5 | 3 1/2' | 11:24 | 11:26 | 11:26 | 11:28 | 2 min | |
| | 7 | 9' | 11:32 - Overtime - probable water at 9 ft. | | | | | |
| | | | | | | | | |
| | | | | | | | | |
| | | | | | | | | |

SOIL AUGER FINDING

TESTED BY AHR

REMARKS #2 water at 8 ft. not tested

Don E. Bateman