

PERMIT

SEWAGE DISPOSAL SYSTEM

DEPARTMENT OF HEALTH AND MENTAL HYGIENE

P. 50290E

A. _____

DISTRICT _____

DATE 12-9-94

DATE SYSTEM APPROVED _____

INSPECTOR _____

HOWARD COUNTY HEALTH DEPARTMENT

BUREAU OF ENVIRONMENTAL HEALTH

461-9933

05 - 418860
INDEXED

Van Sant Plumbing & Heating

IS PERMITTED TO INSTALL ALTER _____

ADDRESS 3 N. Main Street, Mt. Airy, Maryland 21771

PHONE 795-6566

SUBDIVISION Ashleigh Knolls

LOT 63

ROAD 7132 Chilton Court

PROPERTY OWNER _____

Winchester Homes

ADDRESS _____

Greenbelt, MD 20770

BLDG. PERMIT SIGNED

AND RETURNED

4/21/95
Serial # 60822-SFD(58mm)

- House is served by a shared community septic system. As part of the general permit for the community system, items previously installed or under construction include individual septic tank, connection from tank to common effluent line, community system headworks, and shared disposal fields.

- This permit is limited to installation of the individual house sewer line only. Location as per the signed building permit site plan, copy attached.

- As the community system is not yet approved for service, connection to the septic tank is prohibited at this time. Sewer line is to be capped so as to maintain a minimum 2 foot separation from the connecting stub on the inlet side of the septic tank. Contact Health Department for inspection before covering the installation.

PLANS APPROVED BY _____

DATE _____

50290E


Neighbors well

Lot 62


Lot 61

well

Neighbors well

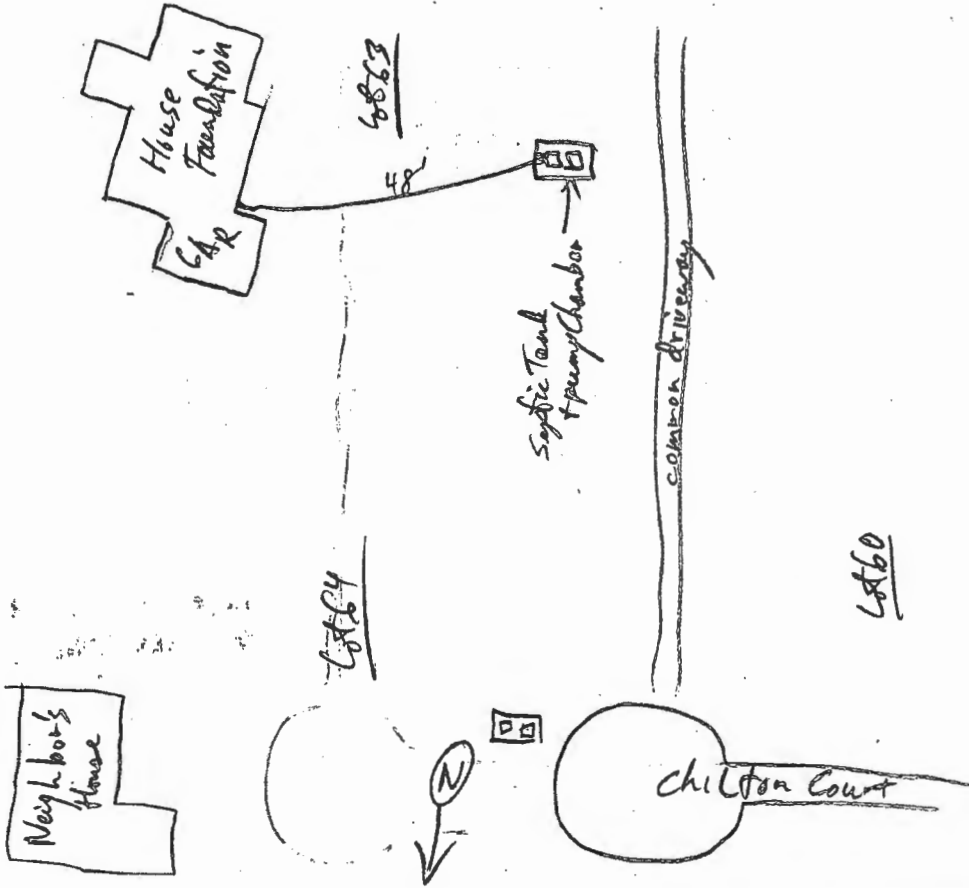

8/23/95 House Connection to Septic Tank OK to cover. RJP

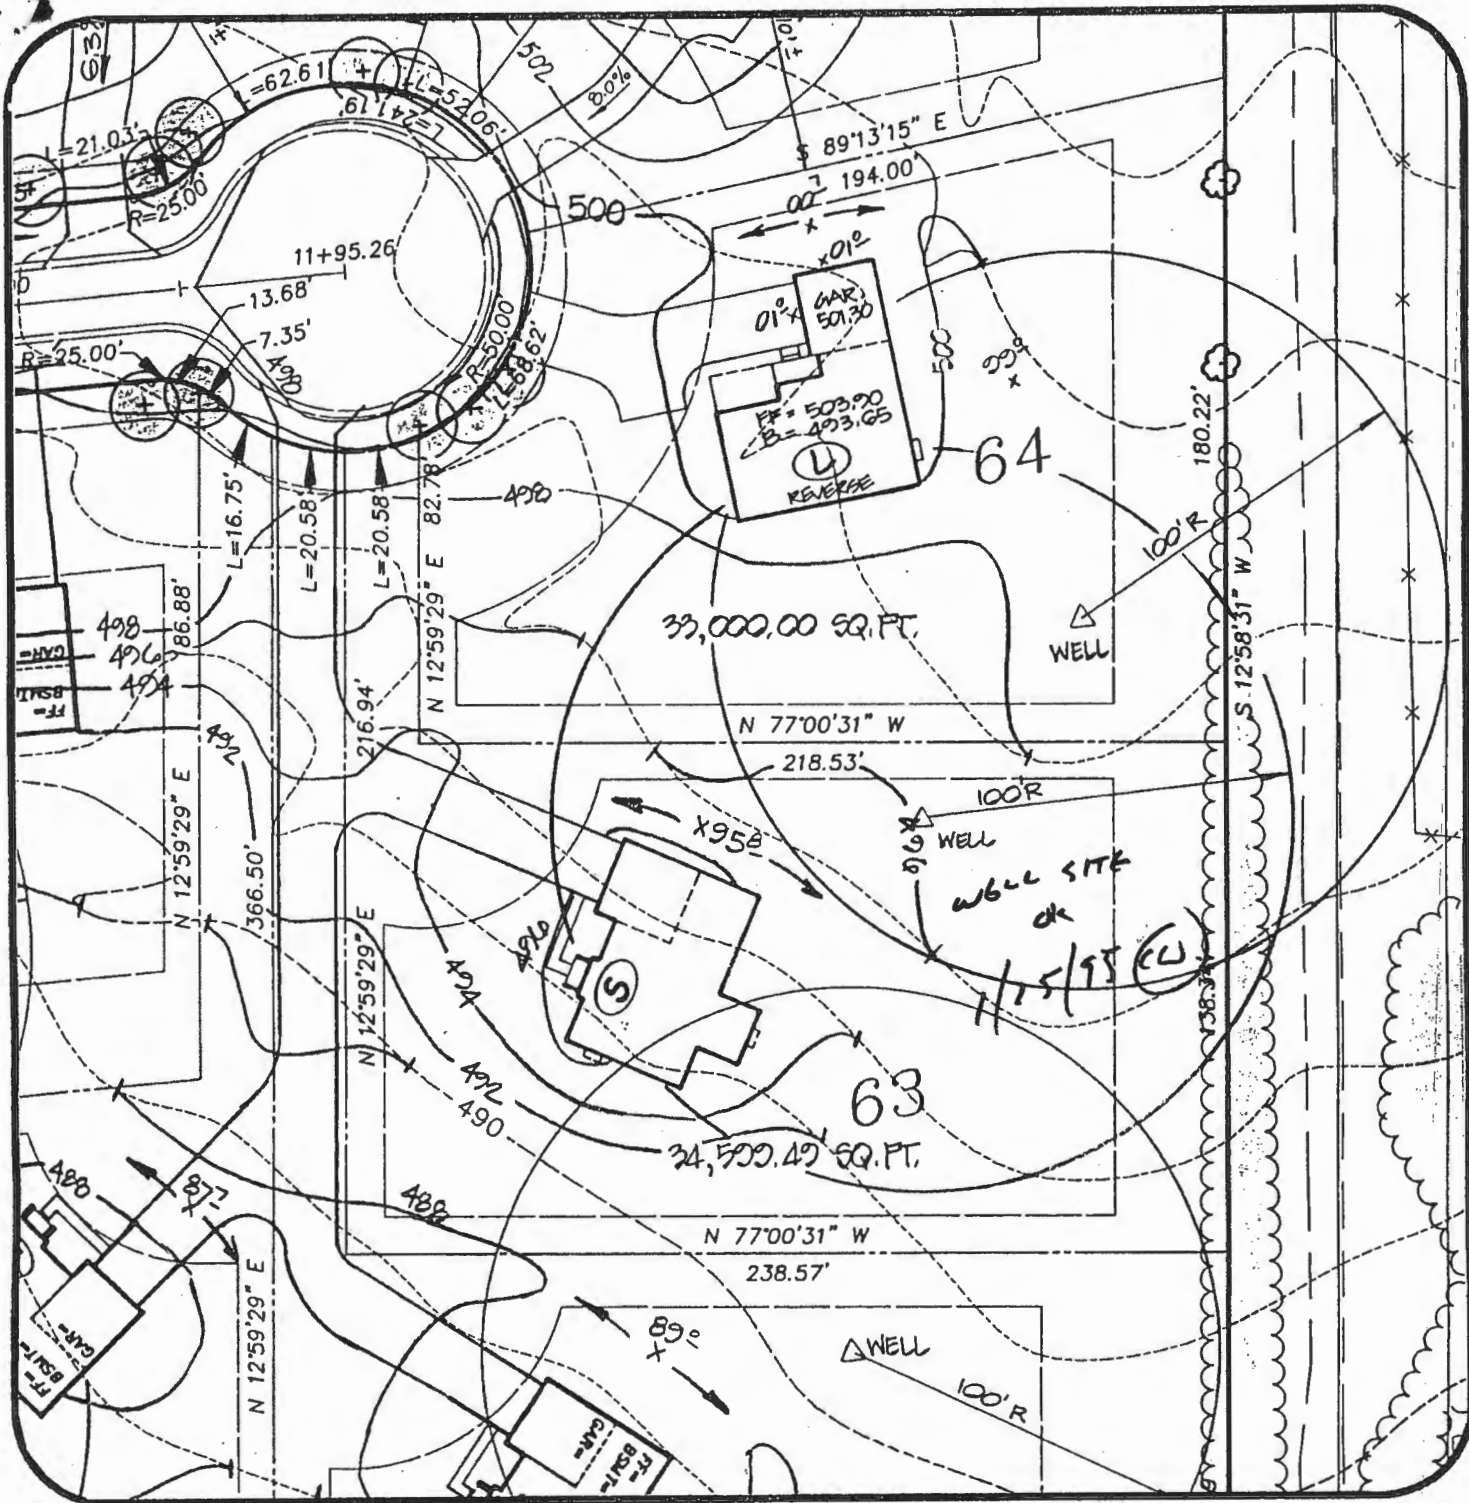

✓ Ashleigh Knolls
Lot 63

DATE: 9/20/04

PROJECT NO.:
89027.06

DRAWN BY:
TJP

SCALE:
1" = 50'

R.M. MOCHI GROUP, P.C.
CIVIL ENGINEERS
LAND SURVEYORS
PLANNERS
ENVIRONMENTAL

3300 N. Ridge Road, Suite 235
Ellicott City, MD 21043-3305

(410) 461-0079
Fax: (410) 750-6340