

APPLICATION

SEWAGE DISPOSAL TESTING

STATE OF MARYLAND - DEPARTMENT OF HEALTH AND MENTAL HYGIENE

HOWARD COUNTY HEALTH DEPARTMENT
ENVIRONMENTAL HEALTH SERVICES

P. O. BOX 476 ELLICOTT CITY, MARYLAND 21043
TELEPHONE: 992-2330

A 33431

P _____

DISTRICT 5th.

DATE December 28, 1983

TO: THE COUNTY HEALTH OFFICER
ELLICOTT CITY, MARYLAND

I, HEREBY, APPLY FOR THE NECESSARY TEST IN ORDER TO CONSTRUCT (OR RECONSTRUCT) A SEWAGE DISPOSAL SYSTEM.

PROPERTY OWNER Cherry Brae Hothouse
11961 Simpson Road
ADDRESS Clarksville, Maryland 21029 PHONE _____

PROPERTY LOCATION:

SUBDIVISION _____ LOT NO. "A" (2 EAST)

ROAD AND DESCRIPTION Farm House

SIZE OF LOT 3 acres TYPE BLDG. _____
(NUMBER OF BEDROOMS)

THE SYSTEM INSTALLED UNDER THIS APPLICATION IS ACCEPTABLE ONLY UNTIL PUBLIC FACILITIES BECOME AVAILABLE. I FULLY UNDERSTAND THE
FEE CONNECTED WITH THE FILING OF THIS PERC TEST APPLICATION IS NON-REFUNDABLE UNDER ANY CIRCUMSTANCES. I ALSO AGREE TO COMPLY
WITH ALL M.O.S.H.A. REQUIREMENTS IN TESTING THIS LOT. Wm Swann Agent 854 2608
(SIGNATURE OF APPLICANT)

APPROVED BY [Signature] FOR _____ DATE _____

REJECTED BY _____ FOR _____ DATE _____

HOLD PENDING FURTHER TESTS _____ DATE _____

REASONS FOR REJECTION OR HOLDING HOLD FOR FINAL SUBDIVISION PLAT 1-6-83 CWLlian
3/16/84 T.C.E. Rtd McCoy re straight pipe & repair system spec 5.5

THIS IS NOT A PERMIT

GREENHOUSES

WELL

HIGH
HOLE #3

SOIL PROFILE

RED CLAY

33½

RED
SAND
SAND

14

HOLE 29 RED CLAY

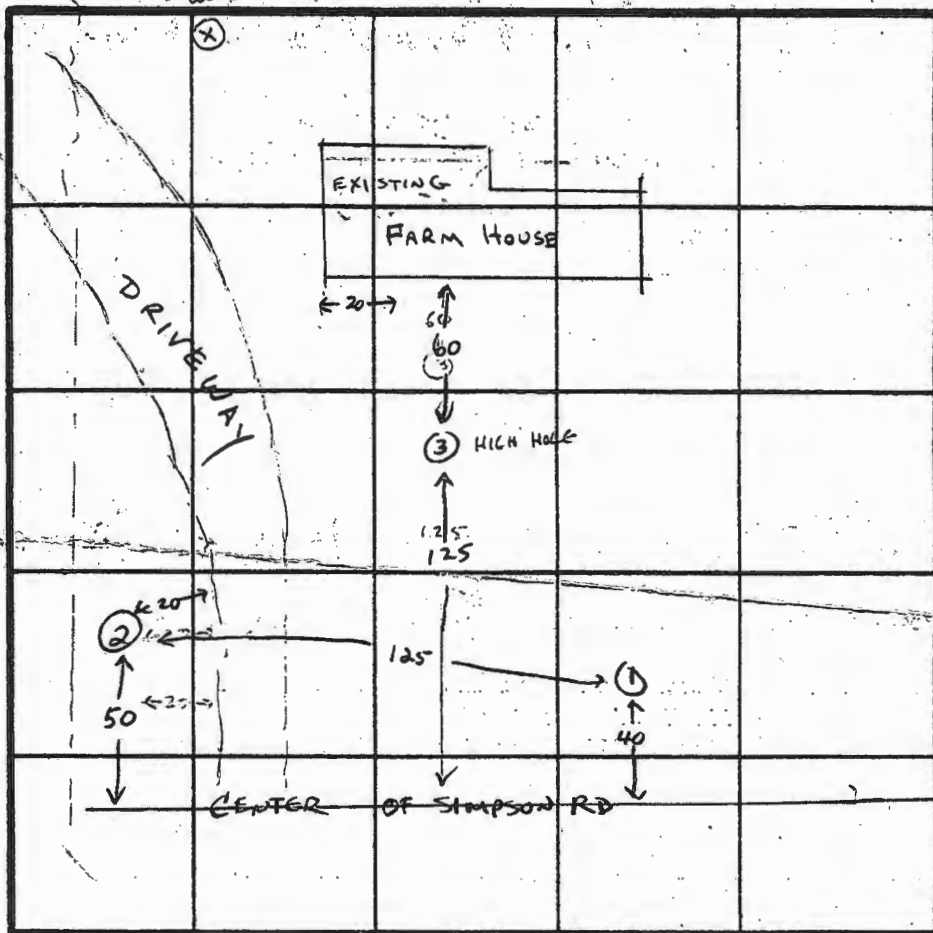
3'

RED SAND

12

LOW
HOLE #1RED
CLAY

4

RED
SAND

INDICATE NORTH - NAME ADJOINING ROADWAY AS BASE LINE.

DATE	TEST NO.	DEPTH	PRE-WET		TEST - 1" DROP		TIME
			START	STOP	START	STOP	
1-5-84	1	4 8	2:03	2:06	2:06	2:10	4 MIN
		12	SAND	4-12 FT	WATER AT 12 FT		
	2	4	2:09	2:14	2:14	2:19	5 MIN
		12	SAND	3-12 FT	DRY		
	3	4 8	2:16	2:18	2:18	2:20	2 MIN
		14	SAND	4-14'	DRY		

REMARKS

TYPE OF SOIL RED CLAY 3-4' (THEN RED SAND)

TESTED BY

C. Wilman

ALSO PRESENT

BILL SWANN, OLIVETTE LANN

EH-12-1079