

**HOWARD COUNTY
 PERMIT APPLICATION**

B09000948
PERMIT NUMBER

Building Address 7592 Rosemary Lane
D 21042

Suite/Apt. #: SDP/WP/Petition #:

Census Tract Subdivision

Section: Area Lot

Tax Map Parcel Grid

Zoning Map Coordinates Lot Size

Existing Use SFD
 Proposed Use SFD
 Estimated Construction Cost \$ 10,000⁰⁰

Description of Work 24 sq. ft. fwyer addition
one story on front of house.
11' 3" x 6' 4"

Occupant or Tenant my owner

Contact Name

Address

City State Zip Code

Phone Fax

Property Owner's Name Lisa & Craig Kelly
 Address 3552 Rosemary Lane
 City Fellsmere City State MD Zip Code 21042
 Home Phone Work Phone

Applicant's Name & Mailing Address, (if other than stated herein):
L. J. Link Jr. Architect
bx 727
Brooklandville Md. 21022
 Phone 410.337.9528 Fax 410.369.6601

Contractor Company H. J. Link Jr. Inc.
 Contact Person
 Address
 City State Zip Code
 License No.
 Phone Fax

Engineer or Architect Company L. J. Link Jr. Inc.
 Contact Person L. Link
 Address bx 727 Brooklandville Md
 City State Zip Code 21022
 Phone 410.337.9528 / 410.369.6601

BUILDING DESCRIPTION - COMMERCIAL

Building Characteristics	Utilities
Height: <u> </u>	Water Supply: <u> </u> <input type="checkbox"/> Public <input type="checkbox"/> Private
No. of stories: <u> </u>	Sewage Disposal: <u> </u> <input type="checkbox"/> Public <input type="checkbox"/> Private
Gross area, sq. ft. per floor: <u> </u>	Electric Yes <input type="checkbox"/> No <input type="checkbox"/> Gas Yes <input type="checkbox"/> No <input type="checkbox"/>
Use group: <u> </u>	Heating System: <u> </u> Electric <input type="checkbox"/> Oil <input type="checkbox"/> Natural Gas <input type="checkbox"/> Propane Gas <input type="checkbox"/>
Construction type: <input type="checkbox"/> Reinforced Concrete <input type="checkbox"/> Structural Steel <input type="checkbox"/> Masonry <input type="checkbox"/> Wood Frame <input type="checkbox"/> State Certified Modular	Sprinkler system: <u>N/A</u> <input type="checkbox"/> <input type="checkbox"/> Full <input type="checkbox"/> Partial <input type="checkbox"/> Other Suppression <input type="checkbox"/> # of Heads <u> </u>

BUILDING DESCRIPTION - RESIDENTIAL

Building Characteristics	Utilities
SF Dwelling <input checked="" type="checkbox"/> SF Townhouse <input type="checkbox"/> Depth <u> </u> Width <u> </u> 1 st floor: <u>6'4" x 10'0"</u> 2 nd floor: <u> </u> Basements: <u> </u>	Water Supply: <u> </u> <input type="checkbox"/> Public <input checked="" type="checkbox"/> Private
Finished Basement <input type="checkbox"/> Unfinished Basement <input type="checkbox"/> <input checked="" type="checkbox"/> Crawl space <input type="checkbox"/> Slab on Grade <input type="checkbox"/> No. of Bedrooms <u>N.A.</u>	Sewage Disposal: <u> </u> <input type="checkbox"/> Public <input checked="" type="checkbox"/> Private
Multi-family dwellings: No. of efficiency units: <u> </u> No. of 1 BR units: <u> </u> No. of 2 BR units: <u> </u> No. of 3 BR units: <u> </u>	Electric Yes <input checked="" type="checkbox"/> No <input type="checkbox"/> Gas Yes <input type="checkbox"/> No <input checked="" type="checkbox"/>
Other Structure: <u> </u> Dimensions: <u> </u> Footings: <u> </u> Roof: <u> </u> <input type="checkbox"/> State Certified Modular <input type="checkbox"/> Manufactured Home	Heating System: <u> </u> Electric <input checked="" type="checkbox"/> Oil <input type="checkbox"/> Natural Gas <input type="checkbox"/> Propane Gas <input checked="" type="checkbox"/>
	Sprinkler system: <u>N/A</u> <input checked="" type="checkbox"/> <input type="checkbox"/> NFPA #13D <input type="checkbox"/> NFPA #13R <input type="checkbox"/> Other: <u> </u>

THE UNDERSIGNED HEREBY CERTIFIES AND AGREES AS FOLLOWS: (1) THAT HE/SHE IS AUTHORIZED TO MAKE THIS APPLICATION; (2) THAT THE INFORMATION IS CORRECT; (3) THAT HE/SHE WILL COMPLY WITH ALL REGULATIONS OF HOWARD COUNTY WHICH ARE APPLICABLE THERETO; (4) THAT HE/SHE WILL PERFORM NO WORK ON THE ABOVE REFERENCED PROPERTY NOT SPECIFICALLY DESCRIBED IN THIS APPLICATION; (5) THAT HE/SHE GRANTS COUNTY OFFICIALS THE RIGHT TO ENTER ONTO THIS PROPERTY FOR THE PURPOSE OF INSPECTING THE WORK PERMITTED AND POSTING NOTICES.

Applicant's Signature L. J. Link Jr. Inc.
 Title/Company

Print Name L. J. Link Jr.
 Date May 7/09

Checks payable to: DIRECTOR OF FINANCE OF HOWARD COUNTY
 PLEASE WRITE NEATLY AND LEGIBLY

FOR OFFICE USE ONLY -

AGENCY	DATE	SIGNATURE	APPROVAL
Land Development, DPZ			
State Highways			
Building Officials			
Dev. Engineering, DPZ	<u>5/7/09</u>	<u>John Link</u>	
Health			
Fire Protection			

Is Sediment Control approval required prior to issuance?
 YES NO

CONTINGENCY CONSTRUCTION START:
 ONE STOP SHOP:

DPZ SETBACK INFORMATION

Front:
 Rear:
 Side:
 Side St.:

All minimum setbacks met?
 YES NO


Is Entrance Permit Required?
 YES NO
 Historic District?
 YES NO
 Lot Coverage for New Town Zone
 SDP/Red-line approval date

Accepted by

PROPERTY ID #

Filing fee \$
 Permit fee \$
 Excise tax \$
 Add'l per fee \$
 TOTAL FEES \$
 Sub-total paid \$
 Balance due \$
 Check #
 Validation #

3552 Rosemary Ln

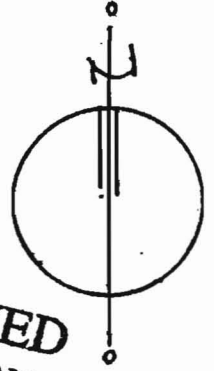

APPROVED

WALK-THRU BUILDING PERMIT

BP#

APP. SAN

DESC/OF WORK: SFD

A# 251624

DATE: 5/7/89

331.24

Form 844

5'16" 11' 19" E.

2' 10"

EXISTING HOUSE

EXIST. SEWER (L.O.)

PROPOSED DDD.

EXIST. GARAGE

EXIST. WELL

ROSEMARY LANE
10' R/W

TRIADELPHIA ROAD

° SITE ° PLAN °
1" = 50' - 0"

ADP

165.16

20' W

14.5'

60'

15' W

25' R/W

Lot 212.4
3,000 sq. ft.