

APPLICATION

SEWAGE DISPOSAL TESTING

A 14413

P _____

MARYLAND STATE DEPARTMENT OF HEALTH

HOWARD COUNTY

ELLICOTT CITY

DISTRICT 4

DATE 4/14/69

*Free. 4/17/69
9:30*

Septic Tank - 750 gal.

Dry Well - 446 sq ft absorbent side wall area to begin below the first 5 ft of non absorbent ground.

Place Dry Well 70 ft behind left rear corner of house as seen when facing the front rear of lot.

Max depth permitted for dry well below orig. grade is 13 ft.

TO: THE COUNTY HEALTH OFFICER
ELLICOTT CITY, MARYLAND

I, HEREBY, APPLY FOR THE NECESSARY TESTS IN ORDER TO CONSTRUCT (OR RECONSTRUCT) A SEWAGE DISPOSAL SYSTEM.

PROPERTY OWNER Wilson Howard Triplett

ADDRESS Hardy Road, Rt. 3, Mt. Airy, Md. PHONE 489-4535

PROPERTY LOCATION:

SUBDIVISION _____ LOT NO. _____

ROAD AND DESCRIPTION Rt. 144 - approx. 250 ft. from Watersville Road left side - single house beside white duplex

OCCUPANT _____ PHONE _____

PERSON TO CONSTRUCT SYSTEM _____

ADDRESS _____ PHONE _____

SIZE OF LOT This single house and the duplex are both on 1.2 acres of ground TYPE BLDG. Existing house
NUMBER OF BEDROOMS 2

IF NOT SINGLE RESIDENCE DESCRIBE _____

SIGNATURE OF APPLICANT Mrs. Howard Triplett


APPROVED BY Donald V. Monaghan FOR Dry Well DATE 4-17-69
(KIND OF SYSTEM)

REJECTED BY _____ FOR _____ DATE _____
(KIND OF SYSTEM)

HOLD PENDING FURTHER TESTS _____ DATE _____

REASONS FOR REJECTION OR HOLDING _____

THIS IS NOT A PERMIT

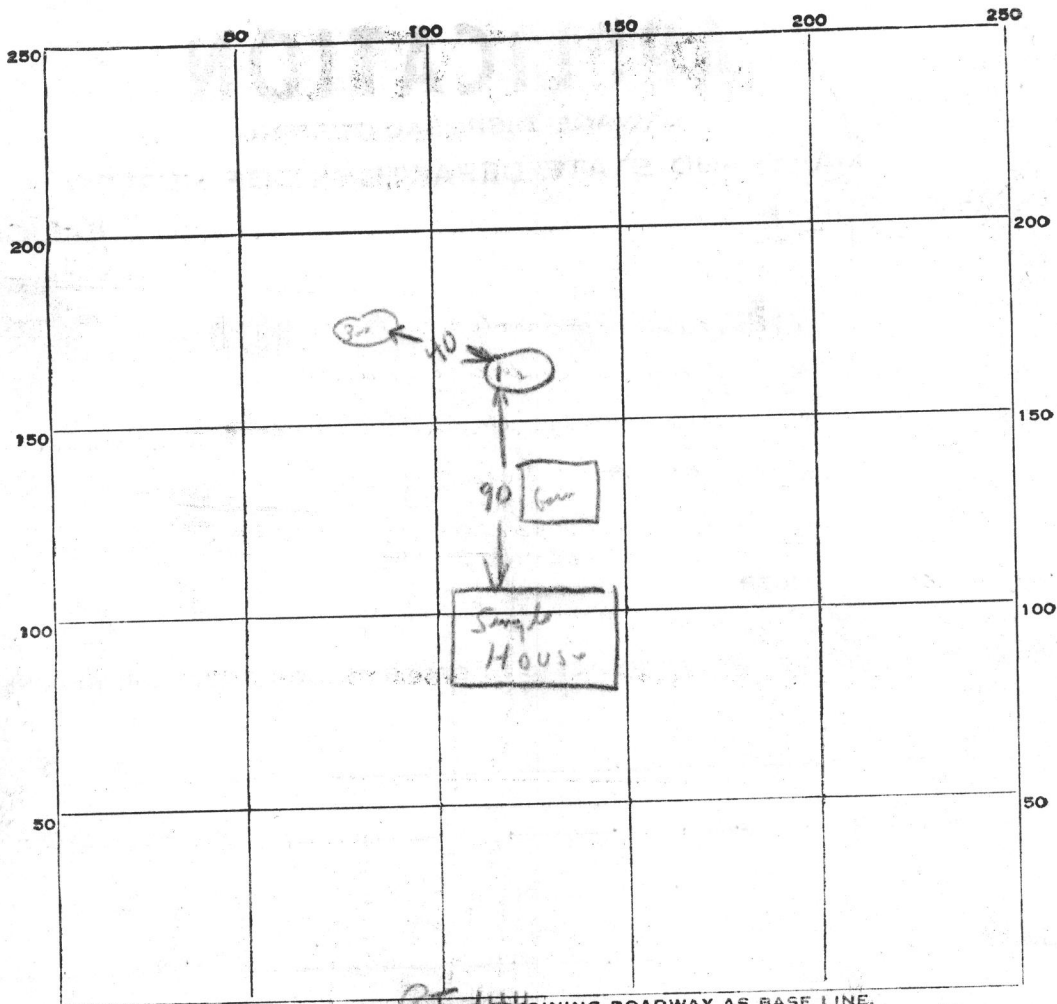

DATE	TEST NO.	DEPTH	PRE-WET		TEST - 1" DROP		TIME
			START	STOP	START	STOP	
4/1	1	16 ft	9 33	9 42	9 46	10 12	27 min
	2	4 1/2 ft	9 34	9 40	9 40	overtime	
	3	7 ft	9 36	9 45	9 45	10 00	15 min
	4	4 ft	9 36	overtime			

SOIL AUGER FINDING

TESTED BY: *4/7/69 [Signature]*
aloyant → *Ground Slight*

APPLICATION

A 14413

P _____

SEWAGE DISPOSAL TESTING

MARYLAND STATE DEPARTMENT OF HEALTH

HOWARD COUNTY

ELLICOTT CITY

DISTRICT 4

DATE 4/14/69

TO: THE COUNTY HEALTH OFFICER
ELLICOTT CITY, MARYLAND

I, HEREBY, APPLY FOR THE NECESSARY TESTS IN ORDER TO CONSTRUCT (OR RECONSTRUCT) A SEWAGE DISPOSAL SYSTEM.

PROPERTY OWNER Wilson Howard Triplett

ADDRESS Hardy Road, Rt. 3, Mt. Airy, Md. PHONE 489-4535

PROPERTY LOCATION:

SUBDIVISION _____ LOT NO. _____

ROAD AND DESCRIPTION Rt. 144 - approx. 250 ft. from Watersville Road
left side - single house beside white duplex

OCCUPANT _____ PHONE _____

PERSON TO CONSTRUCT SYSTEM _____

ADDRESS _____ PHONE _____

SIZE OF LOT This single house and the duplex are TYPE BLDG. Existing house
both on 1.2 acres of ground NUMBER OF BEDROOMS 2

IF NOT SINGLE RESIDENCE DESCRIBE _____

SIGNATURE OF APPLICANT Mrs. Howard Triplett


APPROVED BY Donald W. Manly FOR _____ (KIND OF SYSTEM) DATE _____

REJECTED BY _____ FOR Wells (KIND OF SYSTEM) DATE 4-17-69

HOLD PENDING FURTHER TESTS _____ DATE _____

REASONS FOR REJECTION OR HOLDING _____

THIS IS NOT A PERMIT

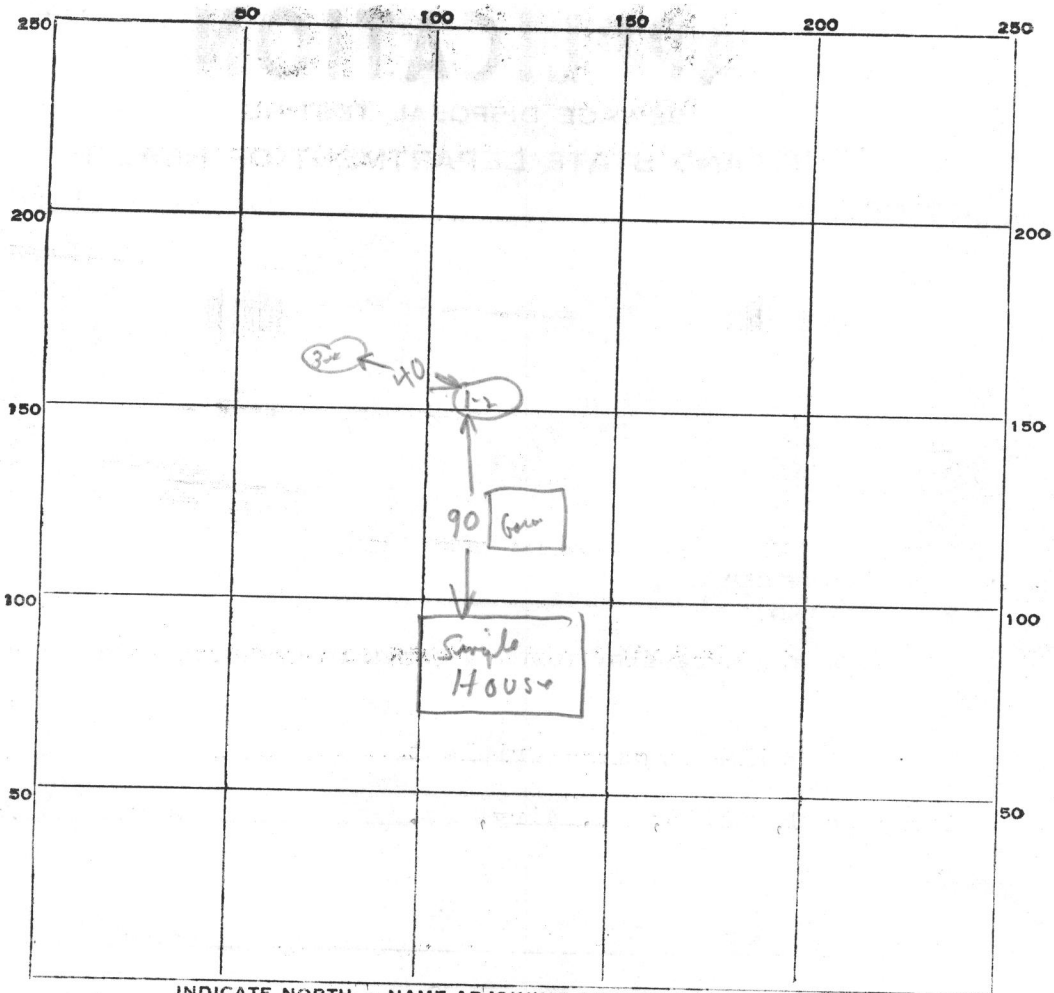

INDICATE NORTH. - NAME ADJOINING ROADWAY AS BASE LINE.

RT 144

DATE	TEST NO.	DEPTH	PRE-WET		TEST - 1" DROP		TIME
			START	STOP	START	STOP	
4/1	1	16 ft	9:33	9:46	9:46	10:13	27 min
	2	4 1/2 ft	9:34	9:40	9:40	overtime	
	3	9 ft	9:36	9:45	9:45	10:00	15 min
	4	4 ft	9:36	overtime			

SOIL AUGER FINDING

TESTED BY: *4/1/68 Dan*

Howard Smith

also just →


APPROVED FOR PRIVATE WATER & SEWERAGE

DR. THEODORE R. SHROP

DATE

HOWARD COUNTY HEALTH OFFICER

Md. Rte. 5. 76° 30' E. 144 Poplar Spring

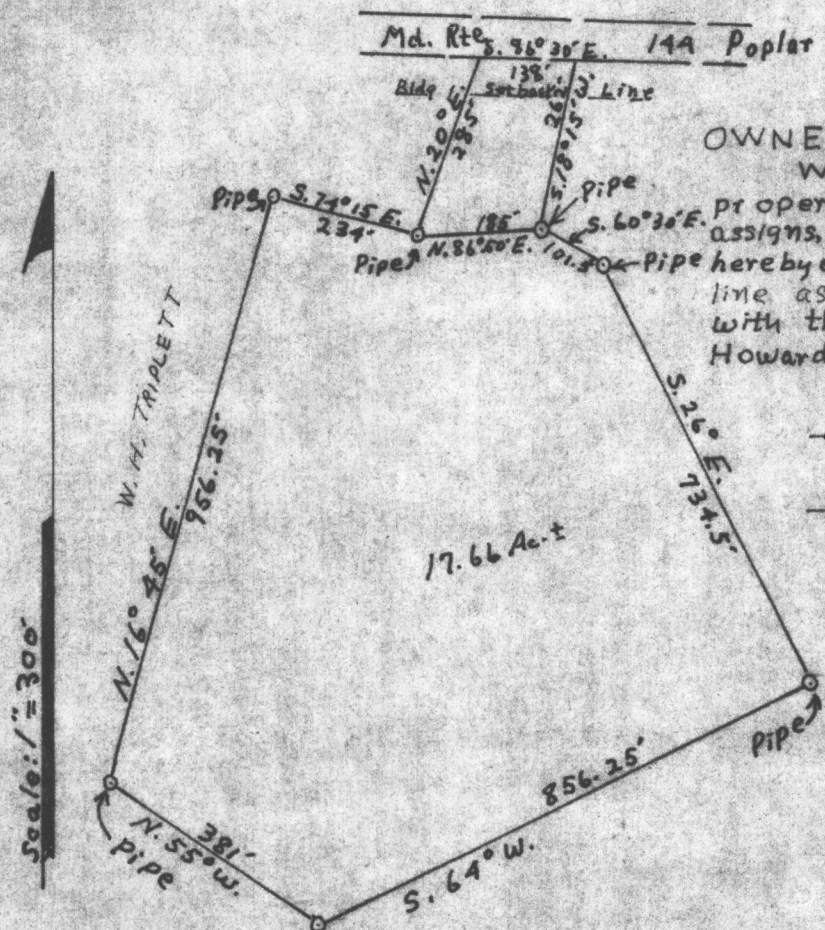

OWNERS STATEMENT

We, the undersigned owners of the property shown hereon, our heirs or assigns, adopt this plan of subdivision and do hereby establish the building setback restriction line as shown hereon in order to comply with the general plan of Highways of Howard County.

Wilson H. Triplett

Date


Date

NOTE:

No new building or extension or addition to an existing building is to be constructed at a distance less than the building restriction line shown hereon.

APPROVED BY VIRTUE OF PLANNING COMMISSION ACTION

T. G. HARRIS, JR. PLANNING DIRECTOR - DATE
HOWARD COUNTY PLANNING COMMISSION.

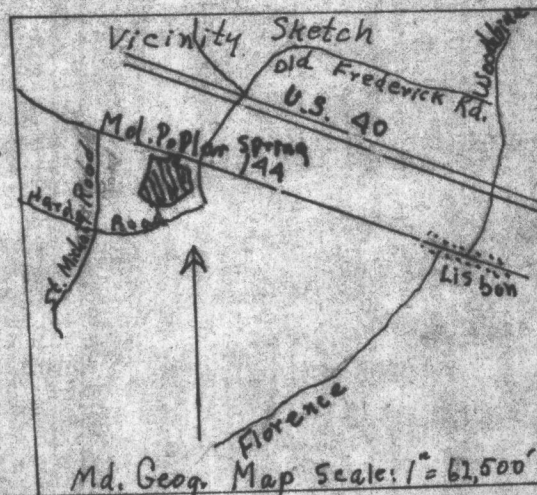

PREPARED BY
J. HARRY KOLLER
REG. LAND SURVEYOR
No. 250
Rt. 2. SYKESVILLE, MD.
21784

OWNER: WILSON HOWARD TRIPLETT
FOURTH ELECTION DISTRICT,
HOWARD COUNTY, MD.
TITLE REFERENCE: R. 3, MT. AIRY, MD.
21771