

660 sq. ft. tile field
3 trenches, 3 ft wide, each
73 ft. long.
750 gal. Septic tank

HOWARD COUNTY HEALTH DEPARTMENT
APPLICATION-SEWAGE DISPOSAL TESTING

00313

Application No. _____

District 11-28-58

Date _____

Attn 6-2476

TO: THE COUNTY HEALTH OFFICER
Ellicott City, Maryland

I, hereby, apply for the necessary tests in order to construct (or re-construct) a sewage disposal system.

William and Martha Thompson

PROPERTY OWNER _____ E.C. 508 M

Address Chestnut Hill, Ellicott City Phone _____

LOCATION OF PROPERTY: Subdivision _____ Lot No. _____

On Rt. 144 - Go in Roy Feaga entrance which is opposite
Marriottville Rd. Go to Mr. Feaga's house and someone there will take
Sanitarian to lot. Mr. Feagass house is a stone ranch house.

OCCUPANT OF PROPERTY _____

Address _____ Phone _____

PERSON TO CONSTRUCT PLANT _____

Address _____ Phone _____

SIZE OF LOT 1 acre

TYPE OF BUILDING TO BE SERVED Residence

SYSTEM TO SERVE _____ PEOPLE _____ NO. OF BEDROOMS 3

PERMIT NUMBER _____ FEE \$10.00


SIGNATURE OF APPLICANT Martha E. Thompson

APPROVED BY James E. Hennig DATE 12-3-58

REJECTED BY _____ DATE _____

REASONS FOR REJECTION _____

FOR TEST FINDINGS, SEE OTHER SIDE.

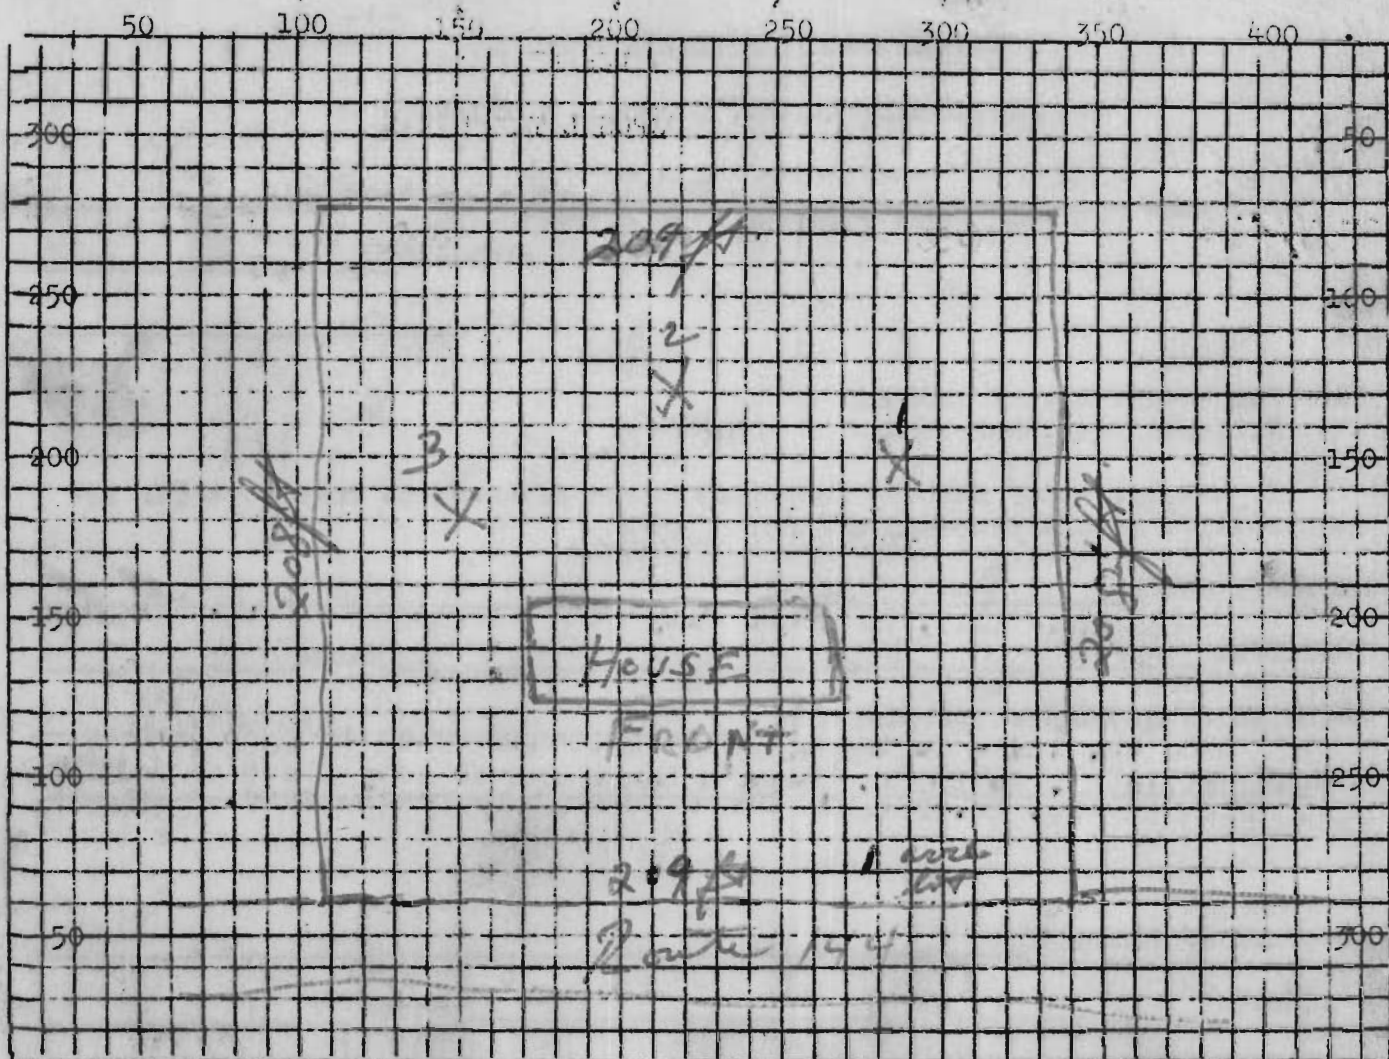

Above: Sketch property showing dimensions, location and numbers of test holes distance to adjoining wells and slope of ground. Each square = 10 ft.

LAST PREVIOUS RAIN _____

RAINFALL FOR YEAR _____

DATE	TEST NO.	TEST DEPTH	PRE-WET 6"		TIME START	TIME STOP	TOTAL TIME
			START	STOP			
12-3-58	1	3 ft	10:11		10:12	10:50	38 minutes
	2		10:29	3/4 inch	60 min - Pre-Wet -		
	3		10:38	10:55	10:55	11:20	25 minutes

SOIL AUGER FINDING: _____

TEST CONDUCTED BY J. Herringan DATE 12-3-58

ALSO, PRESENT Brother-in-law SIGNATURE _____

REMARKS: _____ TITLE _____