

RECORDED

APPLICATION

A 21696

SEWAGE DISPOSAL TESTING

P _____

STATE OF MARYLAND - DEPARTMENT OF HEALTH AND MENTAL HYGIENE

HOWARD COUNTY HEALTH DEPARTMENT
ENVIRONMENTAL HEALTH SERVICES
P. O. BOX 476, ELLICOTT CITY, MARYLAND 21043
TELEPHONE: 465-5000, EXT. 356

DISTRICT 3rd

DATE 6/23/75

7/15/75
9:30 A.M.

TO: THE COUNTY HEALTH OFFICER
ELLICOTT CITY, MARYLAND

I, HEREBY, APPLY FOR THE NECESSARY TEST IN ORDER TO CONSTRUCT (OR RECONSTRUCT) A SEWAGE DISPOSAL SYSTEM.

PROPERTY OWNER Ethel L. Slack Estate
ADDRESS _____ PHONE 465-4242
Any questions call James Moxley, Jr.

PROPERTY LOCATION:

SUBDIVISION _____ LOT NO. 9

ROAD AND DESCRIPTION Corner Route 32 and Route 99

SIZE OF LOT 5 acres TYPE BLDG. 3 or 4 bedrooms
NUMBER OF BEDROOMS

IF NOT SINGLE RESIDENCE DESCRIBE _____

THE SYSTEM INSTALLED UNDER THIS APPLICATION IS ACCEPTABLE ONLY UNTIL PUBLIC FACILITIES BECOME AVAILABLE.

SIGNATURE OF APPLICANT James R. Moxley, Jr. Agent

APPROVED BY R. O'Neil FOR Dev. well & Tanks DATE 7/15/75
(KIND OF SYSTEM)


REJECTED BY _____ FOR _____ DATE _____
(KIND OF SYSTEM)

HOLD PENDING FURTHER TESTS _____ DATE _____

REASONS FOR REJECTION OR HOLDING _____

THIS IS NOT A PERMIT

General
 Topsoil
 clay loam
 — 4 1/2
 Sandy
 loam
 saprolite
 — 12'

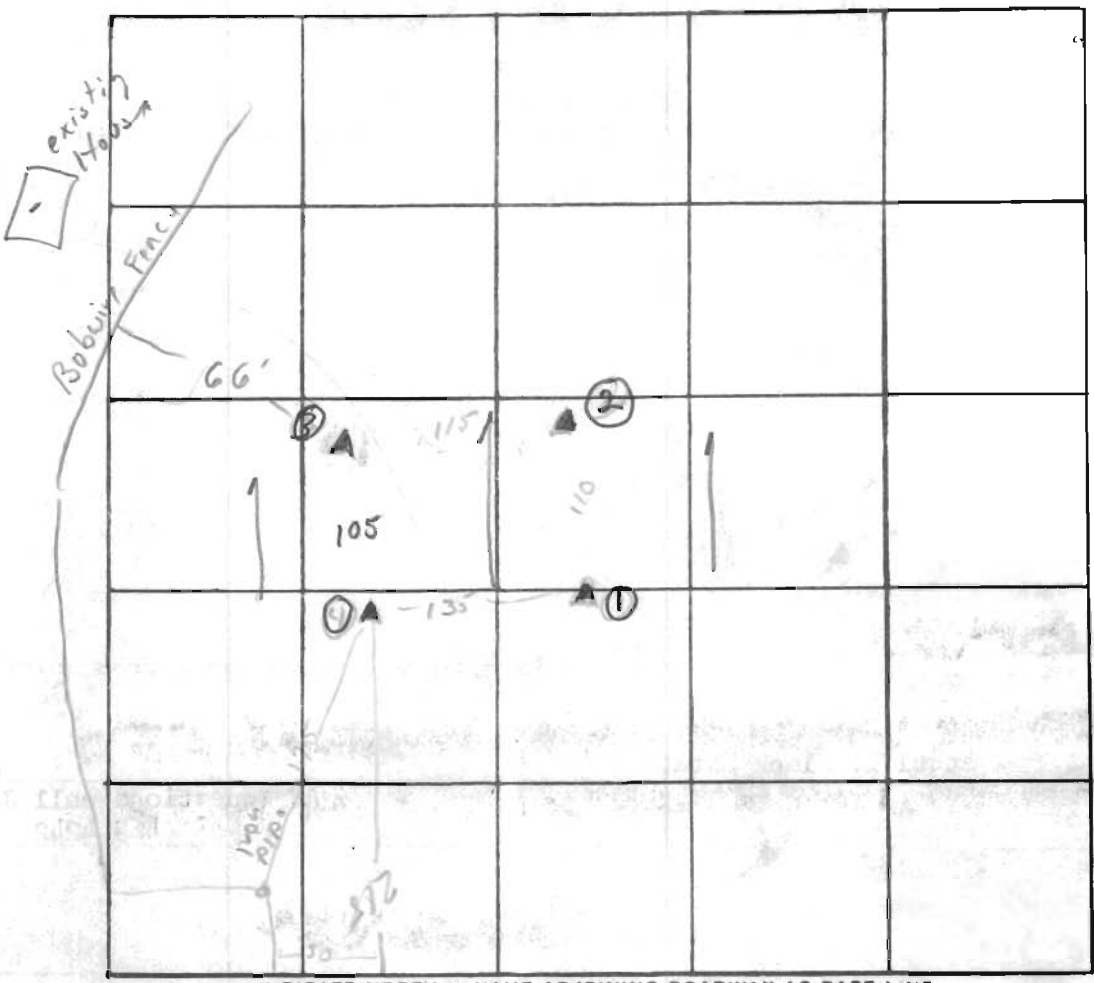

INDICATE NORTH. - NAME ADJOINING ROADWAY AS BASE LINE

DATE	TEST NO.	DEPTH	PRE-WET		TEST - 1" DROP		TIME	
			START	STOP	START	STOP		
7/14/75	1s	4 1/2	9 43	9 49	9 44	9 45	1	
"	1d	12 1/2	9 43	9 45	9 45	9 52	7	
"	2s	5 1/2	9 50	9 51	9 51	9 52	1	
"	2d	12 1/2	9 50	9 55	9 55	10 01	9	
"	3s	4 1/2	9 58	10 00	10 00	10 04	4	
"	3d	11 1/2	9 55	10 03	10 03	10 14	11	
"	4	12' Visual - good soil 4 1/2 - 11'						

REMARKS Dry well to go between land 4 4 1/2 - 10'

TYPE OF SOIL Sandy loam - Saprolite

TESTED BY D/O'Neill

Flock crew - Danny + Ron
 ALSO PRESENT: James Roy + Son

July 23, 1975

TO WHOM IT MAY CONCERN:

This is to advise that Lot 9, Ethel L. Slack property, corner of Route 99 and Route 32, passed the standard percolation tests on July 15, 1975.

Very truly yours,


Donald W. Monaghan, Chief
Division of Water and Sewer

DWM:hs

Mailed to: Mr. James R. Moxley, Jr.
13155 Route 144
West Friendship, Md. 21794



MARYLAND STATE ROUTE No. 32
EAST MARGIN

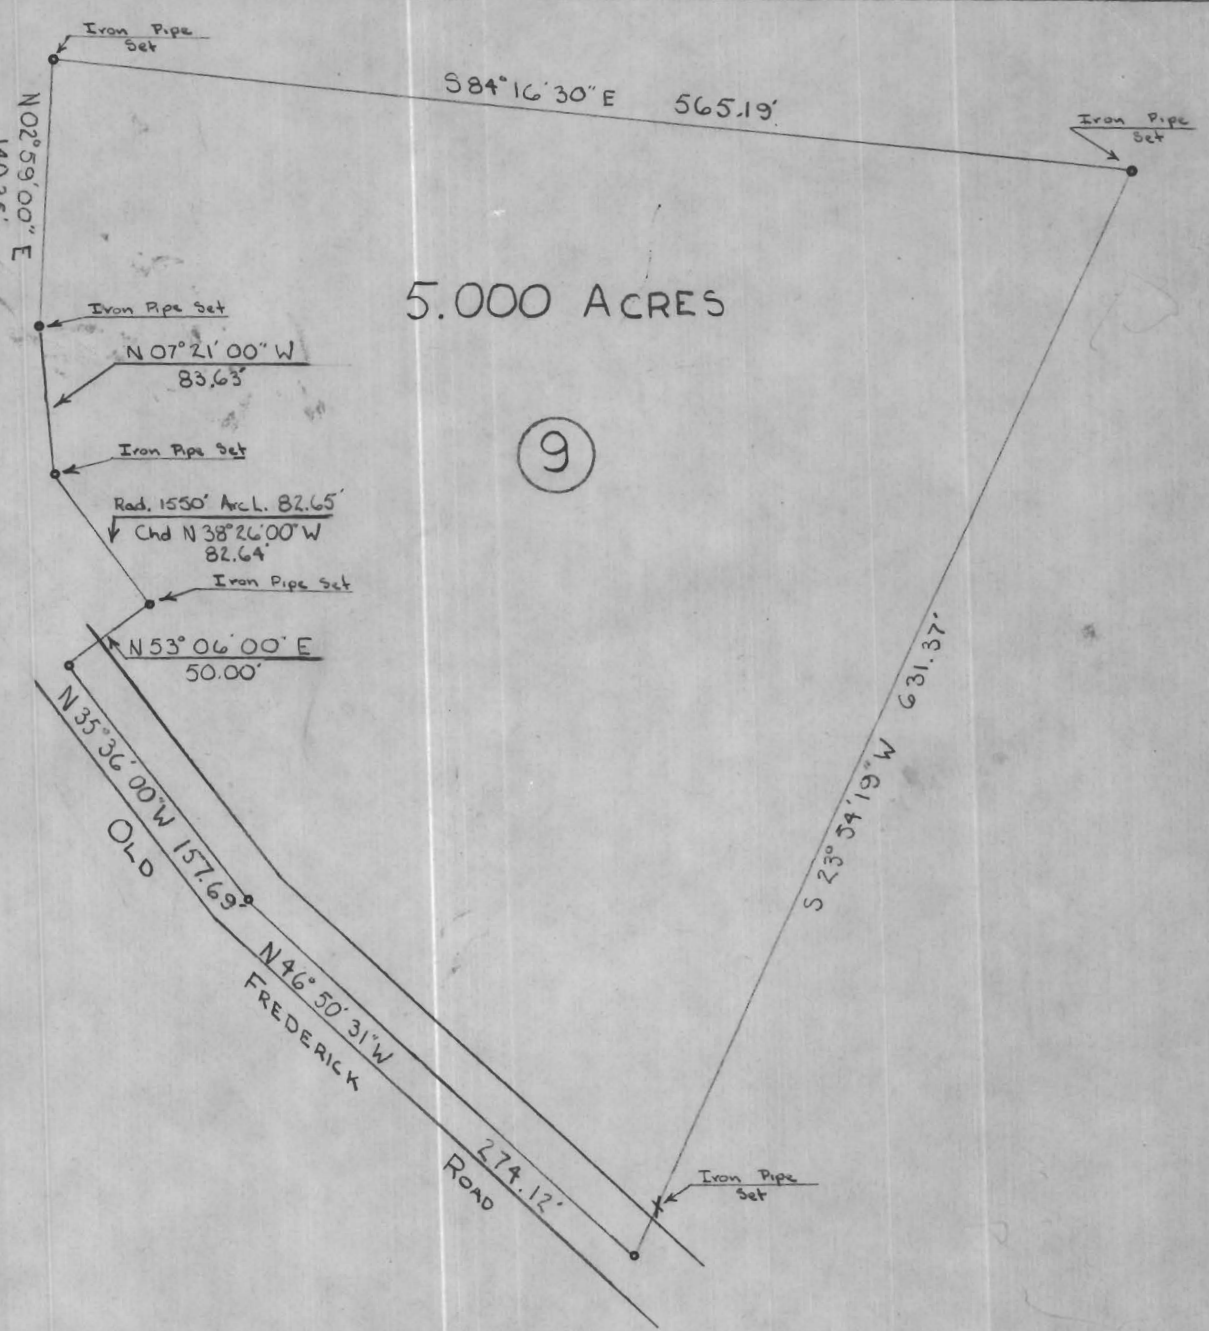

PLAT OF SURVEY
FOR
ETHEL L. SLACK ESTATE
THIRD ELECTION DISTRICT, HOWARD COUNTY
WEST FRIENDSHIP, MARYLAND
SCALE 1IN=100FT APRIL 16, 1974

Note: The lot shown hereon complies with the minimum ownership and lot area as required by the Maryland State Health Department.

Approved: Private Water and Private Sewer.

Howard County Health Officer _____ Date _____

