

HOWARD COUNTY HEALTH DEPARTMENT

APPLICATION-SEWAGE DISPOSAL TESTING

*Oct. 21  
9:30 a.m.*

**\* INDEXED**

Application No. A00159

District 4

Date 10-15-58

TO: THE COUNTY HEALTH OFFICER  
Ellicott City, Maryland

I, hereby, apply for the necessary tests in order to construct (or re-construct) a sewage disposal system.

PROPERTY OWNER John Edgar Fleming, Jr.

Address Mt. Airy Phone Mt. Airy 493

LOCATION OF PROPERTY: Subdivision \_\_\_\_\_ Lot No. \_\_\_\_\_

Road Rt. 144 at Lisbon - next to Joseph Donovan's Store.

OCCUPANT OF PROPERTY above

Address \_\_\_\_\_ Phone \_\_\_\_\_

PERSON TO CONSTRUCT PLANT \_\_\_\_\_

Address \_\_\_\_\_ Phone \_\_\_\_\_

SIZE OF LOT 1 acre more or less

TYPE OF BUILDING TO BE SERVED residence

SYSTEM TO SERVE 6 PEOPLE NO. OF BEDROOMS 3

PERMIT NUMBER \_\_\_\_\_


SIGNATURE OF APPLICANT Mary Jane Fleming

APPROVED BY \_\_\_\_\_ DATE \_\_\_\_\_

REJECTED BY \_\_\_\_\_ DATE \_\_\_\_\_

REASONS FOR REJECTION \_\_\_\_\_

FOR TEST FINDINGS, SEE OTHER SIDE.

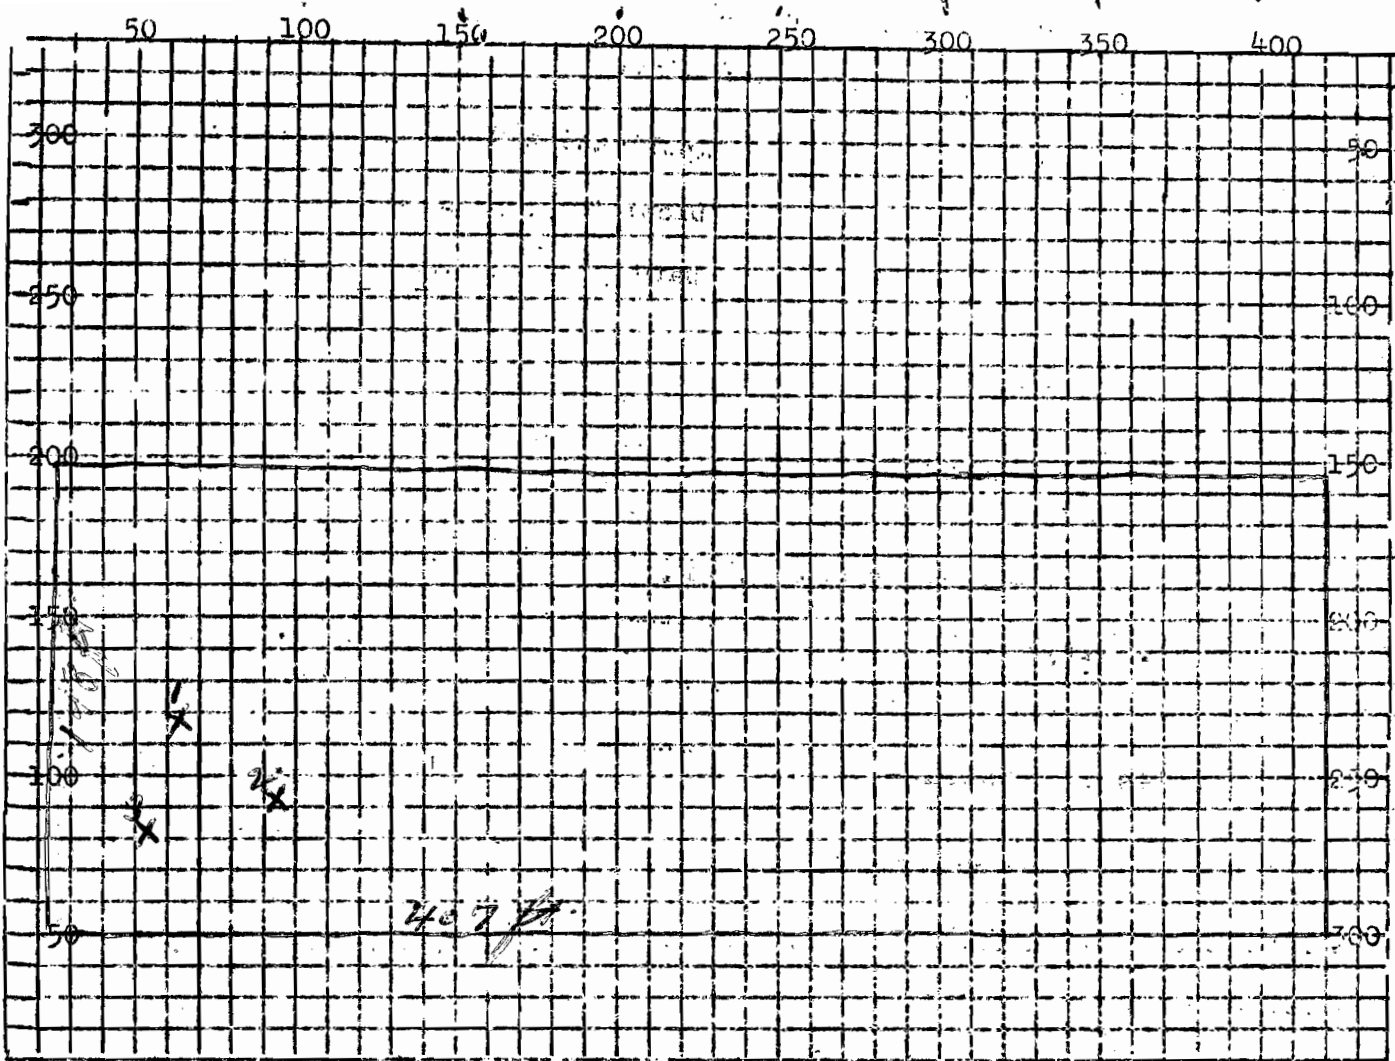

Above: Sketch property showing dimensions, location and numbers of test holes distance to adjoining wells and slope of ground. Each square = 10 ft.

LAST PREVIOUS RAIN \_\_\_\_\_  
 RAINFALL FOR YEAR \_\_\_\_\_

X = TEST HOLES

DATE	TEST NO.	TEST DEPTH	PRE-JET 6"		TIME START	TIME STOP	TOTAL TIME
			START	STOP			
10-21-58	1	3 ft	10:33	over 40 Minutes Per Test			
	2		10:37				
	3		10:38		11:00	about 50 Minutes Per	

SOIL AUGER FINDING: \_\_\_\_\_

TEST CONDUCTED BY John Henninger DATE 10-21-58

ALSO, PRESENT John D. Janner SIGNATURE John Henninger

REMARKS: \_\_\_\_\_ TITLE \_\_\_\_\_