

VB 8/16/19

Search Result for HOWARD COUNTY

View Map		View GroundRent Redemption		View GroundRent Registration							
Tax Exempt:		Special Tax Recapture:									
Exempt Class:		NONE									
Account Identifier:		District - 06 Account Number - 476295									
Owner Information											
Owner Name:		VAETH STEPHEN J VAETH JUDI		Use: RESIDENTIAL							
Mailing Address:		9791 OWEN BROWN RD COLUMBIA MD 21045-4303		Principal Residence: YES							
				Deed Reference: /01728/ 00269							
Location & Structure Information											
Premises Address:		9791 SW OWEN BROWN RD COLUMBIA 21045-0000		Legal Description: LOT 8 .592 A 9791 OWEN BROWN RD CUNDY SUBD							
Map:	Grid:	Parcel:	Sub District:	Subdivision:	Section:	Block:	Lot:	Assessment Year:	Plat No:	5597	
0036	0009	0395		1001			8	2020	Plat Ref:		
Special Tax Areas:				Town:		NONE					
				Ad Valorem:		104					
				Tax Class:							
Primary Structure Built		Above Grade Living Area		Finished Basement Area		Property Land Area		County Use			
1986		2,698 SF				25,787 SF					
Stories	Basement	Type	Exterior	Full/Half Bath	Garage	Last Major Renovation					
2	NO	SPLIT LEVEL	FRAME	2 full							
Value Information											
		Base Value		Value		Phase-in Assessments					
				As of		As of		As of			
				01/01/2017		07/01/2019		07/01/2020			
Land:		147,700		147,700							
Improvements		242,900		242,900							
Total:		390,600		390,600		390,600					
Preferential Land:		0									
Transfer Information											
Seller: TATTRIE LEVY CONSTRUCTION CO INC			Date: 09/25/1987			Price: \$197,000					
Type: ARMS LENGTH IMPROVED			Deed1: /01728/ 00269			Deed2:					
Seller: CUNDY THOMAS E			Date: 04/04/1986			Price: \$32,500					
Type: ARMS LENGTH IMPROVED			Deed1: /01457/ 00497			Deed2:					
Seller:			Date:			Price:					
Type:			Deed1:			Deed2:					
Exemption Information											
Partial Exempt Assessments:		Class		07/01/2019		07/01/2020					
County:		000		0.00							
State:		000		0.00							
Municipal:		000		0.00		0.00					
Tax Exempt:		Special Tax Recapture:									
Exempt Class:		NONE									
Homestead Application Information											
Homestead Application Status: Approved						08/17/2009					

Homeowners' Tax Credit Application Status: No Application

Date:

1. This screen allows you to search the Real Property database and display property records.
2. Click **here** for a glossary of terms.
3. Deleted accounts can only be selected by Property Account Identifier.
4. The following pages are for information purpose only. The data is not to be used for legal reports or documents. While we have confidence in the accuracy of these records, the Department makes no warranties, expressed or implied, regarding the information.

Aug. 13-14

McINTOSH - OWEN BROWN Rd.

Route 29 South to

Owen Brown Rd. Left

past Broken Land Parkway

to Right between 2 large

Hemlock trees on RIGHT

(last drive before Forty Winks)

HOWARD COUNTY HEALTH DEPARTMENT

P.O. BOX 476
ELLCOTT CITY, MARYLAND 21043
TELEPHONE: 992-2333

November 29, 19 79

MEMORANDUM

TO: *Betty DeVilbiss*

FROM: *Helen Smoot*

RE: *Refunding of money paid by Mr. Peter McIntosh for percolation tests*

Mr. Peter J. McIntosh, 1290 Woodbine Road, Woodbine, Maryland 21797 paid for six (6) percolation tests in August of 1979 and only one lot was tested. Public sewer is available to the rest of the lots so therefore there is no need for percolation tests to be done. Please refund him money for 5 lots that were not tested (application receipt numbers are 30086, 30087, 30088, 30089 and 30091.


hs


*Ok # 274
Acct # 10-361-6
11/30/79
BCH*

Aug 6, 1979

CW. Banditts

USDA-SCS

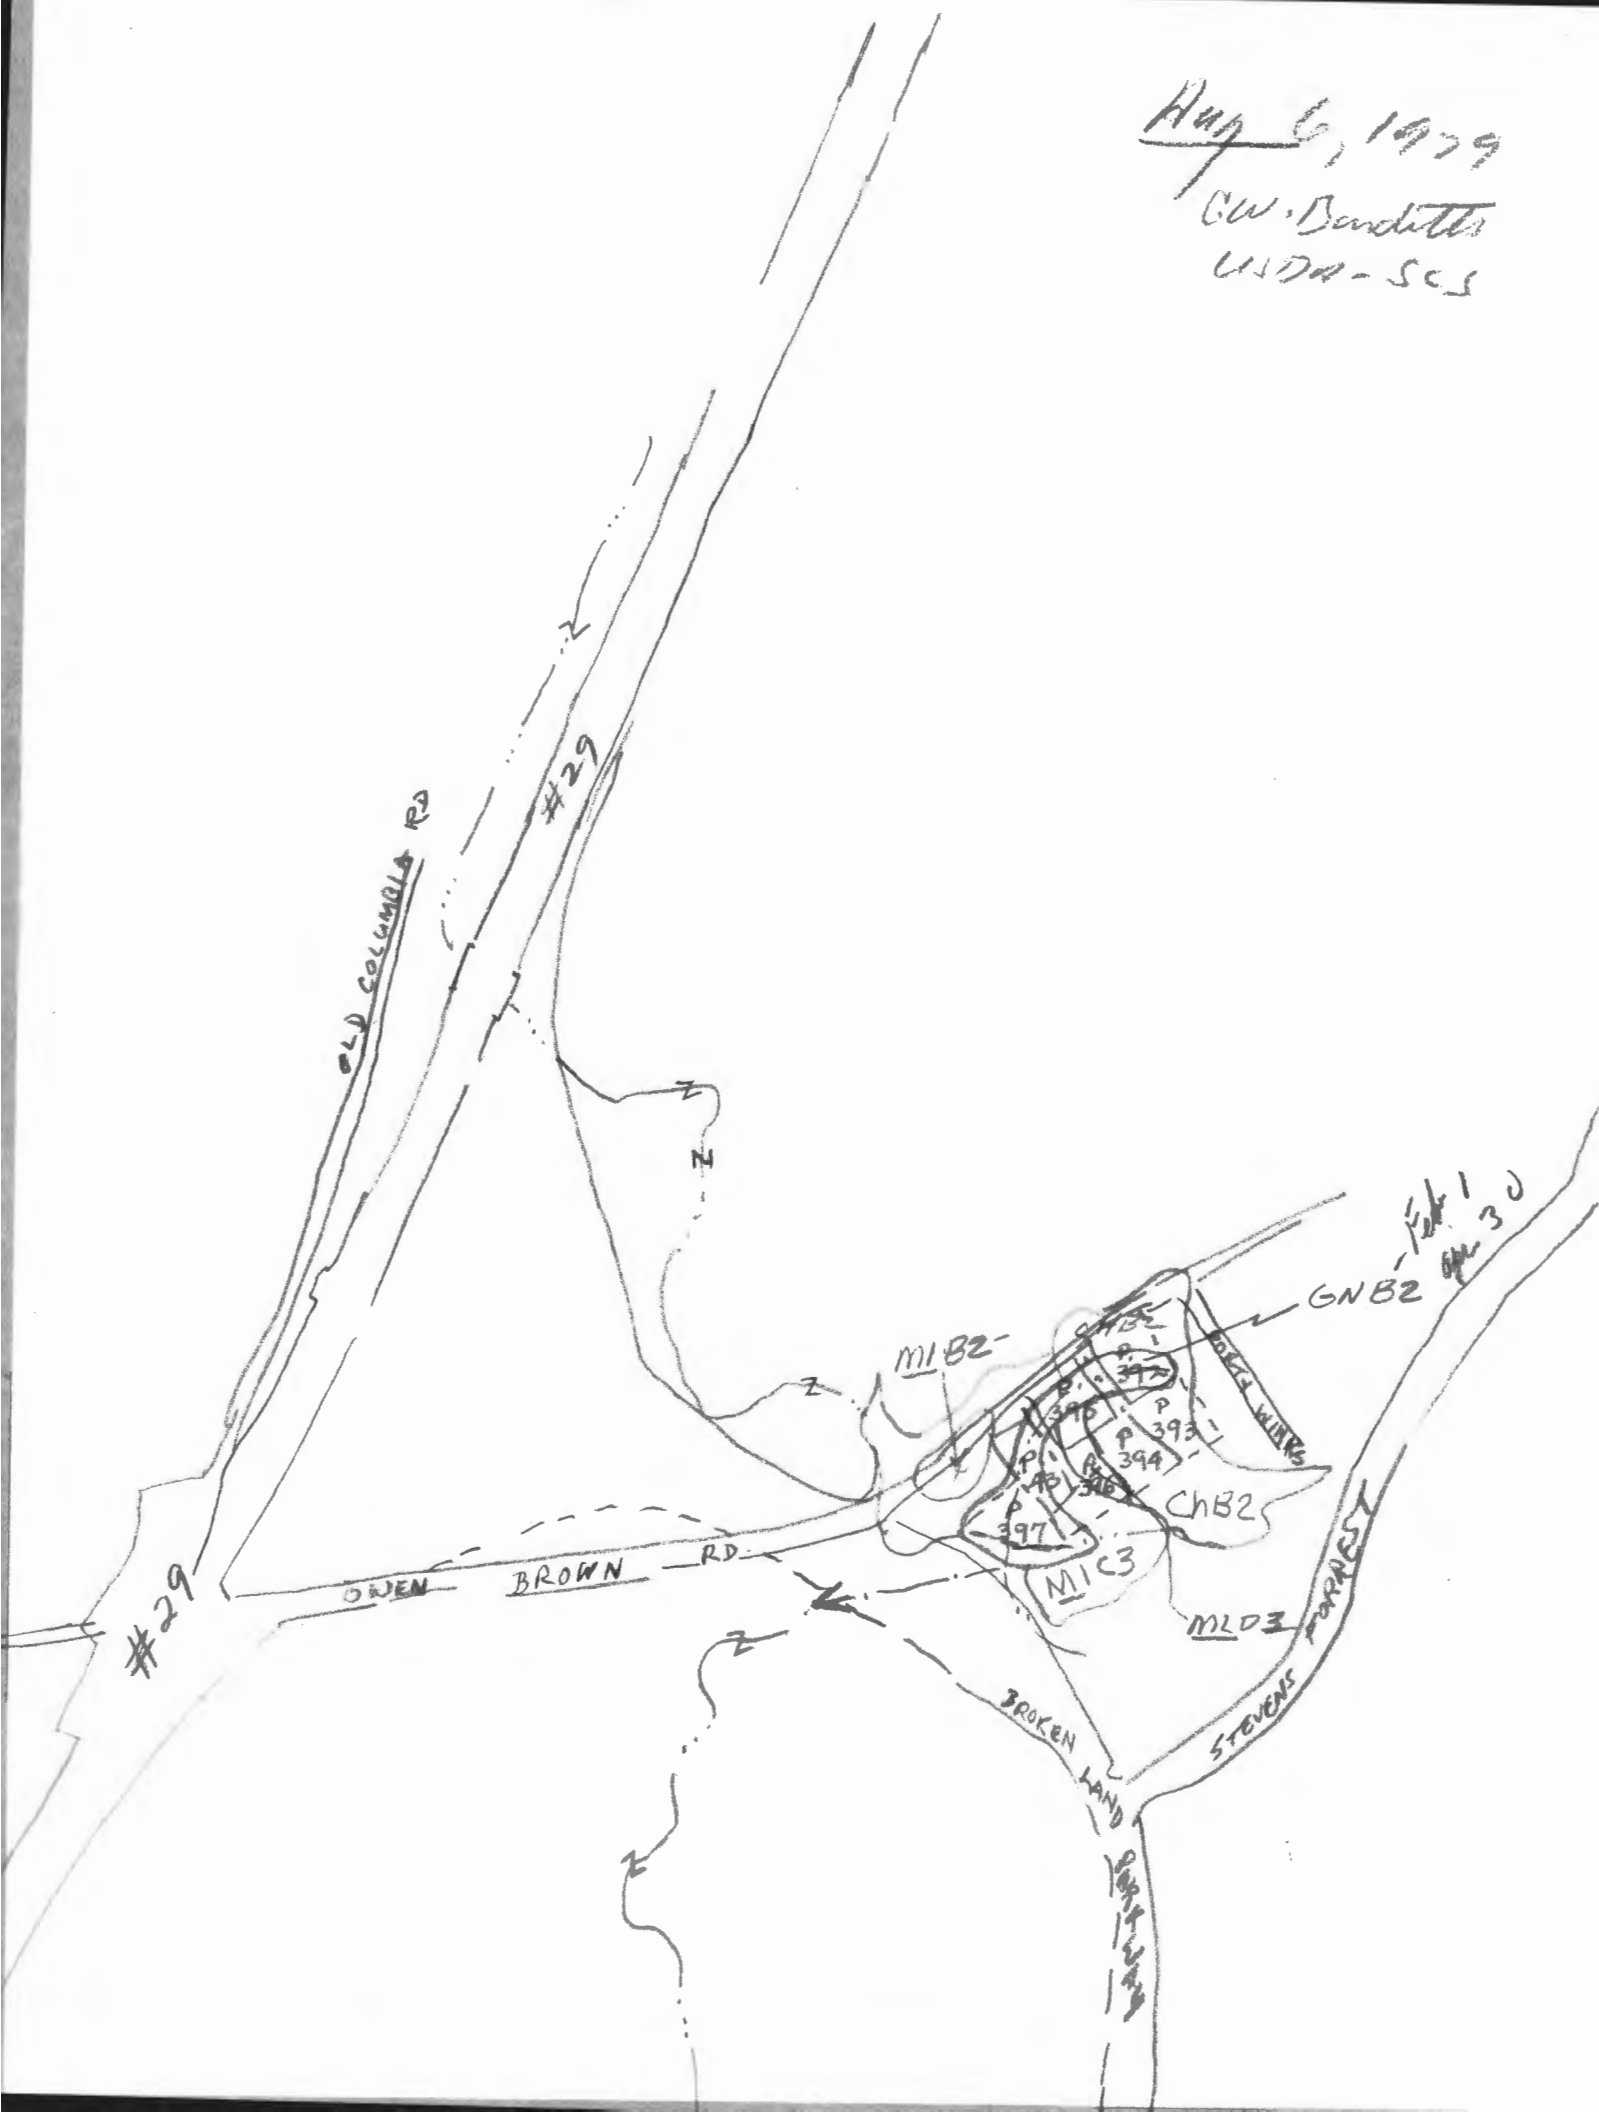

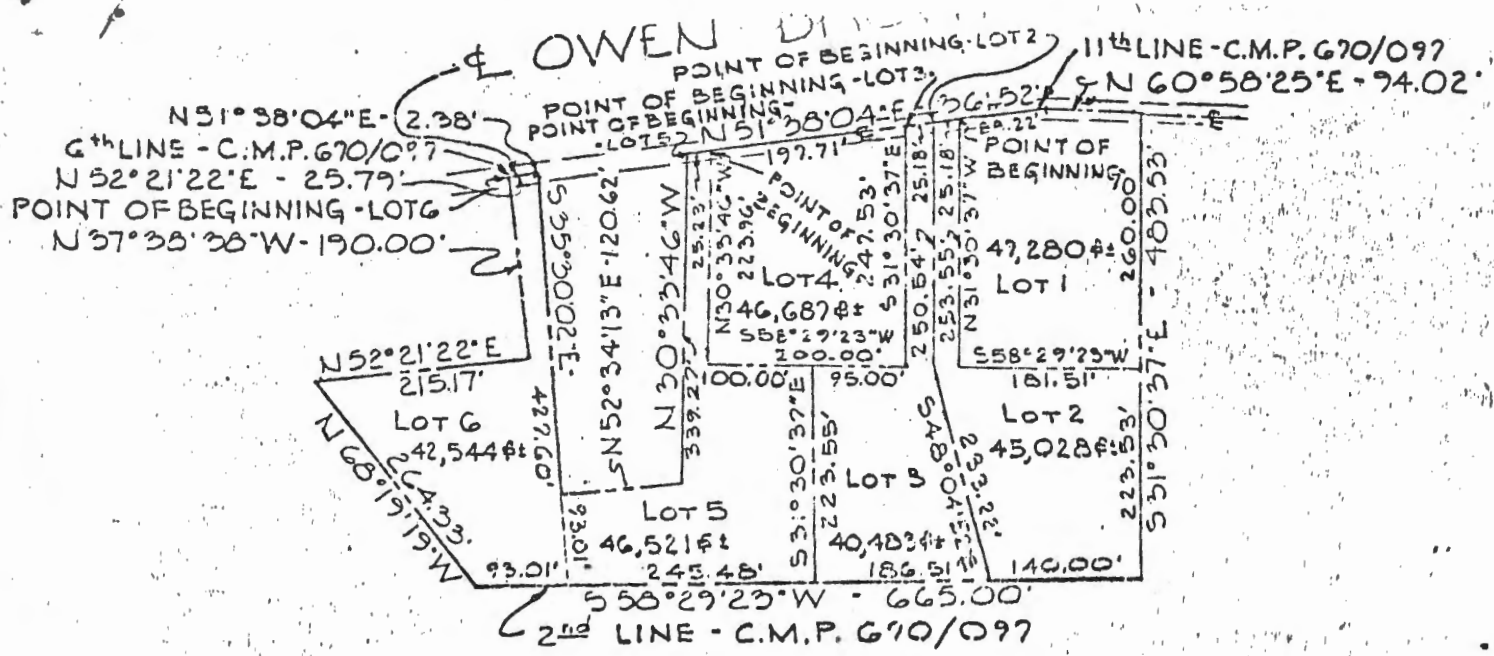

PROPERTY OF
 JUANITA B. MCINTOSH

6th ELECTION DISTRICT - HOWARD COUNTY, MD.
 APRIL 26, 1974
 SCALE: 1" = 200'

PURDUM & JESCHKE
 ENGINEERS & LAND SURVEYORS
 3697 PARK AVENUE
 ELLICOTT CITY, MARYLAND 21043

APPLICATION

SEWAGE DISPOSAL TESTING

STATE OF MARYLAND - DEPARTMENT OF HEALTH AND MENTAL HYGIENE

A 30090
P _____

HOWARD COUNTY HEALTH DEPARTMENT
ENVIRONMENTAL HEALTH SERVICES

P.O. BOX 476 ELLICOTT, MARYLAND 21043
TELEPHONE: 992-2330

DISTRICT 6th.

DATE 8/9/79

TO: THE COUNTY HEALTH OFFICER
ELLICOTT CITY, MARYLAND

I, HEREBY, APPLY FOR THE NECESSARY TEST IN ORDER TO CONSTRUCT (OR RECONSTRUCT) A SEWAGE DISPOSAL SYSTEM.

PROPERTY OWNER Peter Mc Intosh

ADDRESS 1290 Woodbine Road, Woodbine, Md. 21797 PHONE _____

PROPERTY LOCATION:

SUBDIVISION Juanita B. Mc Intosh Property LOT NO. Lot 5

ROAD AND DESCRIPTION Owen Brown Road

SIZE OF LOT 46,521 Sq. Ft. TYPE BLDG. 3 or 4 Bedrooms

THE SYSTEM INSTALLED UNDER THIS APPLICATION IS ACCEPTABLE ONLY UNTIL PUBLIC FACILITIES BECOME AVAILABLE.

I FULLY UNDERSTAND THE FEE CONNECTED WITH THE FILING OF THIS PERC TEST APPLICATION IS NON-REFUNDABLE UNDER

ANY CIRCUMSTANCES.

SIGNATURE OF APPLICANT /s/ Peter Mc Intosh

APPROVED BY _____ FOR _____ DATE _____





REJECTED BY Raymond Hodges FOR ALL DATE 10/24/79

HOLD PENDING FURTHER TESTS _____ DATE _____

REASONS FOR REJECTION OR HOLDING 10/24/79 - UNDER GROUND WATER

A

THIS IS NOT A PERMIT

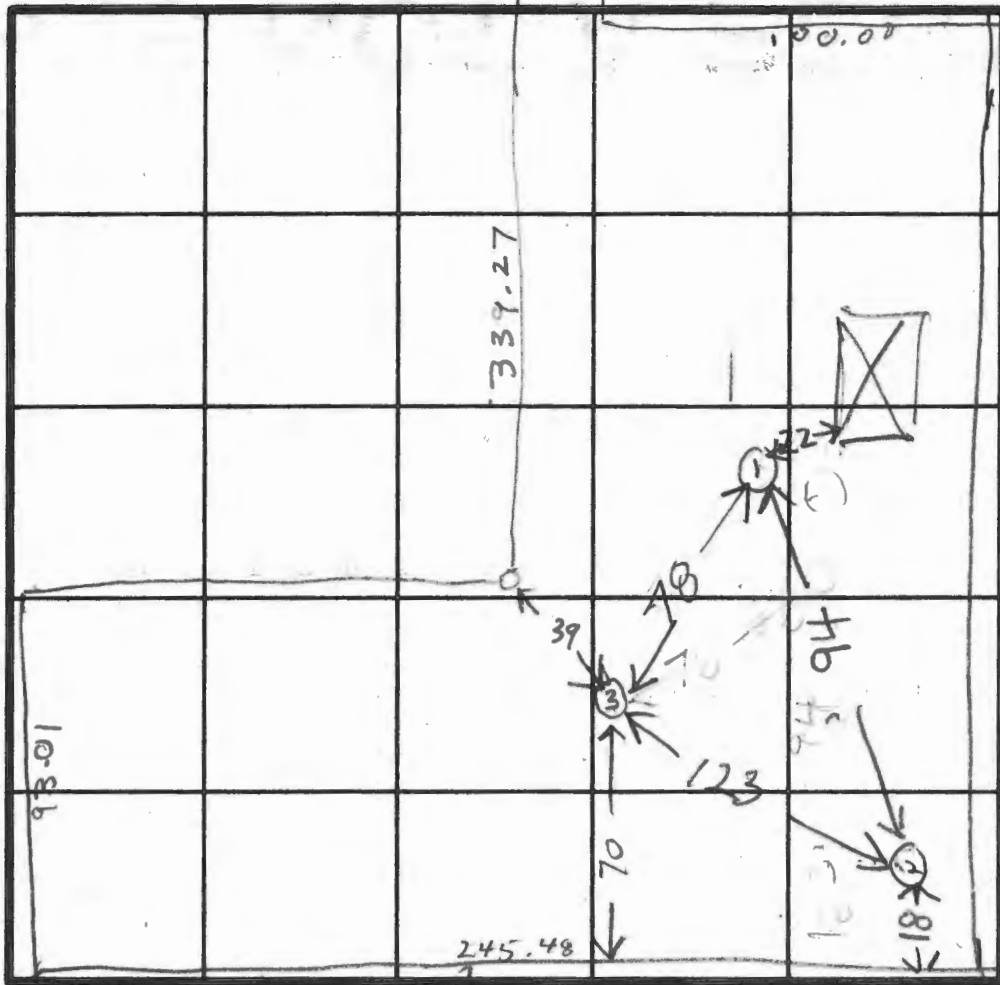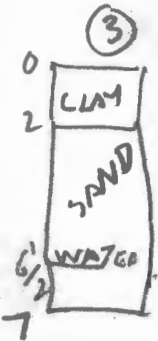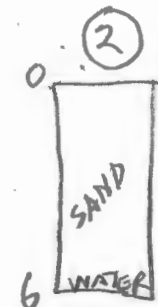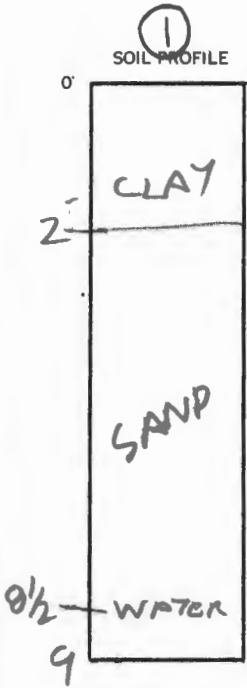

HOLE
ELEVATION
① = HIGH
② = HIGH
③ = LOW

INDICATE NORTH - NAME ADJOINING ROADWAY AS BASE LINE.

DATE	TEST NO.	DEPTH	PRE-WET		TEST - 1" DROP		TIME
			START	STOP	START	STOP	
10/24/79	1V	9	WATER		8 1/2 FT		
	2V	6	WATER		6 FT		
10/24/79	3V	7	WATER		6 1/2 FT		

REMARKS _____

TYPE OF SOIL _____

TESTED BY BH HSIRK ALSO PRESENT _____

39

78

APPLICATION

SEWAGE DISPOSAL TESTING

STATE OF MARYLAND - DEPARTMENT OF HEALTH AND MENTAL HYGIENE

A 30086

P _____

HOWARD COUNTY HEALTH DEPARTMENT
ENVIRONMENTAL HEALTH SERVICES
P.O. BOX 476 ELLICOTT, MARYLAND 21043
TELEPHONE: 992-2330

DISTRICT 6th.

DATE 8/9/79

TO: THE COUNTY HEALTH OFFICER
ELLICOTT CITY, MARYLAND

I, HEREBY, APPLY FOR THE NECESSARY TEST IN ORDER TO CONSTRUCT (OR RECONSTRUCT) A SEWAGE DISPOSAL SYSTEM.

PROPERTY OWNER Peter Mc Intosh

ADDRESS 1290 Woodbine Road, Woodbine, Md. 21797 PHONE 442-2773-Work
442-2035-Home.

PROPERTY LOCATION:

SUBDIVISION Juanita B. McIntosh Property LOT NO. Lot 1

ROAD AND DESCRIPTION Owen Brown Road Rt 29 South to Owen Brown Rd Left

Past Broken Land Parkway to Right between 2 large Hemlock
Trees on Right Last Drive before Forty Winds
SIZE OF LOT 47,280 sq. feet TYPE BLDG. 3 or 4 Bedrooms

THE SYSTEM INSTALLED UNDER THIS APPLICATION IS ACCEPTABLE ONLY UNTIL PUBLIC FACILITIES BECOME AVAILABLE.

I FULLY UNDERSTAND THE FEE CONNECTED WITH THE FILING OF THIS PERC TEST APPLICATION IS NON-REFUNDABLE UNDER ANY CIRCUMSTANCES.

SIGNATURE OF APPLICANT /s/ Peter J. McIntosh

APPROVED BY _____ FOR _____ DATE _____

REJECTED BY _____ FOR _____ DATE _____

HOLD PENDING FURTHER TESTS _____ DATE _____

REASONS FOR REJECTION OR HOLDING _____

THIS IS NOT A PERMIT

*Rec'd
Aug 23 or 24th
9:30 A.M.*

SOIL PROFILE

0'

Vertical rectangular box for soil profile drawing.

Large grid for soil profile data, consisting of 5 columns and 5 rows.

INDICATE NORTH - NAME ADJOINING ROADWAY AS BASE LINE.

Table with 8 columns: DATE, TEST NO., DEPTH, PRE-WET (START, STOP), TEST - 1" DROP (START, STOP), TIME. It contains 12 empty rows for data entry.

REMARKS _____

TYPE OF SOIL _____

TESTED BY _____ ALSO PRESENT _____

APPLICATION

SEWAGE DISPOSAL TESTING

STATE OF MARYLAND - DEPARTMENT OF HEALTH AND MENTAL HYGIENE

A 30086

P _____

HOWARD COUNTY HEALTH DEPARTMENT
ENVIRONMENTAL HEALTH SERVICES
P.O. BOX 476 ELLICOTT, MARYLAND 21043
TELEPHONE: 992-2330

DISTRICT 6th.

DATE 8/9/79

TO: THE COUNTY HEALTH OFFICER
ELLICOTT CITY, MARYLAND

I, HEREBY, APPLY FOR THE NECESSARY TEST IN ORDER TO CONSTRUCT (OR RECONSTRUCT) A SEWAGE DISPOSAL SYSTEM.

PROPERTY OWNER Peter Mc Intosh

ADDRESS 1290 Woodbine Road, Woodbine, Md. 21797 PHONE _____

PROPERTY LOCATION:

SUBDIVISION Juanita B. McIntosh Property LOT NO. Lot 1

ROAD AND DESCRIPTION Owen Brown Road

SIZE OF LOT 47,280 sq. feet TYPE BLDG. 3 or 4 Bedrooms

THE SYSTEM INSTALLED UNDER THIS APPLICATION IS ACCEPTABLE ONLY UNTIL PUBLIC FACILITIES BECOME AVAILABLE.

I FULLY UNDERSTAND THE FEE CONNECTED WITH THE FILING OF THIS PERC TEST APPLICATION IS NON-REFUNDABLE UNDER

ANY CIRCUMSTANCES.

SIGNATURE OF APPLICANT /s/ Peter J. McIntosh

APPROVED BY _____ FOR _____ DATE _____


REJECTED BY _____ FOR _____ DATE _____

HOLD PENDING FURTHER TESTS _____ DATE _____

REASONS FOR REJECTION OR HOLDING _____

THIS IS NOT A PERMIT

SOIL PROFILE

0' 

INDICATE NORTH - NAME ADJOINING ROADWAY AS BASE LINE.

DATE	TEST NO.	DEPTH	PRE-WET		TEST - 1" DROP		TIME
			START	STOP	START	STOP	

REMARKS _____

TYPE OF SOIL _____

TESTED BY _____ ALSO PRESENT _____

*Paul
Aug. 23 12:24 P.M.
9:30 A.M.*

APPLICATION

SEWAGE DISPOSAL TESTING

STATE OF MARYLAND - DEPARTMENT OF HEALTH AND MENTAL HYGIENE

A 30087
P _____

HOWARD COUNTY HEALTH DEPARTMENT
ENVIRONMENTAL HEALTH SERVICES
P.O. BOX 476 ELLICOTT, MARYLAND 21043
TELEPHONE: 992-2330

DISTRICT 6th.
DATE 8/9/79

TO: THE COUNTY HEALTH OFFICER
ELLICOTT CITY, MARYLAND

I, HEREBY, APPLY FOR THE NECESSARY TEST IN ORDER TO CONSTRUCT (OR RECONSTRUCT) A SEWAGE DISPOSAL SYSTEM.

PROPERTY OWNER Peter Mc Intosh
ADDRESS 1290 Woodbine, Road, Woodbine, Md. 21797 PHONE _____

PROPERTY LOCATION:

SUBDIVISION Juanita B. Mc Intosh Property LOT NO. Lot 2
ROAD AND DESCRIPTION Owen Brown Road

SIZE OF LOT 45,028 sq ft. TYPE BLDG. 3 or 4 Bedrooms

THE SYSTEM INSTALLED UNDER THIS APPLICATION IS ACCEPTABLE ONLY UNTIL PUBLIC FACILITIES BECOME AVAILABLE.

I FULLY UNDERSTAND THE FEE CONNECTED WITH THE FILING OF THIS PERC TEST APPLICATION IS NON-REFUNDABLE UNDER

ANY CIRCUMSTANCES.

SIGNATURE OF APPLICANT /s/ Peter Mc Intosh

APPROVED BY _____ FOR _____ DATE _____

REJECTED BY _____ FOR _____ DATE _____

HOLD PENDING FURTHER TESTS _____ DATE _____

REASONS FOR REJECTION OR HOLDING _____

THIS IS NOT A PERMIT

SOIL PROFILE

0'

INDICATE NORTH - NAME ADJOINING ROADWAY AS BASE LINE.

DATE	TEST NO.	DEPTH	PRE-WET		TEST - 1" DROP		TIME
			START	STOP	START	STOP	

REMARKS _____

TYPE OF SOIL _____

TESTED BY _____ ALSO PRESENT _____

APPLICATION

SEWAGE DISPOSAL TESTING

STATE OF MARYLAND - DEPARTMENT OF HEALTH AND MENTAL HYGIENE

A 30087
P _____

HOWARD COUNTY HEALTH DEPARTMENT
ENVIRONMENTAL HEALTH SERVICES
P.O. BOX 476 ELLICOTT, MARYLAND 21043
TELEPHONE: 992-2330

DISTRICT 6th

DATE 8/9/79

TO: THE COUNTY HEALTH OFFICER
ELLICOTT CITY, MARYLAND

I, HEREBY, APPLY FOR THE NECESSARY TEST IN ORDER TO CONSTRUCT (OR RECONSTRUCT) A SEWAGE DISPOSAL SYSTEM.

PROPERTY OWNER Peter Mc Intosh

ADDRESS 1290 Woodbine, Road, Woodbine, Md. 21797 PHONE _____

PROPERTY LOCATION:

SUBDIVISION Juanita B. Mc Intosh Property LOT NO. Lot 2

ROAD AND DESCRIPTION Owen Brown Road

SIZE OF LOT 45,028 sq ft. TYPE BLDG. 3 or 4 Bedrooms

THE SYSTEM INSTALLED UNDER THIS APPLICATION IS ACCEPTABLE ONLY UNTIL PUBLIC FACILITIES BECOME AVAILABLE.

I FULLY UNDERSTAND THE FEE CONNECTED WITH THE FILING OF THIS PERC TEST APPLICATION IS NON-REFUNDABLE UNDER

ANY CIRCUMSTANCES.

SIGNATURE OF APPLICANT /s/ Peter Mc Intosh

APPROVED BY _____ FOR _____ DATE _____

REJECTED BY _____ FOR _____ DATE _____

HOLD PENDING FURTHER TESTS _____ DATE _____

REASONS FOR REJECTION OR HOLDING _____

THIS IS NOT A PERMIT

Paul -
Aug. 23. 4:24 th
9:30 A.M.

APPLICATION

A 30188

SEWAGE DISPOSAL TESTING

STATE OF MARYLAND - DEPARTMENT OF HEALTH AND MENTAL HYGIENE

P _____

HOWARD COUNTY HEALTH DEPARTMENT
ENVIRONMENTAL HEALTH SERVICES

P.O. BOX 476 ELLICOTT, MARYLAND 21043
TELEPHONE: 992-2330

DISTRICT 6th.

DATE 8/9/79

TO: THE COUNTY HEALTH OFFICER
ELLICOTT CITY, MARYLAND

I, HEREBY, APPLY FOR THE NECESSARY TEST IN ORDER TO CONSTRUCT (OR RECONSTRUCT) A SEWAGE DISPOSAL SYSTEM.

PROPERTY OWNER Peter Mc Intosh

ADDRESS 1290 Woodbine Road, Woodbine, Md. 21797 PHONE _____

PROPERTY LOCATION:

SUBDIVISION Juanita B. Mc Intosh Property LOT NO. Lot 3

ROAD AND DESCRIPTION Owen Brown Road

SIZE OF LOT 40, 483 sq. Feet TYPE BLDG. 3 or 4 Bedrooms

THE SYSTEM INSTALLED UNDER THIS APPLICATION IS ACCEPTABLE ONLY UNTIL PUBLIC FACILITIES BECOME AVAILABLE.

I FULLY UNDERSTAND THE FEE CONNECTED WITH THE FILING OF THIS PERC TEST APPLICATION IS NON-REFUNDABLE UNDER

ANY CIRCUMSTANCES.

SIGNATURE OF APPLICANT /s/ Peter Mc Intosh

APPROVED BY _____ FOR _____ DATE _____

REJECTED BY _____ FOR _____ DATE _____

HOLD PENDING FURTHER TESTS _____ DATE _____

REASONS FOR REJECTION OR HOLDING _____

THIS IS NOT A PERMIT

SOIL PROFILE

0'

INDICATE NORTH - NAME ADJOINING ROADWAY AS BASE LINE.

DATE	TEST NO.	DEPTH	PRE-WET		TEST - 1" DROP		TIME
			START	STOP	START	STOP	

REMARKS _____

TYPE OF SOIL _____

TESTED BY _____ ALSO PRESENT _____

APPLICATION

SEWAGE DISPOSAL TESTING

STATE OF MARYLAND - DEPARTMENT OF HEALTH AND MENTAL HYGIENE

A 30088

P _____

HOWARD COUNTY HEALTH DEPARTMENT
ENVIRONMENTAL HEALTH SERVICES

P.O. BOX 476 ELLICOTT, MARYLAND 21043
TELEPHONE: 992-2330

DISTRICT 6th.

DATE 8/9/79

TO: THE COUNTY HEALTH OFFICER
ELLICOTT CITY, MARYLAND

I, HEREBY, APPLY FOR THE NECESSARY TEST IN ORDER TO CONSTRUCT (OR RECONSTRUCT) A SEWAGE DISPOSAL SYSTEM.

PROPERTY OWNER Peter Mc Intosh

ADDRESS 1290 Woodbine Road, Woodbine, Md. 21797 PHONE _____

PROPERTY LOCATION:

SUBDIVISION Juanita B. Mc Intosh Property LOT NO. Lot 3

ROAD AND DESCRIPTION Owen Brown Road

SIZE OF LOT 40, 483 sq. Feet TYPE BLDG. 3 or 4 Bedrooms

THE SYSTEM INSTALLED UNDER THIS APPLICATION IS ACCEPTABLE ONLY UNTIL PUBLIC FACILITIES BECOME AVAILABLE.

I FULLY UNDERSTAND THE FEE CONNECTED WITH THE FILING OF THIS PERC TEST APPLICATION IS NON-REFUNDABLE UNDER

ANY CIRCUMSTANCES.

SIGNATURE OF APPLICANT /s/ Peter Mc Intosh

APPROVED BY _____ FOR _____ DATE _____

REJECTED BY _____ FOR _____ DATE _____

HOLD PENDING FURTHER TESTS _____ DATE _____

REASONS FOR REJECTION OR HOLDING _____

THIS IS NOT A PERMIT

SOIL PROFILE

0'

INDICATE NORTH - NAME ADJOINING ROADWAY AS BASE LINE.

DATE	TEST NO.	DEPTH	PRE-WET		TEST - 1" DROP		TIME
			START	STOP	START	STOP	

REMARKS _____

TYPE OF SOIL _____

TESTED BY _____ ALSO PRESENT _____

Paul
Aug 13 + 14 ok
9:30 A.M.

APPLICATION

SEWAGE DISPOSAL TESTING

STATE OF MARYLAND - DEPARTMENT OF HEALTH AND MENTAL HYGIENE

A 30089

P _____

HOWARD COUNTY HEALTH DEPARTMENT
ENVIRONMENTAL HEALTH SERVICES
P.O. BOX 476 ELLICOTT, MARYLAND 21043
TELEPHONE: 992-2330

DISTRICT 6th.

DATE 8/9/79

TO: THE COUNTY HEALTH OFFICER
ELLICOTT CITY, MARYLAND

I, HEREBY, APPLY FOR THE NECESSARY TEST IN ORDER TO CONSTRUCT (OR RECONSTRUCT) A SEWAGE DISPOSAL SYSTEM.

PROPERTY OWNER Peter J. Mc Intosh

ADDRESS 1290 Woodbine Road, Woodbine, Md. 21797 PHONE _____

PROPERTY LOCATION:

SUBDIVISION Juanita B. Mcintosh property LOT NO. Lot 4

ROAD AND DESCRIPTION Owen Brown Road

SIZE OF LOT 46,687 sq. ft. TYPE BLDG. 3 or 4 Bedrooms

THE SYSTEM INSTALLED UNDER THIS APPLICATION IS ACCEPTABLE ONLY UNTIL PUBLIC FACILITIES BECOME AVAILABLE.

I FULLY UNDERSTAND THE FEE CONNECTED WITH THE FILING OF THIS PERC TEST APPLICATION IS NON-REFUNDABLE UNDER

ANY CIRCUMSTANCES.

SIGNATURE OF APPLICANT /s/ Peter J. Mc Intosh

APPROVED BY _____ FOR _____ DATE _____

REJECTED BY _____ FOR _____ DATE _____

HOLD PENDING FURTHER TESTS _____ DATE _____

REASONS FOR REJECTION OR HOLDING _____

THIS IS NOT A PERMIT

SOIL PROFILE

0'

Vertical rectangular box for soil profile drawing.

Large grid for soil profile data, consisting of 5 columns and 5 rows.

INDICATE NORTH - NAME ADJOINING ROADWAY AS BASE LINE.

DATE	TEST NO.	DEPTH	PRE-WET		TEST - 1" DROP		TIME
			START	STOP	START	STOP	

REMARKS _____

TYPE OF SOIL _____

TESTED BY _____ ALSO PRESENT _____

APPLICATION

SEWAGE DISPOSAL TESTING

STATE OF MARYLAND - DEPARTMENT OF HEALTH AND MENTAL HYGIENE

A 30089

P _____

HOWARD COUNTY HEALTH DEPARTMENT
ENVIRONMENTAL HEALTH SERVICES

P.O. BOX 476 ELLICOTT, MARYLAND 21043
TELEPHONE: 992-2330

DISTRICT 6th.

DATE 8/9/79

TO: THE COUNTY HEALTH OFFICER
ELLICOTT CITY, MARYLAND

I, HEREBY, APPLY FOR THE NECESSARY TEST IN ORDER TO CONSTRUCT (OR RECONSTRUCT) A SEWAGE DISPOSAL SYSTEM.

PROPERTY OWNER Peter J. Mc Intosh

ADDRESS 1290 Woodbine, Road, Woodbine, Md. 21797 PHONE _____

PROPERTY LOCATION:

SUBDIVISION Juanita B. McIntosh property LOT NO. Lot 4

ROAD AND DESCRIPTION Owen Brown Road

SIZE OF LOT 46,687 sq. ft. TYPE BLDG. 3 or 4 Bedrooms

THE SYSTEM INSTALLED UNDER THIS APPLICATION IS ACCEPTABLE ONLY UNTIL PUBLIC FACILITIES BECOME AVAILABLE.

I FULLY UNDERSTAND THE FEE CONNECTED WITH THE FILING OF THIS PERC TEST APPLICATION IS NON-REFUNDABLE UNDER ANY CIRCUMSTANCES.

SIGNATURE OF APPLICANT /s/ Peter J. Mc Intosh

APPROVED BY _____ FOR _____ DATE _____

REJECTED BY _____ FOR _____ DATE _____

HOLD PENDING FURTHER TESTS _____ DATE _____

REASONS FOR REJECTION OR HOLDING _____

THIS IS NOT A PERMIT

*Phil
Aug. 23rd 9:30 A.M.*

APPLICATION

SEWAGE DISPOSAL TESTING

A 30091

STATE OF MARYLAND - DEPARTMENT OF HEALTH AND MENTAL HYGIENE

P _____

HOWARD COUNTY HEALTH DEPARTMENT
ENVIRONMENTAL HEALTH SERVICES
P.O. BOX 476 ELLICOTT, MARYLAND 21043
TELEPHONE: 992-2330

DISTRICT 6th.

DATE 8/9/79

TO: THE COUNTY HEALTH OFFICER
ELLICOTT CITY, MARYLAND

I, HEREBY, APPLY FOR THE NECESSARY TEST IN ORDER TO CONSTRUCT (OR RECONSTRUCT) A SEWAGE DISPOSAL SYSTEM.

PROPERTY OWNER Peter Mc Intosh

ADDRESS 1290 Woodbine Road, Woodbine, Md. 21797 PHONE _____

PROPERTY LOCATION:

SUBDIVISION Juanita B. Mc Intosh Property LOT NO. Lot 6

ROAD AND DESCRIPTION Owen Brown Road

SIZE OF LOT 42,544 Sq. Ft. TYPE BLDG. 3 or 4 Bedrooms

THE SYSTEM INSTALLED UNDER THIS APPLICATION IS ACCEPTABLE ONLY UNTIL PUBLIC FACILITIES BECOME AVAILABLE.

I FULLY UNDERSTAND THE FEE CONNECTED WITH THE FILING OF THIS PERC TEST APPLICATION IS NON-REFUNDABLE UNDER

ANY CIRCUMSTANCES.

SIGNATURE OF APPLICANT /s/ Peter Mc Intosh

APPROVED BY _____ FOR _____ DATE _____

REJECTED BY _____ FOR _____ DATE _____

HOLD PENDING FURTHER TESTS _____ DATE _____

REASONS FOR REJECTION OR HOLDING _____

THIS IS NOT A PERMIT

APPLICATION

SEWAGE DISPOSAL TESTING

A 31191

STATE OF MARYLAND - DEPARTMENT OF HEALTH AND MENTAL HYGIENE

P _____

HOWARD COUNTY HEALTH DEPARTMENT
ENVIRONMENTAL HEALTH SERVICES

P.O. BOX 476 ELLICOTT, MARYLAND 21043
TELEPHONE: 992-2330

DISTRICT 6th.

DATE 8/9/79

TO: THE COUNTY HEALTH OFFICER
ELLICOTT CITY, MARYLAND

I, HEREBY, APPLY FOR THE NECESSARY TEST IN ORDER TO CONSTRUCT (OR RECONSTRUCT) A SEWAGE DISPOSAL SYSTEM.

PROPERTY OWNER Peter Mc Intosh

ADDRESS 1290 Woodbine Road, Woodbine, Md. 21797 PHONE _____

PROPERTY LOCATION:

SUBDIVISION Juanita B. Mc Intosh Property LOT NO. Lot 6

ROAD AND DESCRIPTION Owen Brown Road

SIZE OF LOT 42,544 Sq. Ft. TYPE BLDG. 3 or 4 Bedrooms

THE SYSTEM INSTALLED UNDER THIS APPLICATION IS ACCEPTABLE ONLY UNTIL PUBLIC FACILITIES BECOME AVAILABLE.

I FULLY UNDERSTAND THE FEE CONNECTED WITH THE FILING OF THIS PERC TEST APPLICATION IS NON-REFUNDABLE UNDER

ANY CIRCUMSTANCES.

SIGNATURE OF APPLICANT /s/ Peter Mc Intosh

APPROVED BY _____ FOR _____ DATE _____

REJECTED BY _____ FOR _____ DATE _____

HOLD PENDING FURTHER TESTS _____ DATE _____

REASONS FOR REJECTION OR HOLDING _____

THIS IS NOT A PERMIT

SOIL PROFILE

0'

INDICATE NORTH - NAME ADJOINING ROADWAY AS BASE LINE.

DATE	TEST NO.	DEPTH	PRE-WET		TEST - 1" DROP		TIME
			START	STOP	START	STOP	

REMARKS _____

TYPE OF SOIL _____

TESTED BY _____ ALSO PRESENT _____