

#9265 } all on this parcel
 #9267 }
 #9269 }
 RB 8/16/19

[View Map](#) [View GroundRent Redemption](#) [View GroundRent Registration](#)

Tax Exempt: **Special Tax Recapture:**
Exempt Class: NONE
Account Identifier: **District - 06 Account Number - 413803**

Owner Information

Owner Name: BURKE AMBER **Use:** RESIDENTIAL
 BEACH KRISTEN **Principal Residence:** NO
Mailing Address: 5249 RISING SUN LN **Deed Reference:** /14523/ 00195
 ELLICOTT CITY MD 20143-

Location & Structure Information

Premises Address: 9269 ALL SAINTS RD **Legal Description:** 2.220 A
 LAUREL 20723-0000 9269 ALL SAINTS RD
 LAUREL

| Map: | Grid: | Parcel: | Sub District: | Subdivision: | Section: | Block: | Lot: | Assessment Year: | Plat No: |
|------|-------|---------|---------------|--------------|----------|--------|------|------------------|-----------|
| 0047 | 0021 | 0554 | | 2002 | | | | 2020 | Plat Ref: |

Special Tax Areas: **Town:** NONE
Ad Valorem: 104
Tax Class:

| Primary Structure Built | Above Grade Living Area | Finished Basement Area | Property Land Area | County Use |
|-------------------------|-------------------------|------------------------|--------------------|------------|
| 1973 | 2,424 SF | | 2.2200 AC | |

| Stories | Basement | Type | Exterior | Full/Half Bath | Garage | Last Major Renovation |
|---------|----------|---------------|----------|----------------|--------|-----------------------|
| 1 | YES | STANDARD UNIT | SIDING | 3 full | | |

Value Information

| | Base Value | Value As of 01/01/2017 | Phase-in Assessments As of 07/01/2019 | As of 07/01/2020 |
|---------------------------|------------|------------------------------|---|---------------------|
| Land: | 259,500 | 259,500 | | |
| Improvements | 177,500 | 177,500 | | |
| Total: | 437,000 | 437,000 | 437,000 | |
| Preferential Land: | 0 | | | |

Transfer Information

| | | |
|--|-----------------------------|-------------------|
| Seller: MCALLISTER MARGARET A | Date: 12/13/2012 | Price: \$0 |
| Type: NON-ARMS LENGTH OTHER | Deed1: /14523/ 00195 | Deed2: |
| Seller: MCALLISTER EDGAR A & WF | Date: 07/20/1987 | Price: \$0 |
| Type: NON-ARMS LENGTH OTHER | Deed1: /01690/ 00137 | Deed2: |
| Seller: | Date: | Price: |
| Type: | Deed1: | Deed2: |

Exemption Information

| Partial Exempt Assessments: | Class | 07/01/2019 | 07/01/2020 |
|-----------------------------|-------|------------|------------|
| County: | 000 | 0.00 | |
| State: | 000 | 0.00 | |
| Municipal: | 000 | 0.00 | 0.00 |

Tax Exempt: **Special Tax Recapture:**
Exempt Class: NONE

Homestead Application Information

Homestead Application Status: Denied

Homeowners' Tax Credit Application Information

1. This screen allows you to search the Real Property database and display property records.
2. Click **here** for a glossary of terms.
3. Deleted accounts can only be selected by Property Account Identifier.
4. The following pages are for information purpose only. The data is not to be used for legal reports or documents. While we have confidence in the accuracy of these records, the Department makes no warranties, expressed or implied, regarding the information.

RECORDED

APPLICATION

SEWAGE DISPOSAL TESTING

A _____

STATE OF MARYLAND - DEPARTMENT OF HEALTH AND MENTAL HYGIENE

P _____

HOWARD COUNTY HEALTH DEPARTMENT
ENVIRONMENTAL HEALTH SERVICES
P.O. BOX 476 ELLICOTT, MARYLAND 21043
TELEPHONE: 992-2330

DISTRICT 6th

DATE 6/5/79

TO: THE COUNTY HEALTH OFFICER
ELLICOTT CITY, MARYLAND

I, HEREBY, APPLY FOR THE NECESSARY TEST IN ORDER TO CONSTRUCT (OR RECONSTRUCT) A SEWAGE DISPOSAL SYSTEM.

PROPERTY OWNER Charles L. Mills, Jr. & Charlotte M. Mills

ADDRESS 9267 All Saints Road, Lanwel, Md. PHONE 498-1832

PROPERTY LOCATION:

SUBDIVISION _____ LOT NO. _____

ROAD AND DESCRIPTION Old Scaggsville Road (Route 216) - Route 29, turn left on Old Scaggsville Road - right on All Saints Road and right onto Old Route 216

SIZE OF LOT 45 ft. wide x 218 deep TYPE BLDG. 3 bedrooms

THE SYSTEM INSTALLED UNDER THIS APPLICATION IS ACCEPTABLE ONLY UNTIL PUBLIC FACILITIES BECOME AVAILABLE.

I FULLY UNDERSTAND THE FEE CONNECTED WITH THE FILING OF THIS PERC TEST APPLICATION IS NON-REFUNDABLE UNDER

ANY CIRCUMSTANCES.

SIGNATURE OF APPLICANT Charlotte M. Mills



APPROVED BY _____ FOR _____ DATE _____

REJECTED BY Raymond J. Fryer FOR All Systems DATE 6/15/79

HOLD PENDING FURTHER TESTS _____ DATE _____

REASONS FOR REJECTION OR HOLDING 6/15/79 Underground Water & Slow Percolation

THIS IS NOT A PERMIT

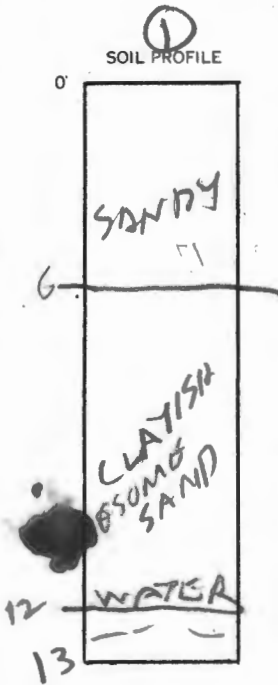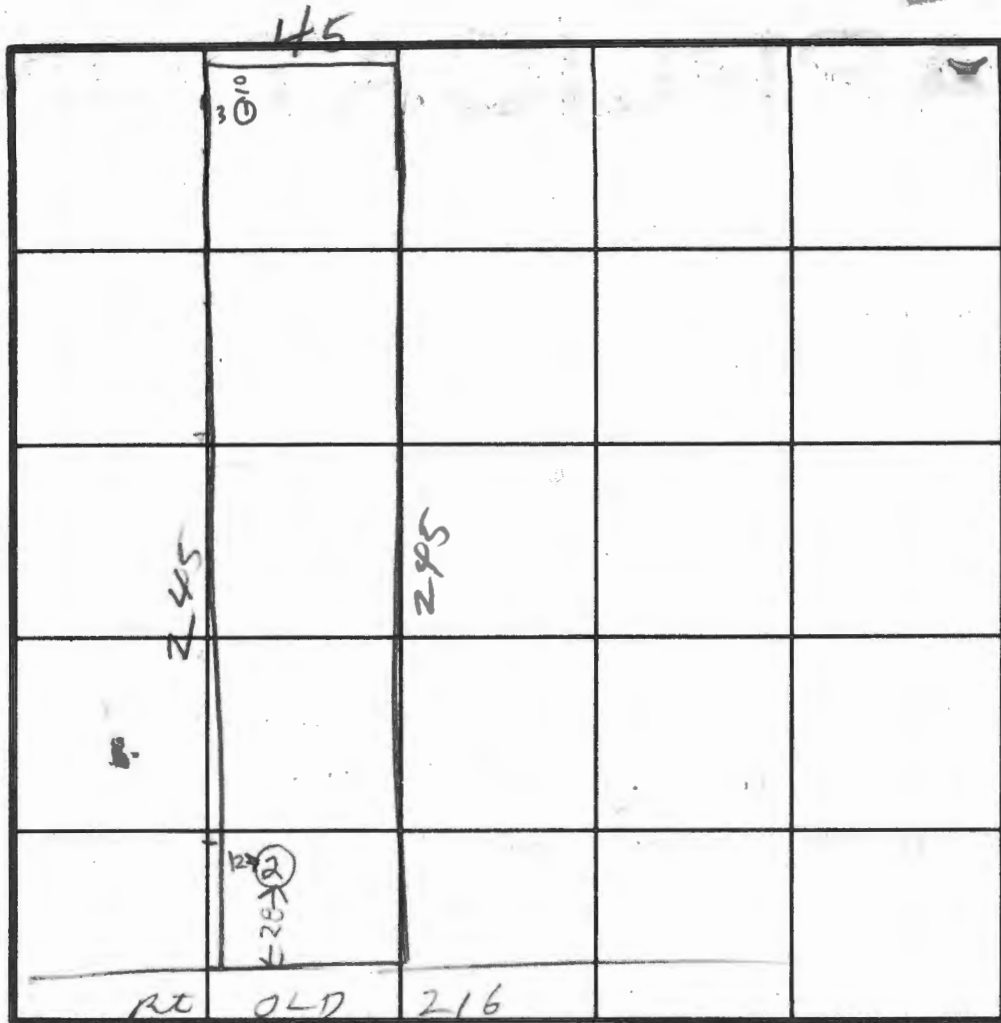

INDICATE NORTH - NAME ADJOINING ROADWAY AS BASE LINE.

| DATE | TEST NO. | DEPTH | PRE-WET | | TEST - 1" DROP | | TIME | |
|---------|----------|-------|-------------------------------|------|----------------|------|------|--|
| | | | START | STOP | START | STOP | | |
| 6/15/79 | IS | 3 | 1002 | 1033 | Water 31 | FAIL | | |
| | IV | 13 | SEE SOIL PROFILE WATER 12 FT | | | | | |
| 6/15/79 | 2V | 10 | BACK HOE MAN SAID WATER 10 FT | | | | | |
| | | | | | | | | |
| | | | | | | | | |
REMARKS city water Copy Given to Sherry Mills

TYPE OF SOIL _____

TESTED BY B HODGES

ALSO PRESENT WAYNE SOUTER ^{BACKING}
DAUGHTER OF GUNNERS HERRT MILLS