

TCB  
9/23/2019

Search Result for HOWARD COUNTY

View Map		View GroundRent Redemption			View GroundRent Registration				
Tax Exempt: None		Special Tax Recapture: None							
Exempt Class: None									
Account Identifier:		District - 04 Account Number - 330676							
Owner Information									
Owner Name:	15936 FREDERICK RD LLC			Use:	COMMERCIAL				
Mailing Address:	15811 AE MULLINIX RD WOODBINE MD 21797-			Principal Residence:	NO				
				Deed Reference:	/18490/ 00001				
Location & Structure Information									
Premises Address:	15936 FREDERICK RD LISBON 21765-0000			Legal Description:	.25 ACRE 15936 FREDERICK RD RT 94				
Map:	Grid:	Parcel:	Neighborhood:	Subdivision:	Section:	Block:	Lot:	Assessment Year:	Plat No:
0007	0012	0239	20000.14	0000				2020	Plat Ref:
Special Tax Areas: None				Town:	None				
				Ad Valorem:	100				
				Tax Class:	None				
Primary Structure Built	Above Grade Living Area		Finished Basement Area		Property Land Area		County Use		
1919	1,800 SF				0.2500 AC				
Stories	Basement	Type	Exterior	Quality	Full/Half Bath	Garage	Last Notice of Major Improvements		
		OFFICE BUILDING	/	C3					
Value Information									
	Base Value		Value		Phase-in Assessments				
			As of		As of		As of		
			01/01/2017		07/01/2019		07/01/2020		
Land:	92,500		92,500						
Improvements	76,200		76,200						
Total:	168,700		168,700		168,700				
Preferential Land:	0								
Transfer Information									
Seller: OPO LLC			Date: 12/18/2018			Price: \$300,000			
Type: ARMS LENGTH IMPROVED			Deed1: /18490/ 00001			Deed2:			
Seller: JENKINS DAVID J			Date: 08/23/2012			Price: \$0			
Type: NON-ARMS LENGTH OTHER			Deed1: /14235/ 00319			Deed2:			
Seller: WARNER FRANK L AND WF			Date: 08/29/1984			Price: \$75,000			
Type: ARMS LENGTH IMPROVED			Deed1: /01279/ 00242			Deed2:			
Exemption Information									
Partial Exempt Assessments:	Class		07/01/2019		07/01/2020				
County:	000		0.00						
State:	000		0.00						
Municipal:	000		0.00		0.00		0.00		
Tax Exempt: None		Special Tax Recapture: None							
Exempt Class: None									
Homestead Application Information									
Homestead Application Status: No Application									

**Homeowners' Tax Credit Application Status:** No Application

**Date:**

---

1. This screen allows you to search the Real Property database and display property records.
2. Click **here** for a glossary of terms.
3. Deleted accounts can only be selected by Property Account Identifier.
4. The following pages are for information purpose only. The data is not to be used for legal reports or documents. While we have confidence in the accuracy of these records, the Department makes no warranties, expressed or implied, regarding the information.

4/19/77  
9:30 A.M.  
no show  
8/17/77  
9:30 A.M.

# APPLICATION

A 29917.

P \_\_\_\_\_

SEWAGE DISPOSAL TESTING

STATE OF MARYLAND - DEPARTMENT OF HEALTH AND MENTAL HYGIENE

DISTRICT 4th

DATE 4/19/77

HOWARD COUNTY HEALTH DEPARTMENT  
ENVIRONMENTAL HEALTH SERVICES

P. O. BOX 476, ELLICOTT CITY, MARYLAND 21043  
TELEPHONE: 465-5000, EXT. 356

TO: THE COUNTY HEALTH OFFICER  
ELLICOTT CITY, MARYLAND

I, HEREBY, APPLY FOR THE NECESSARY TEST IN ORDER TO CONSTRUCT (OR RECONSTRUCT) A SEWAGE DISPOSAL SYSTEM.

PROPERTY OWNER Church of the Open Bible pastor: Hoke Rosensteel

ADDRESS Route 144, Lisbon, Maryland Will Hopkins PHONE \_\_\_\_\_

PROPERTY LOCATION: (Test ok)

SUBDIVISION \_\_\_\_\_ LOT NO. \_\_\_\_\_

ROAD AND DESCRIPTION Route 144 - 1/2 block west of Lisbon Elementary School on north side of road

SIZE OF LOT ? TYPE BLDG. ? NUMBER OF BEDROOMS \_\_\_\_\_

IF NOT SINGLE RESIDENCE DESCRIBE \_\_\_\_\_

THE SYSTEM INSTALLED UNDER THIS APPLICATION IS ACCEPTABLE ONLY UNTIL PUBLIC FACILITIES BECOME AVAILABLE.

SIGNATURE OF APPLICANT \_\_\_\_\_


APPROVED BY \_\_\_\_\_ FOR \_\_\_\_\_ DATE \_\_\_\_\_  
(KIND OF SYSTEM)

REJECTED BY \_\_\_\_\_ FOR \_\_\_\_\_ DATE \_\_\_\_\_  
(KIND OF SYSTEM)

HOLD PENDING FURTHER TESTS \_\_\_\_\_ DATE \_\_\_\_\_

REASONS FOR REJECTION OR HOLDING Exity build + system C.B.D.

# THIS IS NOT A PERMIT

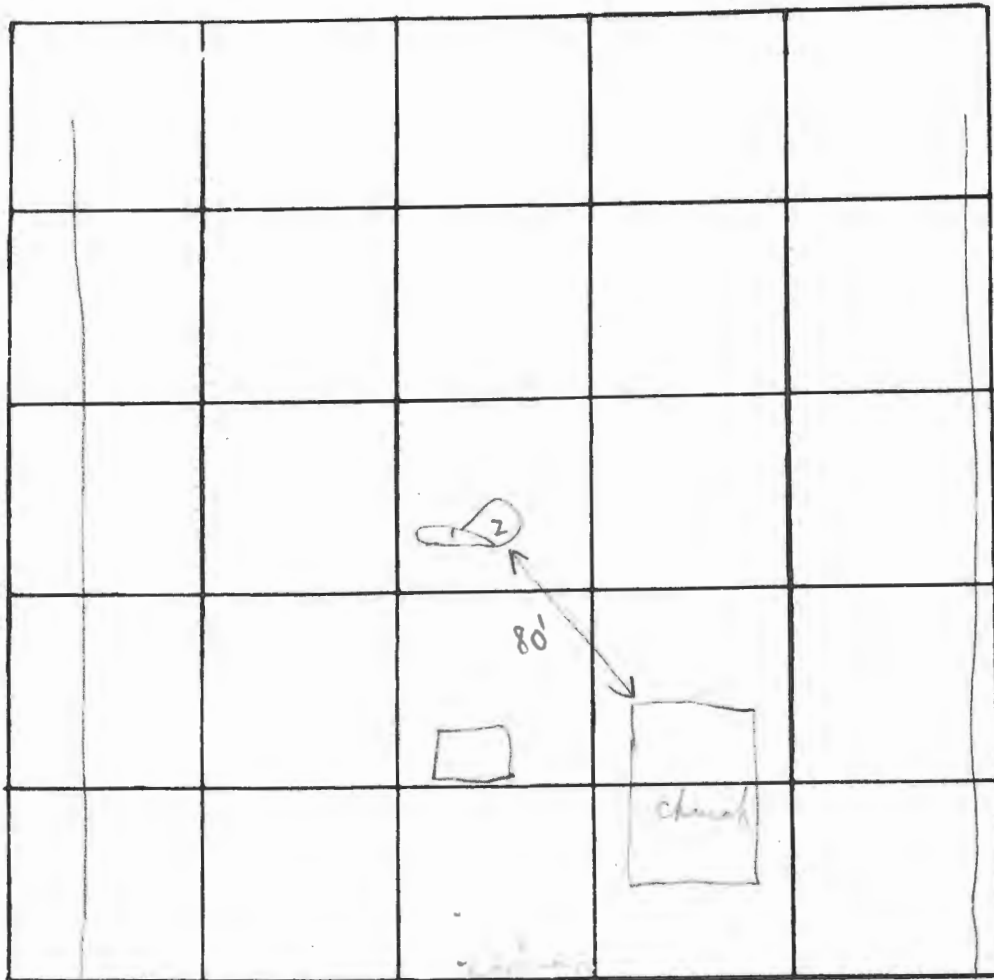

Poplar Springs

Da 2

INDICATE NORTH. - NAME ADJOINING ROADWAY AS BASE LINE

RD. 144

Soil Profile

DATE	TEST NO.	DEPTH	PRE-WET		TEST - 1" DROP		TIME
			START	STOP	START	STOP	
8/17/77	1	5'	10:02	10:04	10:04	10:08	4 min
	2	13'	10:03	10:05	10:05	10:09	4 min
	3/	/	/	/	/	/	
	4/	/	/	/	/	/	
	5/	/	/	/	/	/	
	6/	/	/	/	/	/	
	7/		Vertical		inches to		

Below clay

Reddish  
4 ft  
4 ft



(Hole per the Eng & Office)  
in both locations

REMARKS

Electric system spans tested under 1

TYPE OF SOIL

TESTED BY

C. B. J.

ALSO PRESENT:

W. Hopkins; H. Rosenthal