

C1 14343

SEQUENCE NO. (MDE USE ONLY)

STATE OF MARYLAND WELL COMPLETION REPORT

THIS REPORT MUST BE SUBMITTED WITHIN 45 DAYS AFTER WELL IS COMPLETED.

(THIS NUMBER IS TO BE PUNCHED IN COLS. 3-6 ON ALL CARDS)

COUNTY NUMBER AS14952 P

DATE RECEIVED MM DD YY 11 26 02

DATE WELL COMPLETED MM DD YY 11 26 02

DEPTH OF WELL 570 (TO NEAREST FOOT)

PERMIT NO. FROM "PERMIT TO DRILL WELL" OK SRK 12/1/02 HO-94-3580

OWNER GST TRUST & SISTERS TRUST STREET OR RFD ROAD C ELEANOR GARDEN WATOWN GLENWOOD SUBDIVISION WOODFORD FARMS SECTION LOT 44

WELL LOG table with columns for DESCRIPTION, FEET (FROM, TO), and check if water bearing. Includes entries for Brown Shale and Gray Granite.

GROUTING RECORD: WELL HAS BEEN GROUTED (Y), TYPE OF GROUTING MATERIAL (CM, BC), NO. OF BAGS (25), NO. OF POUNDS (2350), GALLONS OF WATER (150), DEPTH OF GROUT SEAL (85 ft).

CASING RECORD: MAIN CASING TYPE (ST), Nominal diameter (6 inch), Total depth (100 feet).

OTHER CASING (if used) diameter and depth.

SCREEN RECORD: screen type or open hole (ST, BR, HO, PL, OT).


DEPTH (nearest ft.) table with rows for casing and screen diameters.

GRAVEL PACK IF WELL DRILLED WAS FLOWING WELL INSERT F IN BOX 66

MDE USE ONLY (NOT TO BE FILLED IN BY DRILLER) T (E.R.O.S.) W Q

PUMPING TEST: HOURS PUMPED (6), PUMPING RATE (1.3 gal. per min.), METHOD USED TO MEASURE PUMPING RATE (Bucket), WATER LEVEL (79 ft. before, 351 ft. when pumping), TYPE OF PUMP USED (S submersible).

PUMP INSTALLED: DRILLER INSTALLED PUMP (YES), TYPE OF PUMP INSTALLED PLACE (S), CAPACITY: GALLONS PER MINUTE (31), PUMP HORSE POWER (37), PUMP COLUMN LENGTH (43), CASING HEIGHT (above).

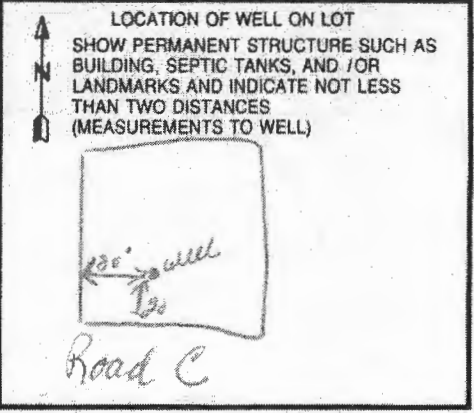

NUMBER OF UNSUCCESSFUL WELLS: 0, WELL HYDROFRACTURED (Y), CIRCLE APPROPRIATE LETTER (A, E, P).

DRILLERS LIC. NO. M 5 DO 24, DRILLERS SIGNATURE (John T. Mayne), LIC. NO. D, SITE SUPERVISOR responsible for sitework if different from permittee.