

# APPLICATION

## FOR PERCOLATION TESTING AND SITE EVALUATION

TEST DATE(S) \_\_\_\_\_ TEST TIME \_\_\_\_\_ A/P \_\_\_\_\_

AGENCY REVIEW: \_\_\_\_\_ DATE \_\_\_\_\_

DO NOT WRITE ABOVE THIS LINE

I HEREBY APPLY FOR THE NECESSARY TESTING/EVALUATION PRIOR TO ISSUANCE OF SEWAGE DISPOSAL SYSTEM PERMIT(S) TO:

CHECK AS NEEDED:

- CONSTRUCT NEW SEPTIC SYSTEM(S)
- REPAIR/ADD TO AN EXISTING SEPTIC SYSTEM
- REPLACE AN EXISTING SEPTIC SYSTEM

CHECK AS NEEDED:

- NEW STRUCTURE(S)
- ADDITION TO AN EXISTING STRUCTURE
- REPLACE AN EXISTING STRUCTURE

CHECK ONE:

- CREATE NEW LOT(S)
- BUILD ON AN EXISTING LOT IN A SUBDIVISION
- BUILD ON AN EXISTING PARCEL OF RECORD

IS THE PROPERTY WITHIN 2500' OF ANY RESERVOIR?

- YES
- NO

THE TYPE OF STRUCTURE IS:

- RESIDENTIAL WITH \_\_\_\_\_ PROPOSED BEDROOMS IN THE COMPLETED STRUCTURE (NOTE **UNKNOWN** IF APPROPRIATE)
- COMMERCIAL (PROVIDE DETAIL OF NUMBERS AND TYPES OF EMPLOYEES/ CUSTOMERS ON ACCOMPANYING PLAN)
- INSTITUTIONAL/GOVERNMENT (PROVIDE DETAIL OF NUMBERS AND TYPES OF EMPLOYEES/USERS ON ACCOMPANYING PLAN)

PROPERTY OWNER(S) Begina Smutz

DAYTIME PHONE 410-442-1708 CELL \_\_\_\_\_ FAX \_\_\_\_\_

MAILING ADDRESS 799 Driver Rd. Mariottsville MD 21104  
STREET CITY/TOWN STATE ZIP

APPLICANT Mildenberg Boender & Assoc, Inc.

DAYTIME PHONE 410-997-0296 CELL \_\_\_\_\_ FAX \_\_\_\_\_

MAILING ADDRESS 7350-B Grave Drive Columbia MD 21044  
STREET CITY/TOWN STATE ZIP

APPLICANT'S ROLE: DEVELOPER BUILDER BUYER RELATIVE/FRIEND REALTOR CONSULTANT

PROPERTY LOCATION

SUBDIVISION/PROPERTY NAME Piney Run Overlook LOT NO. 3

PROPERTY ADDRESS Driver Rd Mariottsville MD  
STREET TOWN/POST OFFICE

TAX MAP PAGE(S) 5 GRID 22 PARCEL(S) 7 PROPOSED LOT SIZE 3.00 Ac.

AS APPLICANT, I UNDERSTAND THE FOLLOWING: THE SYSTEM INSTALLED SUBSEQUENT TO THIS APPLICATION IS ACCEPTABLE ONLY UNTIL PUBLIC SEWERAGE IS AVAILABLE. THIS APPLICATION IS COMPLETE WHEN ALL APPLICABLE FEES AND A SUITABLE SITE PLAN HAVE BEEN RECEIVED. I ACCEPT THE RESPONSIBILITY FOR COMPLIANCE WITH ALL M.O.S.H.A. AND "MISS UTILITY" REQUIREMENTS. APPROVAL IS BASED UPON SATISFACTORY REVIEW OF A PERC CERTIFICATION PLAN.


TEST RESULTS WILL BE MAILED TO APPLICANT.

SIGNATURE OF APPLICANT

HOWARD COUNTY HEALTH DEPARTMENT, BUREAU OF ENVIRONMENTAL HEALTH, WELL AND SEPTIC PROGRAM  
7178 COLUMBIA GATEWAY DRIVE COLUMBIA MARYLAND 21046 (410) 313-2640 FAX (410) 313-2648  
TDD (410) 313-2323 TOLL FREE 1-877-4MD-DHMH

Lot 3

AP

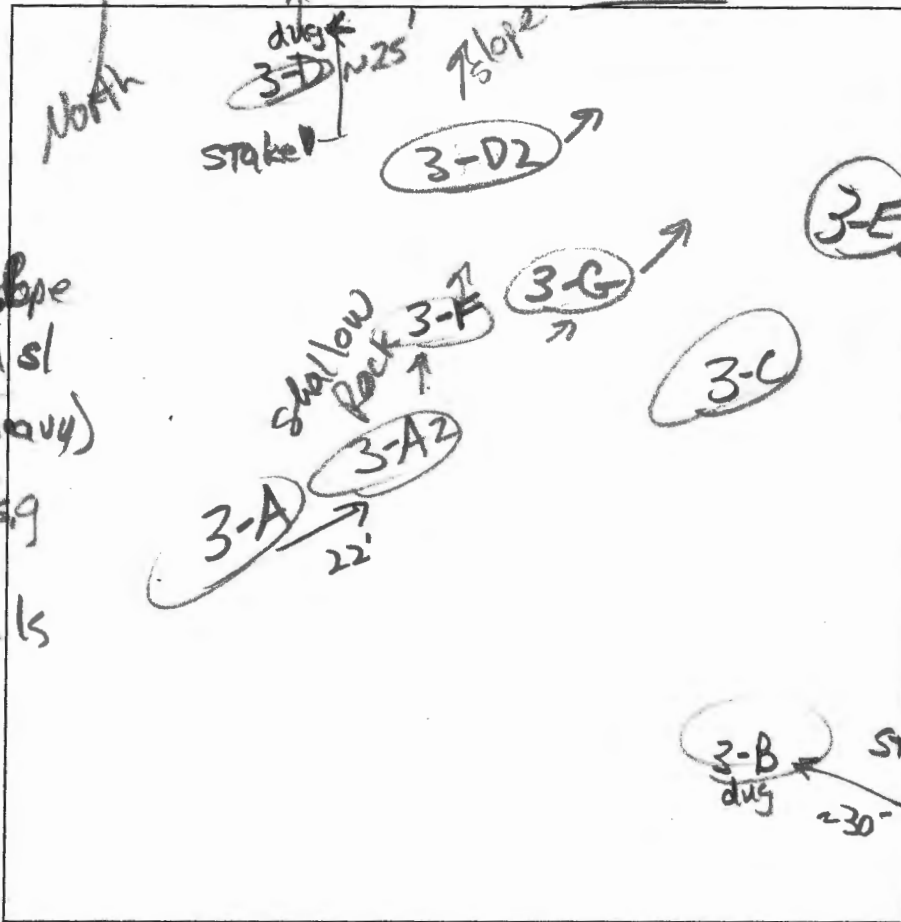

- 3F top of ches +  
2-5' refusal
- 3G side slope  
dk grey brn sl  
brn sl (heavy)  
few mica  
brn ls @ sq  
yellow  
& grey-brn ls  
12' @ s.g.


DATE	TEST #	DEPTH	START	BREAK 1" DROP	STOP 2" DROP	TIME OF 2ND INCH	P/F/H
12/15/14	3B	12'	Visual		Sidewall 3-B 1/2 gpd/ft <sup>2</sup>		P
12/15/14	3F	2'	Visual		Rock/refusal		F

REMARKS \_\_\_\_\_  
 SANITARIAN RP Ricker BACKHOE Jay Nathan OTHERS Todd Hill  
 TEST HOLES USED IN SDA \_\_\_\_\_ AVG. PERC TIME \_\_\_\_\_ SQ. FT/BR \_\_\_\_\_  
 TRENCH WIDTH \_\_\_\_\_ INLET DEPTH \_\_\_\_\_ MAX. BOT DEPTH \_\_\_\_\_ EFFECTIVE SW \_\_\_\_\_

A/P

wooded Lot 3

3-D  
 0.2 dk grey-brn sl, 2fg  
 0.8 grey-brn sl, 1 v/sbk  
 2.5 red-brn sl, 1 f/sbk, com. mica  
 4.3 dk. grey & brn ls, wk, thin platy many mica  
 8.3 pink & yellow ls, wk, medium platy (many mica)  
 11' brn ls, medium platy (com. mica)  
 11' 10% stones  
 3A  
 dk. grey-brn sl  
 60% boulders  
 40% yel-red sandy loam  
 55' R  
 3A2  
 1' extremely bouldery  
 3-C  
 dk grey-brn sl, 2fg to 2 v/sbk  
 0.8 yel-red chcls, 0m  
 2' red & red-brn ls, thin platy many mica  
 3.5' brn ls, with yellow & yel-red inclusions  
 9' common mica  
 brn & grey & grey-brn ls, 0m few flags & channers

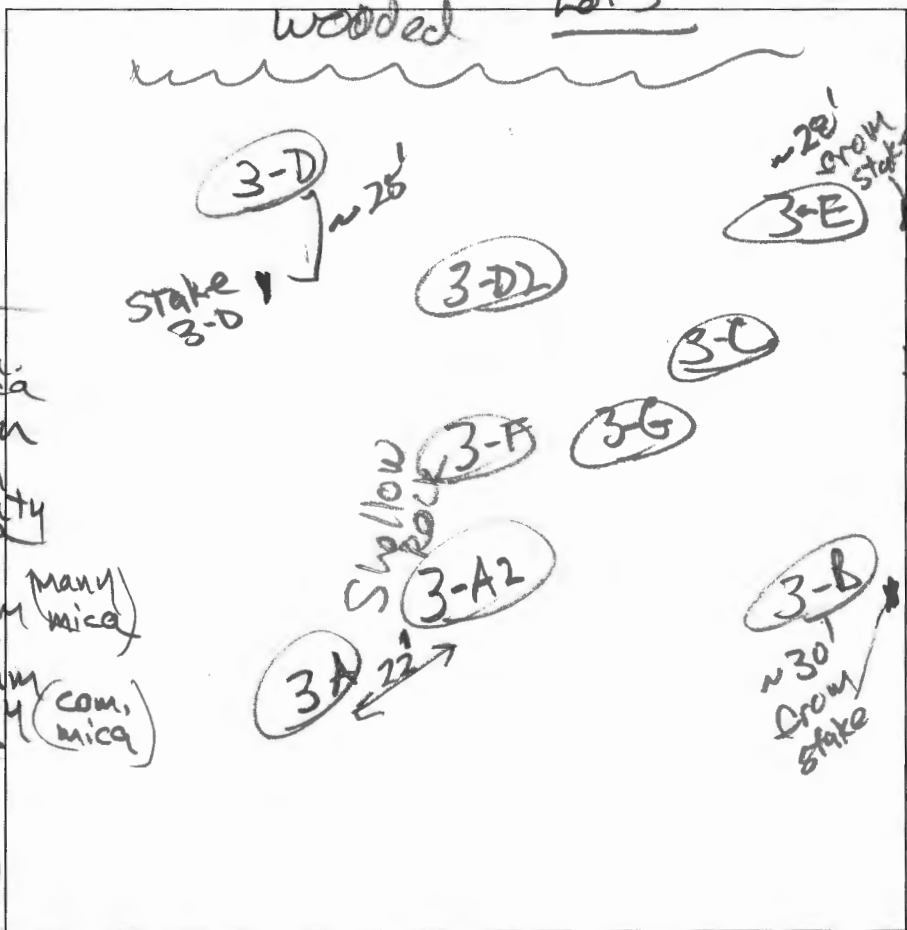

3-E  
 dk grey-brn sl, few channers  
 2fg to 1 v/sbk  
 dk. grey-brn red-brn & yellow ls, wk, medium platy near vertical  
 3.5' dk brn & yellow ls, wk, medium platy  
 6.3' yellow ls  
 12' 0m  
 3-D2  
 boulders to 4'  
 4' brn-grey and brn ls  
 11'  
 3-B  
 dk. grey-brn sl, 2fg to 2 f/sbk  
 0.8' brn L, 3 f/sbk  
 6.7' brn L, 2 f/sbk common mica  
 2.8' dk grey-brn, red-brn ls many mica wk, medium platy  
 6' yellow, brn & red-yellow ls, wk, medium platy many mica  
 12'

DATE	TEST #	DEPTH	START	BREAK 1" DROP	STOP 2" DROP	TIME OF 2ND INCH	P/F/H
12/15/14	3-D	4' 11"	10:33	10:39	10:50	11	P
12/15/14	3A	1'	Visual		very bouldery 60% boulders		F
12/15/14	3-C	5' 12"	11:13	11:15	11:17	2	P
12/15	3-D2	11'	Visual		sidewall to 5 1.25 gpd/a.		P
12/15/14	3-E	4' 12"	11:35	11:37	11:39	2	P
12/15/14	3-B	4' 12"	12:09	12:11	12:16	5	P
12/15/14	3A2	1'	Visual		Rock		F

REMARKS \_\_\_\_\_  
 SANITARIAN Bricker BACKHOE J&A Nathan OTHERS Todd Hill  
 TEST HOLES USED IN SDA \_\_\_\_\_ AVG. PERC TIME \_\_\_\_\_ SQ. FT/BR \_\_\_\_\_  
 TRENCH WIDTH \_\_\_\_\_ INLET DEPTH \_\_\_\_\_ MAX. BOT DEPTH \_\_\_\_\_ EFFECTIVE SW \_\_\_\_\_

Lot 3

AP

3H

0.2' dk brn-grey  
L, 2fg, ss  
few mica

0.8' brn L, 2fsbk  
common mica

1.8' red-brn & dk brn  
sl, thick platy  
many mica  
& brn-yel lcs, dsq

4' dk. brn, red-brn  
& yel-brn ls  
thick platy few mica  
few stones

6' dk brn, pale brn  
& lt. brn-grey  
chls, dsq few mica

11' brn & red yel.  
fils, thick platy few mica

North

wooded  
3-D field

3D2 3H  
3E

Sample

DATE	TEST #	DEPTH	START	BREAK 1" DROP	STOP 2" DROP	TIME OF 2ND INCH	P/F/H
4/10/15	3H	4.3' 11'	10:16	10:18	10:20	2	P

REMARKS \_\_\_\_\_

SANITARIAN R. Bricker BACKHOE JEA OTHERS Todd Hill

TEST HOLES USED IN SDA \_\_\_\_\_ AVG. PERC TIME \_\_\_\_\_ SQ. FT/BR \_\_\_\_\_

TRENCH WIDTH \_\_\_\_\_ INLET DEPTH \_\_\_\_\_ MAX. BOT DEPTH \_\_\_\_\_ EFFECTIVE SW \_\_\_\_\_

Search Result for HOWARD COUNTY

View Map		View GroundRent Redemption			View GroundRent Registration					
<b>Tax Exempt:</b>		<b>Special Tax Recapture:</b>								
<b>Exempt Class:</b>		AGRICULTURAL TRANSFER TAX								
<b>Account Identifier:</b>		<b>District - 03 Account Number - 600109</b>								
Owner Information										
<b>Owner Name:</b>		SMUTZ REGINA R SMUTZ JOSEPH A			<b>Use:</b>		RESIDENTIAL			
<b>Mailing Address:</b>		799 DRIVER RD MARRIOTTSVILLE MD 21104-1326			<b>Principal Residence:</b>		NO			
					<b>Deed Reference:</b>					
Location & Structure Information										
<b>Premises Address:</b>		739 DRIVER RD MARRIOTTSVILLE 21104-0000			<b>Legal Description:</b>		LOT 3 3.01 A. 739 DRIVER RD PINEY RUN OVERLOOK			
<b>Map:</b>	<b>Grid:</b>	<b>Parcel:</b>	<b>Sub District:</b>	<b>Subdivision:</b>	<b>Section:</b>	<b>Block:</b>	<b>Lot:</b>	<b>Assessment Year:</b>	<b>Plat No:</b>	
0005	0022	0007		0003			3	2019		
									<b>Plat Ref:</b> 24296-97	
<b>Special Tax Areas:</b>				<b>Town:</b>		NONE				
				<b>Ad Valorem:</b>						
				<b>Tax Class:</b>						
<b>Primary Structure Built</b>	<b>Above Grade Living Area</b>	<b>Finished Basement Area</b>	<b>Property Land Area</b>	<b>County Use</b>						
			3.0100 AC							
<b>Stories</b>	<b>Basement</b>	<b>Type</b>	<b>Exterior</b>	<b>Full/Half Bath</b>	<b>Garage</b>	<b>Last Major Renovation</b>				
Value Information										
		<b>Base Value</b>	<b>Value</b>	<b>Phase-in Assessments</b>						
			As of	As of		As of				
			01/01/2019	07/01/2019		07/01/2020				
<b>Land:</b>		170,100	193,900							
<b>Improvements</b>		0	0							
<b>Total:</b>		170,100	193,900	178,033		185,967				
<b>Preferential Land:</b>		0		0						
Transfer Information										
<b>Seller:</b>		<b>Date:</b>			<b>Price:</b>					
<b>Type:</b>		<b>Deed1:</b>			<b>Deed2:</b>					
<b>Seller:</b>		<b>Date:</b>			<b>Price:</b>					
<b>Type:</b>		<b>Deed1:</b>			<b>Deed2:</b>					
<b>Seller:</b>		<b>Date:</b>			<b>Price:</b>					
<b>Type:</b>		<b>Deed1:</b>			<b>Deed2:</b>					
Exemption Information										
<b>Partial Exempt Assessments:</b>		<b>Class</b>				07/01/2019	07/01/2020			
<b>County:</b>		000				0.00				
<b>State:</b>		000				0.00				
<b>Municipal:</b>		000				0.00 0.00	0.00 0.00			
<b>Tax Exempt:</b>		<b>Special Tax Recapture:</b>								
<b>Exempt Class:</b>		AGRICULTURAL TRANSFER TAX								
Homestead Application Information										
<b>Homestead Application Status:</b> No Application										
Homeowners' Tax Credit Application Information										
<b>Homeowners' Tax Credit Application Status:</b> No Application					<b>Date:</b>					