

9/8/72
after 10 A.M.

Final
OR
CSD

PERMIT

SEWAGE DISPOSAL SYSTEM

MARYLAND STATE DEPARTMENT OF HEALTH

HOWARD COUNTY

ELLICOTT CITY

INDEXED

DISTRICT 3rd

DATE 9/7/72

P 17415

A

Jenkins Brothers IS PERMITTED TO INSTALL ALTER

ADDRESS Wallas Park, Ellicott City, Md. PHONE 465-6646

A SEWAGE DISPOSAL SYSTEM LOCATED AT

SUBDIVISION ROAD Route 32 - 1/4 miles LOT from Route 144, making left on Rt. 32 - house on left hand side of road

PROPERTY OWNER William Unverzagt

ADDRESS Route 32, West Friendship, Md.

SPECIFICATIONS

DRAIN FIELD DEPTH FEET, BOTTOM AREA SQ. FT.

SEEPAGE PITS ABSORBENT SIDE-WALL AREA SQ. FT.

SEPTIC TANK CAPACITY 1000 GALLONS

FOR GARBAGE GRINDER, INCREASE DISPOSAL AREA 22% & TANK CAPACITY 50%.

OTHER Inspection of excavation needed before back filling.


PLANS APPROVED BY Palmer F. Wine DATE 9/7/72

FILL SEPTIC TANK AND DISTRIBUTION BOX WITH WATER BEFORE CALLING FOR AN INSPECTION. COVER NO WORK UNTIL INSPECTED AND APPROVED.

NEITHER THE HOWARD COUNTY COMMISSIONERS NOR THE HEALTH DEPARTMENT IS RESPONSIBLE FOR THE SUCCESSFUL OPERATION OF ANY SYSTEM.

17415

DATE SYSTEM APPROVED INSPECTOR

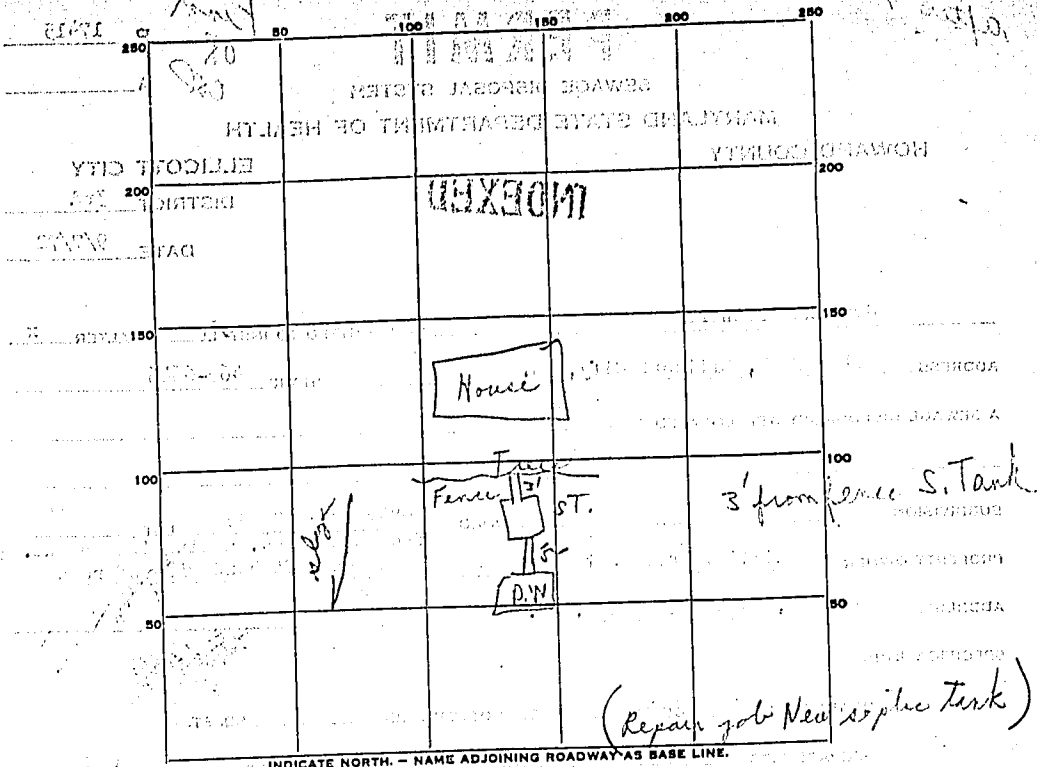

INDICATE NORTH - NAME ADJOINING ROADWAY AS BASE LINE.

PERMIT CARD signed

SEPTIC TANK, LEVEL OK CLEANOUTS OK

DISTRIBUTION BOX, LEVEL _____

TILE FIELD, DEPTH _____ FT. TRENCH WIDTH _____ FT.

GRAVEL DEPTH _____ IN. TOTAL LENGTH _____ FT.

NUMBER OF TRENCHES _____ TOTAL BOTTOM AREA _____

SEEPAGE PITS; INSIDE DIAMETER _____ FT. DEPTH BELOW INLET _____ FT.

ABSORBENT AREA _____ SQ. FT.

REMARKS 9/7/72 OK plan, install tank & new septic tank
only of CBS! (as called for!)

DATE SYSTEM APPROVED 9/7/72 INSPECTOR C J Stecker