


AP 16
 Strong brn. SCL Compact
 3L 4
 wk org, 4brn Loam / s/l
 SAND MASSIVE
 Rock frag Stone 15-20%
 Bottom 14'10"

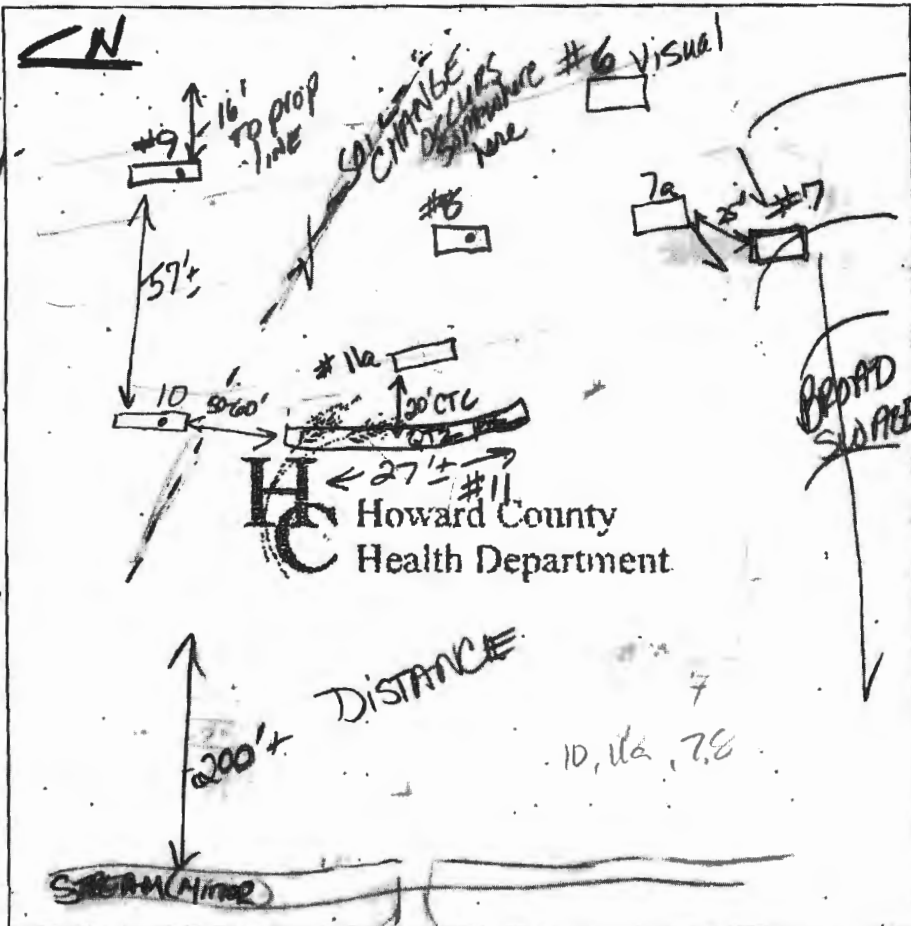

Strong gritty SCL
 3'
 Str brn fin brn
 gritty 2pl / LS w/ clay
 chert frag w/ Mnion (sand stone)
 30%
 Bottom

7a
 Strong brn MASSIVE CL
 NO water seepage
 6'
 Str brn
 Loam Trace Rx
 13
 Lt brn SL Bottom 16'

10
 Strong org CL
 2'
 Str yellow S.L. Rx 10%
 5'
 Hbrn grn brn SL
 Rx 23
 10'10" - 10'15" - LS
 Bottom getting hard

7
 Str rig brn dense SCL w/ w/ Loam Rx Trace
 water seepage @ 6 1/2"
 Str brn Sandy loam much @ 20% w/ w/ Rx 5%
 Bottom 14.2'

11
 Str frag @ 3 1/2" hole
 27" on center

DATE	TEST #	DEPTH	START	BREAK 1" DROP	STOP 2" DROP	TIME OF 2nd INCH	P/F/H
4-5-05	8	4 1/2' 14'10"	9:29	9:35	9:47	12	P
	6	same profile				BT 12	P
	7a	6 1/2' S	10:03	10:06	10:11	5'	P
	9	3 1/2' S	10:26	10:31	10:37	6	P
		5 gallons in bottom	10:37	10:35	8 min	1/2 gal left	
	10	5 1/2'	10:51	10:53	10:55	2'	
	11	7' on center	8 1/2'	lens @ 3 1/2"			
	11a	Visual	soils similar to 6, 8				OK
		Refusal	9 1/2'				BOTTOM NO DEEPER THAN 5'

REMARKS Compact soils. 6" posthole-sized perches.
 SANITARIAN Kacie Thomas BACKHOE Ted OTHERS Mr. Gaske
 TEST HOLES USED IN SDA 6, 7a, 8, 9, 10, 11a AVG. PERC TIME 8-15 SQ. FT/BR 210
 TRENCH WIDTH _____ INLET DEPTH _____ MAX. BOT DEPTH _____ EFFECTIVE SW _____

NOTES NOT PRESENT

Oswald, Hank

From: Oswald, Hank
Sent: Friday, March 01, 2019 10:01 AM
To: Stephanie Tuite (Stephanie@fcc-eng.com)
Subject: B19000445_13375 Forsythe Road

Hi Stephanie:

Good morning. Our office is in receipt of a building permit for 13375 Forsythe Road. I have not been able to locate the copy of the perc cert plan and perc test notes. Would you provide a copy of the approved perc cert plan and perc test notes for 13375 Forsythe Road? We will eventually need an OSDS plan for the BP.

Thanks,

Hank

Hank Oswald
Licensed Environmental Health Specialist
Howard County Health Department
Bureau of Environmental Health
Well & Septic Program
8930 Stanford Boulevard
Columbia, MD 21045
410.313.1786 (Office)
hoswald@howardcountymd.gov

CONFIDENTIALITY NOTICE

This message and the accompanying documents are intended only for the use of the individual or entity to which they are addressed and may contain information that is privileged, confidential, or exempt from disclosure under applicable law. If the reader of this email is not the intended recipient, you are hereby notified that you are strictly prohibited from reading, disseminating, distributing, or copying this communication. If you have received this email in error, please notify the sender immediately and destroy the original transmission.