

APPLICATION

Retest

8/19/83
9:30 A.M.

SEWAGE DISPOSAL TESTING

A 33037

STATE OF MARYLAND - DEPARTMENT OF HEALTH AND MENTAL HYGIENE

P _____

HOWARD COUNTY HEALTH DEPARTMENT
ENVIRONMENTAL HEALTH SERVICES

DISTRICT Fifth

P. O. BOX 476 ELLICOTT CITY, MARYLAND 21043
TELEPHONE: 992-2330

DATE August 11 1983

*SDP-84-192
8/26/83
9:30 AM*

TO: THE COUNTY HEALTH OFFICER
ELLICOTT CITY, MARYLAND

I, HEREBY, APPLY FOR THE NECESSARY TEST IN ORDER TO CONSTRUCT (OR RECONSTRUCT) A SEWAGE DISPOSAL SYSTEM.

PROPERTY OWNER DAVE SHAW

ADDRESS 51000 ROUTE 32 PHONE 730-3367

PROPERTY LOCATION:

SUBDIVISION _____ LOT NO. _____

ROAD AND DESCRIPTION _____

SIZE OF LOT 6 ACRES + TYPE BLDG. 6 EMPLOYEES NURSERY
3 BUILDINGS (NUMBER OF BEDROOMS) 3 B.R. + employees = 5 B.R.

THE SYSTEM INSTALLED UNDER THIS APPLICATION IS ACCEPTABLE ONLY UNTIL PUBLIC FACILITIES BECOME AVAILABLE. I FULLY UNDERSTAND THE

FEE CONNECTED WITH THE FILING OF THIS PERC TEST APPLICATION IS NON-REFUNDABLE UNDER ANY CIRCUMSTANCES. I ALSO AGREE TO COMPLY

WITH ALL M.O.S.H.A. REQUIREMENTS IN TESTING THIS LOT. [Signature]
(SIGNATURE OF APPLICANT)

APPROVED BY _____ FOR _____ DATE _____

REJECTED BY _____ FOR _____ DATE _____

HOLD PENDING FURTHER TESTS _____ DATE _____

REASONS FOR REJECTION OR HOLDING 8/19/83 - PROPOSED NEW PERC AREA





FOR NEW RETAIL STORE UNSATISFACTORY, BUT MAY
BE POSSIBLE TO COMBINE HOUSE & STORE IN ONE BUILDING
AT ORIGINAL HOUSE SITE. MUST HOLD FOR REVIEW RH

THIS IS NOT A PERMIT


8/26/83 F.S. said OK HOUSE & STORE IN ONE BUILDING
ALSO OK TO HAVE HOUSE & STORE IN SEPARATE BUILDING
WITH STORE USING A PERMITS TO BE OBTAINED SEPARATE TO PERC

H₂O
 2
 9

SOIL PROFILE

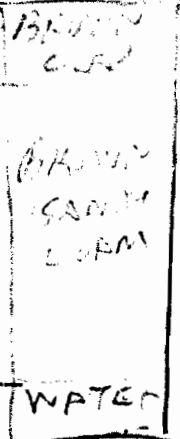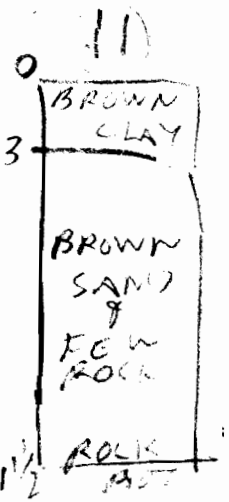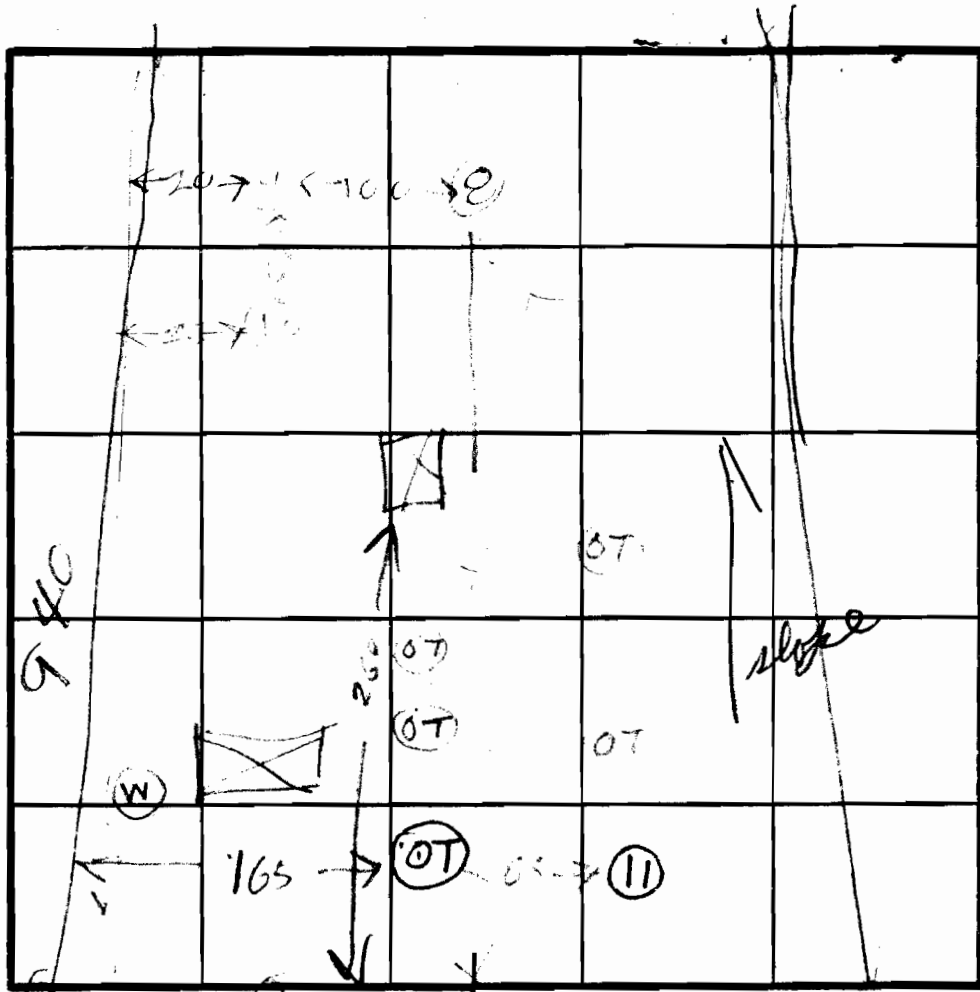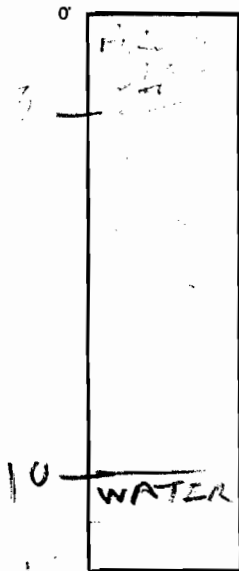

DATE	TEST NO.	DEPTH	PRE-WET		TEST - 1" DROP		TIME	
			START	STOP	START	STOP		
8/19/83	8V	12	WATER	1.5"	LOOKS BAD			
	9V	12	WATER	1.5"	LOOKS BAD			
	10V	10	WATER	7"	LOOKS BAD			
	11V	11 1/2	LOOKS OK		SEE PR OF 14			

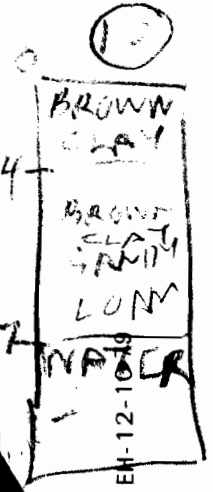

REMARKS OT = OLD TEST, UNSATISFACTORY FOR
PROPOSED STORE LOCATED 260 FT FROM FRONT
 TYPE OF SOIL DAVE SHAW
 TESTED BY OWNER ALSO PRESENT

EH-12-10-79