

2/15/75 file app'd WWZ

PERMIT

P 21042

A 17883

SEWAGE DISPOSAL SYSTEM

MARYLAND STATE DEPARTMENT OF HEALTH

HOWARD COUNTY

INDEXED

ELLICOTT CITY

DISTRICT 4

DATE 12/23/74

Melvin C. Howard IS PERMITTED TO INSTALL ALTER

ADDRESS 4001 Damascus Road, Gaithersburg, Md. PHONE 301-774-4149

A SEWAGE DISPOSAL SYSTEM LOCATED AT _____

SUBDIVISION _____ ROAD Route 94 LOT 9

1.7 miles so. of Lisbon

PROPERTY OWNER Melvin C. Howard

ADDRESS _____

SPECIFICATIONS - 3 bedrooms

DRAIN FIELD _____ DEPTH _____ FEET, BOTTOM AREA _____ SQ. FT.

SEEPAGE PITS _____ ABSORBENT SIDE-WALL AREA _____ SQ. FT.

SEPTIC TANK CAPACITY 1,000 GALLONS

FOR GARBAGE GRINDER, INCREASE DISPOSAL AREA 22% & TANK CAPACITY 50%.

OTHER Dry well - 375 sq. ft. absorbent sidewall area to begin below the first 4 1/2 ft.

of non-absorbent ground. Max. depth permitted for dry well is 13 ft. below original grade.

Place dry well 190 ft. from edge of Rt. 94 and 135 ft. from right sideline as seen when facing lot from Rt. 94.

NOTE: ALL PIPE FROM HOUSE TO DISPOSAL AREA MUST BE CAST IRON.

PERMIT VOID AFTER THREE YEARS.


NOTE: INSTALL STAND PIPE ON SEPTIC TANK AND DRY WELL - STAND PIPE MUST BE 6" IN DIA. - CAST IRON, CONCRETE OR TERRA COTTA ACCEPTED.

PLANS APPROVED BY D. W. Monaghan DATE 1/30/73

FILL SEPTIC TANK AND DISTRIBUTION BOX WITH WATER BEFORE CALLING FOR AN INSPECTION. COVER NO WORK UNTIL INSPECTED AND APPROVED.

NEITHER THE HOWARD COUNTY COMMISSIONERS NOR THE HEALTH DEPARTMENT IS RESPONSIBLE FOR THE SUCCESSFUL OPERATION OF ANY SYSTEM.

A 17883

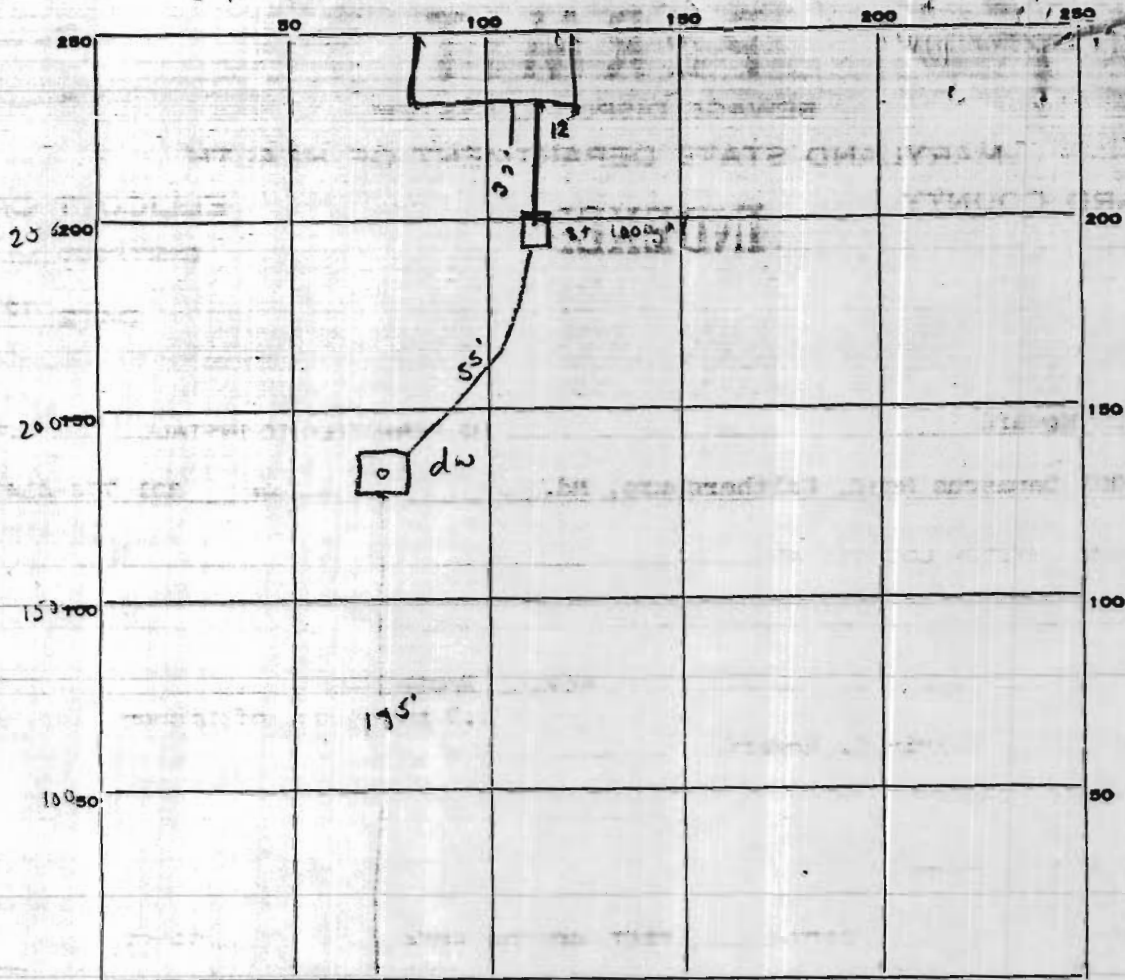

INDICATE NORTH. - NAME ADJOINING ROADWAY AS BASE LINE.

PERMIT CARD

SEPTIC TANK, LEVEL

CLEANOUTS du / st cap cleanout - not affected

DISTRIBUTION BOX, LEVEL Na

TILE FIELD, DEPTH Na FT. TRENCH WIDTH Na FT.

GRAVEL DEPTH Na IN. TOTAL LENGTH Na FT.

NUMBER OF TRENCHES Na TOTAL BOTTOM AREA Na

SEEPAGE PITS, INSIDE DIAMETER 4 1/4 FT. DEPTH BELOW INLET 8 1/2 FT.

ABSORBENT AREA 374 SQ. FT.

REMARKS 3/5/75 Work Satisfactory, continue. Install cleanout and cap on ST, all other work may be covered. A/C & F.S.

8/5/75 Cleanout for ST visible. Cap and cleanout are cast iron, appear to be secure. Date

DATE SYSTEM APPROVED 8/5/75

INSPECTOR W. H. Jeff