

APPLICATION

PERCOLATION TESTING

A 41240

P _____

HOWARD COUNTY HEALTH DEPARTMENT
BUREAU OF ENVIRONMENTAL HEALTH
P.O. BOX 476 ELLICOTT CITY, MARYLAND 21043
TELEPHONE 461-9933

DISTRICT 4th

DATE 3-10-88

TO: THE COUNTY HEALTH OFFICER
ELLICOTT CITY, MARYLAND

I, HEREBY, APPLY FOR THE NECESSARY TEST IN ORDER TO CONSTRUCT (OR RECONSTRUCT) A SEWAGE DISPOSAL SYSTEM.

PROPERTY OWNER Catherine C. Apovian

ADDRESS 2225 Mc hendree Rd PHONE Loring / Tim 544-6052

PROSPECTIVE BUYER W. M. M. Builders Inc.

ADDRESS 5581 Boardman Rd PHONE Loring / Tim 544-6052

PROPERTY LOCATION:

SUBDIVISION _____ LOT NO 4

ROAD AND DESCRIPTION Mc hendree Rd West Friendship

TAX MAP 10 PARCEL # 51

SIZE OF LOT 3.03 TYPE BLDG 1 1/2 S
(SINGLE FAMILY DWELLING OR COMMERCIAL)

THE SYSTEM INSTALLED UNDER THIS APPLICATION IS ACCEPTABLE ONLY UNTIL PUBLIC FACILITIES BECOME AVAILABLE. I FULLY UNDERSTAND THE FEE CONNECTED WITH THE FILING OF THIS PERC TEST APPLICATION IS NON-REFUNDABLE UNDER ANY CIRCUMSTANCES. I ALSO AGREE TO COMPLY WITH ALL M.O.S.H.A. REQUIREMENTS IN TESTING THIS LOT. Loring / Tim M. M. Builders Inc.
(SIGNATURE OF APPLICANT)

APPROVED BY _____ FOR _____ DATE _____

REJECTED BY _____ FOR _____ DATE _____

HOLD PENDING FURTHER TESTS _____ DATE _____

REASONS FOR REJECTION OR HOLDING _____



HD-216

THIS IS NOT A PERMIT

210

Lot 4

SOIL PROFILE

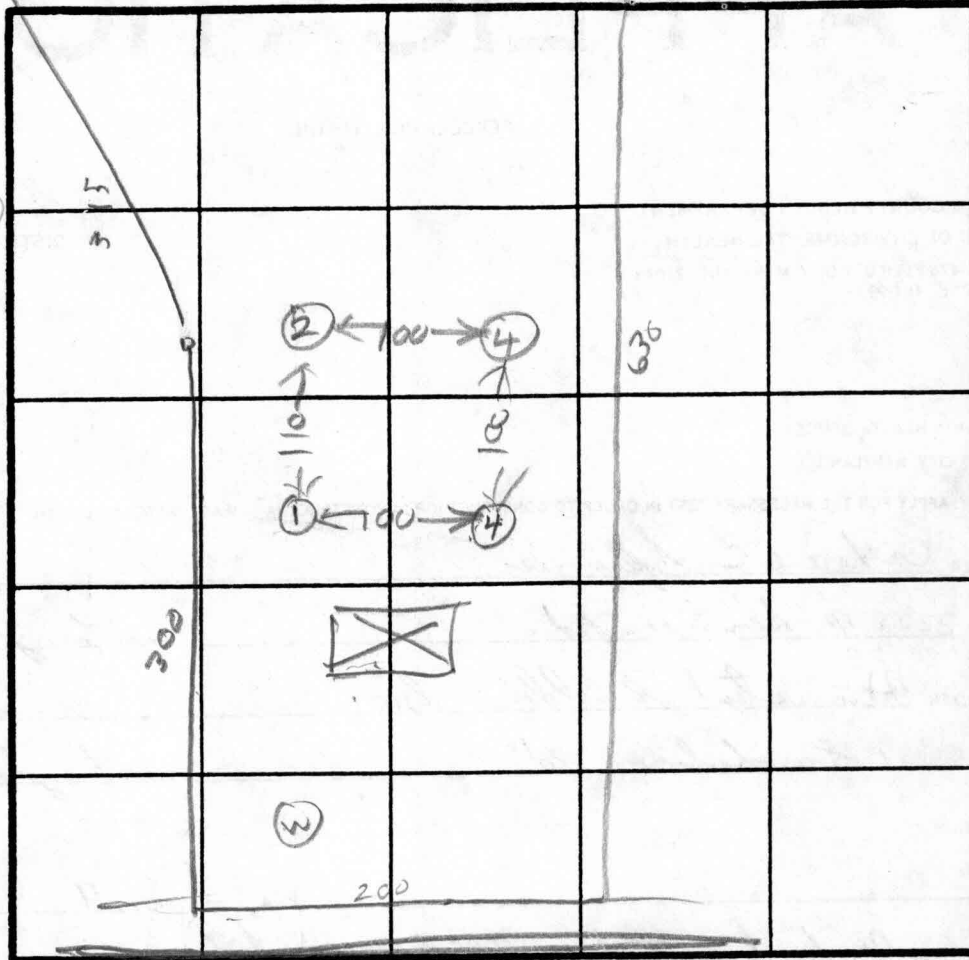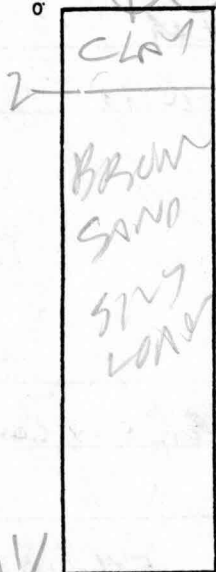

INDICATE NORTH - NAME ADJOINING ROADWAY AS BASE LINE.

DATE	TEST NO.	DEPTH	PRE-WET		TEST - 1" DROP		TIME
			START	STOP	START	STOP	
5/13/88	15	3	1134	1135	1135	1137	2
	112	6.5	1134	1135	1135	1137	
5/13/88	11	11 1/2	OK				
1	25	2	1100	1101	1101	1143	2
	21	1 1/2	OK				
	33	3 1/2	1145	1149	1149	1159	
	34	11	OK				
2	4	12	OK				



REMARKS: Holes per survey on plot

TYPE OF SOIL

TESTED BY: R. HODGES

ALSO PRESENT: SKIP JACK EYUIC, LARRY STEAN