

11/16/67  
steady

# PERMIT

11/16/67  
DWS

P 12787

A 12701

SEWAGE DISPOSAL SYSTEM

MARYLAND STATE DEPARTMENT OF HEALTH

HOWARD COUNTY

ELLICOTT CITY

DISTRICT 4

## INDEXED

DATE 6/28/67

10/26/67  
Herman Sirk Souden Const. Co. IS PERMITTED TO INSTALL  ALTER

ADDRESS Annapolis Rock Rd., Woodbine, Md. PHONE 1-CL. 3-2221  
9-4724

A SEWAGE DISPOSAL SYSTEM LOCATED AT \_\_\_\_\_

SUBDIVISION Hallowell Property ROAD Florence Rd. - Rt. 10 LOT 10

PROPERTY OWNER Joseph G. Ciufolo

ADDRESS \_\_\_\_\_

SPECIFICATIONS - 3 bedrooms

DRAIN FIELD \_\_\_\_\_ DEPTH \_\_\_\_\_ FEET, BOTTOM AREA \_\_\_\_\_ SQ. FT.

SEEPAGE PITS \_\_\_\_\_ ABSORBENT SIDE-WALL AREA \_\_\_\_\_ SQ. FT.

SEPTIC TANK CAPACITY 1500 GALLONS

FOR GARBAGE GRINDER, INCREASE DISPOSAL AREA 22% & TANK CAPACITY 50%.

OTHER Dry well - 16 ft. square (set block and top for 12 ft. diameter and fill in rest of pit with gravel). Dry well to be 7 ft. deep below the inlet pipe. Inlet pipe must be 4 ft. below original grade. Maximum depth permitted for dry well below original grade is 13 ft. Place dry well 75 ft. directly in front of right front corner of house.

PERMIT VOID AFTER THREE YEARS.

PLANS APPROVED BY D. W. Monaghan DATE 6/7/67

FILL SEPTIC TANK AND DISTRIBUTION BOX WITH WATER BEFORE CALLING FOR AN INSPECTION. COVER NO WORK UNTIL INSPECTED AND APPROVED.

NEITHER THE HOWARD COUNTY COMMISSIONERS NOR THE HEALTH DEPARTMENT IS RESPONSIBLE FOR THE SUCCESSFUL OPERATION OF ANY SYSTEM.


### NOTIFY THE HEALTH DEPARTMENT 48 HOURS BEFORE EXCAVATIONS ARE TO BE BACK FILLED.

12701

15  
16  
16  
17  

---

64

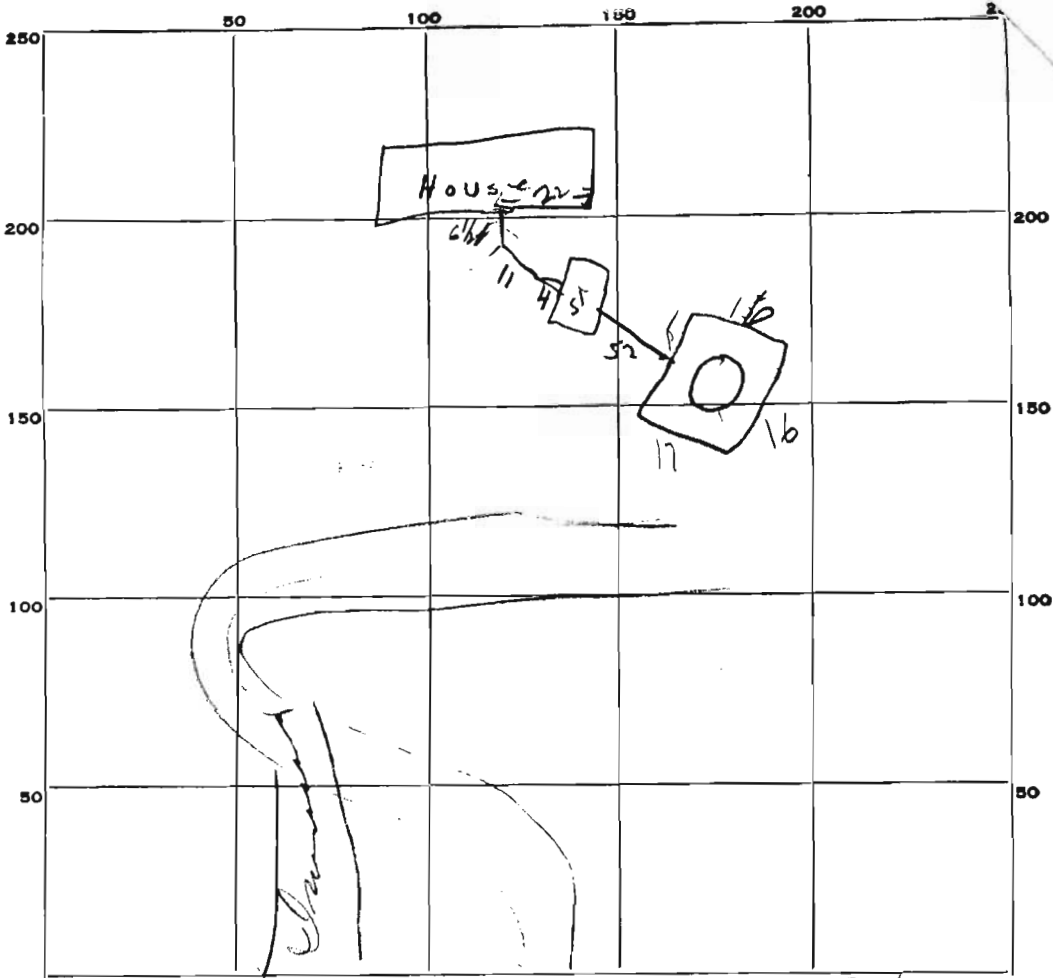

PERMIT CARD OK

SEPTIC TANK, LEVEL OK CLEANOUTS OK (man hole)

DISTRIBUTION BOX, LEVEL \_\_\_\_\_

TILE FIELD, DEPTH \_\_\_\_\_ FT. TRENCH WIDTH \_\_\_\_\_ FT.

GRAVEL DEPTH \_\_\_\_\_ IN. TOTAL LENGTH \_\_\_\_\_ FT.

NUMBER OF TRENCHES \_\_\_\_\_ TOTAL BOTTOM AREA \_\_\_\_\_

SEEPAGE PITS, INSIDE DIAMETER Perimeter of 64 FT. DEPTH BELOW INLET 7 FT.

ABSORBENT AREA 448 SQ. FT.

REMARKS 11/16/67 Due to amount of rocky soil can't open space between outlet pipe & solid ground the first 5 ft of fiber pipe should be removed & replaced with cast iron - fiber pipe may bend when ground settles or cracks in pot hole in it when backfilled - or use extreme caution when must be used in backfilling & backfilled to hard - then tamped light fiber pipe should be braced by plank board not necessary to call for rock bed

DATE SYSTEM APPROVED 11/16/67 INSPECTOR DW Money