

2/20/86
9:30 AM

APPLICATION

PERCOLATION TESTING

A 34576

P _____

HOWARD COUNTY HEALTH DEPARTMENT
BUREAU OF ENVIRONMENTAL HEALTH
P.O. BOX 476 ELLICOTT CITY, MARYLAND 21043
TELEPHONE: 461-9933

DISTRICT 4

DATE Feb 10/86

TO: THE COUNTY HEALTH OFFICER
ELLICOTT CITY, MARYLAND

I, HEREBY, APPLY FOR THE NECESSARY TEST IN ORDER TO CONSTRUCT (OR RECONSTRUCT) A SEWAGE DISPOSAL SYSTEM.

PROPERTY OWNER Mrs Ruth Daggett

ADDRESS 1276 Rt 97 PHONE 489-4953

PROSPECTIVE BUYER William L. Seymour Jr.

ADDRESS 1276 Rt 97 PHONE 489-4953

PROPERTY LOCATION:

SUBDIVISION Daggett farm LOT NO. Parcel two

ROAD AND DESCRIPTION Rt 97 one mile north 144 turn
left at old Fredrick Rd top of hill

TAX MAP _____ PARCEL # two

SIZE OF LOT 3 acres TYPE BLDG. Barn
(SINGLE FAMILY DWELLING OR COMMERCIAL)

THE SYSTEM INSTALLED UNDER THIS APPLICATION IS ACCEPTABLE ONLY UNTIL PUBLIC FACILITIES BECOME AVAILABLE. I FULLY UNDERSTAND THE FEE CONNECTED WITH THE FILING OF THIS PERC TEST APPLICATION IS NON-REFUNDABLE UNDER ANY CIRCUMSTANCES. I ALSO AGREE TO COMPLY WITH ALL M.O.S.H.A. REQUIREMENTS IN TESTING THIS LOT.

William L. Seymour Jr.
(SIGNATURE OF APPLICANT)

APPROVED BY _____ FOR _____ DATE _____

REJECTED BY _____ FOR _____ DATE _____

HOLD PENDING FURTHER TESTS _____ DATE _____

REASONS FOR REJECTION OR HOLDING _____

THIS IS NOT A PERMIT

APPLICATION

PERCOLATION TESTING

A 34517

HOWARD COUNTY HEALTH DEPARTMENT
BUREAU OF ENVIRONMENTAL HEALTH
P.O. BOX 476 ELLICOTT CITY, MARYLAND 21043
TELEPHONE: 461-9933

P _____
DISTRICT 4
DATE Feb 10/86

TO: THE COUNTY HEALTH OFFICER
ELLICOTT CITY, MARYLAND

I, HEREBY, APPLY FOR THE NECESSARY TEST IN ORDER TO CONSTRUCT (OR RECONSTRUCT) A SEWAGE DISPOSAL SYSTEM.

PROPERTY OWNER Mrs Ruth Daggett
ADDRESS 1271 Rt 97 PHONE 421-4153

PROSPECTIVE BUYER William S. Seymour Jr.
ADDRESS 1271 Rt 97 PHONE 421-4153

PROPERTY LOCATION:
SUBDIVISION Daggett farm LOT NO. Parcel two
ROAD AND DESCRIPTION Rt 97 one mile north 144 turn
left at old Frederick Rd top of hill
TAX MAP _____ PARCEL # two
SIZE OF LOT 3 acres TYPE BLDG. ~~Single Family Dwelling~~
(SINGLE FAMILY DWELLING OR COMMERCIAL)

THE SYSTEM INSTALLED UNDER THIS APPLICATION IS ACCEPTABLE ONLY UNTIL PUBLIC FACILITIES BECOME AVAILABLE. I FULLY UNDERSTAND THE FEE CONNECTED WITH THE FILING OF THIS PERC TEST APPLICATION IS NON-REFUNDABLE UNDER ANY CIRCUMSTANCES. I ALSO AGREE TO COMPLY WITH ALL M.O.S.H.A. REQUIREMENTS IN TESTING THIS LOT. William S. Seymour Jr.
(SIGNATURE OF APPLICANT)

APPROVED BY _____ FOR _____ DATE _____
REJECTED BY _____ FOR _____ DATE _____
HOLD PENDING FURTHER TESTS _____ DATE _____
REASONS FOR REJECTION OR HOLDING _____

THIS IS NOT A PERMIT

2/20/86
9:30 AM

APPLICATION

PERCOLATION TESTING

R 36517

A Repair

HOWARD COUNTY HEALTH DEPARTMENT
BUREAU OF ENVIRONMENTAL HEALTH
P.O. BOX 476 ELLICOTT CITY, MARYLAND 21043
TELEPHONE: 461-9933

DISTRICT 4

DATE Feb 10/86

" 97 TO OLD FREDERICK
LEFT ON DIRT DRIVEWAY AT OLD FREDERICK
BACK THRU CORNFIELD. "

TO: THE COUNTY HEALTH OFFICER
ELLICOTT CITY, MARYLAND

I, HEREBY, APPLY FOR THE NECESSARY TEST IN ORDER TO CONSTRUCT (OR RECONSTRUCT) A SEWAGE DISPOSAL SYSTEM.

PROPERTY OWNER Mrs. Ruth Paggett

ADDRESS 1276 Rt 97 PHONE 489-4953

PROSPECTIVE BUYER William A. Seymour Jr.

ADDRESS 1276 Rt 97 PHONE 489-4953

PROPERTY LOCATION:

SUBDIVISION Paggett farm LOT NO. Parcel ~~two~~ ^{one}

ROAD AND DESCRIPTION Rt 97 one mile north 144 turn left
at old Frederick Rd top of hill

TAX MAP _____ PARCEL # two

SIZE OF LOT 3 acers TYPE BLDG. ~~Res~~
(SINGLE FAMILY DWELLING OR COMMERCIAL)

THE SYSTEM INSTALLED UNDER THIS APPLICATION IS ACCEPTABLE ONLY UNTIL PUBLIC FACILITIES BECOME AVAILABLE. I FULLY UNDERSTAND THE FEE CONNECTED WITH THE FILING OF THIS PERC TEST APPLICATION IS NON-REFUNDABLE UNDER ANY CIRCUMSTANCES. I ALSO AGREE TO COMPLY WITH ALL M.O.S.H.A. REQUIREMENTS IN TESTING THIS LOT. William A. Seymour Jr.
(SIGNATURE OF APPLICANT)

APPROVED BY _____ FOR _____ DATE _____

REJECTED BY _____ FOR _____ DATE _____

HOLD PENDING FURTHER TESTS _____ DATE _____


REASONS FOR REJECTION OR HOLDING _____

THIS IS NOT A PERMIT

① ②

SOIL PROFILE

0'	AP
10'	RED BR. SILT CLAY LOAM <10% FRAGMENTS
4'	Yellow RED TO Yellow BR Silty SANDY LOAM <10% COARSE FRAGMENTS
14'	

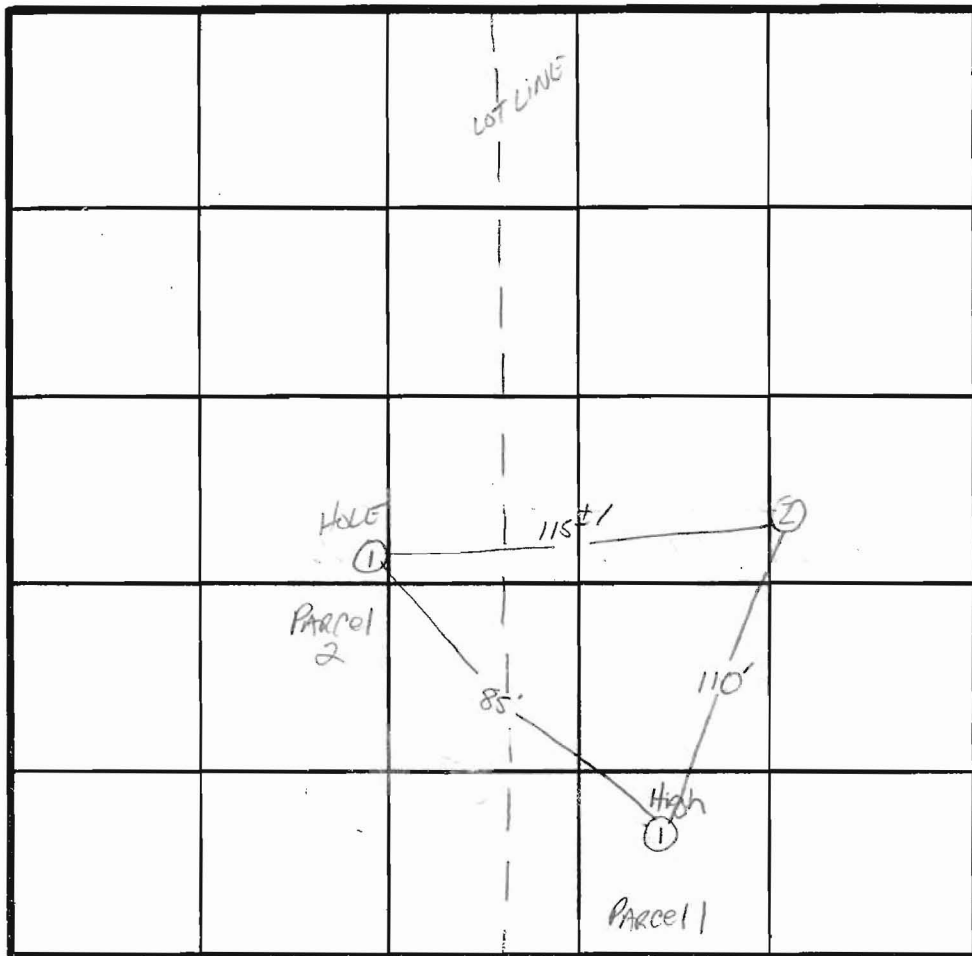

INDICATE NORTH - NAME ADJOINING ROADWAY AS BASE LINE.

RE 97


DATE	TEST NO.	DEPTH	PRE-WET		TEST - 1" DROP		TIME
			START	STOP	START	STOP	
2/20/86	1 S V	4' 14'	10:44	10:46	10:46	10:49	3min
	2 S V	4' 14'	10:54	10:59	10:59	11:10	11min

REMARKS _____

TYPE OF SOIL _____

TESTED BY S. Abel ALSO PRESENT CRAB, SKIP

EH-12-1079

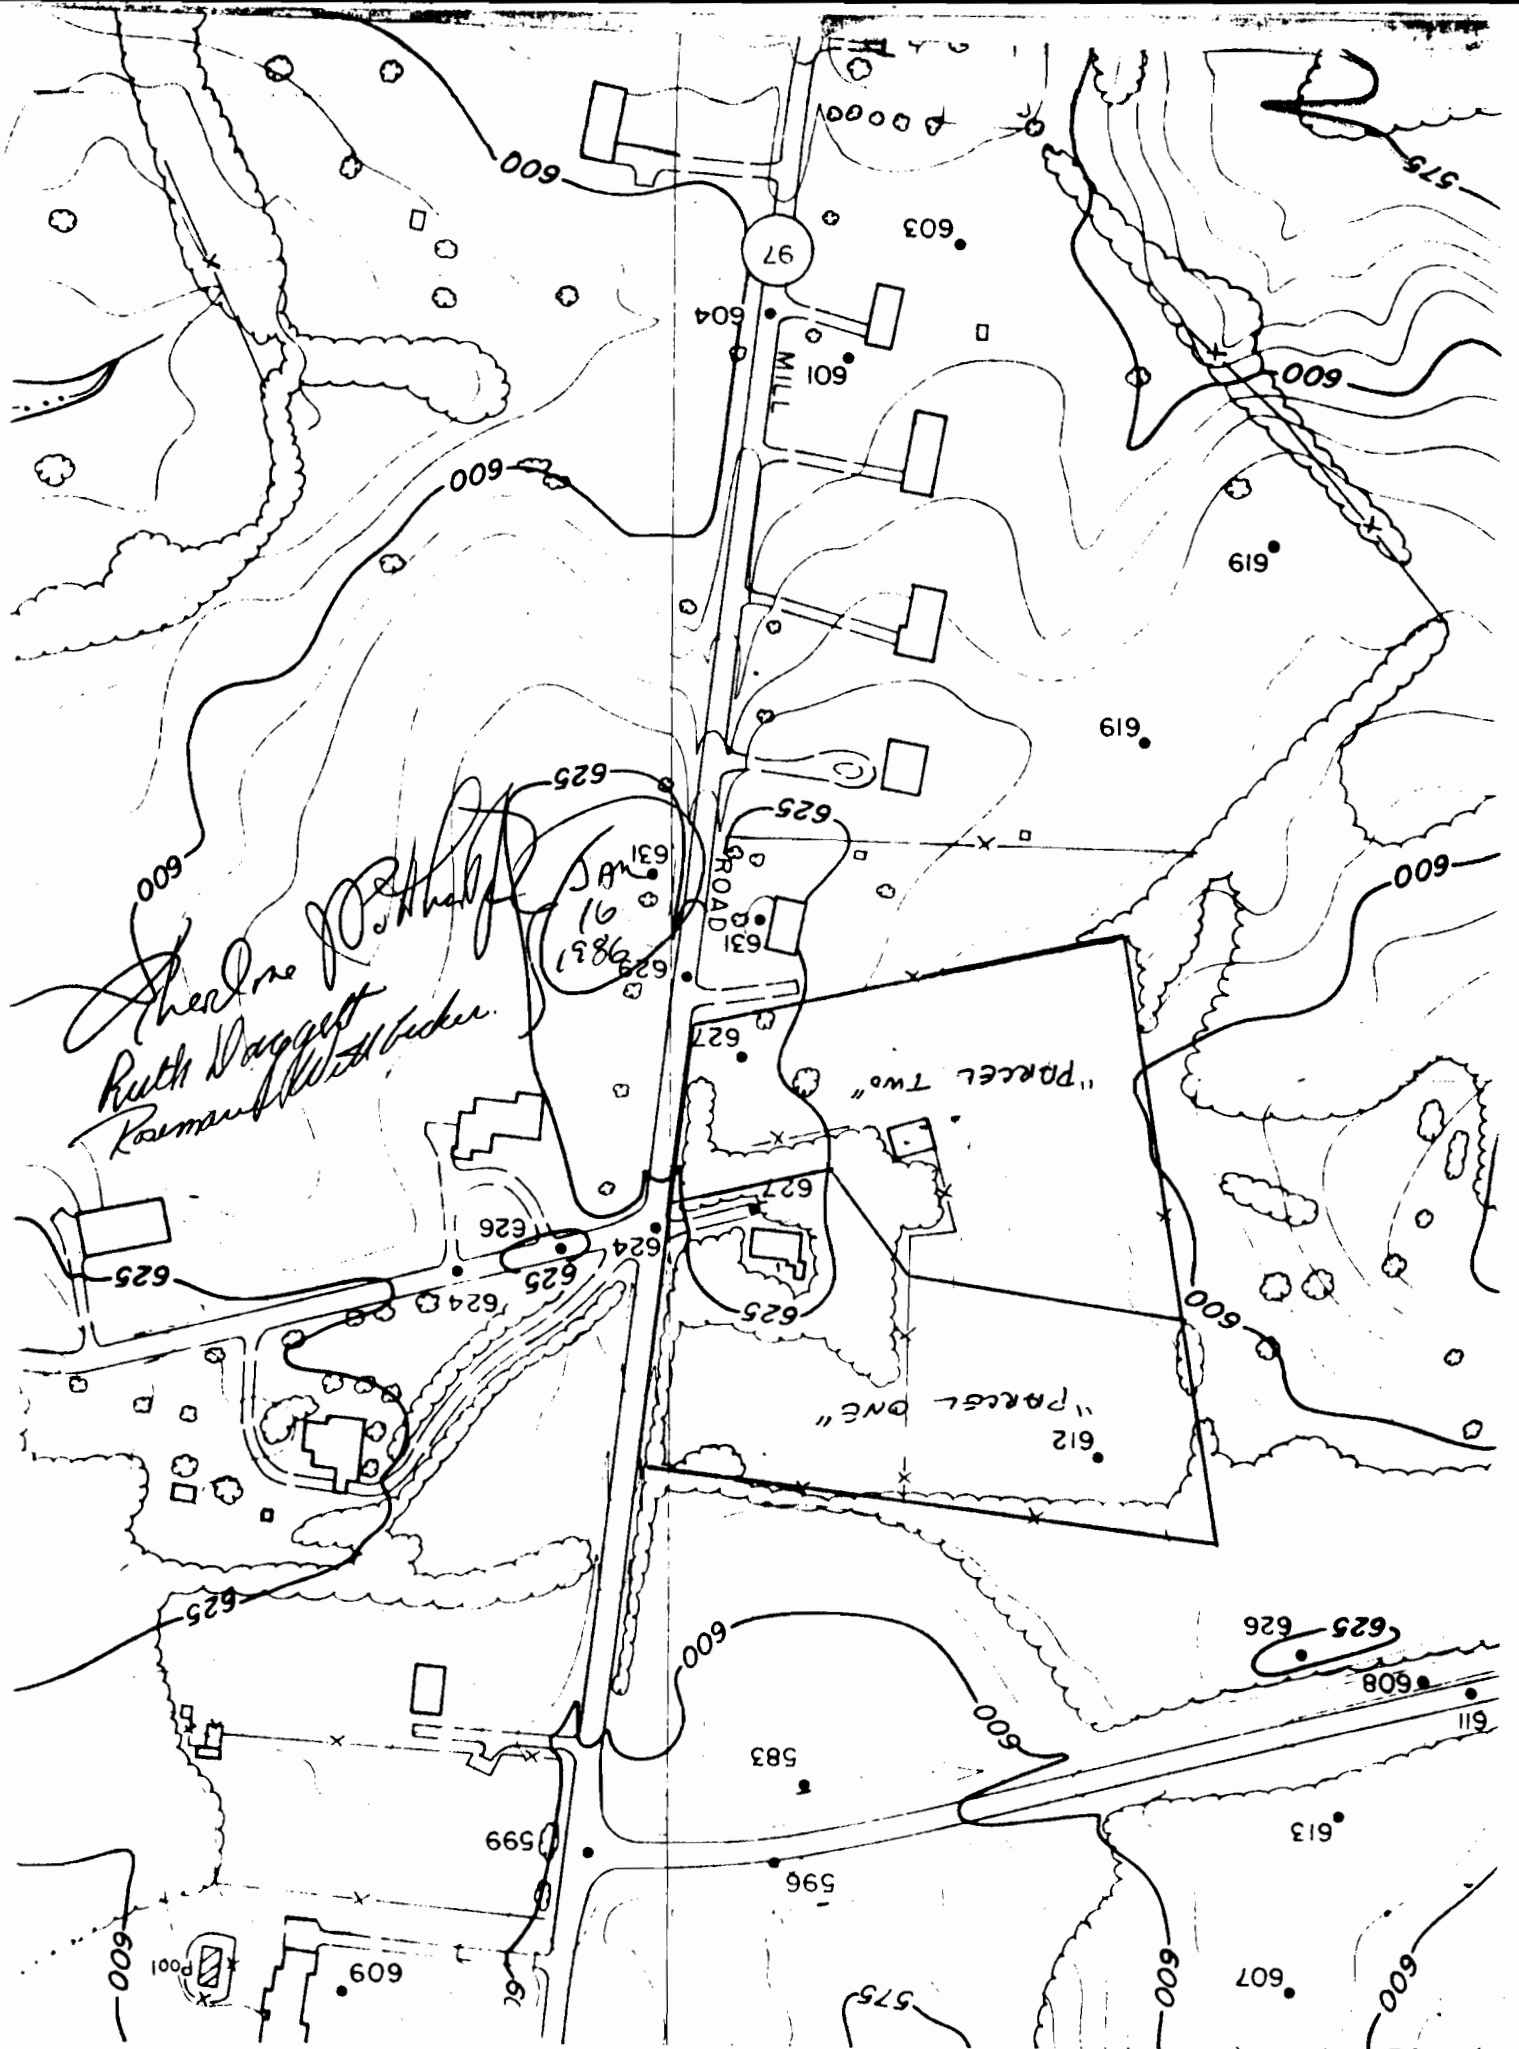

Shed one of Ruth Daggett
 Remains with fence.

Jan 16 1986

HOWARD COUNTY HEALTH DEPARTMENT

JOYCE M. BOYD M.D., M.P.H.
COUNTY HEALTH OFFICER



BUREAU OF ENVIRONMENTAL HEALTH
P. O., Box 476
ELLCOTT CITY, MARYLAND 21045
TELEPHONE: 461-9933

MEMORANDUM

Date: 2-20-86

Name: MRS. RUTH DAGGETT

Address: 1276 ROUTE 97

~~STEN~~ COOKSVILLE, MD. 21723

RE: DAGGETT FARM

PARCEL 1 AND 2

TAX MAP 8 PARCEL 35

Dear: MRS. DAGGETT

Percolation testing conducted 2-20-86 on the above referenced lot indicated satisfactory soil conditions.

Approval of the lot is contingent upon submission by a registered engineer of a plat showing certified test hole locations and a suitable house and well site.

This should be submitted within sixty (60) days to allow field verification if necessary.

If you have any questions regarding this matter, please feel free to contact me at the above address or by calling 461-9933.

Very truly yours,

ok - C.W.

Craig Williams, Acting Director
Water and Sewerage Program

CW:JR

March 4, 1986

Mrs. Ruth Daggett
1276 Route 97
Cooksville, Maryland 21723

RE: Percolation Testing
Daggett Farm
Parcel 1 and 2
Tax Map 3 Parcel 35

Dear Mrs. Daggett:


Percolation testing conducted February 20, 1986 on the above referenced lot indicated satisfactory soil conditions.

Approval of the lot is contingent upon submission by a registered engineer of a plat showing certified test hole locations and a suitable house and well site.

This should be submitted within sixty (60) days to allow field verification if necessary.

If you have any questions regarding this matter, please feel free to contact me at the above address or by calling 461-9933.

Very truly yours,

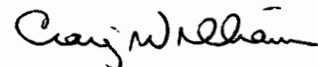

Craig Williams, Director
Water and Sewerage Program

CW/SA:JR