

APPLICATION

PERCOLATION TESTING

A 56422A

P _____

HOWARD COUNTY HEALTH DEPARTMENT
BUREAU OF ENVIRONMENTAL HEALTH
3925 H ELLICOTT MILLS DRIVE ELLICOTT CITY, MARYLAND 21043
TELEPHONE: 313-2240

DISTRICT _____

DATE 1/29/94

TO THE COUNTY HEALTH OFFICER
ELLICOTT CITY, MARYLAND

I HEREBY APPLY FOR THE NECESSARY TEST PRIOR TO APPLICATION FOR PERMIT TO CONSTRUCT (OR RECONSTRUCT) A SEWAGE DISPOSAL SYSTEM

PROPERTY OWNER Carol Bridgely Clark

ADDRESS P.O. Box 56, Glenwood, MD 21738 PHONE (301) 489-9141

AGENT OR PROSPECTIVE BUYER Phoenix Engineering, Inc.

ADDRESS 813 Maiden Choice Lane PHONE (410) 247-8833

PROPERTY LOCATION

SUBDIVISION Clark Property LOT NO. 1

ROAD AND DESCRIPTION Maryland Route 97

ZONING MAP 14 PARCEL # 156

SIZE OF LOT 3.85 ac. TYPE PLOT Single Family
(SINGLE FAMILY DWELLING OR COMMERCIAL)

THE SYSTEM INSTALLED UNDER THIS APPLICATION IS ACCEPTABLE ONLY UNTIL PUBLIC FACILITIES BECOME AVAILABLE. I FULLY UNDERSTAND THE

FEES CONNECTED WITH THE FILING OF THIS PERCO TEST APPLICATION IS NON-REFUNDABLE UNDER ANY CIRCUMSTANCES. I ALSO AGREE TO

COMPLY WITH ALL M.O.S.H.A. REQUIREMENTS IN TESTING THIS LOT

Amyf Roek
(SIGNATURE OF APPLICANT)

APPROVED BY GLEN SAUSAGE FOR SEO DATE 2/23/96

DISAPPROVED BY _____ FOR _____ DATE _____

HOLD PENDING FURTHER TESTS _____

REASONS FOR REJECTION OR HOLDING _____

PERCOLATION TEST PLAT/PRELIMINARY PLAT - TITLE OR I.D. # _____ DATE _____

SITE DEVELOPMENT PLAN/FINAL PLAT - TITLE OR I.D. # _____ DATE _____

THIS IS NOT A PERMIT

56422A

COUNTY #

SOIL PROFILE

TOPSOIL

TAN SANDY LOAM

OPEN FIELD

HIGH HOLE

SOIL PROFILE

TOPSOIL

TAN MICACEOUS SANDY SILT LOAM

GARAGE

11.5

HOUSE

DRIVEWAY

53
3
159

INDICATE NORTH - NAME ADJOINING ROADWAY AS BASE LINE.

← N RT 97

DATE	TEST NO.	DEPTH	PRE-WET		TEST - 1" DROP		TIME
			START	STOP	START	STOP	
2/13/96	1A OK TO 11.5	3.5'	10:25	10:27	10:27	10:31	4 MIN
	1 OK TO 11.5	7.5'	10:26	10:27	10:27	10:30	3 MIN
	2A OK TO 11	3'	10:50	10:51	10:51	10:53	2 MIN
	2A OK TO 11	7'	10:50	10:52	10:52	10:54	2 MIN
	3A OK TO 14	3.5'	11:17	11:19	11:19	11:23	4 MIN
	4A OK TO 11.5	3.5'	11:46	11:49	11:49	11:57	8 MIN

REMARKS LOT 1, COLD! WINDY! WATER STOPPING, GROUND FROZEN TO 1'

TYPE OF SOIL

TESTED BY

ALSO PRESENT WILL HOPKINS OWNER

ENGINEER (Any)

TRENCH DESIGN DATA: AVERAGE PERCOLATION TIME

TRENCH WIDTH

INLET DEPTH

MAXIMUM BOTTOM DEPTH

SQ. FT./BEDROOM

11.5

SIMILAR TO 3

2-6-90
10:00 am

APPLICATION

PERCOLATION TESTING

A 45365

P _____

HOWARD COUNTY HEALTH DEPARTMENT
BUREAU OF ENVIRONMENTAL HEALTH
P.O. BOX 476 ELLICOTT CITY, MARYLAND 21043
TELEPHONE 461-9933

12-20-89
Preview ok, JEN

DISTRICT _____

DATE 12/20/89

TO: THE COUNTY HEALTH OFFICER
ELLICOTT CITY, MARYLAND

I, HEREBY, APPLY FOR THE NECESSARY TEST IN ORDER TO CONSTRUCT (OR RECONSTRUCT) A SEWAGE DISPOSAL SYSTEM.

PROPERTY OWNER Worthington Ridgley

ADDRESS 2194 Rt 97 Cooksville MD PHONE _____

PROSPECTIVE BUYER Ronald Clark

ADDRESS 2397 Rt 97 Cooksville MD PHONE 489-4004

PROPERTY LOCATION:

SUBDIVISION Clark/Ridgley Property LOT NO. 1

ROAD AND DESCRIPTION Rt 97

TAX MAP 14 PARCEL # 36

SIZE OF LOT 3.6 Ac. TYPE BLDG SFD
(SINGLE FAMILY DWELLING OR COMMERCIAL)

THE SYSTEM INSTALLED UNDER THIS APPLICATION IS ACCEPTABLE ONLY UNTIL PUBLIC FACILITIES BECOME AVAILABLE. I FULLY UNDERSTAND THE FEE CONNECTED WITH THE FILING OF THIS PERC TEST APPLICATION IS NON-REFUNDABLE UNDER ANY CIRCUMSTANCES. I ALSO AGREE TO COMPLY WITH ALL M.O.S.H.A. REQUIREMENTS IN TESTING THIS LOT.

Wanda Van Winkle (for Jack Fyock)
(SIGNATURE OF APPLICANT)

APPROVED BY _____ FOR _____ DATE _____

REJECTED BY _____ FOR _____ DATE _____

HOLD PENDING FURTHER TESTS _____ DATE _____

REASONS FOR REJECTION OR HOLDING 2/6/90 HOLD FOR PLAT-PERC OR MR


HD-216

THIS IS NOT A PERMIT

Lot 1
A45365

ALL HOLES
SOIL PROFILE

3-4'
0'
13'
0.9%
bgn
clay
loam
H. tan
& H. org
silt
100m
5% frags
little
saprolite

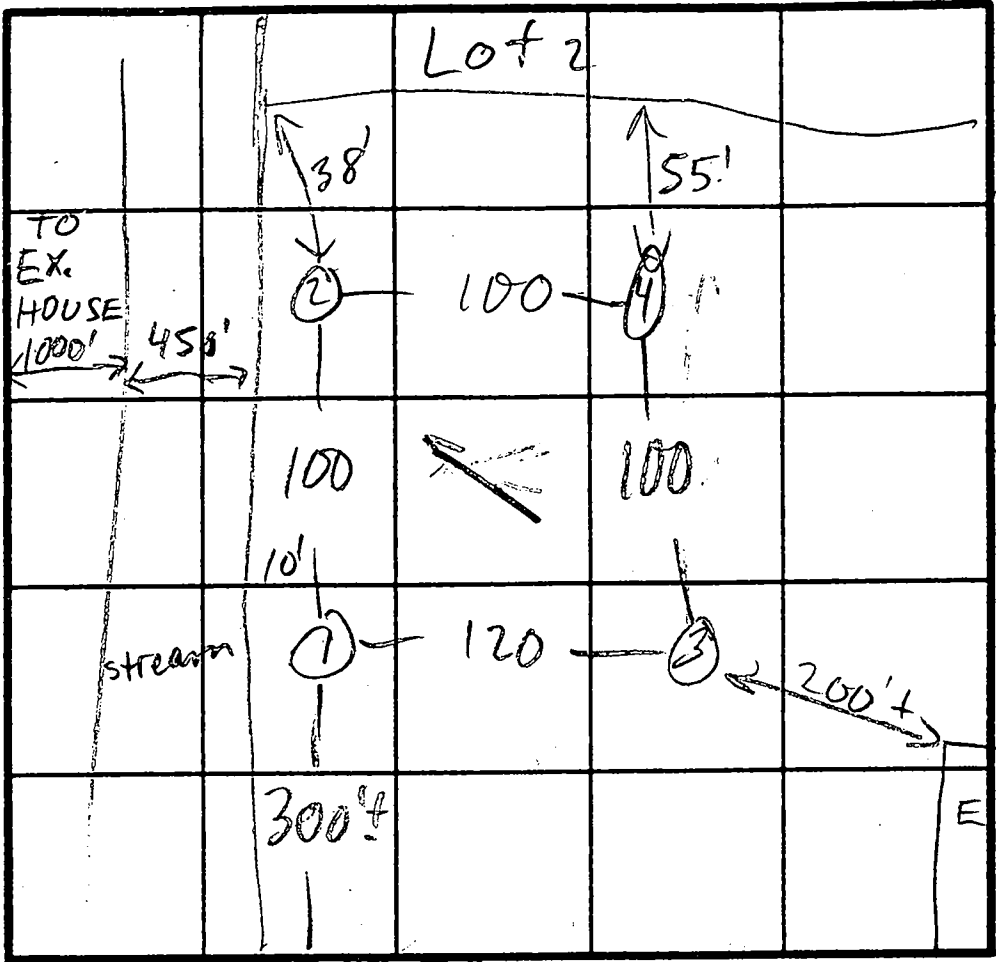

③ H1
④ (MED)
② LO
X=3
180' BR
Inlet 4"
Bottom 8"
EX. LOT W/
HOUSE


Rt. 77 INDICATE NORTH - NAME ADJOINING ROADWAY AS BASE LINE.

DATE	TEST NO.	DEPTH	PRE-WET		TEST - 1" DROP		TIME	
			START	STOP	START	STOP		
2/6/90	1 S	5	10:34	10:35	10:35	10:40	5	
	1 V	13	see profile					
	2 S	4	10:41	10:42	10:42	10:44	2	
	2 V	12 1/2	see profile					
	3 S	3 1/2 6 1/2	10:49 10:50	10:50 10:51	10:50 10:51	10:52 10:55	2 3	
	3 V	13	see profile					
	4 V	13	see profile - OK					

REMARKS _____

TYPE OF SOIL _____

TESTED BY M. Rifkin ALSO PRESENT JF & Co, owner

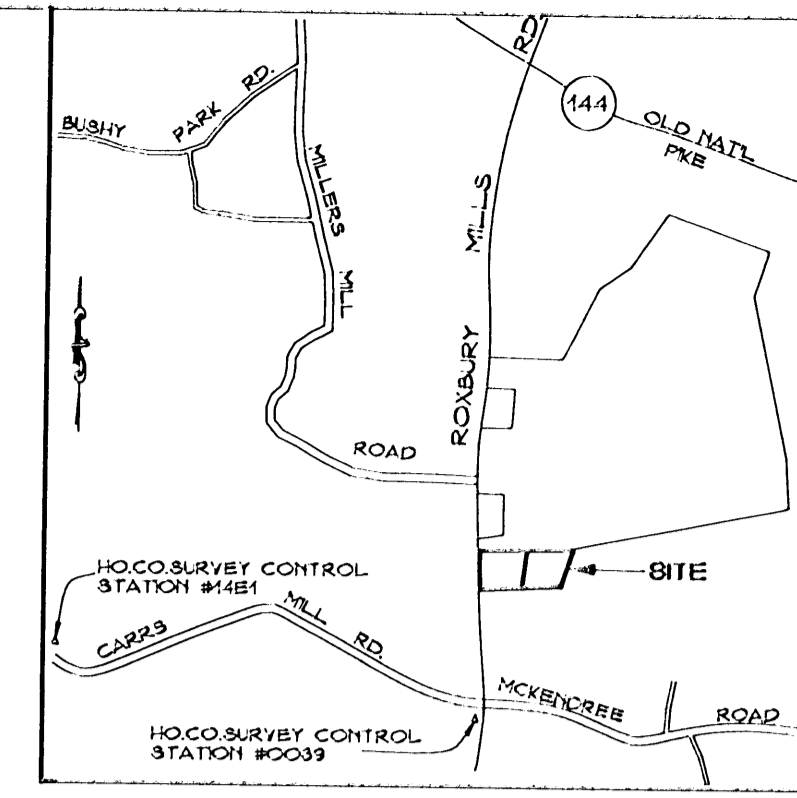


VICINITY MAP
SCALE 1" = 2000'

WORTHINGTON B. RIDGELY, ET. AL.
2904/237
7,526,292 SQ. FT. 172.77 AC.

THIS AREA IS DESIGNATED AS A PRIVATE SEWAGE EASEMENT OF 10,000 SQUARE FEET AS REQUIRED BY THE MARYLAND DEPARTMENT OF THE ENVIRONMENT FOR INDIVIDUAL SEWAGE DISPOSAL. IMPROVEMENTS OF ANY NATURE IN THIS AREA IS RESTRICTED UNTIL PUBLIC SEWAGE IS AVAILABLE. THIS EASEMENT SHALL BECOME NULL AND VOID UPON CONNECTION TO A PUBLIC SEWAGE SYSTEM. THE COUNTY HEALTH OFFICER SHALL HAVE THE AUTHORITY TO GRANT VARIANCES FOR ENCROACHMENTS INTO THE PRIVATE SEWAGE EASEMENT. RECORDATION OF A MODIFIED SEWAGE EASEMENT SHALL NOT BE NECESSARY.


ROUTE 97
MARYLAND

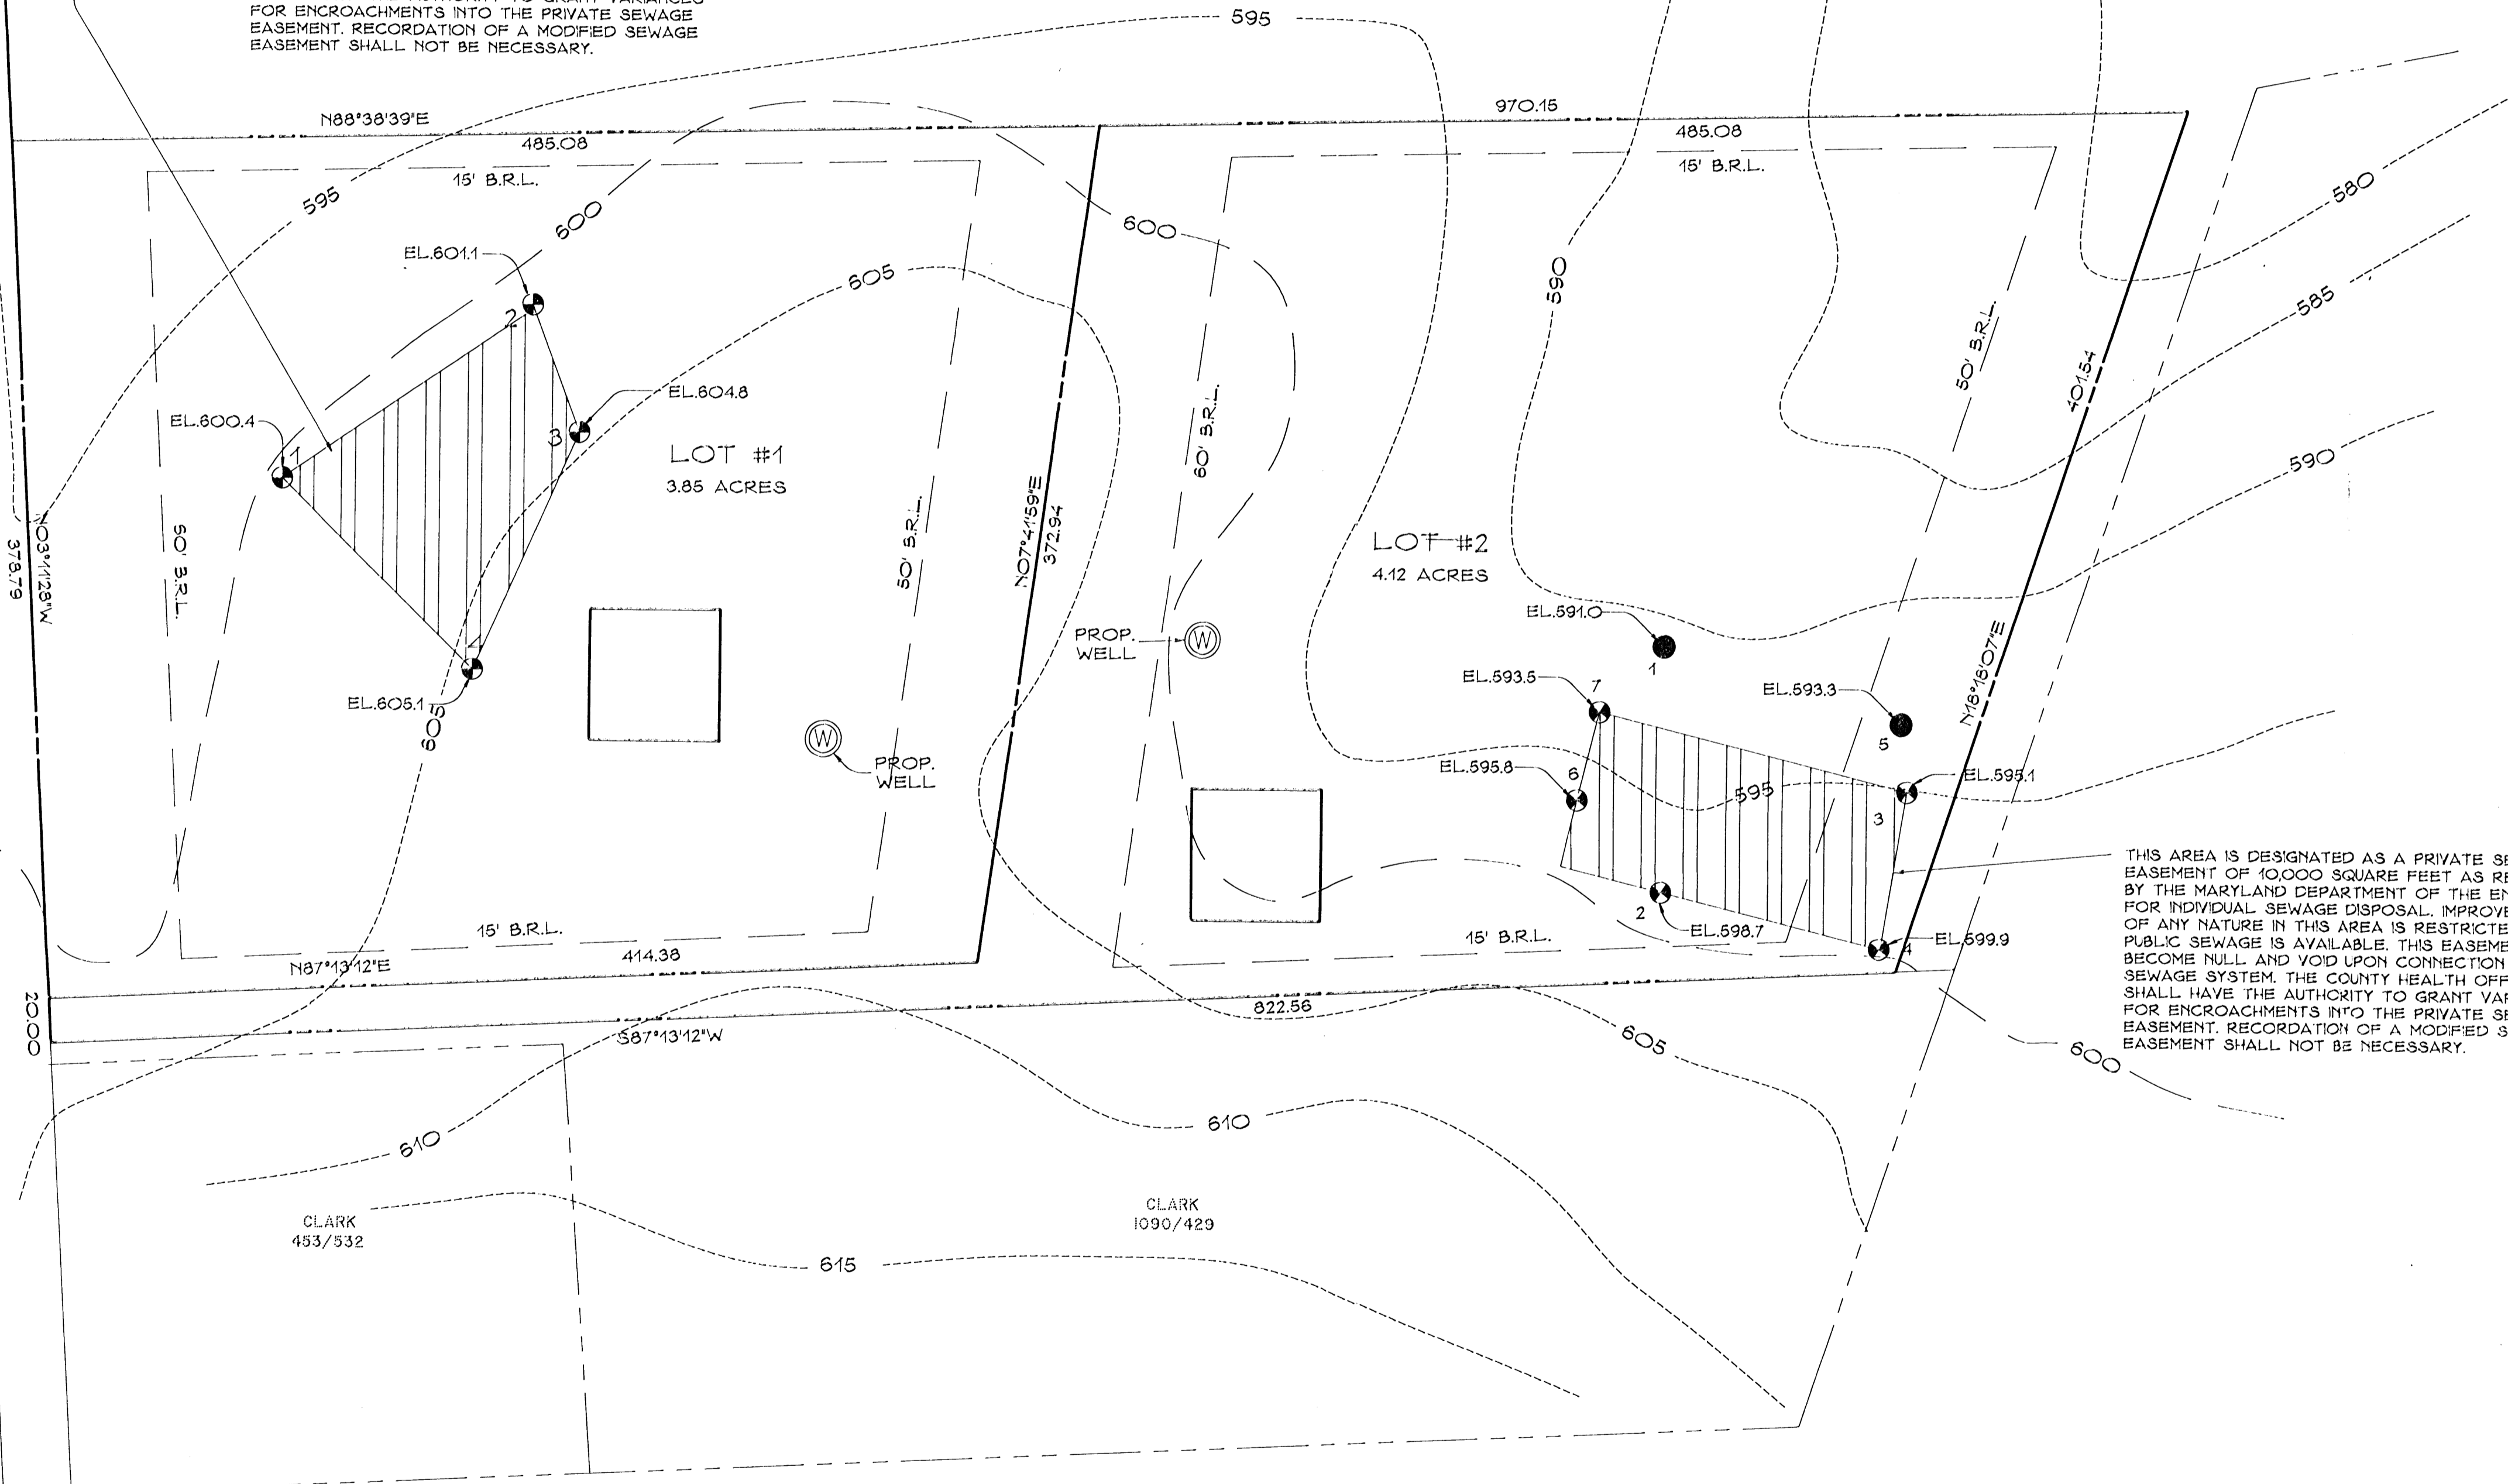



THIS AREA IS DESIGNATED AS A PRIVATE SEWAGE EASEMENT OF 10,000 SQUARE FEET AS REQUIRED BY THE MARYLAND DEPARTMENT OF THE ENVIRONMENT FOR INDIVIDUAL SEWAGE DISPOSAL. IMPROVEMENTS OF ANY NATURE IN THIS AREA IS RESTRICTED UNTIL PUBLIC SEWAGE IS AVAILABLE. THIS EASEMENT SHALL BECOME NULL AND VOID UPON CONNECTION TO A PUBLIC SEWAGE SYSTEM. THE COUNTY HEALTH OFFICER SHALL HAVE THE AUTHORITY TO GRANT VARIANCES FOR ENCROACHMENTS INTO THE PRIVATE SEWAGE EASEMENT. RECORDATION OF A MODIFIED SEWAGE EASEMENT SHALL NOT BE NECESSARY.

GWYNOLY OAK ESTATES
PLAT OF FISHER COLLINS AND CARTER, INC.
PETTIT AND GRIFFIN INC.
1974/146


NOTE:
THERE ARE NO EXISTING SEPTIC OR WELL AREAS WITHIN 100 FEET OF THE PROPOSED LOTS.

Date	No	Revision Description
OWNER/DEVELOPER:		
CAROL RIDGLEY CLARK MARYLAND ROUTE 97 COOKSVILLE, MARYLAND 21723 L 2233 F 629		
 PHOENIX ENGINEERING, INC. CONSULTING ENGINEERS 813 MAIDEN CHOICE LANE, SUITE 300 BALTIMORE, MARYLAND 21228 (410) 247-8833 FAX 247-9397		
AREA: MARYLAND ROUTE 97 COOKSVILLE, MARYLAND TAX MAP 14 PARCEL 156		
TITLE: <i>signed</i> CAROL CLARK PROPERTY LOTS 2 AND 3 PERCOLATION CERTIFICATION PLAT		
Des By: J.R.H.	Scale: 1" = 50'	Proj No: CLARPERK.DWG
Drn By: D.R.B.	Date: FEBRUARY 1996	DRAWING NO
Chk By: J.R.H.	Approved:	1 OF 1


- PERC HOLE LEGEND
-  PASSED PERC HOLES
 -  FAILED PERC HOLES

APPROVED FOR PRIVATE WATER AND PRIVATE SEPTIC SYSTEM

John R. Heinrichs
 HOWARD COUNTY HEALTH OFFICER
 DATE: 3-1-96

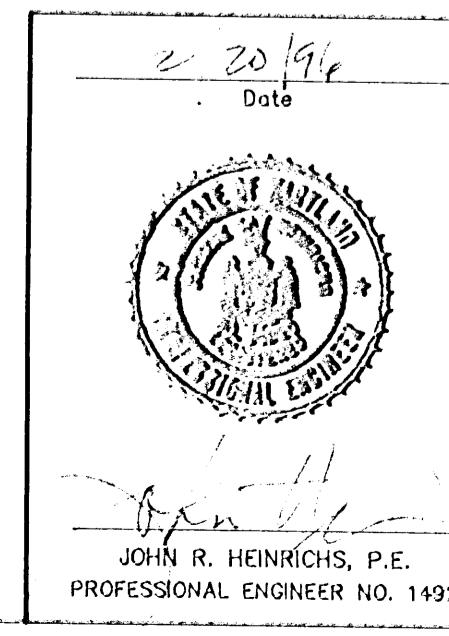

D:\m\c\k\5\p\clark\lot 2

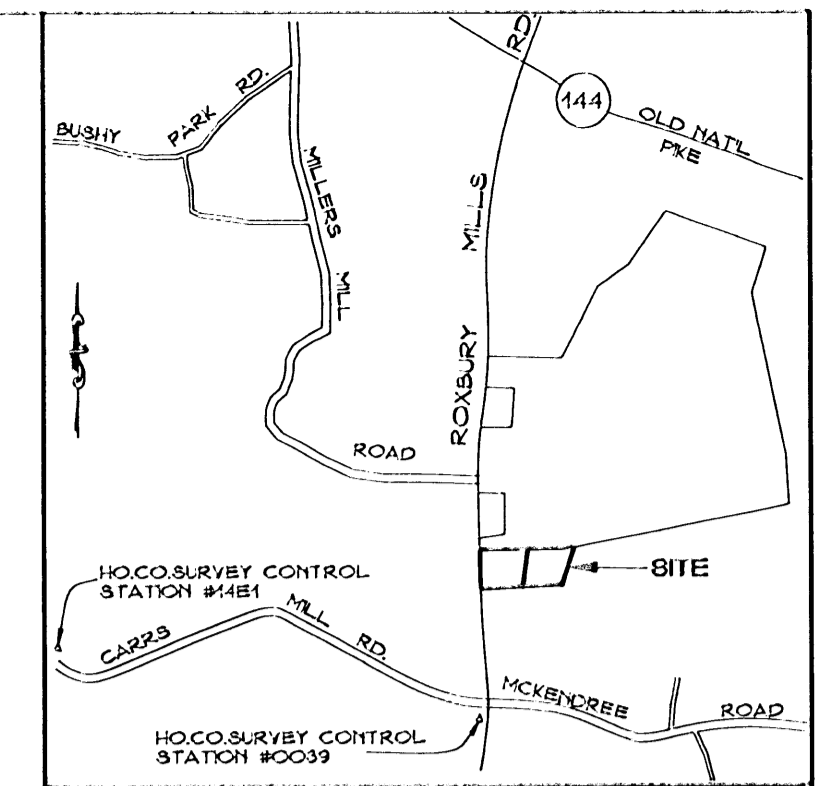

VICINITY MAP
SCALE 1" = 2000'


WORTHINGTON B. RIDGELY, ET. AL.
2904/237
7,526,292 SQ. FT. 172.77 AC.

THIS AREA IS DESIGNATED AS A PRIVATE SEWAGE EASEMENT OF 10,000 SQUARE FEET AS REQUIRED BY THE MARYLAND DEPARTMENT OF THE ENVIRONMENT FOR INDIVIDUAL SEWAGE DISPOSAL. IMPROVEMENTS OF ANY NATURE IN THIS AREA IS RESTRICTED UNTIL PUBLIC SEWAGE IS AVAILABLE. THIS EASEMENT SHALL BECOME NULL AND VOID UPON CONNECTION TO A PUBLIC SEWAGE SYSTEM. THE COUNTY HEALTH OFFICER SHALL HAVE THE AUTHORITY TO GRANT VARIANCES FOR ENCROACHMENTS INTO THE PRIVATE SEWAGE EASEMENT. RECORDATION OF A MODIFIED SEWAGE EASEMENT SHALL NOT BE NECESSARY.

THIS AREA IS DESIGNATED AS A PRIVATE SEWAGE EASEMENT OF 10,000 SQUARE FEET AS REQUIRED BY THE MARYLAND DEPARTMENT OF THE ENVIRONMENT FOR INDIVIDUAL SEWAGE DISPOSAL. IMPROVEMENTS OF ANY NATURE IN THIS AREA IS RESTRICTED UNTIL PUBLIC SEWAGE IS AVAILABLE. THIS EASEMENT SHALL BECOME NULL AND VOID UPON CONNECTION TO A PUBLIC SEWAGE SYSTEM. THE COUNTY HEALTH OFFICER SHALL HAVE THE AUTHORITY TO GRANT VARIANCES FOR ENCROACHMENTS INTO THE PRIVATE SEWAGE EASEMENT. RECORDATION OF A MODIFIED SEWAGE EASEMENT SHALL NOT BE NECESSARY.

GWYNHYL OAK ESTATES
PLAT OF FISHER COLLINS AND CARTER, INC.
PETTIT AND GRIFFIN INC.
1974/146

ROUTE 97
MARYLAND

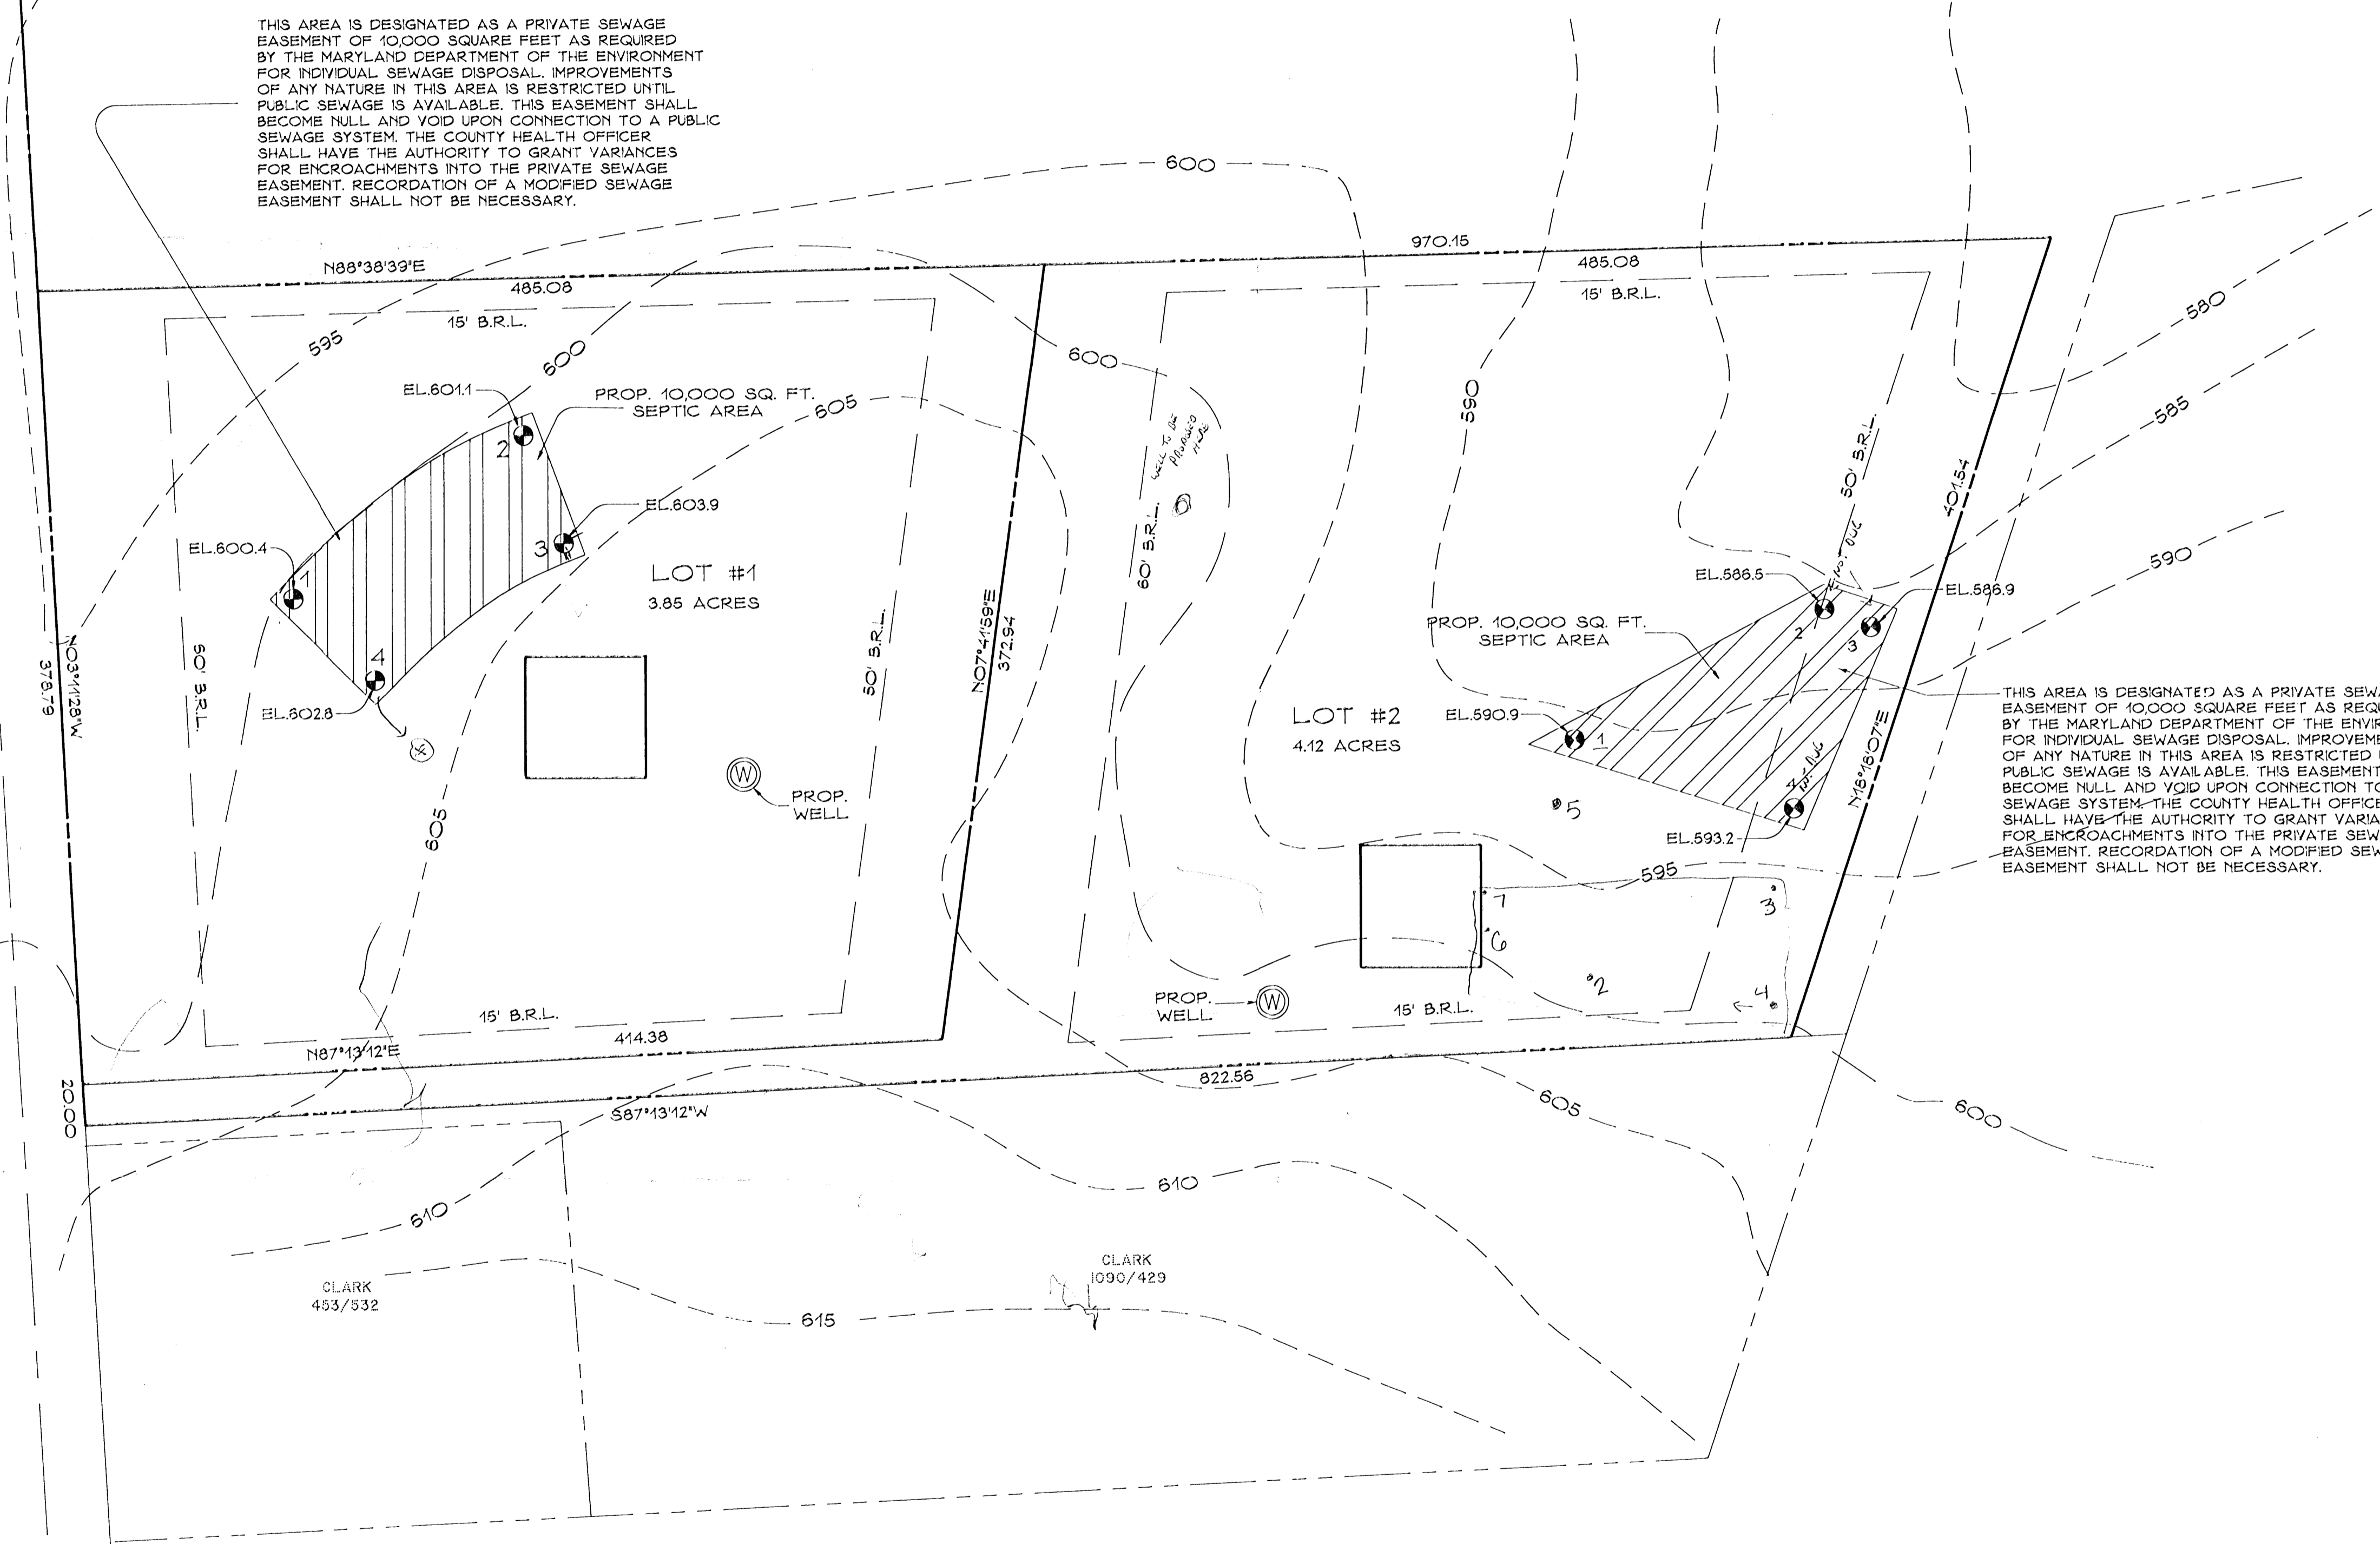

NOTE:
THERE ARE NO EXISTING SEPTIC OR WELL AREAS WITHIN 100 FEET OF THE PROPOSED LOTS.

Date	No	Revision Description

OWNER/DEVELOPER:

CAROL RIDGLEY CLARK
MARYLAND ROUTE 97
COOKSVILLE, MARYLAND 21723
L 2233 F 829

PHOENIX ENGINEERING, INC.
CONSULTING ENGINEERS
813 MAIDEN CHOICE LANE, SUITE 300
BALTIMORE, MARYLAND 21228
(410) 247-8833 FAX 247-9397

AREA
MARYLAND ROUTE 97
COOKSVILLE, MARYLAND
TAX MAP 14 PARCEL 156

TITLE
PATRICKS PLACE LOTS 1 AND 2
PERCOLATION CERTIFICATION PLAT

Des By	J.R.H.	Scale	1" = 50'	Proj No	CLARPERK.DWG
Drn By	D.R.B.	Date	January 1996	DRAWING NO	
Chk By	J.R.H.	Approved			1 OF 1

PERK HOLE LEGEND


- PERK HOLE LEGEND
- PERK HOLE LEGEND

APPROVED FOR PRIVATE WATER AND PRIVATE SEPTIC SYSTEM

HOWARD COUNTY HEALTH OFFICER DATE

COORDINATE TABLE		
1	N 697,285.3781	E 1308,444.4818
2	N 697,285.8148	E 1307,464.4841
3	N 697,308.3334	E 1307,414.3847
4	N 698,927.1084	E 1307,288.2712
5	N 698,887.8944	E 1308,478.8896
6	N 698,887.2970	E 1308,478.4859

MINIMUM LOT SIZE CHART				
LOT NO.	GROSS AREA	PIPESTEM AREA	REMAINING AREA	MINIMUM LOT SIZE
2	179,431 SQ.FT.	8,049 SQ.FT.	171,381 SQ.FT.	171,382 SQ.FT.

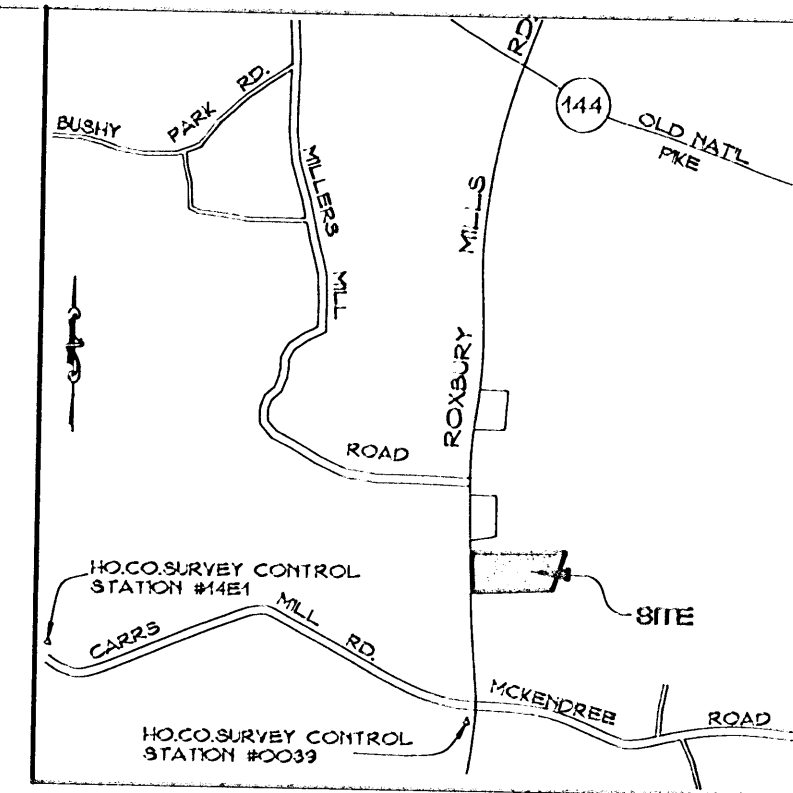


VICINITY MAP
SCALE: 1" = 2000'

NOTES:

- THIS PLAT AND THE COORDINATES SHOWN HEREON ARE BASED UPON NAD 83 MARYLAND SYSTEM, AS PROJECTED BY HOWARD COUNTY GEODETIC CONTROL STATIONS 0039 & 14E1.
- THE BOUNDARY SURVEY WAS PERFORMED BY C. BROCKE MILLER IN NOVEMBER, 1994.
- SUBJECT PROPERTY ZONED RC.
- ALL AREAS SHOWN HAVE BEEN ROUNDED OFF AND ARE MORE OR LESS.
- ALL UTILITY EASEMENTS SHOWN HEREON ARE DESIGNATED AS PUBLIC EASEMENTS, UNLESS OTHERWISE IDENTIFIED AS PRIVATE.
- THE PURPOSE OF THIS PLAT IS TO SUBDIVIDE THIS PARCEL INTO TWO LOTS.
- DRIVEWAYS SHALL BE PROVIDED TO RESIDENTIAL OCCUPANCY TO INSURE SAFE ACCESS FOR FIRE AND EMERGENCY VEHICLES PER THE FOLLOWING MINIMUM REQUIREMENTS: A) WIDTH - 12 FEET (16 FEET SERVING MORE THAN ONE RESIDENCE). B) SURFACE - 8 INCHES OF COMPACTED CRUSHER RUN BASE WITH TAR AND CHIP COATING. C) GEOMETRY - MAXIMUM 15% GRADE, MINIMUM 10% GRADE CHANGE AND MINIMUM 46 FOOT TURNING RADIUS. D) STRUCTURES (CULVERT/BRIDGES) - CAPABLE OF SUPPORTING 25 GROSS TONS (H25 LOADING). E) DRAINAGE ELEMENTS - CAPABLE OF SAFELY PASSING 100-YEAR FLOOD WITH NO MORE THAN 1 FOOT DEPTH OVER DRIVEWAY SURFACE. F) STRUCTURE CLEARANCES - MINIMUM 12 FEET. G) MAINTENANCE - SUFFICIENT TO INSURE ALL WEATHER USE.
- FOR FLAG OR PIPESTEM LOTS, REFUSE COLLECTION, SNOW REMOVAL AND ROAD MAINTENANCE ARE PROVIDED TO THE JUNCTION OF THE FLAG OR PIPESTEM AND THE ROAD RIGHT-OF-WAY LINE ONLY AND NOT ONTO THE FLAG OR PIPESTEM LOT DRIVEWAY.
- THIS PROPERTY IS EXEMPT FROM STORMWATER MANAGEMENT REQUIREMENTS AS PER THE HOWARD COUNTY DESIGN MANUAL VOLUME I STORM DRAINAGE CHAPTER 5, SECTION 5.1.2, B-4.
- OPEN SPACE IS NOT REQUIRED WITHIN THE RC ZONING.
- THE SEPTIC AREAS ARE DESIGNATED AS PRIVATE SEWAGE EASEMENTS OF 10,000 SQ. FEET AS REQUIRED BY THE MARYLAND DEPARTMENT OF THE ENVIRONMENT FOR INDIVIDUAL SEWAGE DISPOSAL. IMPROVEMENTS OF ANY NATURE IN THESE AREAS IS RESTRICTED UNTIL PUBLIC SEWAGE IS AVAILABLE. THIS EASEMENT SHALL BECOME NULL AND VOID UPON CONNECTION TO A PUBLIC SEWAGE SYSTEM. THE COUNTY HEALTH OFFICER SHALL HAVE THE AUTHORITY TO GRANT VARIANCES FOR ENCROACHMENT INTO THE PRIVATE SEWAGE EASEMENT. RECORDATION OF A MODIFIED SEWAGE EASEMENT SHALL NOT BE NECESSARY.
- THE FOREST CONSERVATION REQUIREMENTS INCURRED BY THIS PROPERTY HAVE BEEN MET BY THE FOREST CONSERVATION EASEMENTS AS SHOWN ON THIS PLAT.

AREA TO BE DEDICATED TO HOWARD COUNTY FOR ROAD WIDENING 3,988.827 SQ.FT. 0.0916 AC.

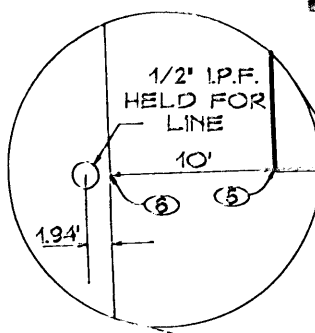

THE REQUIREMENTS 23-1008, THE REAL PROPERTY ARTICLE, ANNOTATED CODE OF MARYLAND, 1988 REPLACEMENT VOLUME (AS SUPPLEMENTED) AS FAR AS THEY RELATE TO THE MAKING OF THIS PLAT AND THE SETTING OF MARKERS, HAVE BEEN COMPLIED WITH.

Brooke Miller
SURVEYOR
C. BROCKE MILLER, P.L.S. #135

Carol Ridgely Clark
OWNER
CAROL RIDGELY CLARK

SITE INFORMATION

'MARYLAND ROUTE 97'
PROPOSED MINOR SUBDIVISION
ZONING: RC TAX MAP: 14 PAR: 168
DEED REF: 2233/625
DEED ACREAGE: 8.02936 AC.

OWNER:
MS. CAROL RIDGELY CLARK
P.O. BOX 55
GLENWOOD, MARYLAND 21738

AREA TABULATION

TOTAL NO. OF LOTS	2
TOTAL AREA OF LOTS	7.884 AC.
AREA OF ROW	0.0916 AC.
AREA OF OPEN SPACE	0
TOTAL AREA OF PLAT	7.975 AC.

LEGEND

- IRON PIPE FOUND
- REBAR FOUND

PHOENIX ENGINEERING, INC.
CONSULTING ENGINEERS
813 MAIDEN CHOICE LANE, SUITE 300
BALTIMORE, MARYLAND 21228
(410) 247-8833 FAX 247-9397

APPROVED: FOR PRIVATE WATER AND PRIVATE SEWERAGE SYSTEMS IN CONFORMANCE WITH MASTER PLAN OF WATER AND SEWERAGE FOR HOWARD COUNTY.

COUNTY HEALTH OFFICER _____ DATE _____

APPROVED: HOWARD COUNTY DEPARTMENT OF PLANNING AND ZONING.


DIRECTOR OF THE DEPARTMENT OF PLANNING AND ZONING _____ DATE _____

APPROVED: FOR PRIVATE WATER, SEWERAGE, STORM DRAINAGE SYSTEMS, AND PUBLIC ROADS, HOWARD COUNTY DEPARTMENT OF PUBLIC WORKS.

DIRECTOR _____ DATE _____

SURVEYOR'S CERTIFICATE

I HEREBY CERTIFY, TO THE BEST OF MY KNOWLEDGE AND BELIEF, THAT THE FINAL PLAT SHOWN HEREON IS CORRECT, THAT IT IS A SUBDIVISION OF ALL OF THE LANDS COMBINED BY WORTHINGTON B. RIDGELY TO CAROL RIDGELY CLARK BY DEED DATED SEPTEMBER 21, 1990 RECORDED AMONG THE LAND RECORDS OF HOWARD COUNTY, MARYLAND IN LIBER 2233 AT FOLIO 425, AND THAT ALL MONUMENTS ARE IN PLACE OR WILL BE IN PLACE, AS SHOWN, IN ACCORDANCE WITH THE ANNOTATED CODE OF MARYLAND, AS AMENDED.

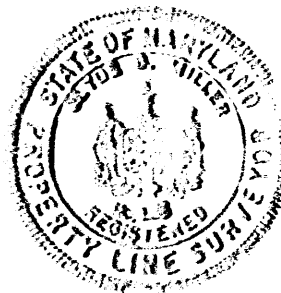

3-6-96
DATE

Brooke Miller
C. BROCKE MILLER, PROPERTY LINE SURVEYOR #135

OWNER'S CERTIFICATE

I, MS. CAROL RIDGELY CLARK, OWNER, OF THE PROPERTY SHOWN AND DESCRIBED HEREON, HEREBY ADOPT THIS PLAN OF SUBDIVISION, AND IN CONSIDERATION OF THE APPROVAL OF THIS PLAT BY THE DEPARTMENT OF PLANNING AND ZONING, ESTABLISH THE MINIMUM BUILDING RESTRICTION LINES AND GRANT UNTO HOWARD COUNTY, MARYLAND ITS SUCCESSORS AND ASSIGNS:

- THE RIGHT TO LAY, CONSTRUCT AND MAINTAIN SEWERS, DRAINS, WATER PIPES AND OTHER MUNICIPAL UTILITIES AND SERVICES, IN AND UNDER ALL ROADS AND STREET RIGHTS OF WAYS AND SPECIFIC EASEMENT SHOWN HEREON;
- THE RIGHT TO REQUIRE DEDICATION FOR PUBLIC USE THE BEDS OF THE STREETS AND/OR ROADS, AND FLOODPLAINS AND OPEN SPACE WHERE APPLICABLE AND FOR GOOD AND OTHER VALUABLE CONSIDERATION, HEREBY GRANT THE RIGHT AND OPTION TO HOWARD COUNTY TO ACQUIRE THE FEE SIMPLE TITLE TO THE BEDS OF THE STREET AND/OR ROADS AND FLOODPLAINS, STORM DRAINAGE FACILITIES AND OPEN SPACE WHERE APPLICABLE; AND
- THE RIGHT TO REQUIRE DEDICATION OF WATERWAYS AND DRAINAGE EASEMENTS FOR THE SPECIFIC PURPOSE OF THEIR CONSTRUCTION, REPAIR AND MAINTENANCE; AND
- THAT NO BUILDING OR SIMILAR STRUCTURE OF ANY KIND SHALL BE ERECTED ON OR OVER THE SAID EASEMENTS AND RIGHT OF WAYS.

WITNESS MY/OUR HANDS THIS 6 DAY OF March 1996.

Carol Ridgely Clark
MS. CAROL RIDGELY CLARK

RECORDED AS PLAT NUMBER _____
ON _____, 1996, AMONG THE LAND RECORDS OF HOWARD COUNTY, MARYLAND

F-96-142
5/5/96

PATRICKS PLACE
LOTS 1 AND 2

SHEET 1 OF 1
TAX MAP 14 PARCEL 158 ZONED: RC
4TH ELECTION DISTRICT OF HOWARD COUNTY, MARYLAND
SCALE: 1" = 100' DATE: MARCH, 1996

WORTHINGTON RIDGELY
2194 RT 97

STAKE

395'±

25' ACCESS TO FARM

489-4004

RONALD CLARK
2397 RT 97
COOKSVILLE MD.

STAKE

213.68'

PROPOSED
LOT 2

4.0 Ac ±

480'±

SDA

STAKE

325'±

STAKE

NOTE: SDA

LOT LINES TO BE
ADJUSTED AFTER
PRELIMINARY
PERC. TEST

PROPOSED

LOT 1

3.6 Ac ±

480'±

470'±

810'±

850.63'

CLARK
1090/429

538.54'

2000'
TO FARM




STAKE

330'±

STAKE

30'

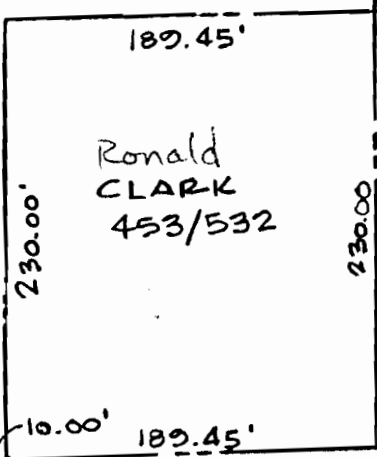

60' R/W

RT 97

CLARK/RIDGELY
PROPERTY

4TH ELECTION DISTRICT
HOWARD COUNTY, MD

TRACY, SCHULTE & ASSOCIATES INC.
engineering, planning & surveying

6450 Baltimore National Pike, Suite 418
Ellicott City, Maryland 21043

SCALE 1" = 100' 9/21/89



HOWARD COUNTY HEALTH DEPARTMENT

Joyce M. Boyd, M.D., County Health Officer

January 2, 1995

Ms. Carol Ridgley Clark
P.O. Box 56
Glenwood, Maryland 21738

RE: Percolation Test Application
Number: 56422A-B
Clark Property - 2 Lots
Route 97
Tax Map: 14 Parcel: 156

Dear Ms. Carol Ridgley Clark:

A percolation test date has been reserved for 10:00 a.m., Tuesday, February 13, 1996, for the above referenced property.

You will be responsible for having a contractor on-site to excavate test holes at the corners of proposed percolation area.

Please call this office between 8:00 a.m. and 5:00 p.m., Monday through Friday, to confirm your acceptance of this percolation test date.

Thank you for your cooperation in this matter.

Very truly yours,

Craig Williams, Program Director
Water & Sewerage Program

CW:am
cc:File
Phoenix Engineering, Inc.



HOWARD COUNTY HEALTH DEPARTMENT

Joyce M. Boyd, M.D., County Health Officer
March 15, 1996

Ms. Amy Rouk
Phoenix Engineering
817 Maiden Choice Lane
Suite 300
Baltimore, MD 21228

RE: Percolation test results
Application #A50503, P56479
Proposed Use: Subdivision
Clark Property - 2 lots
Route 97
Tax Map: 14 Parcel: 156

Dear Ms. Rouk:

Percolation testing was conducted February 13, 1996 on the above referenced property indicated limited satisfactory soil conditions. Copies of the percolation test results are enclosed.

A Percolation Certification Plan showing the following information should be submitted to this office by a registered engineer:

- actual locations & elevations of all excavated test holes
- a suitable house site
- a suitable well site
- locations of existing wells and septic systems that are on the property
- locations of all existing structures on the property
- locations of existing wells and septic systems within 100 feet of property boundaries.
- locations of streams/swales/springs or any other relevant features
- A #'s on all proposed septic reserve easements
- topographical contour lines
- other _____

Bureau of Environmental Health
3525-H Ellicott Mills Drive Ellicott City, Maryland 21043-4544
Water and Sewerage, Permits (410) 313-2640 Community Environmental Health (410) 313-2644
Food Protection Program (410) 313-2642 TDD (410) 313-2323

Ms. Amy Rouk

Page 2

March 15, 1996

This should be submitted within 60 days to allow field verification if necessary.

Please be advised that proposals for subdivision require a Groundwater Appropriations permit prior to any plat approvals.

If you have any questions regarding this matter, please feel free to contact me at the above address or by calling (410) 313-2640.

Very truly yours,



Glen Savage, Sanitarian
Water and Sewerage Program

GS:vr
Enclosures
cc: Owner
File